


PLAT OF GRASSMERE ADDITION

IN THE CITY OF MASSILLON

S.W. QUARTER SEC. 5, T.P. 10, R. 9

SCALE 1" = 60'

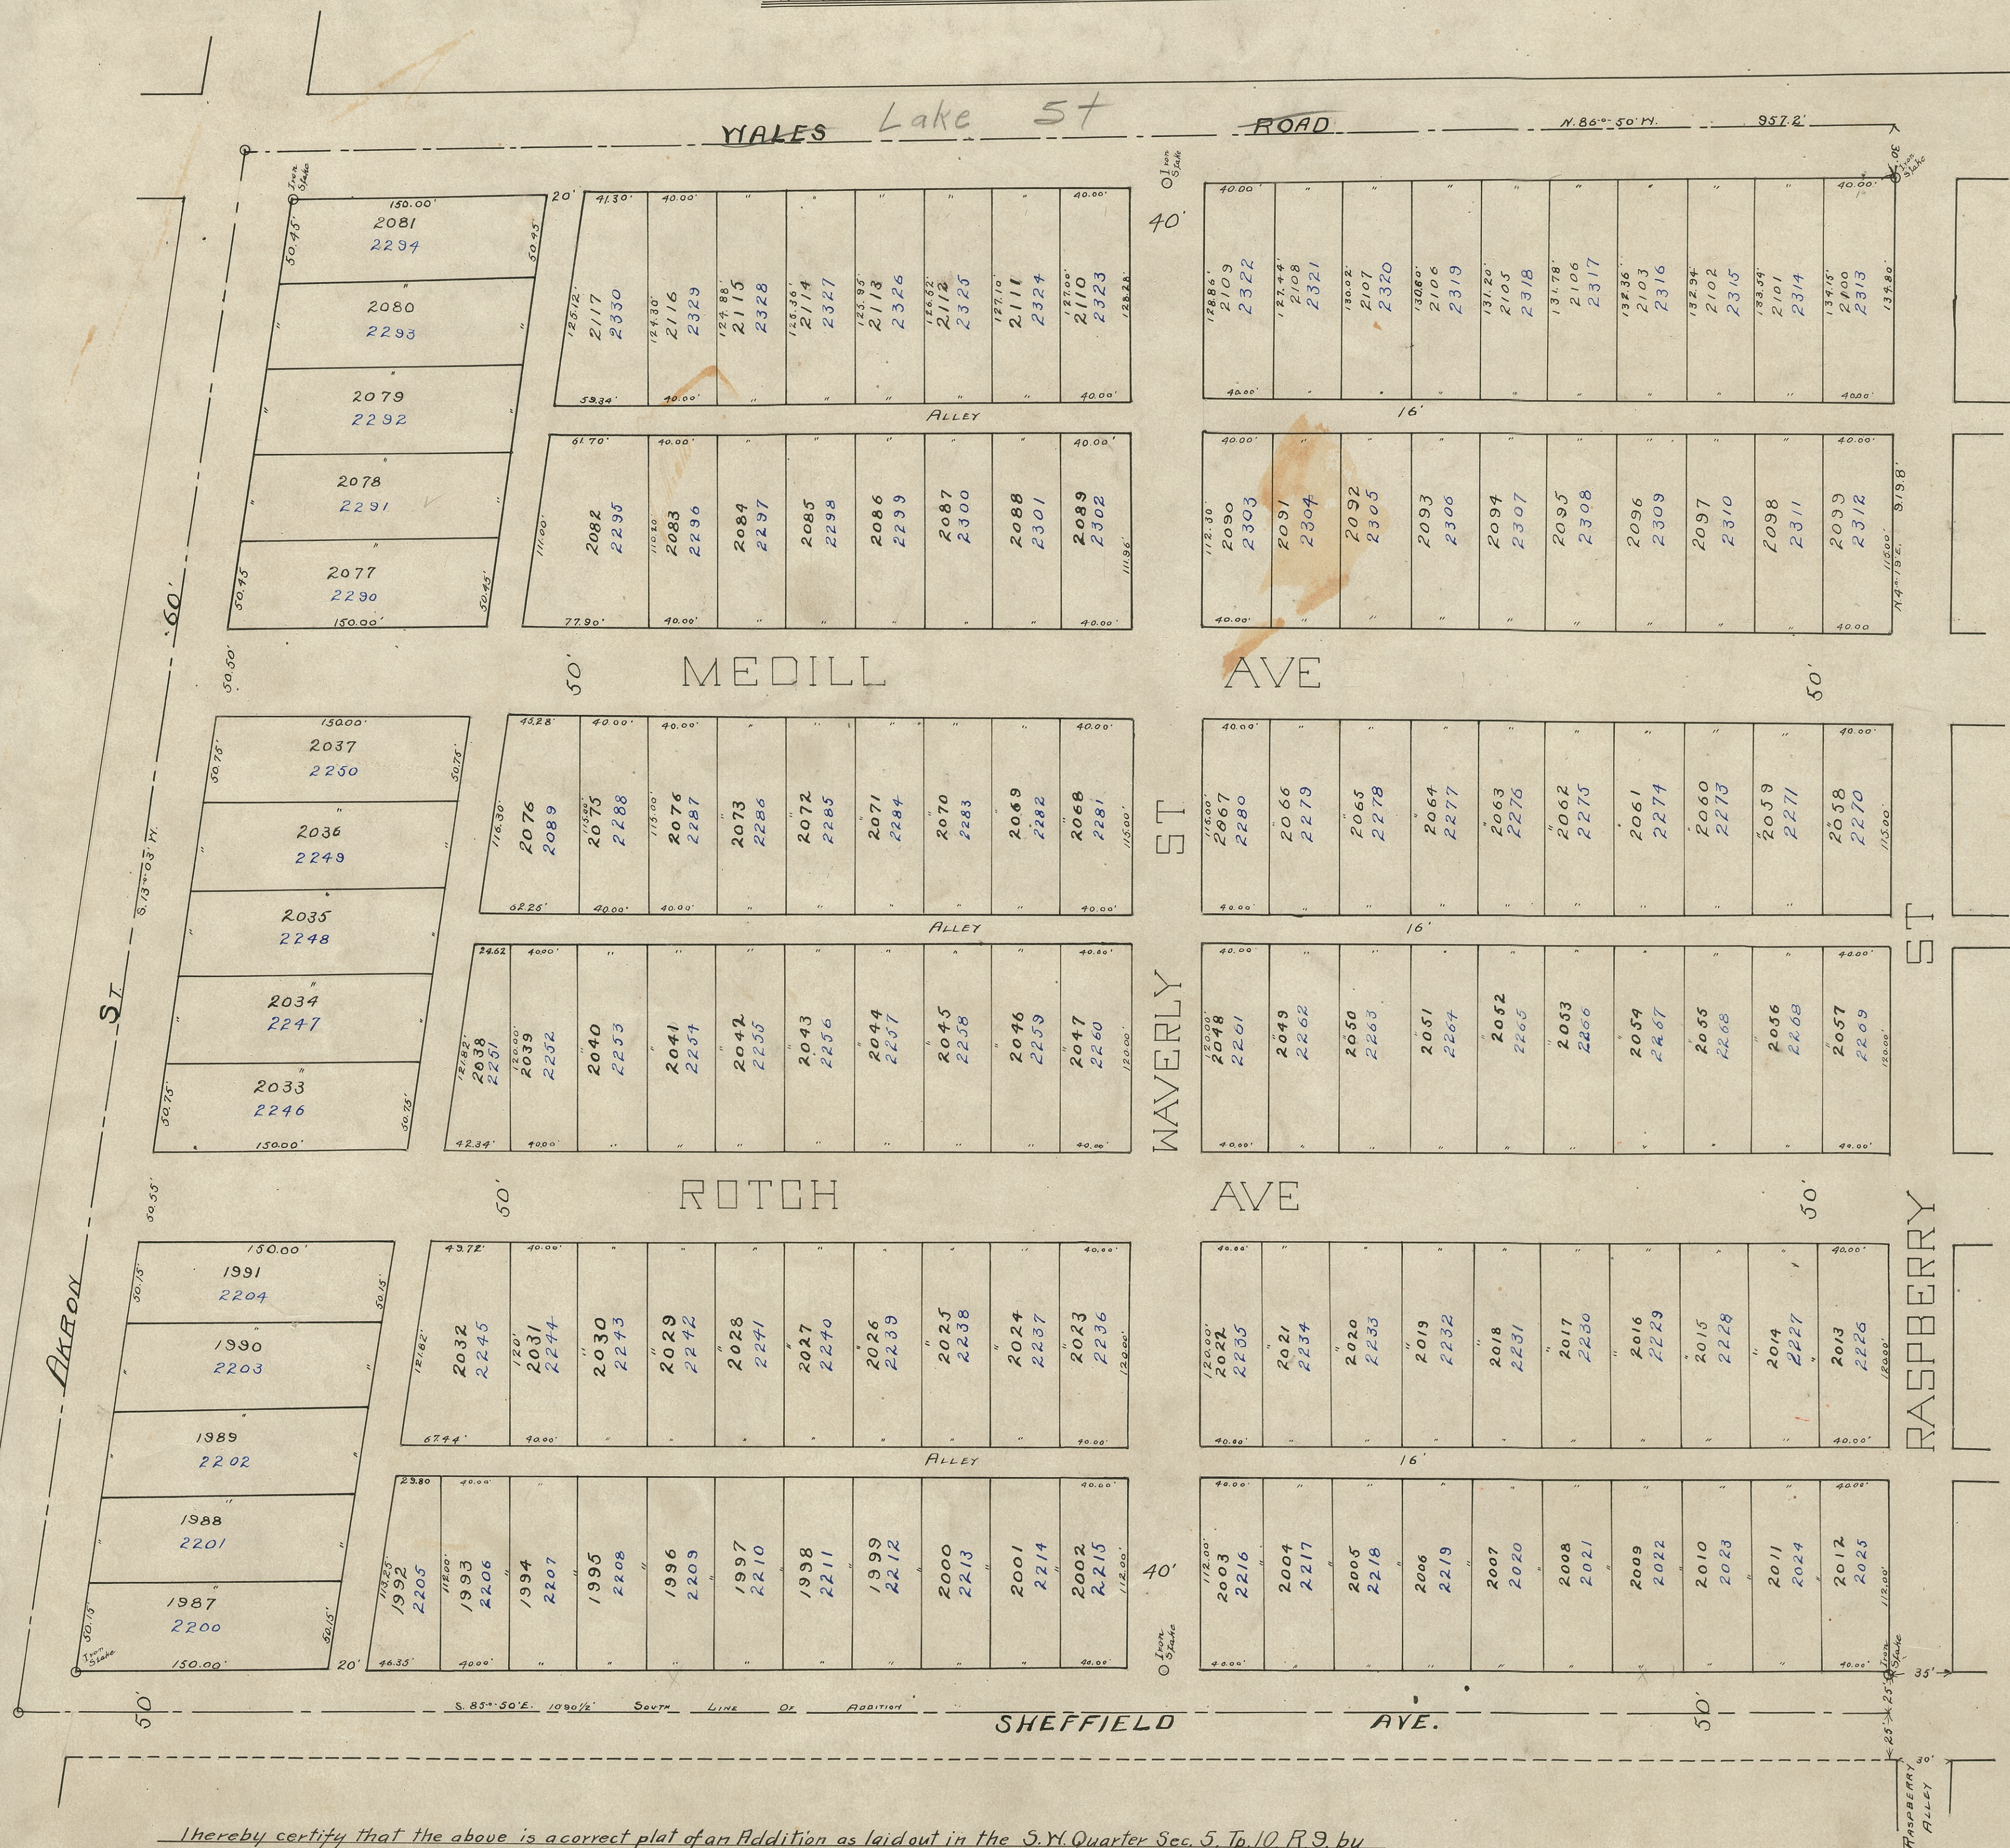

I hereby certify that the above is a correct plat of an Addition as laid out in the S.W. Quarter Sec. 5, T.P. 10, R. 9, by

Mrs. E.A. Wales as the executrix the owner of same as surveyed and platted by me Sept 22, 1892.

Said Tract Contains 21 Acres of Land

John Holl, Surveyor.

Note— Lot numbers in Black are original Numbers, and Blue Numbers are Present Numbers.

The foregoing Map or Plat was this day approved by the Council of the City of Massillon Ohio. Oct 3, 1892

E. B. Bayliss—City Clerk of Massillon Ohio.

Known all men by these presents that Eliza A. Wales, as executrix of the estate of Arvine C. Wales, deceased, late of Perry Township Stark County, Ohio, the owner and Proprietor of the land and ground comprised in the above Allotment and Plat do hereby certify that this Map or Plat is accurate and true and was made by my instance by, John H. Holl, surveyor. That the length and breadth of said respective, are correctly delineated on said Plat and that I hereby grant and give and dedicate all the Streets, Avenues, and Alleys for public purposes forever—Witness my hand and seal this 3rd day of October 1892

Elizabth A. Wales, Exr. of the Est. of A. C. Wales

Signed, Seal, and acknowledged in the presence of and Attested by—Otto E. Young
Arvine Wales

State of Ohio, Stark Co. SS.

Before me a Notary Public in and for said County personally came Elizabeth A. Wales, and acknowledged the signing and Sealing of the foregoing Instrument and Plat as Executrix of the Estate of Arvine C. Wales deceased.

Witness my hand and Notarial Seal this 3rd day of October 1892.

Otto E. Young

Notary Public, Stark County Ohio

Entered for transfer May 5, 1893

L. A. Lorchol Auditor

Received for Record May 3 1893 at 10:00 A.M.—Recorded May 4 1893 in Plat Book #3 Page 204

J. A. Freed—Recorder