


FINAL	SURVEYED	DATE
SURVEY	PLOTTED	BY
NOTE BOOK	REVISIONS	
NO.	AREAS CHECKED	

ORIGINAL	SURVEYED	DATE
SURVEY	PLOTTED	BY
NOTE BOOK	REVISIONS	
NO.	AREAS CHECKED	

NORTH

B.M. Nail S.E. side of Pole $745C4$ - 2nd Pole North of
North property line on East side of Brunnerdale Ave. N.W.
ELEVATION 1090.28

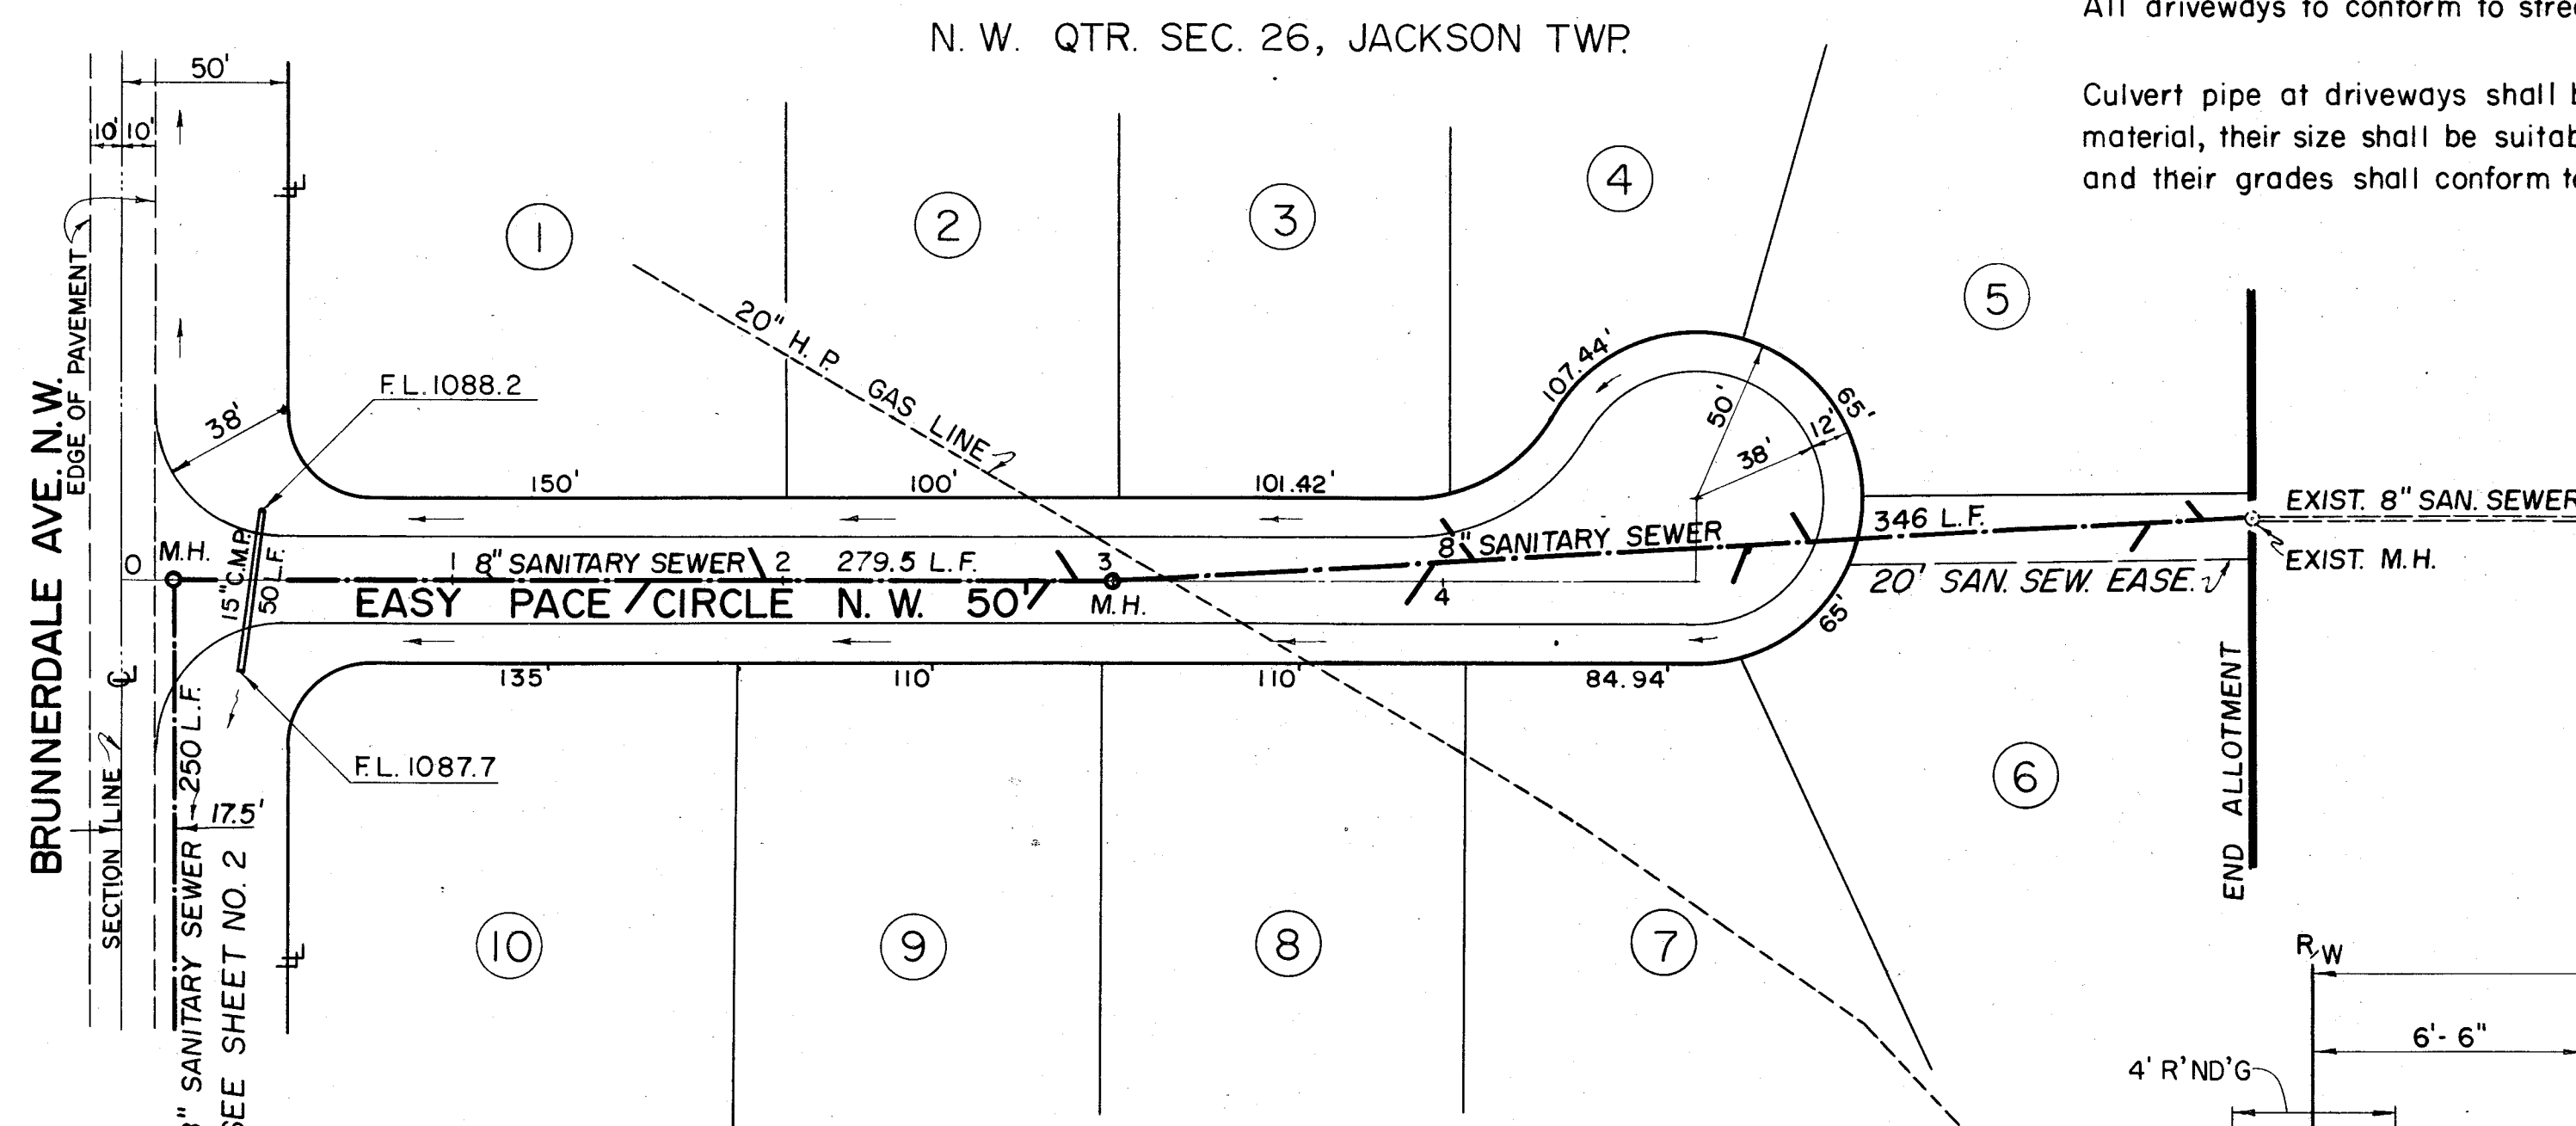

— NOTES —

All streets to be graded throughout their width and length to the grades shown on this plat.

All driveways to conform to street grades.

Culvert pipe at driveways shall be of acceptable material, their size shall be suitable to their location and their grades shall conform to ditch grades.

SANITARY SEWER PLAN AND ROAD GRADE ESTABLISHMENT

EASY PACE CIRCLE N.W. QUEENSWAY ST. N.W.
BRUNNERDALE AVENUE N.W. SUNQUEST CIRCLE N.W.

BRUNNERDALE ACRES ALLOTMENT

PART OF THE N.W. AND S.W. QTR. SEC. 26, T-11 (JACKSON) R-9
STARK COUNTY, O

SCALE: 1" = 50' HORZ.

MAY, 1969

1" = 5' VERT.

DONALD B. CORRELL, ET. AL. — DEVELOPER

Donald B. Correll

R. RICHARD FAWCETT, REG. ENGINEER & SURVEYOR


By *R. Richard Fawcett*
REG. ENGINEER 27549 & SURVEYOR 4948

APPROVED by the Stark County Sanitary
Engineer this 10th day of *Sept* 1969.

S. M. Shivers, Jr.
SANITARY ENGINEER


APPROVED by the Stark County Engineer this _____
day of _____ 196__.

COUNTY ENGINEER

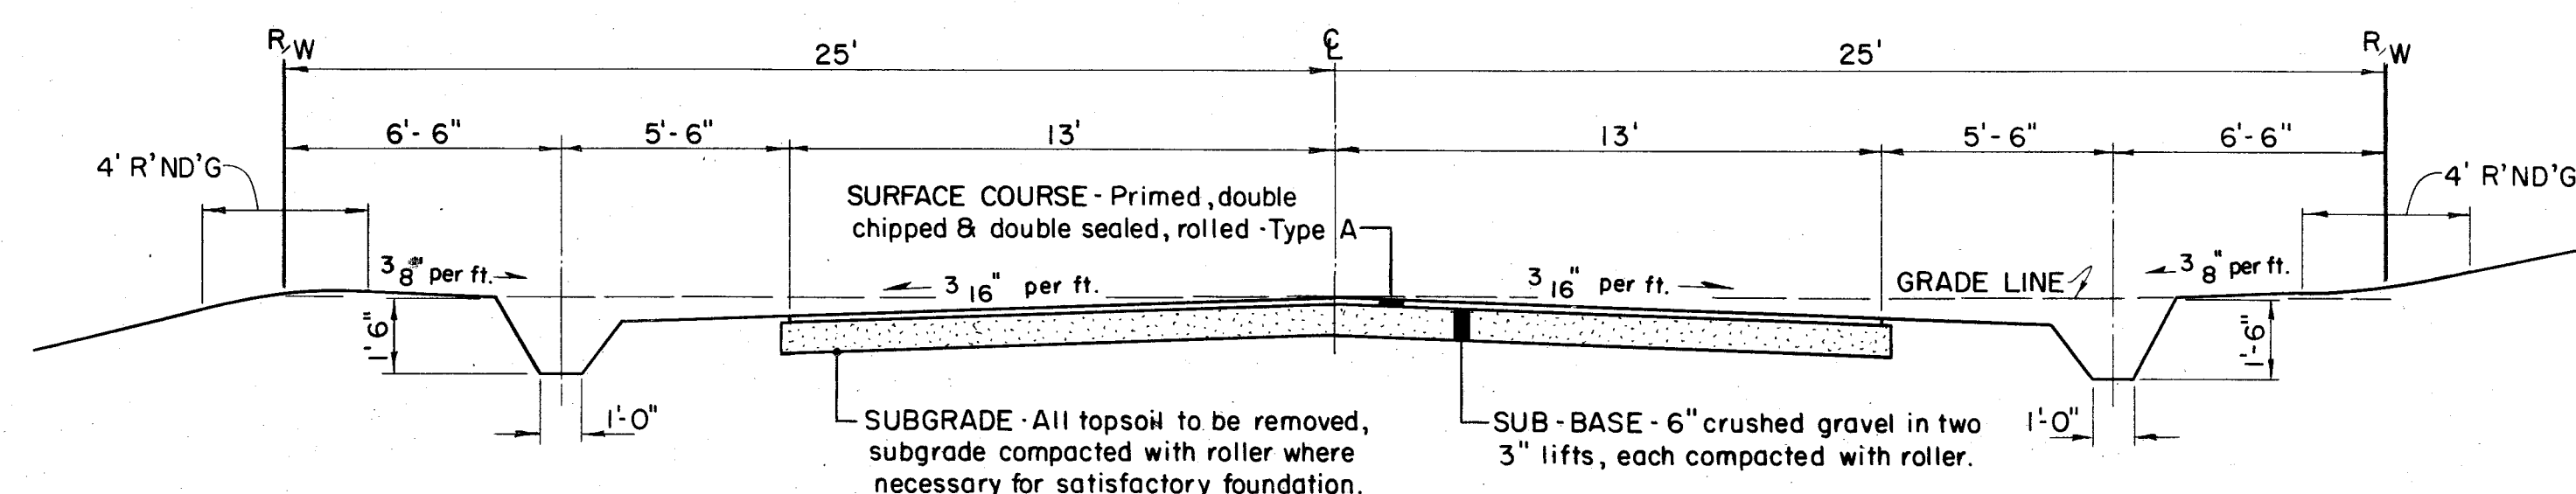


TYPICAL SECTION


AS BUILT SANITARY SEWER PLAN JUNE, 1970

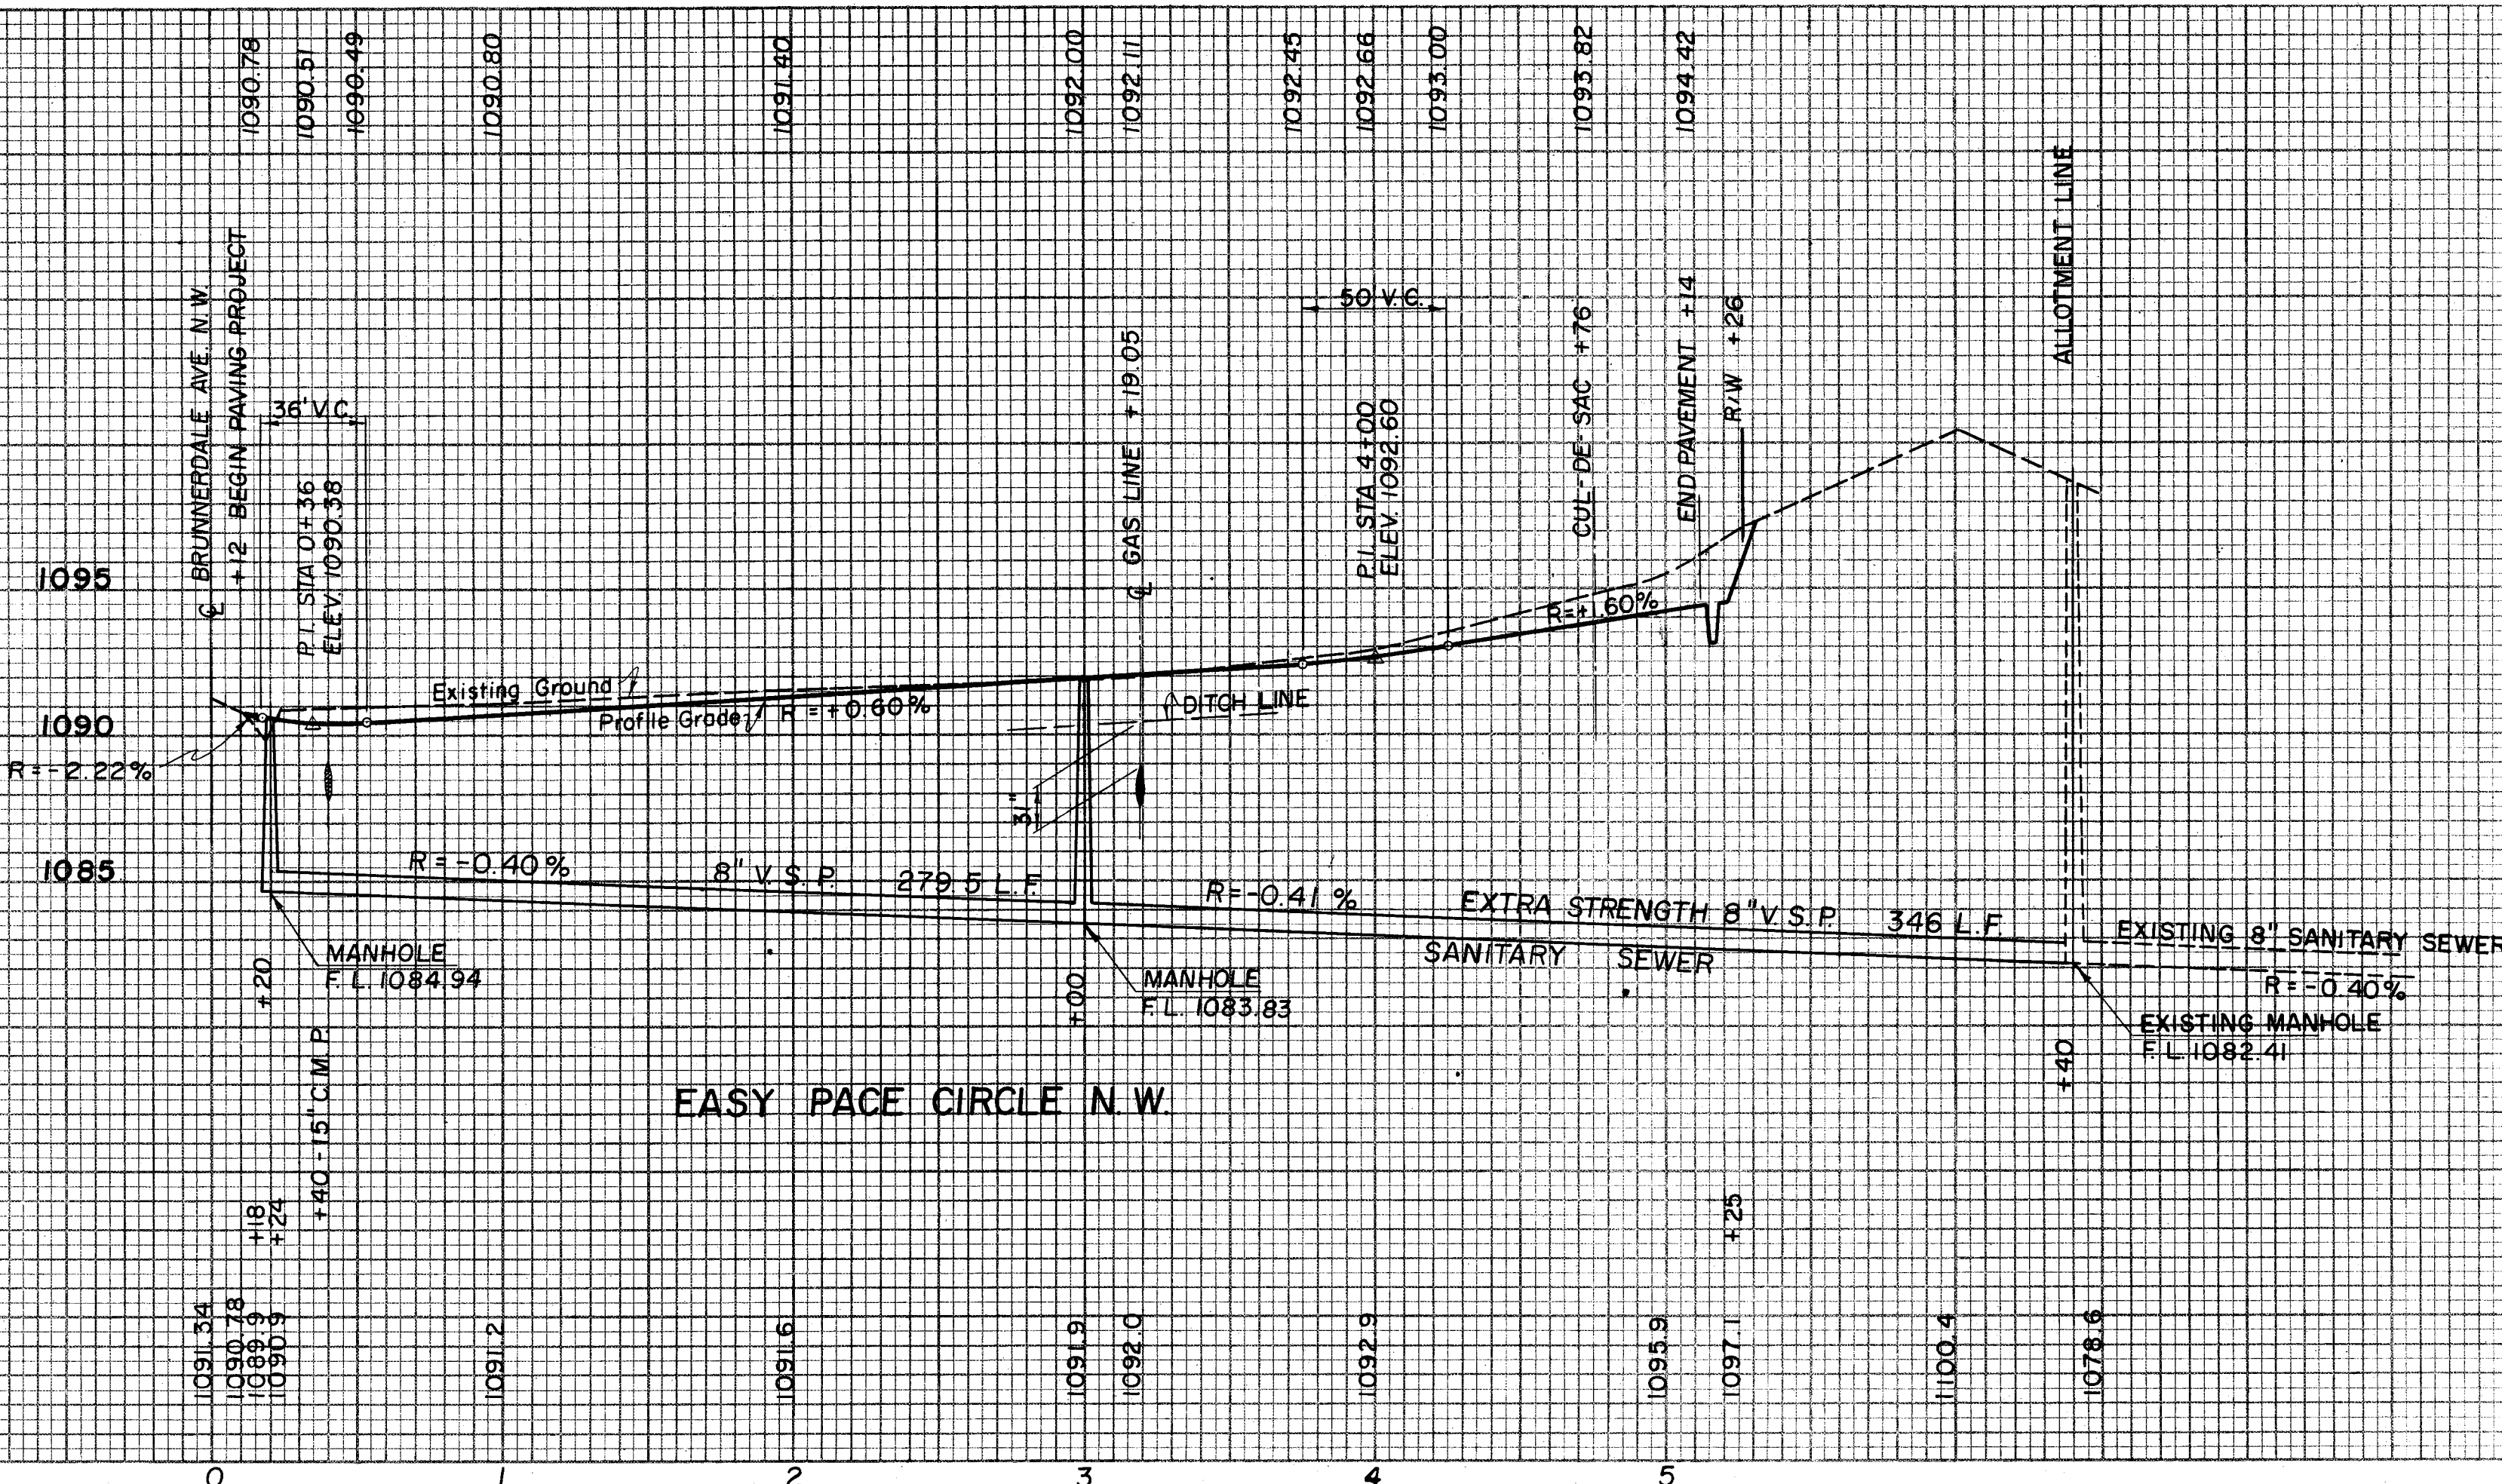


FINAL SURVEY	BY	DATE
SURVEYED		
PLOTTED		
TEMPLATE		
NOTE BOOK		
AREAS CHECKED		
NO.		

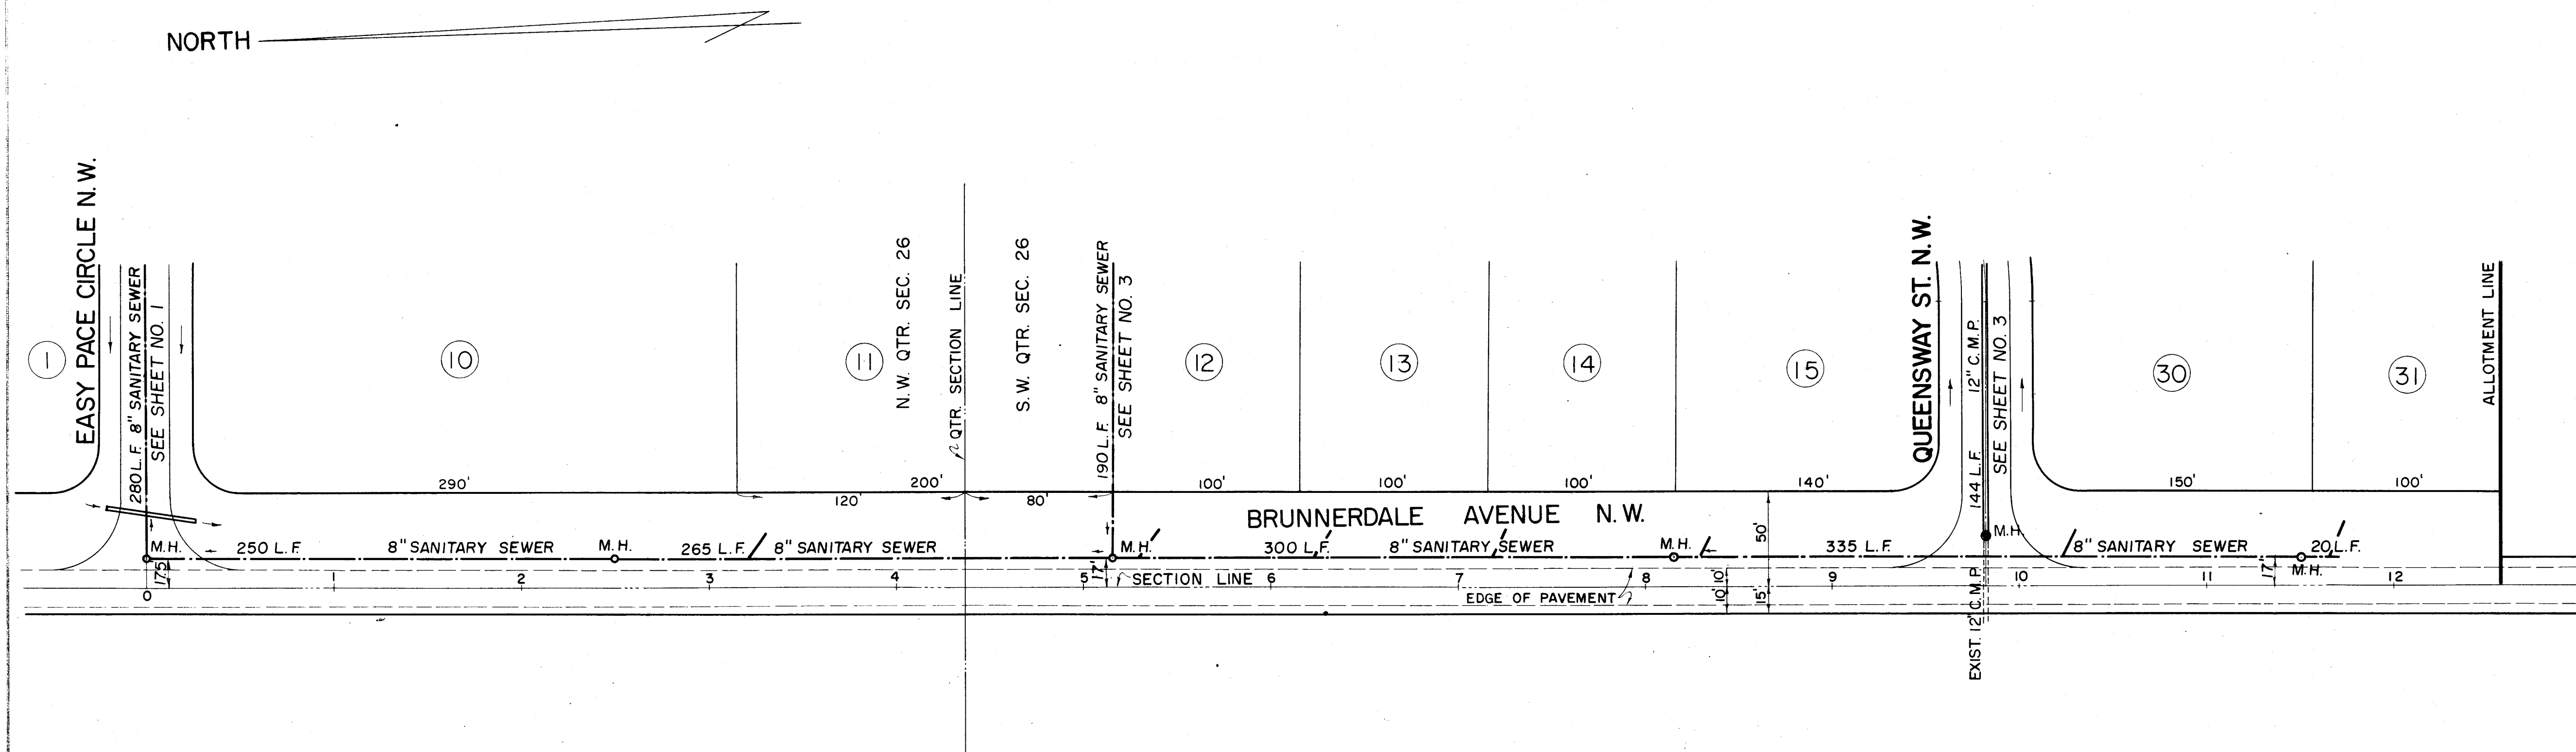

ORIGINAL SURVEY	BY	DATE
SURVEYED		
PLOTTED		
TEMPLATE		
NOTE BOOK		
AREAS CHECKED		
NO.		

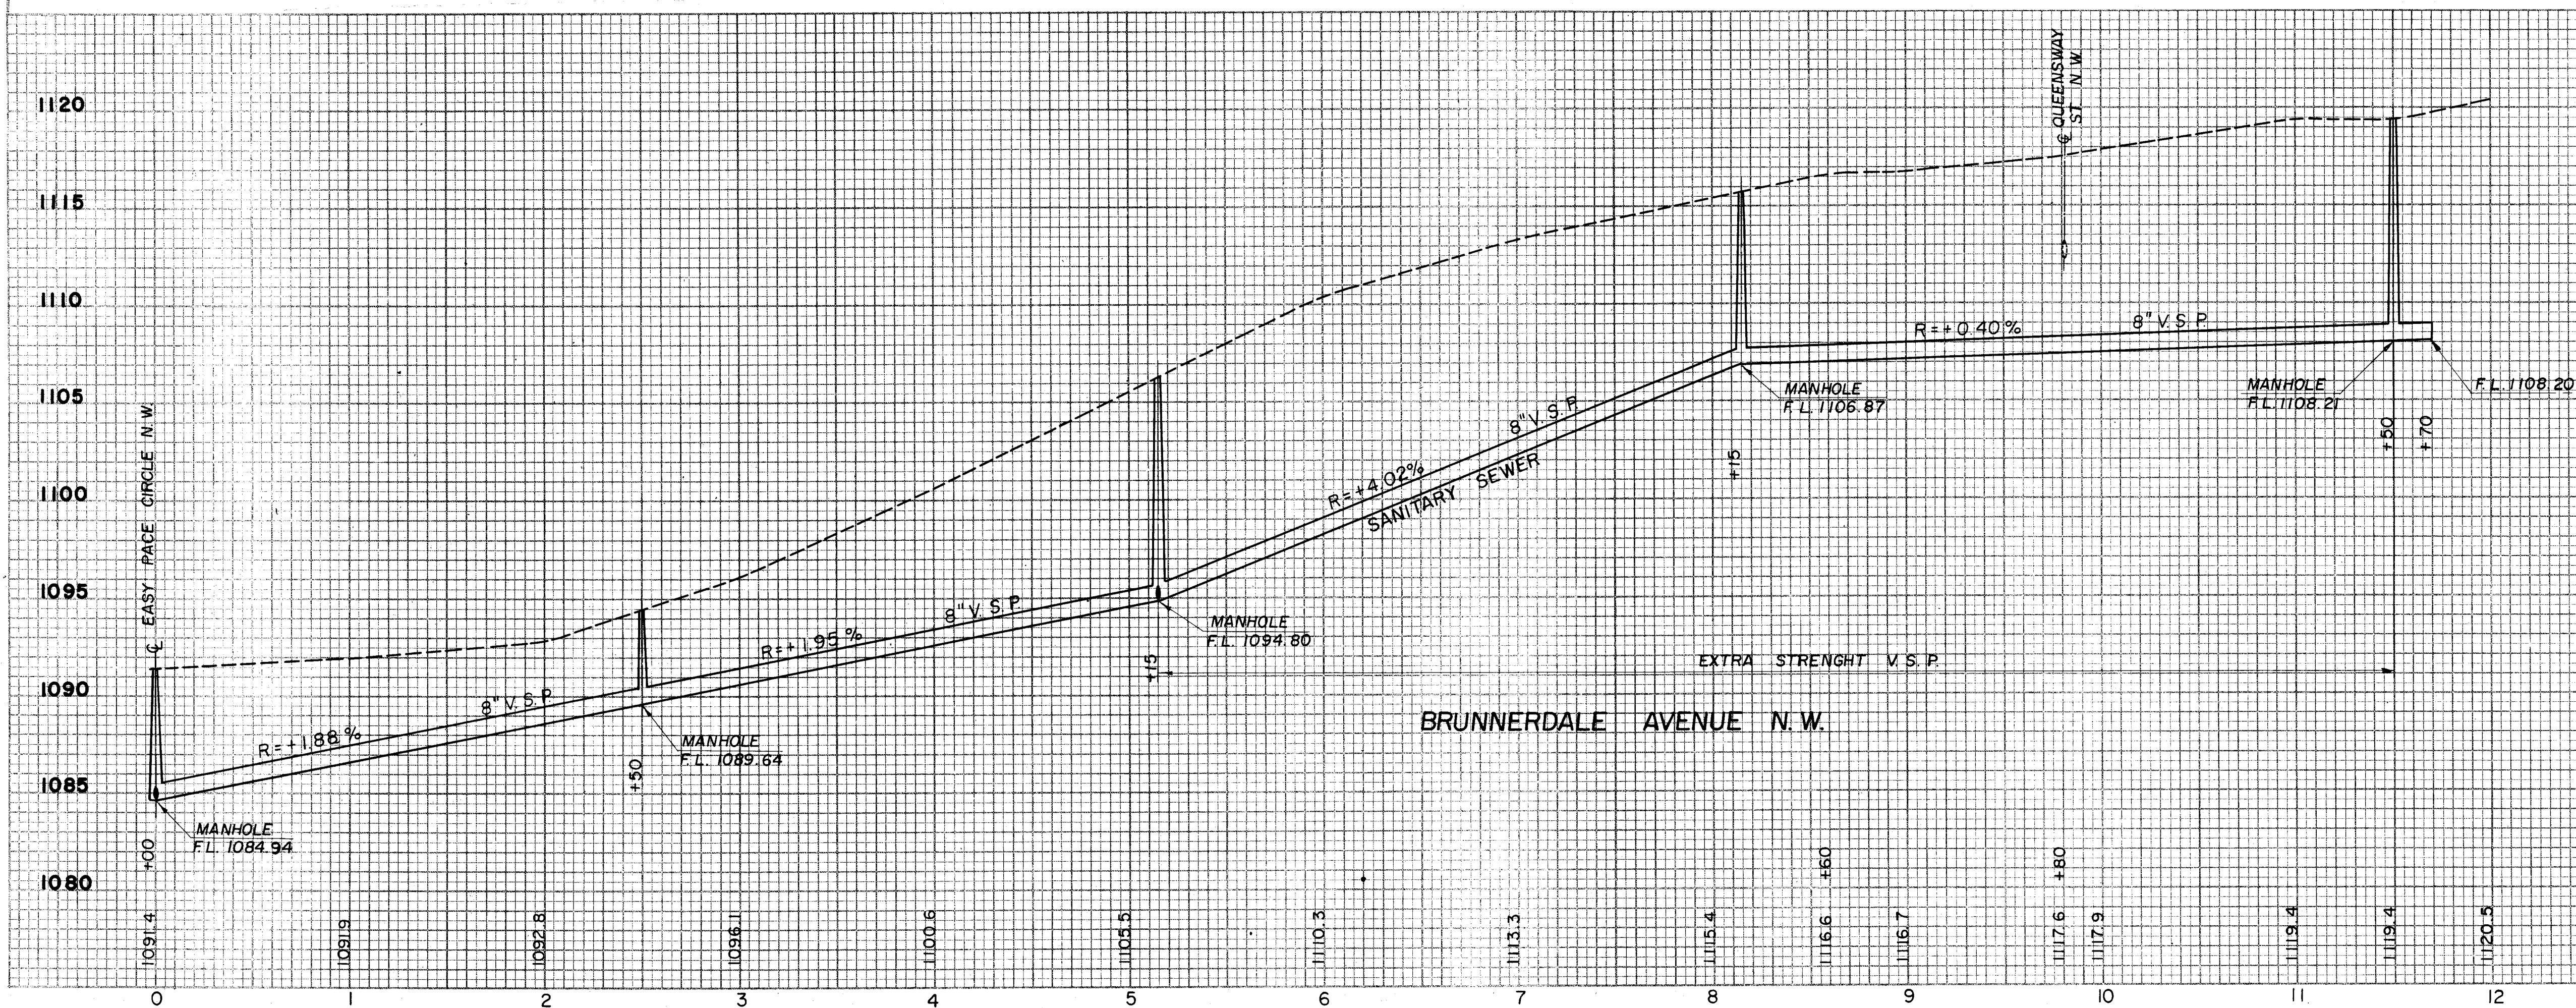

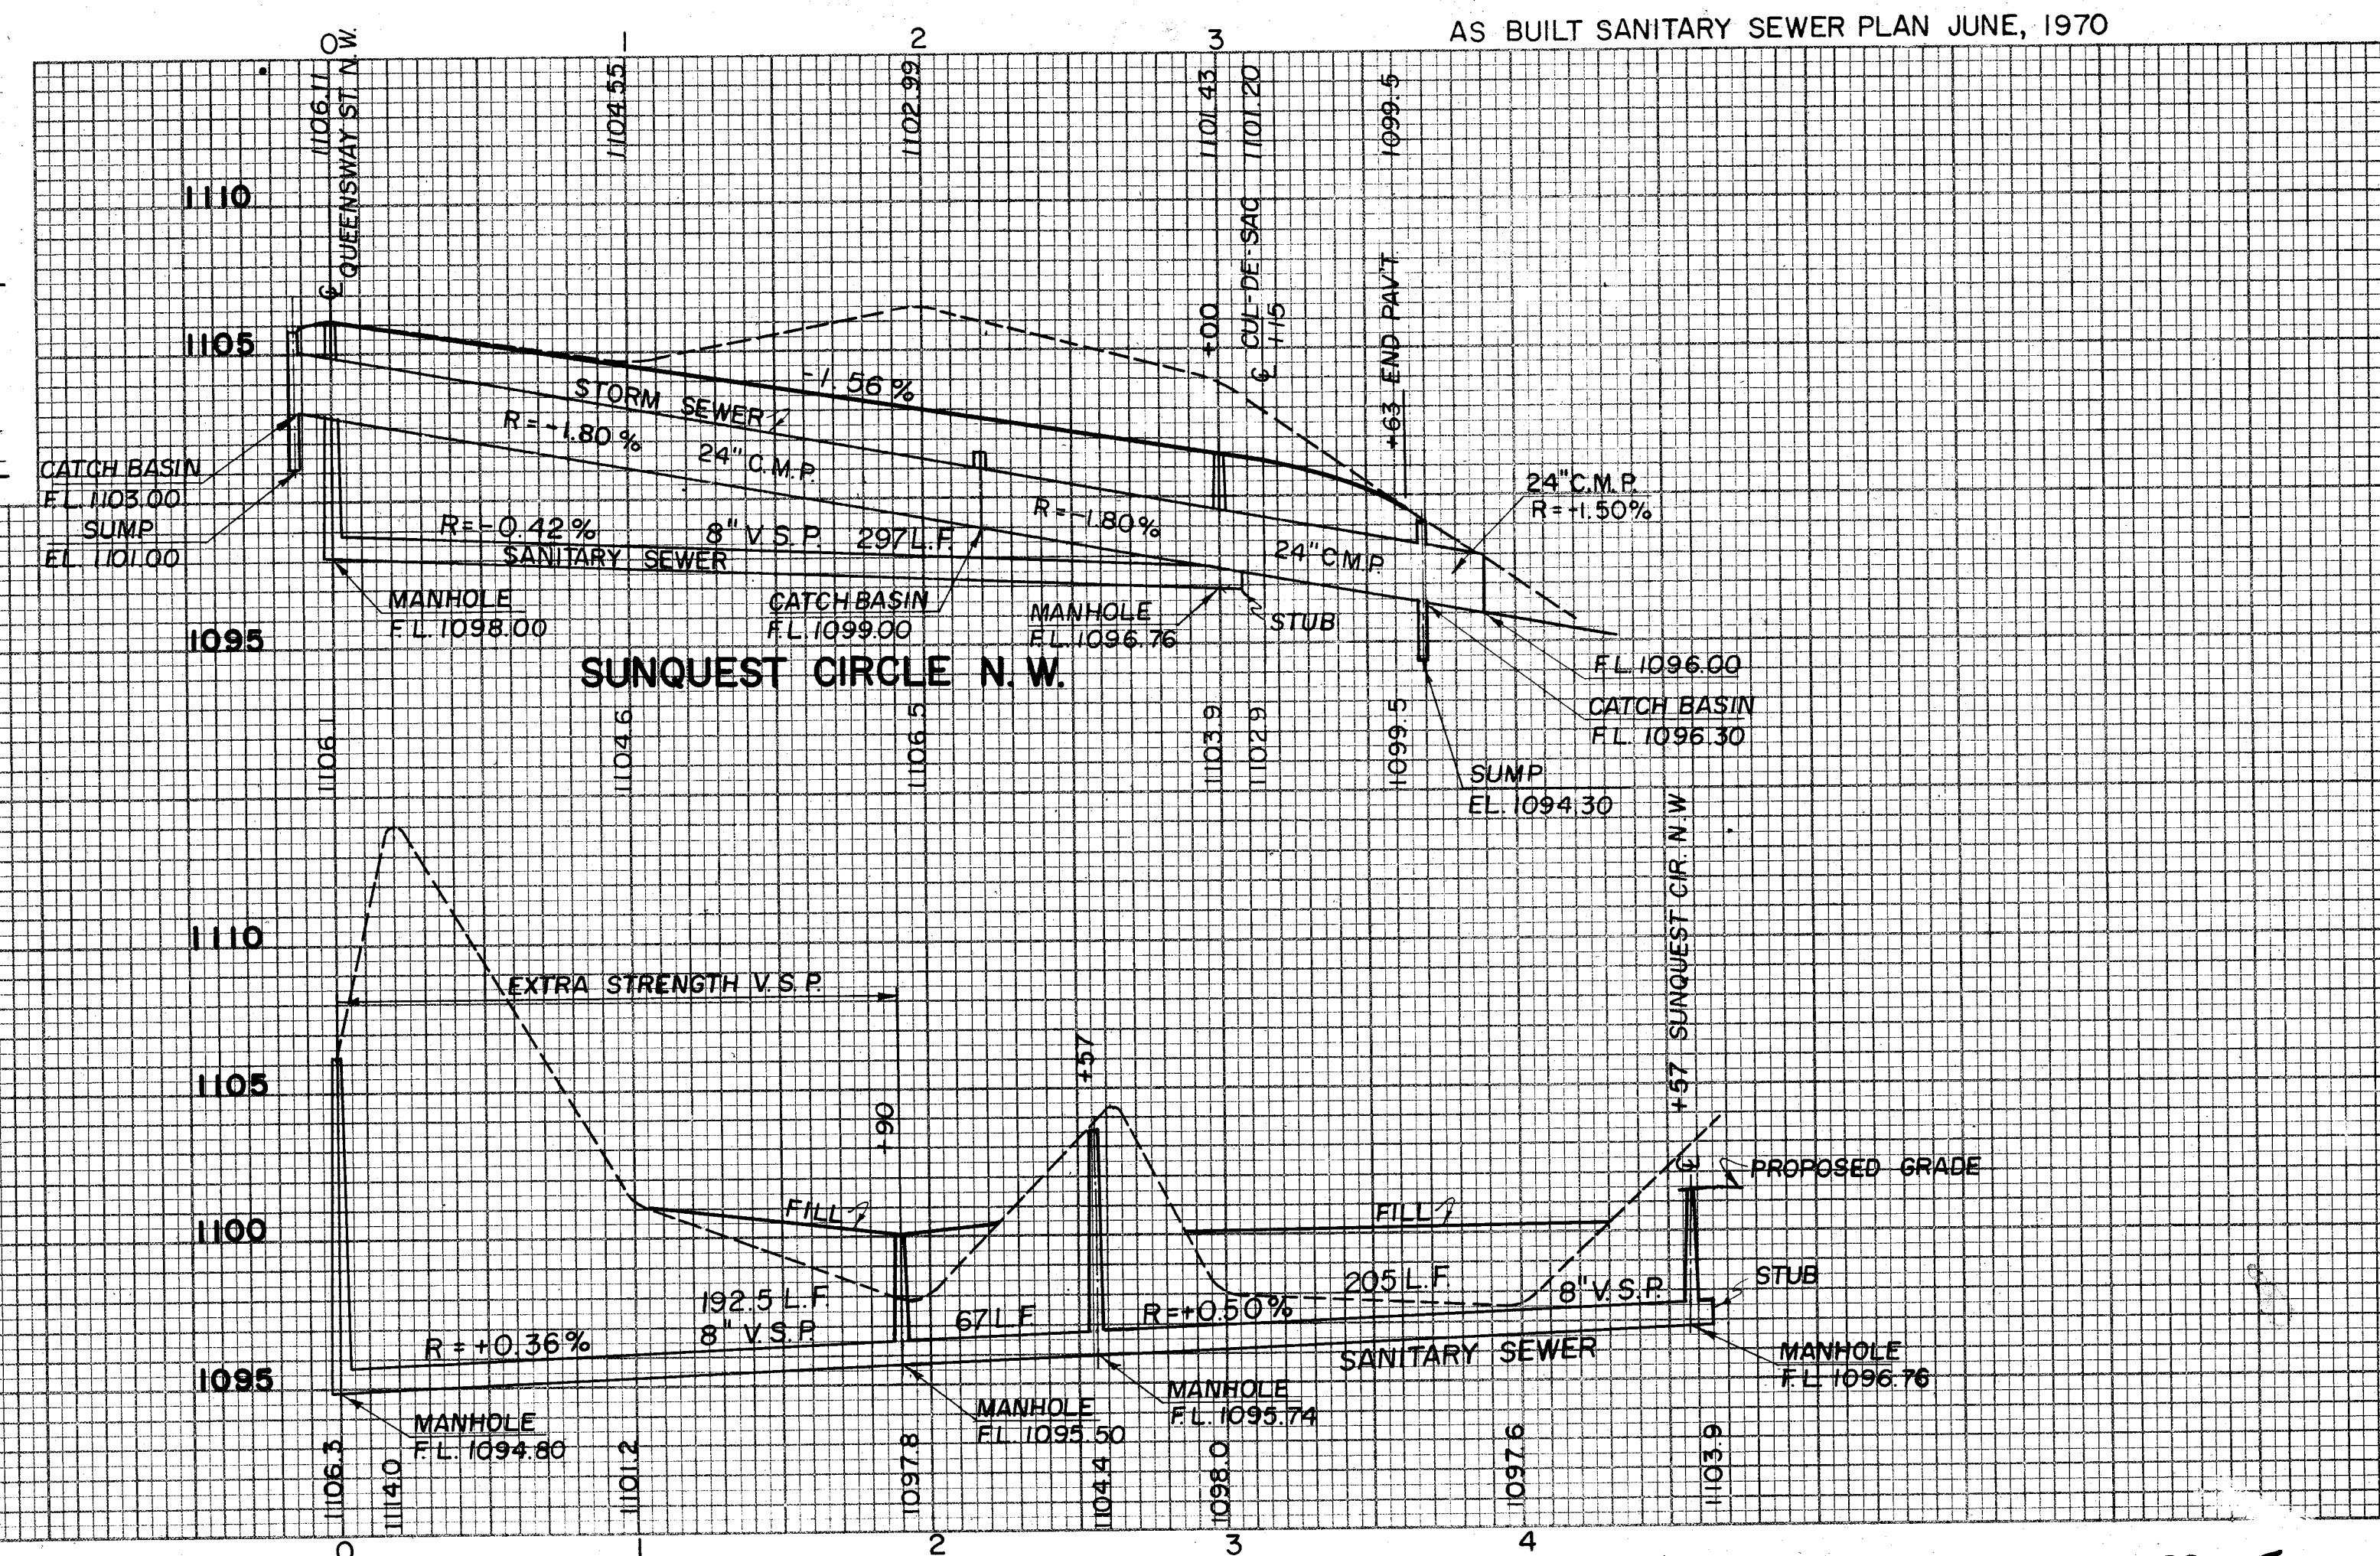

PLAN	DATE	BY
	REVISION	
	NOTED	
	NOTE BOOK	

APPROVED BY THE STARK COUNTY SANITARY ENGINEER THIS
DAY OF 19

STARK COUNTY SANITARY ENGINEER


APPROVED BY THE MASSILLON CITY ENGINEER THIS
DAY OF 19

MASSILLON CITY ENGINEER

T.B.M. No 5
N. RIM OF CONC. M.H. AT S.E. CORNER
OF TREATMENT PLANT 3' SOUTH OF
FENCE AROUND PLANT.
ELEV. 1091.150

T.B.M. No 1
RAILROAD SPIKE 1' UP SOUTH SIDE AND
POWER POLE WEST OF BRUNNERDALE
AVE. ALONG POLE LINE BETWEEN CORN
FIELD & HAY FIELD
ELEV. 1088.62

PROFILE	DATE	BY
	REVISION	
	NOTED	
	NOTE BOOK	

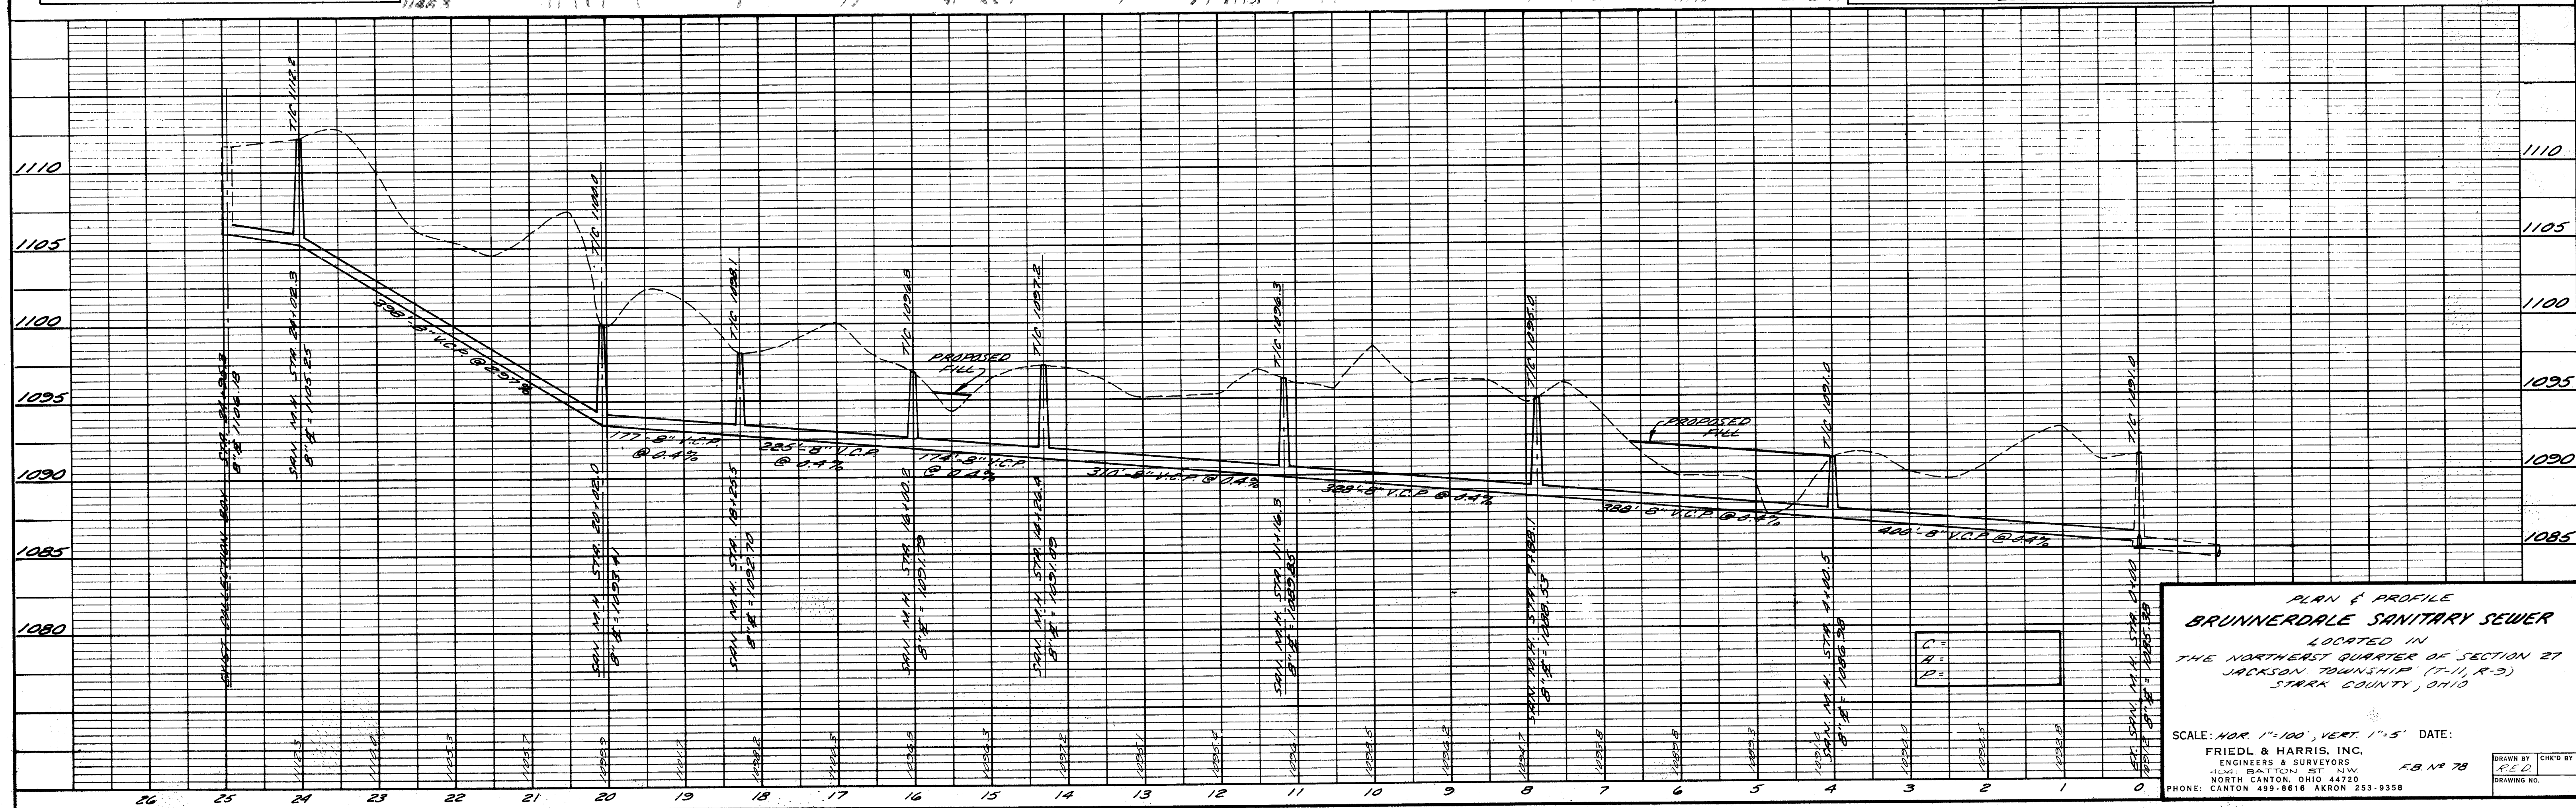

PLAN & PROFILE
BRUNNERDALE SANITARY SEWER
LOCATED IN
THE NORTHEAST QUARTER OF SECTION 27
JACKSON TOWNSHIP (T-11, R-9)
STARK COUNTY, OHIO

SCALE: HOR. 1"=100', VERT. 1"=5' DATE:

FRIEDL & HARRIS, INC.
ENGINEERS & SURVEYORS
1004 BATTON ST. N.W.
NORTH CANTON, OHIO 44720
PHONE: CANTON 499-8616 AKRON 253-9358

FB NR 78
DRAWN BY
CHECKED BY
DATE