


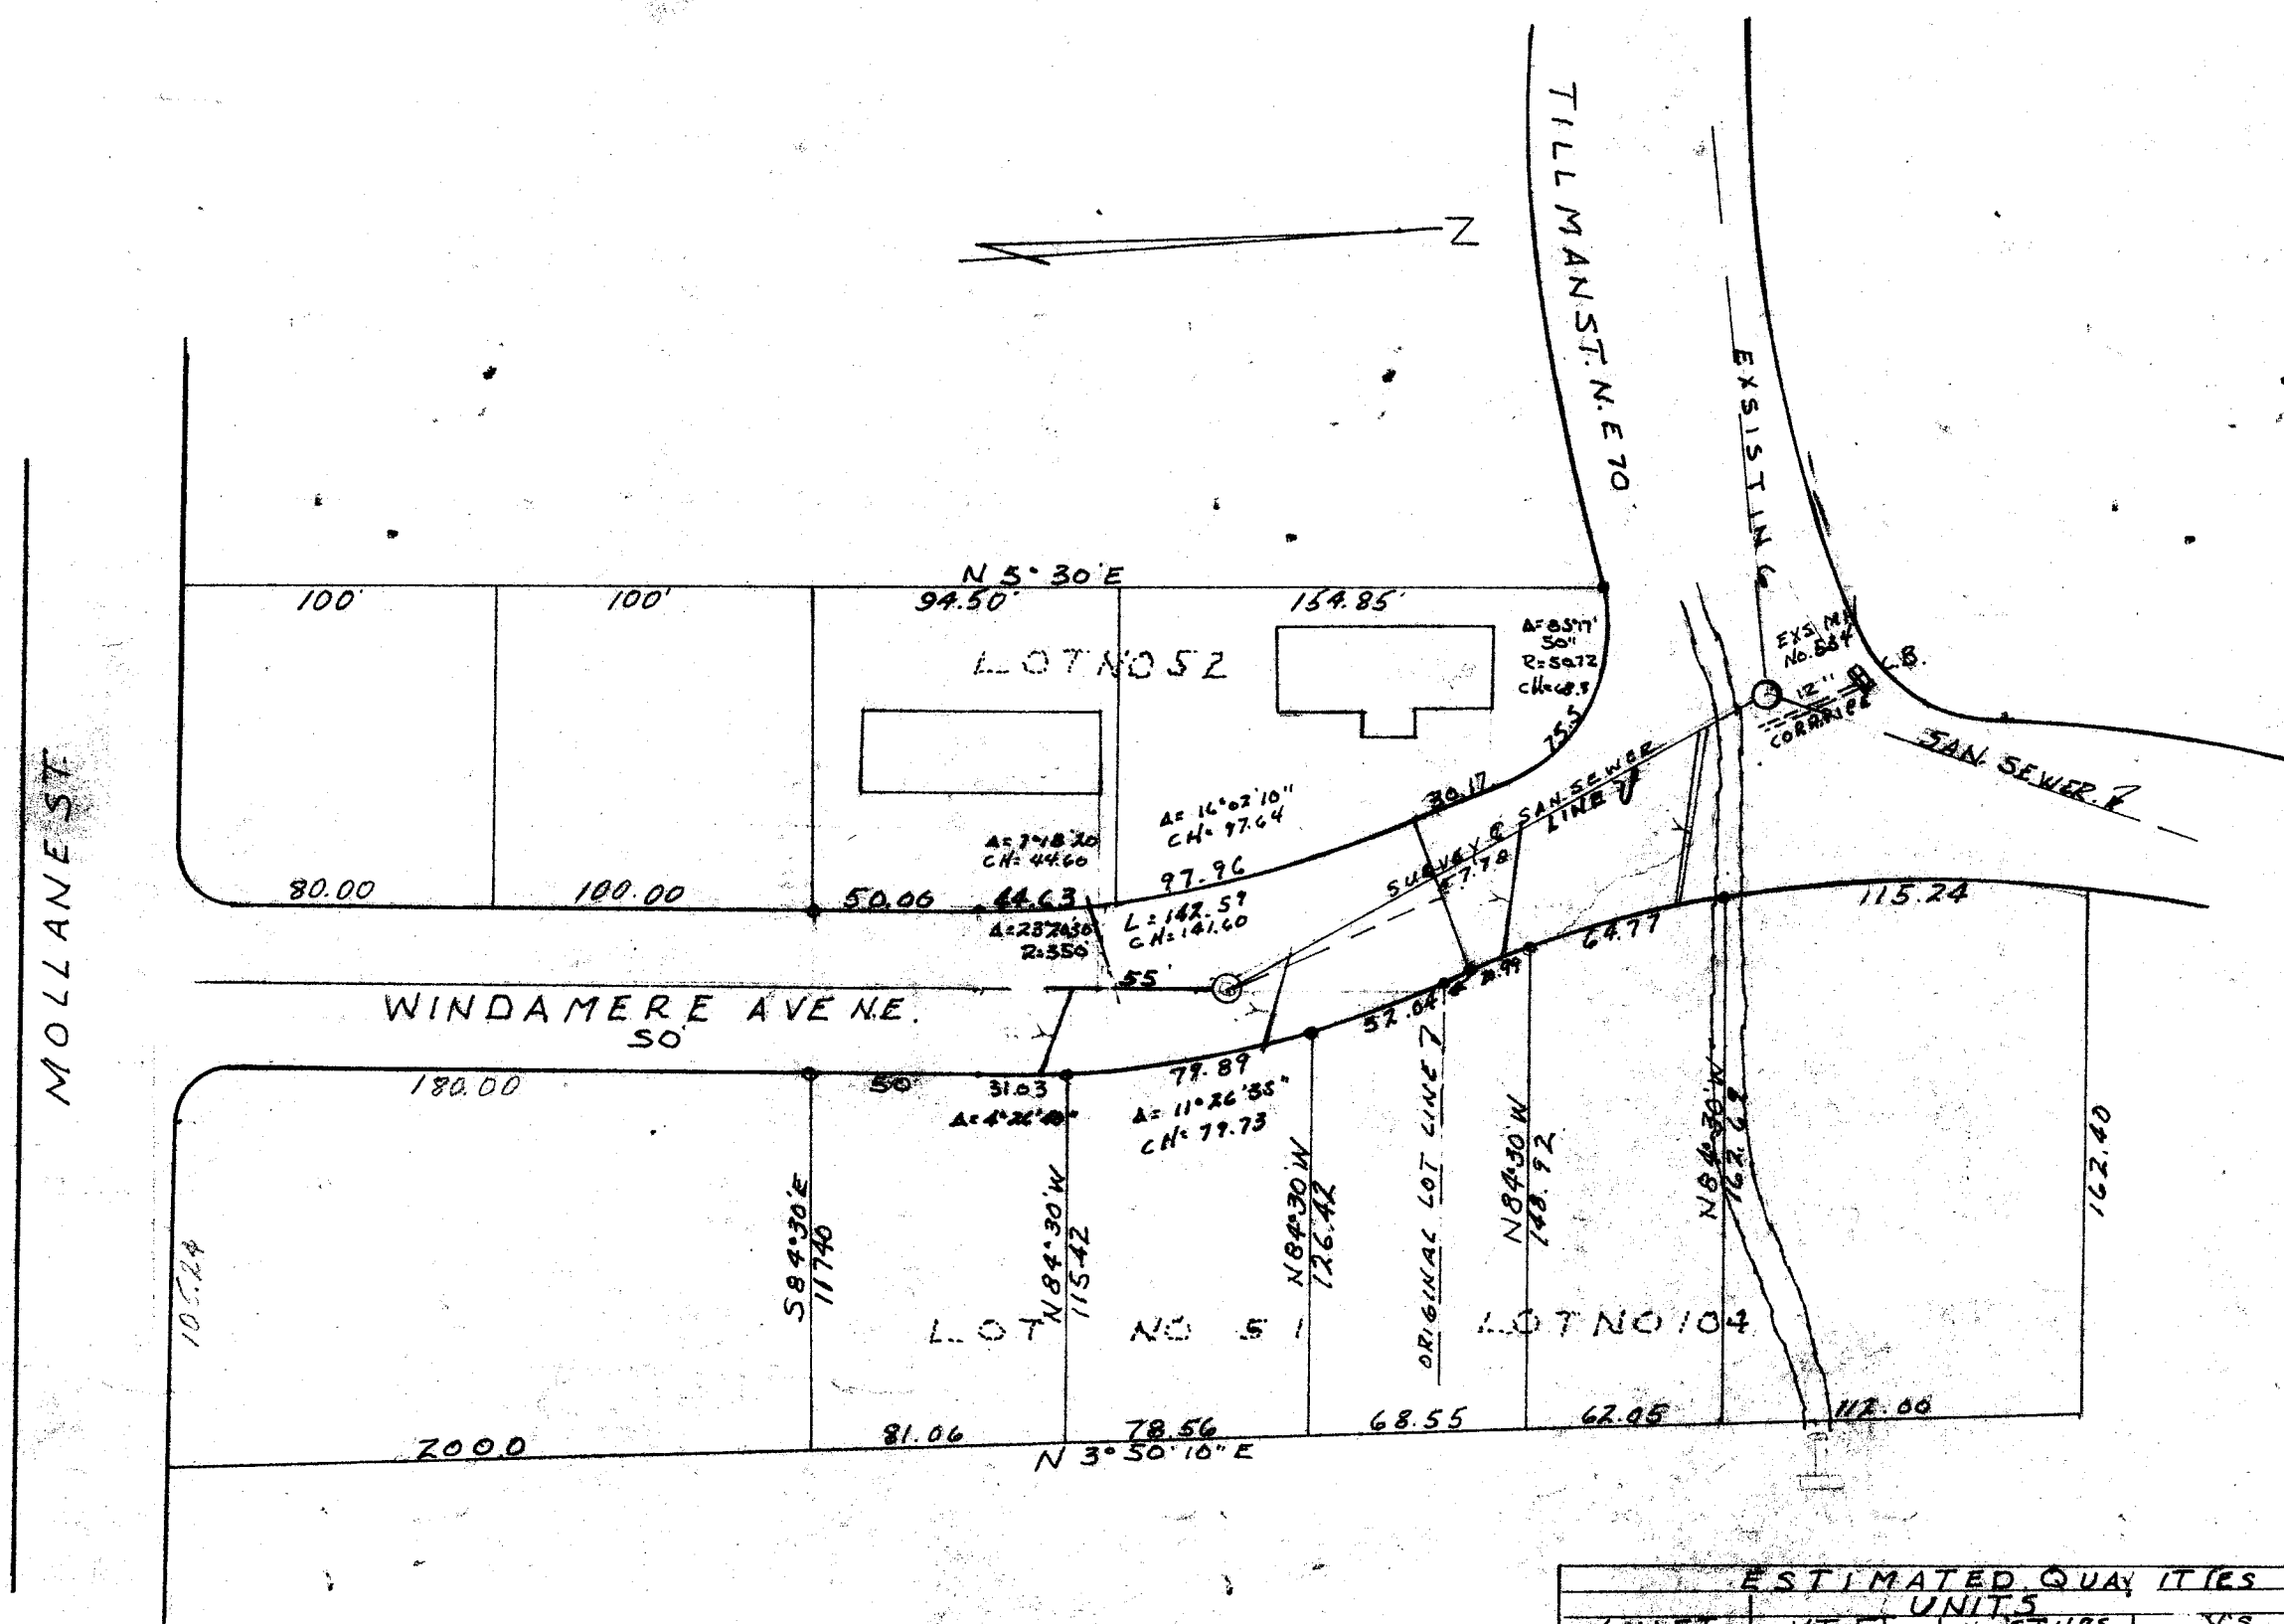

PROPOSED
SANITARY SEWER EXTENSION
FROM EXISTING SANITARY MH No 534
SOUTHEASTWARDLY TO WINDAMERE AVENUE.
SCALE 1"=10' ^{60' HORIZ.} APRIL 1970
THEO. C. BOLDT & WM. K. GALLIGHER
REG. SURVEYORS

ESTIMATED QUANTITIES				
UNITS				
LINE ITEM	MT. FT.	SQUARE	Y.S.	LINE ITEM
APPENDIX B	MR. G. HICK	8"	6"	6" LATERAL
245.2	6' FT.	ONE	5	187 ²


T. ADAMS
DEVELOPER

FINAL MEAST ELEV'S ARE
SHOWN IN RED
WWRG 7-20-76

APPROVED THIS 15th DAY OF MAY 1970

B

RG Hunsinger
STARK COUNTY SAN. ENGINEER

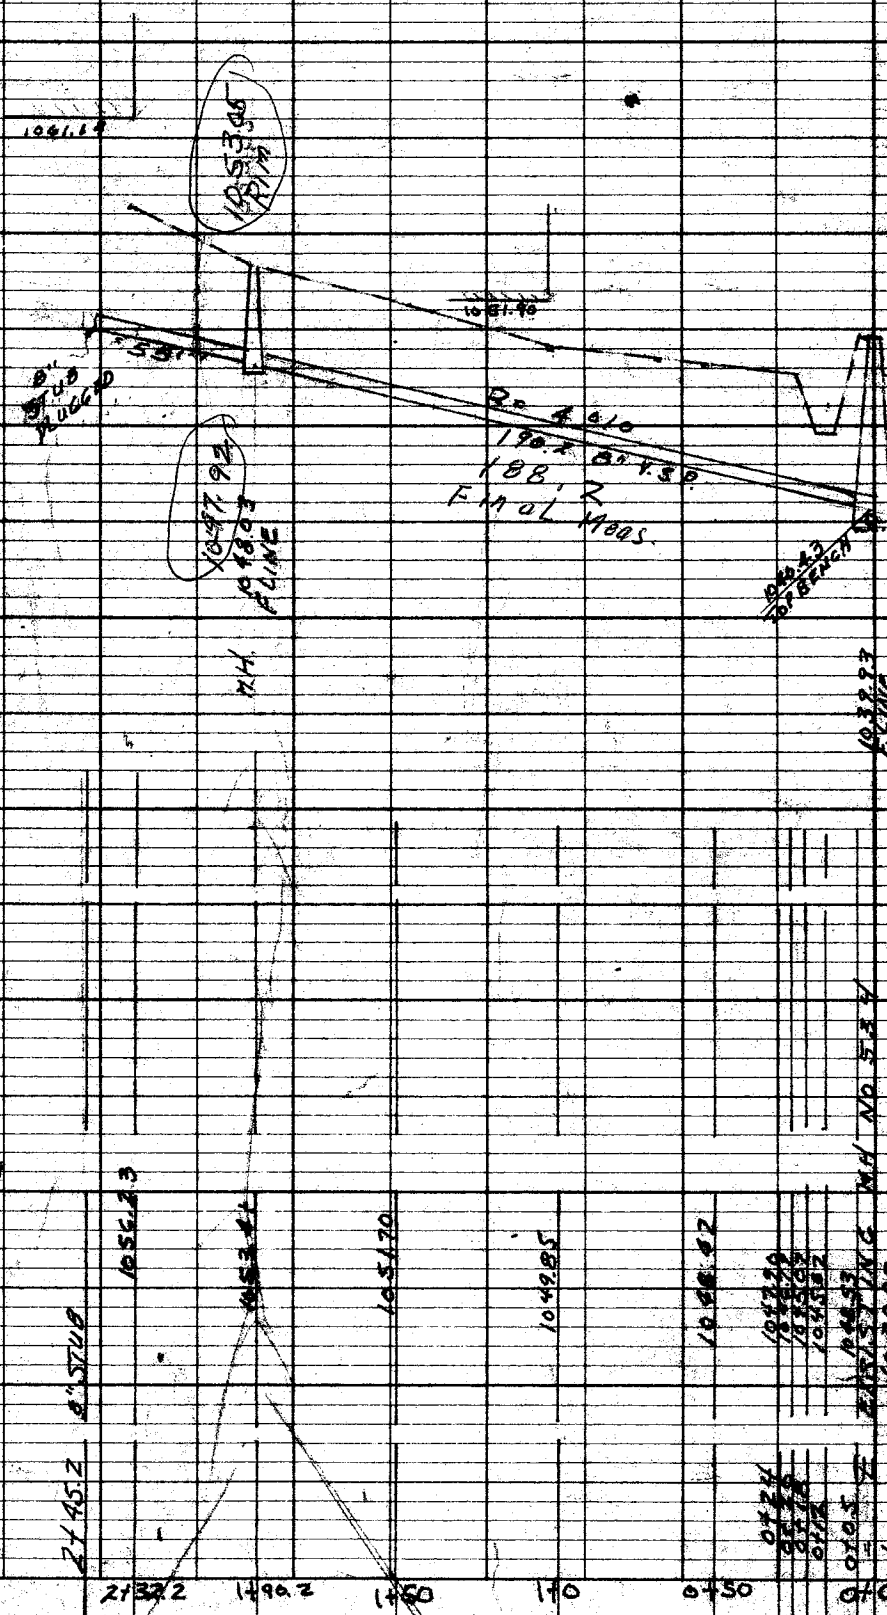[illegible]

No.	2181031002	CHECKED
MOLE BOOK	B' W' 2 MOLED	
BOOK	GRADE2 CHECKED	
	MOLED	
	2181031002	