

STARK COUNTY METROPOLITAN SEWER DISTRICT PROJECT NO. 429 SANITARY SEWERS

CONTRACT I (EPA C390752-02)

CITY OF MASSILLON-JACKSON TOWNSHIP

STARK COUNTY, OHIO - 1981

• APPROVALS •

APPROVED BY:

DATE:

MASSILLON SAFETY & SERVICE DIRECTOR

MASSILLON CITY ENGINEER

• STARK COUNTY COMMISSIONERS •

PRESIDENT

MEMBER

MEMBER

STARK COUNTY SANITARY ENGINEER


• LIST OF DRAWINGS •

DESCRIPTION	DWG. NO.
TITLE SHEET	1
INDEX OF SHEETS AND SERVICE BRANCH SCHEDULE	2
SOIL BORING LOCATIONS	3
STA. 0+00 TO LAKE AVENUE	4
KRACKER STREET TO STA. 16+45	5
CANAL TRUNK TO STA. 22+85	6
STA. 22+85 TO STA. 35+10	7
STA. 35+10 TO STA. 47+55	8
STA. 47+55 TO STA. 61+20	9
STA. 61+20 TO STA. 73+50	10
STA. 73+50 TO STA. 76+58	11
STORM OUTFALL PLAN AND PROFILE & STANDARD DETAILS	12
STANDARD DETAIL SHEET	13
STANDARD DETAIL SHEET	14

NOTE

ROOF DRAINS, FOUNDATION DRAINS AND OTHER CLEAN WATER CONNECTIONS TO THE SANITARY SEWER SYSTEM ARE PROHIBITED.

THIS SYMBOL INDICATES A CRITICAL BASEMENT THAT HAS INFLUENCED THE ELEVATION OF THE MAIN LINE SEWER. SPECIAL ATTENTION MUST BE EXERCISED REGARDING LATERAL LOCATION AND GRADE AT THE TIME OF CONSTRUCTION TO INSURE PROPER CONNECTION OF THE HOUSE LATERAL.

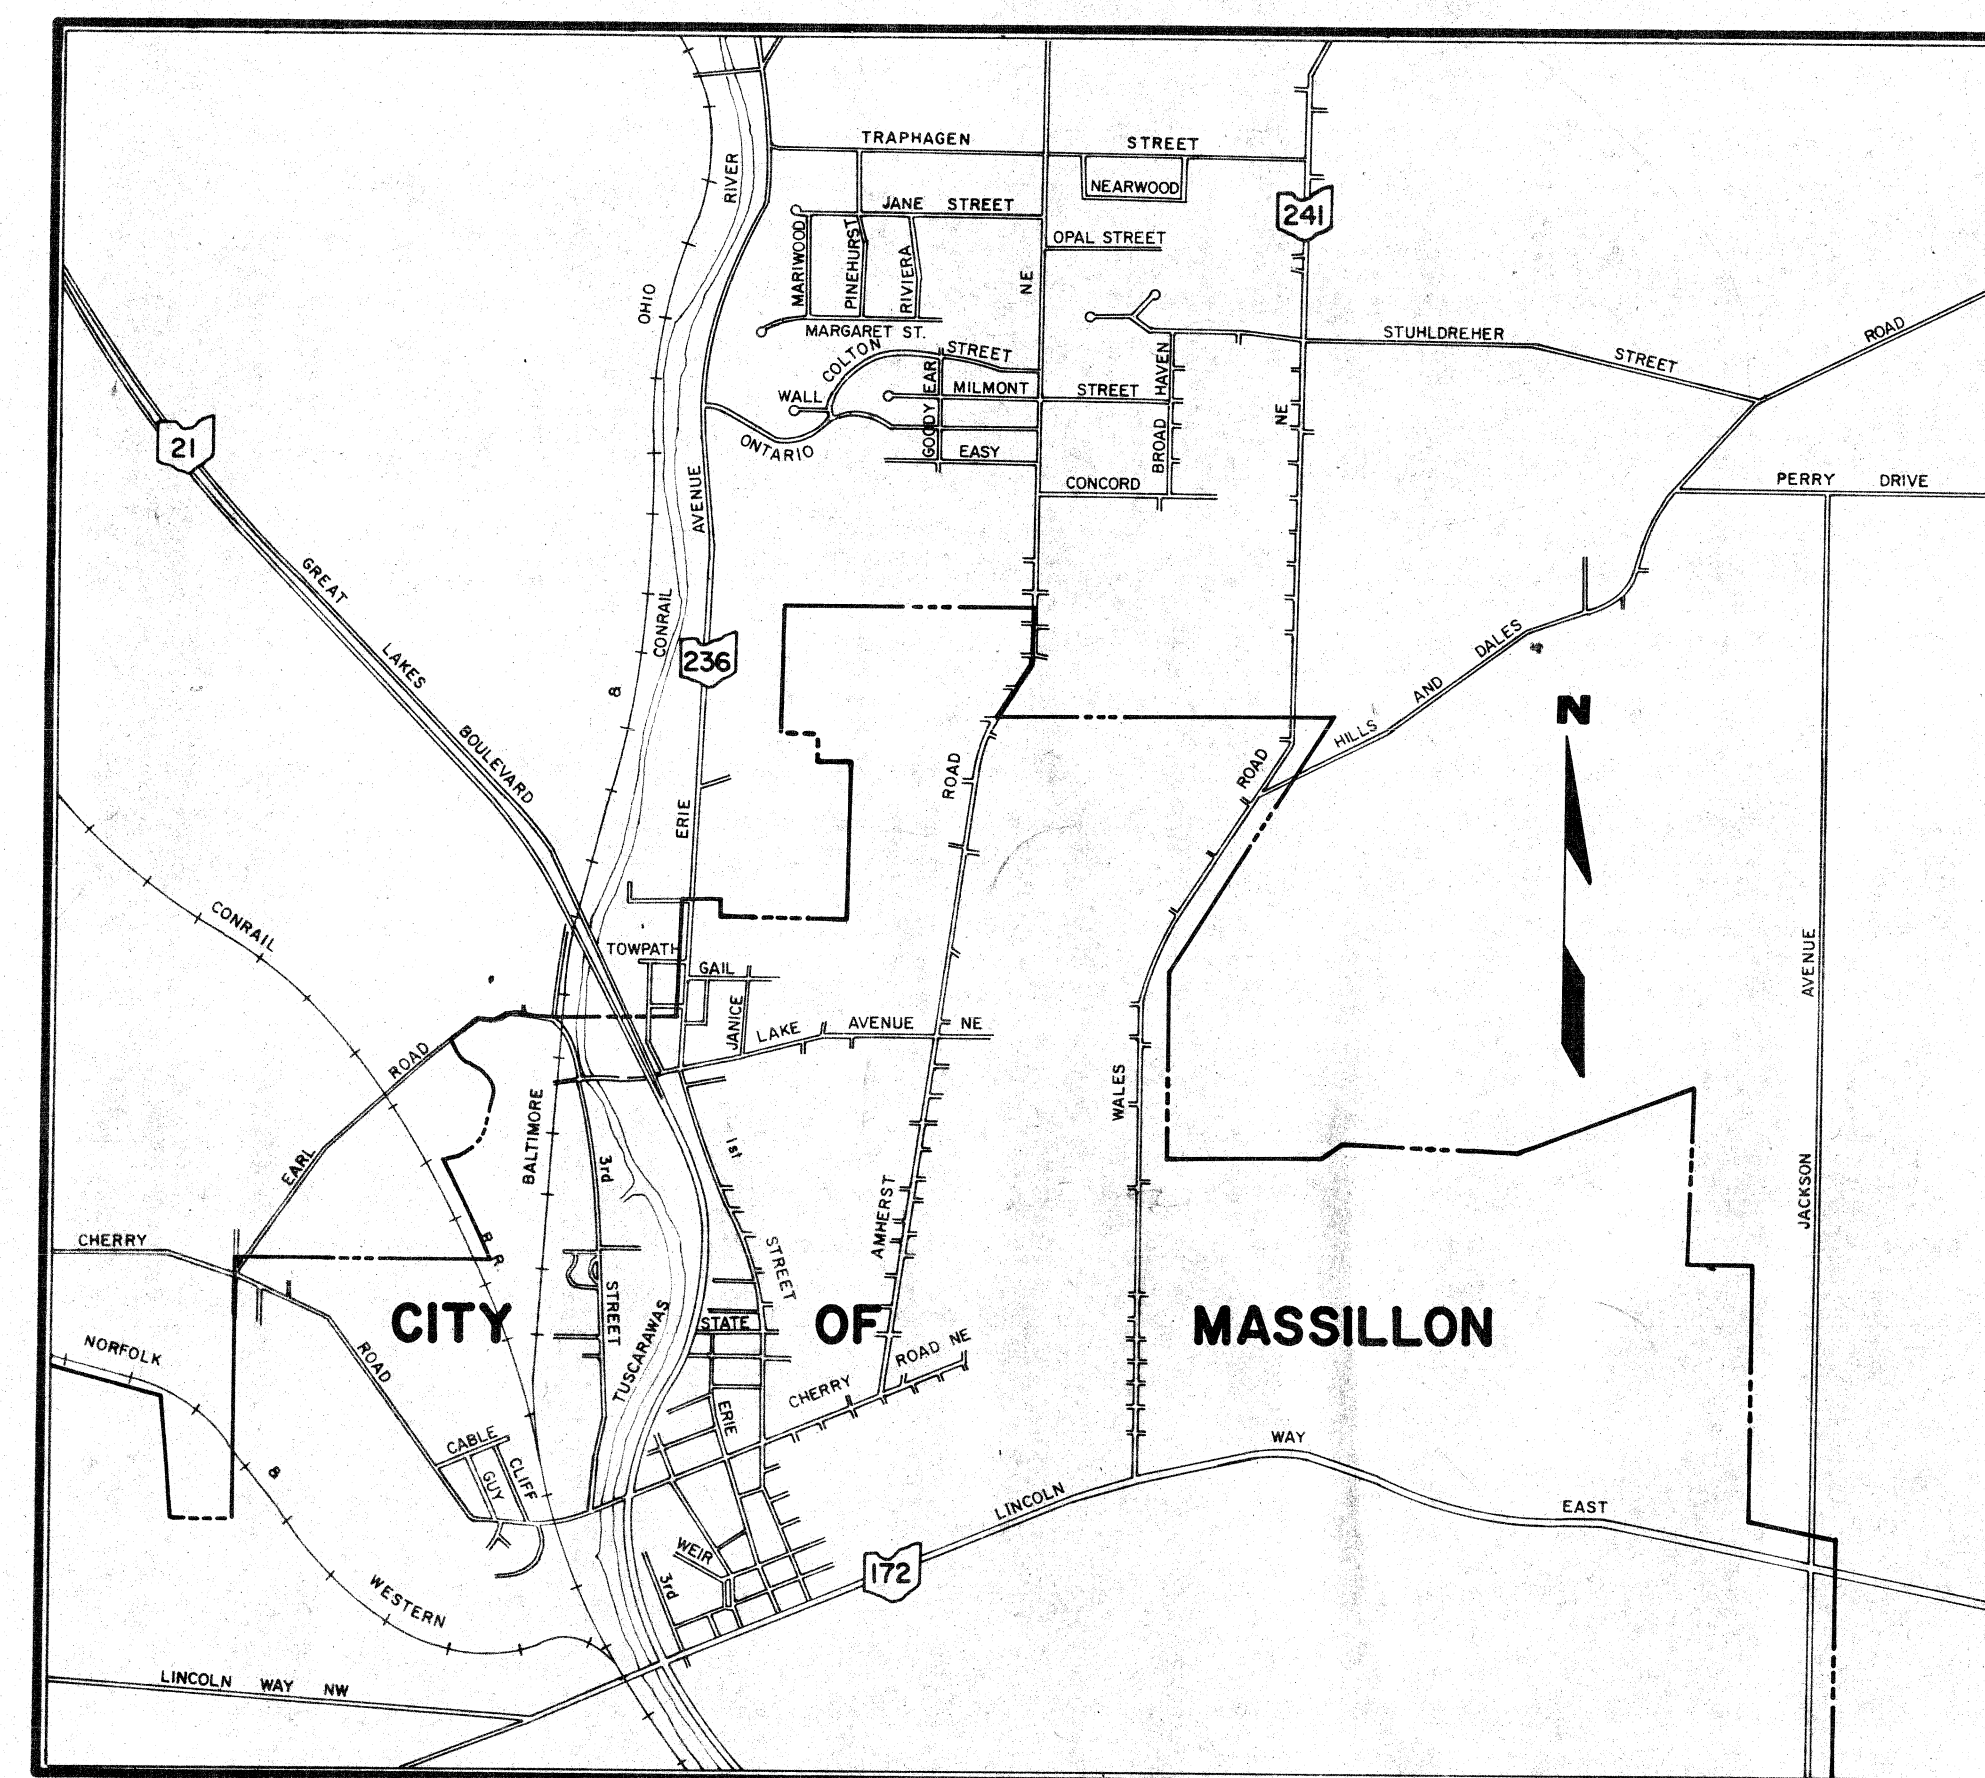

LOCATION MAP
0 1000 2000 3000 4000 5000 6000
SCALE IN FEET

• STARK COUNTY OFFICIALS •

COMMISSIONER NORMAN W. SPONSELLER
COMMISSIONER RICHARD D. WATKINS
COMMISSIONER JERRY PATRICK
COUNTY ADMINISTRATOR ROBERT A. FONTE
COUNTY SANITARY ENGINEER MICHAEL S. ARMOGIDA
COUNTY AUDITOR WILLIAM BOWMAN
PROSECUTING ATTORNEY JAMES UNGER

• CITY OF MASSILLON OFFICIALS •

MAYOR DELBERT A. DEMMER
DIRECTOR OF SAFETY & SERVICE TED C. WILLOUGHBY
LAW DIRECTOR THOMAS V. FERRERO
AUDITOR BARBARA A. WORKMAN
TREASURER WILLIAM Z. CHRISTOFF
ENGINEER ROBERT WAGONER
WASTE & WASTEWATER SUPT. ROBERT BUSHMAN

• COUNCIL •

PRESIDENT OF COUNCIL RONALD E. MANG
COUNCILMAN-AT-LARGE HELEN MAIER
COUNCILMAN-AT-LARGE FRANCIS H. CICCHINELLI, JR.
COUNCILMAN-AT-LARGE TONY EAGLOWSKI
WARD ONE SONNY SPIELMAN
WARD TWO DAVID P. MOLEDOR
WARD THREE DAVID SMITH
WARD FOUR T. ROY ROBERSON
WARD FIVE MARK BAN BOORHIS
WARD SIX THOMAS D. BRENNAN


• JACKSON TOWNSHIP BOARD OF TRUSTEES •

C. STEPHEN AYERS PATTY MILLER
ALLEN McCLURG

PREPARED BY
FRANK A. THOMAS & ASSOCIATES, INC.
CONSULTING ENGINEERS
WILLOUGHBY - NORTH CANTON, OHIO

FINAL MEAS.

Proj No 429 Cont No 1 FILE No 14

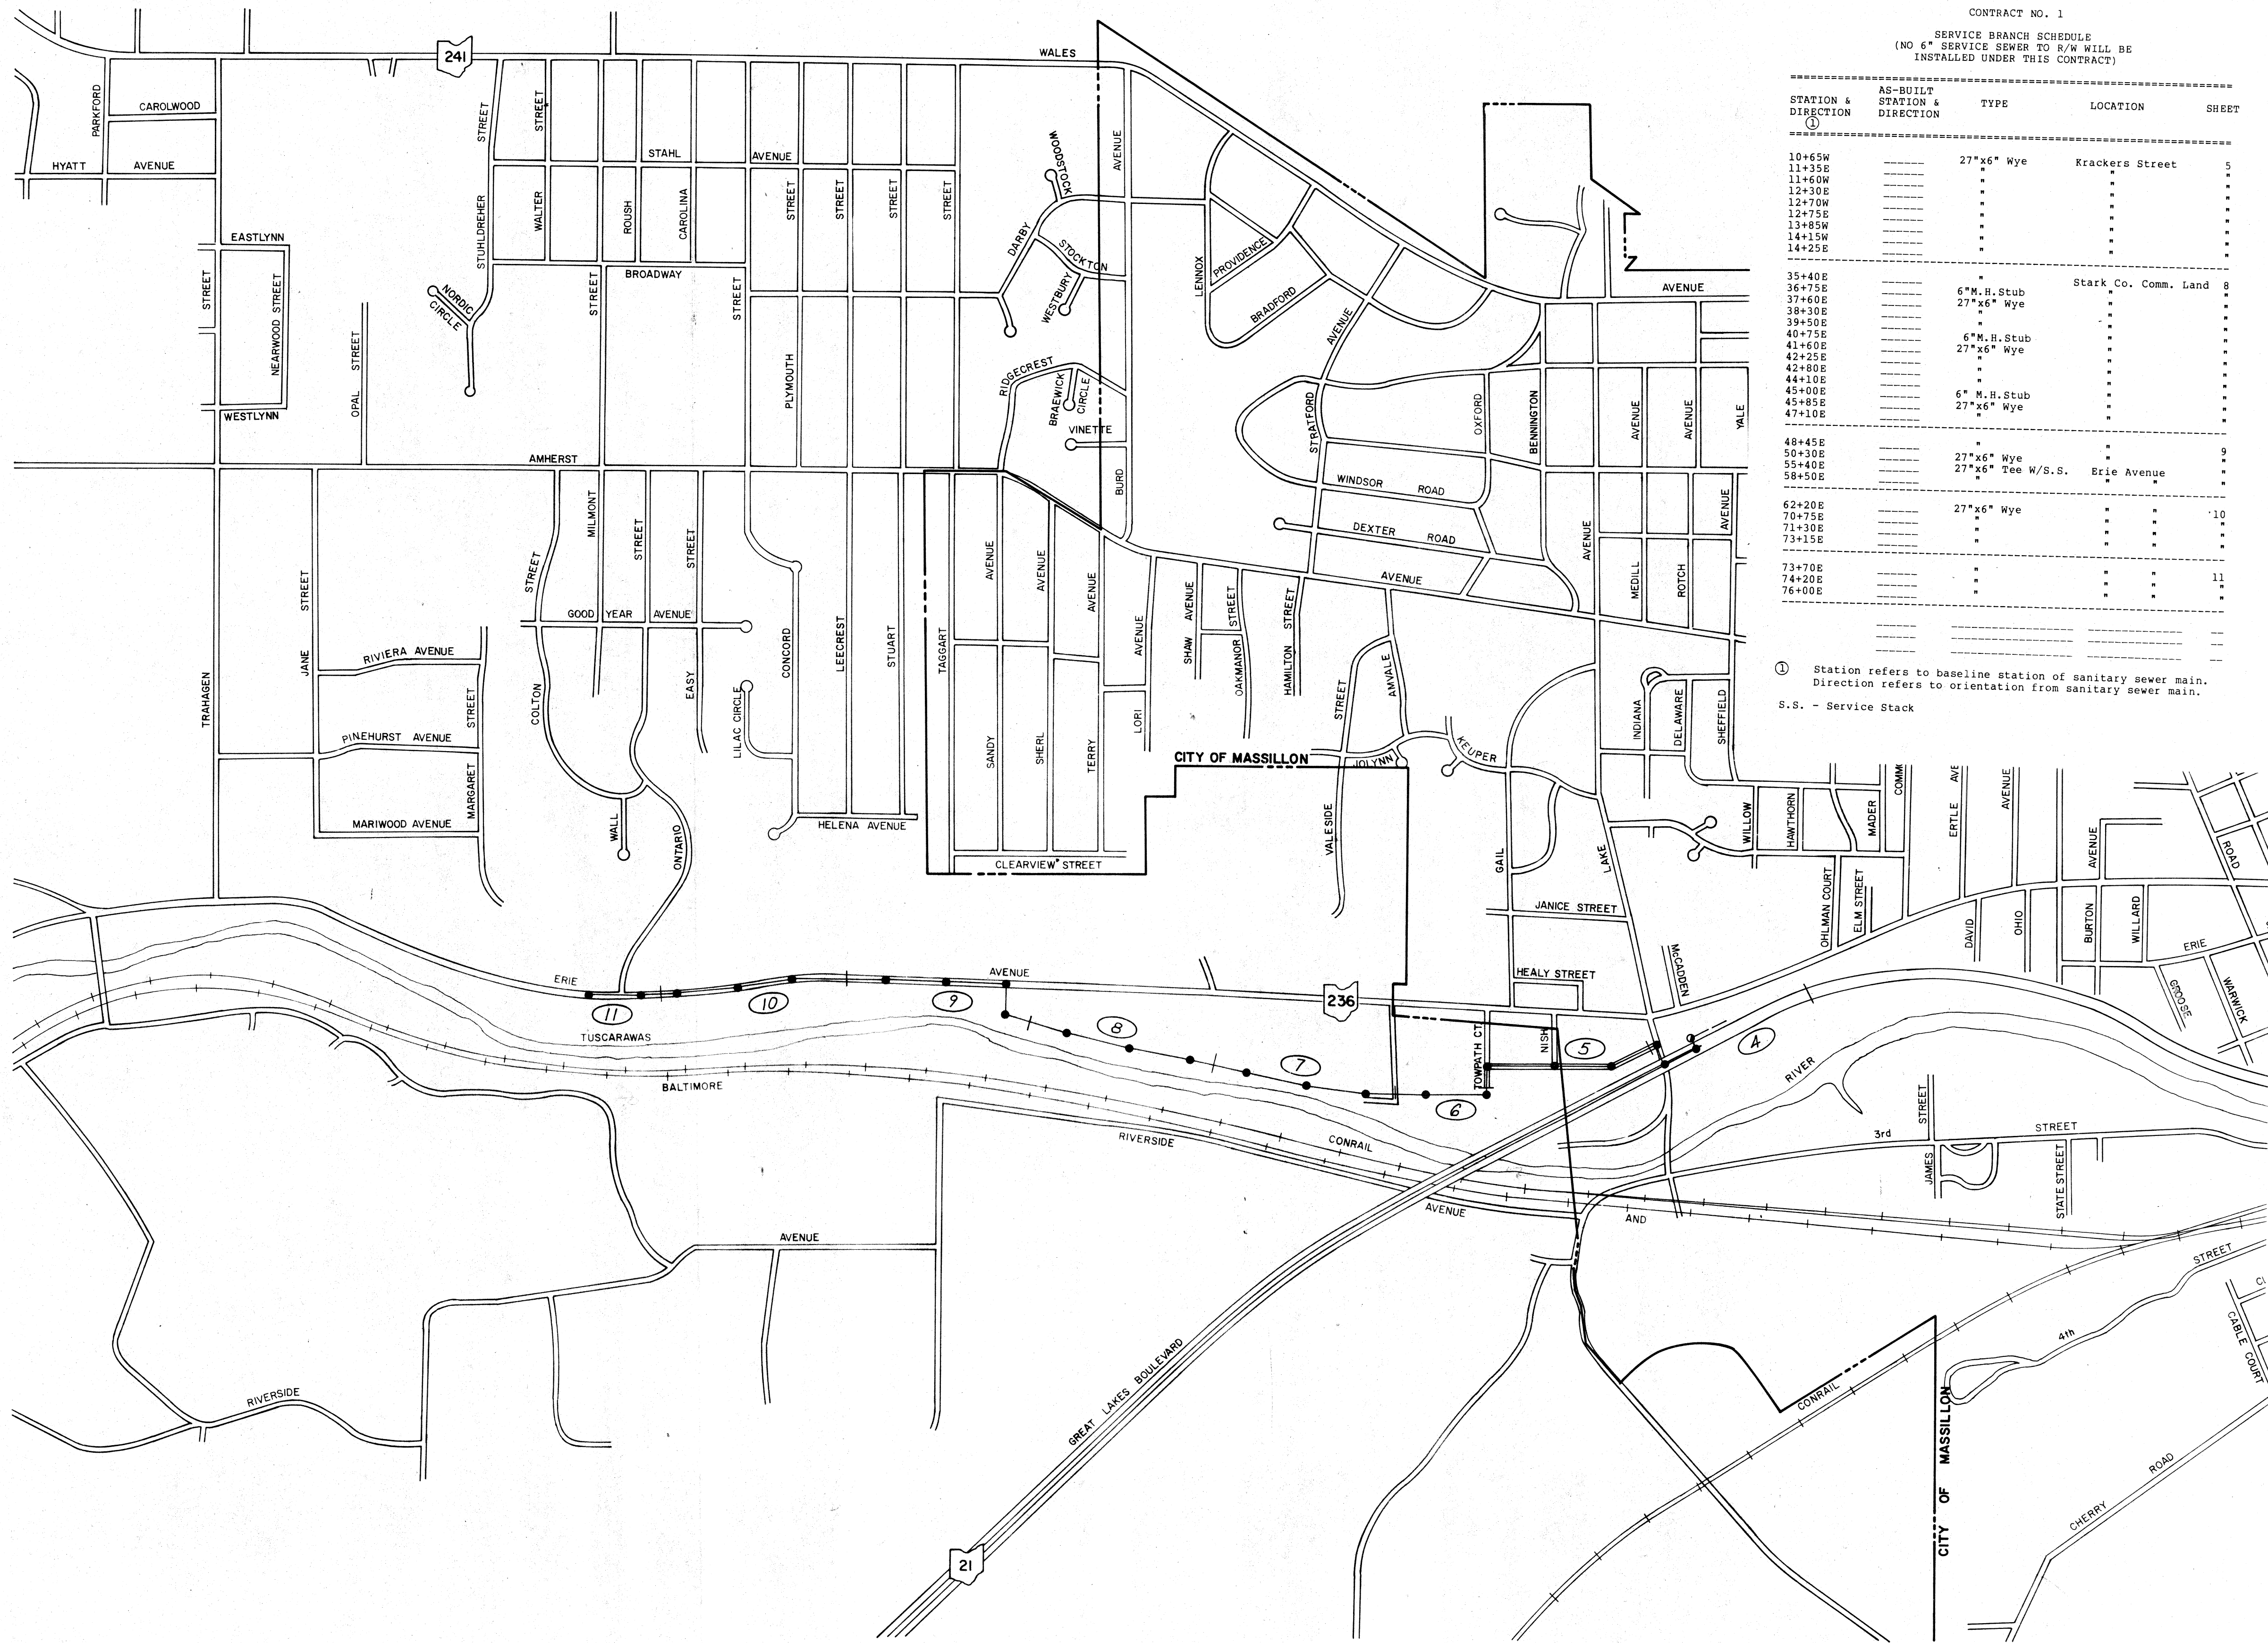

CONTRACT NO. 1
SERVICE BRANCH SCHEDULE
(NO 6" SERVICE SEWER TO R/W WILL BE
INSTALLED UNDER THIS CONTRACT)

STATION & DIRECTION	AS-BUILT STATION & DIRECTION	TYPE	LOCATION	SHEET
10+65W		27"x6" Wye	Krakers Street	5
11+35E				
11+60W				
12+30E				
12+70W				
12+75E				
13+85W				
14+15W				
14+25E				
35+40E		6" M.H. Stub	Stark Co. Comm. Land	8
36+75E		27"x6" Wye		
37+60E				
38+30E				
39+50E		6" M.H. Stub		
40+75E		27"x6" Wye		
41+60E				
42+25E				
42+80E				
44+10E		6" M.H. Stub		
45+00E		27"x6" Wye		
45+85E				
47+10E				
48+45E				
50+30E		27"x6" Wye		9
55+40E		27"x6" Tee W/S.S.	Erie Avenue	
58+50E				
62+20E				
70+75E		27"x6" Wye		10
71+30E				
72+15E				
73+70E				
74+20E				11
76+00E				

① Station refers to baseline station of sanitary sewer main.
Direction refers to orientation from sanitary sewer main.
S.S. - Service Stack

UTILITIES

The following utilities and owners are located within the work limits of this project:

Stark County Sanitary Engineer
Stark County Office Building
209 West Tuscarawas Street
Canton, Ohio 44702
Notify: Michael S. Armogida, P.E.
Director, Sanitary Engineering
(216) 454-5651 Ext. 177

Stark County Engineer
209 West Tuscarawas Street
Canton, Ohio 44702
Notify: Joseph Sturrett
County Engineer
(216) 454-5651 Ext. 248

Ohio Water Service Co.
123 Third Street, S.E.
P.O. Box 584
Massillon, Ohio 44648
Notify: Don Snyder
Supervisor
(216) 833-4156

(M) Ohio Bell Telephone Co.
832 McKinney Avenue, N.W.
Canton, Ohio 44703
Notify: Phil Byham
District Manager - Distribution Services
(216) 489-2632

Massillon Cable T.V.
814 Cable Court, N.W.
Massillon, Ohio 44646
Notify: (216) 833-4134

Ohio Edison Company
663 South Erie Street
Massillon, Ohio 44646
Notify: George Steffen
Division Engineer
(216) 833-3141 Ext. 261

Ohio Department of Transportation
District No. 4
105 Oakwood Street
Ravenna, Ohio 44266
Notify: Ernie Moravec
Permit Supervisor
(216) 297-0801

(M) East Ohio Gas Company
Gas Supply Operations Division
7015 Freedom Street, N.W.
North Canton, Ohio 44720
Notify: Thomas J. Wiese
Supervisor
(216) 499-2501

(M) East Ohio Gas Company
Distribution Division
332 Second Street, N.W.
Canton, Ohio 44702
Notify: Engineering Dept.
(216) 438-6131

City of Massillon
Massillon Municipal Govt. Center
100 City Hall Street
Massillon, Ohio 44646
Notify: Robert Wagoner
City Engineer
(216) 833-1058

(M) Designates member organizations of Ohio Utility Protection Service. Call 1-800-362-2764.

UTILITIES NOTIFICATION


At least two working days prior to commencing construction operations in an area which may involve underground utility facilities, the Contractor shall notify the Project Engineer, the registered utility protection service and the owners of each underground utility facility shown in the plans.

The owner of the underground utility facility shall, within forty-eight hours, excluding Saturdays, Sundays and Legal Holidays, after notice is received, stake, mark or otherwise designate the location of the underground utility facilities in the construction area in such a manner as to indicate their course together with the approximate depth at which they were installed. The marking or locating shall be coordinated to stay approximately two days ahead of the planned construction.

DRAWN BY: _____
CHECKED BY: _____
DATE: JUNE 1983

FRANK A. THOMAS & ASSOCIATES, INC.
CONSULTING ENGINEERS
WILLOUGHBY, OHIO




STARK COUNTY, OHIO
SANITARY SEWER IMPROVEMENTS
PROJECT NO. 429
INDEX OF SHEETS

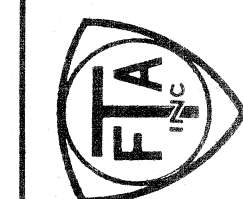

SCALE: 1" = 60'
HOR. _____
VERT. _____
81131
2 OF 14
SHEETS




SCALE: 1" = 600'		3 OF 14 SHEETS	F.T.A. INC.	STARK COUNTY, OHIO		FRANK A. THOMAS & ASSOCIATES, INC.		DRAWN BY: _____
HOR. _____ VERT. _____				SANITARY SEWER IMPROVEMENTS		CONSULTING ENGINEERS		CHECKED BY: _____
8/1/31		PROJECT NO. 429		WILLOUGHBY, OHIO		DATE: JUNE, 1983		
		SOIL BORING LOCATIONS						

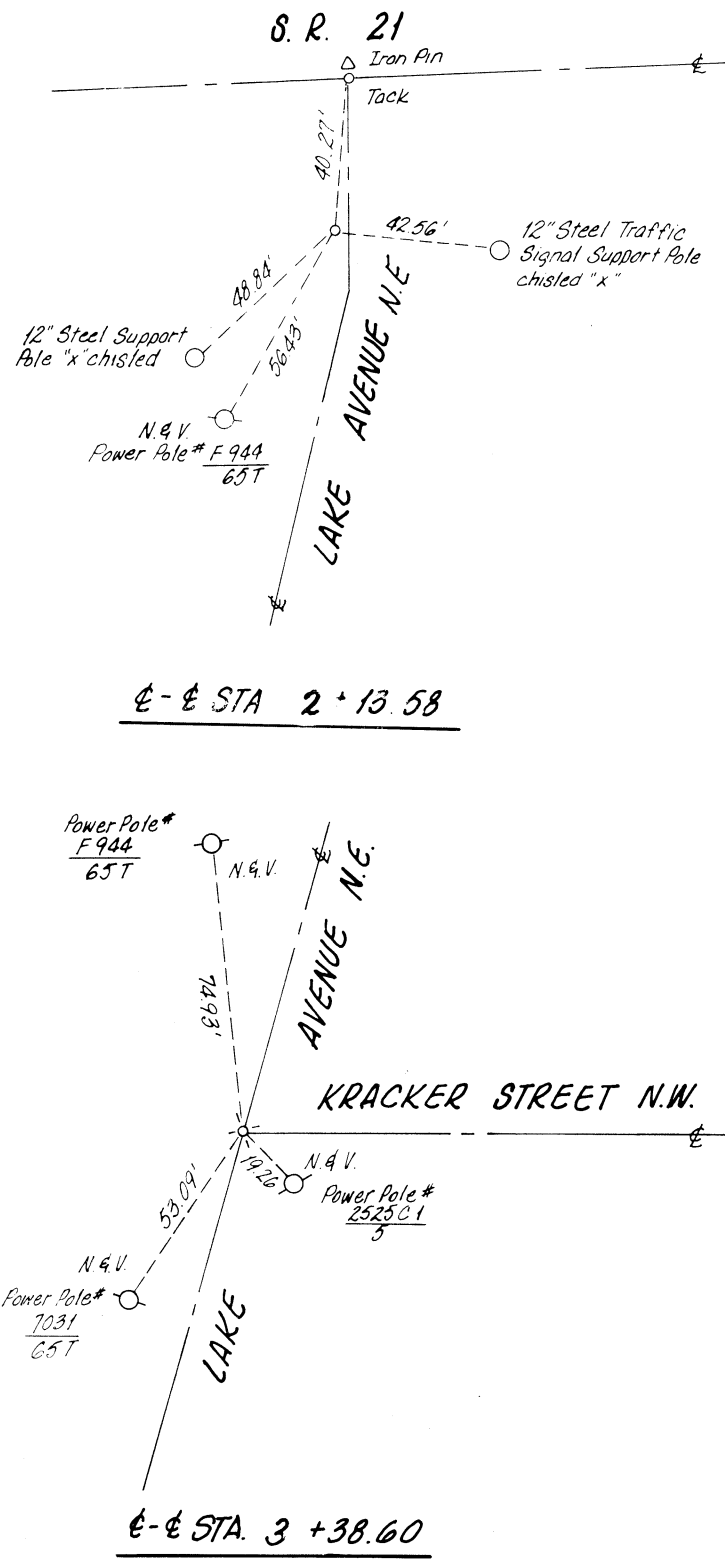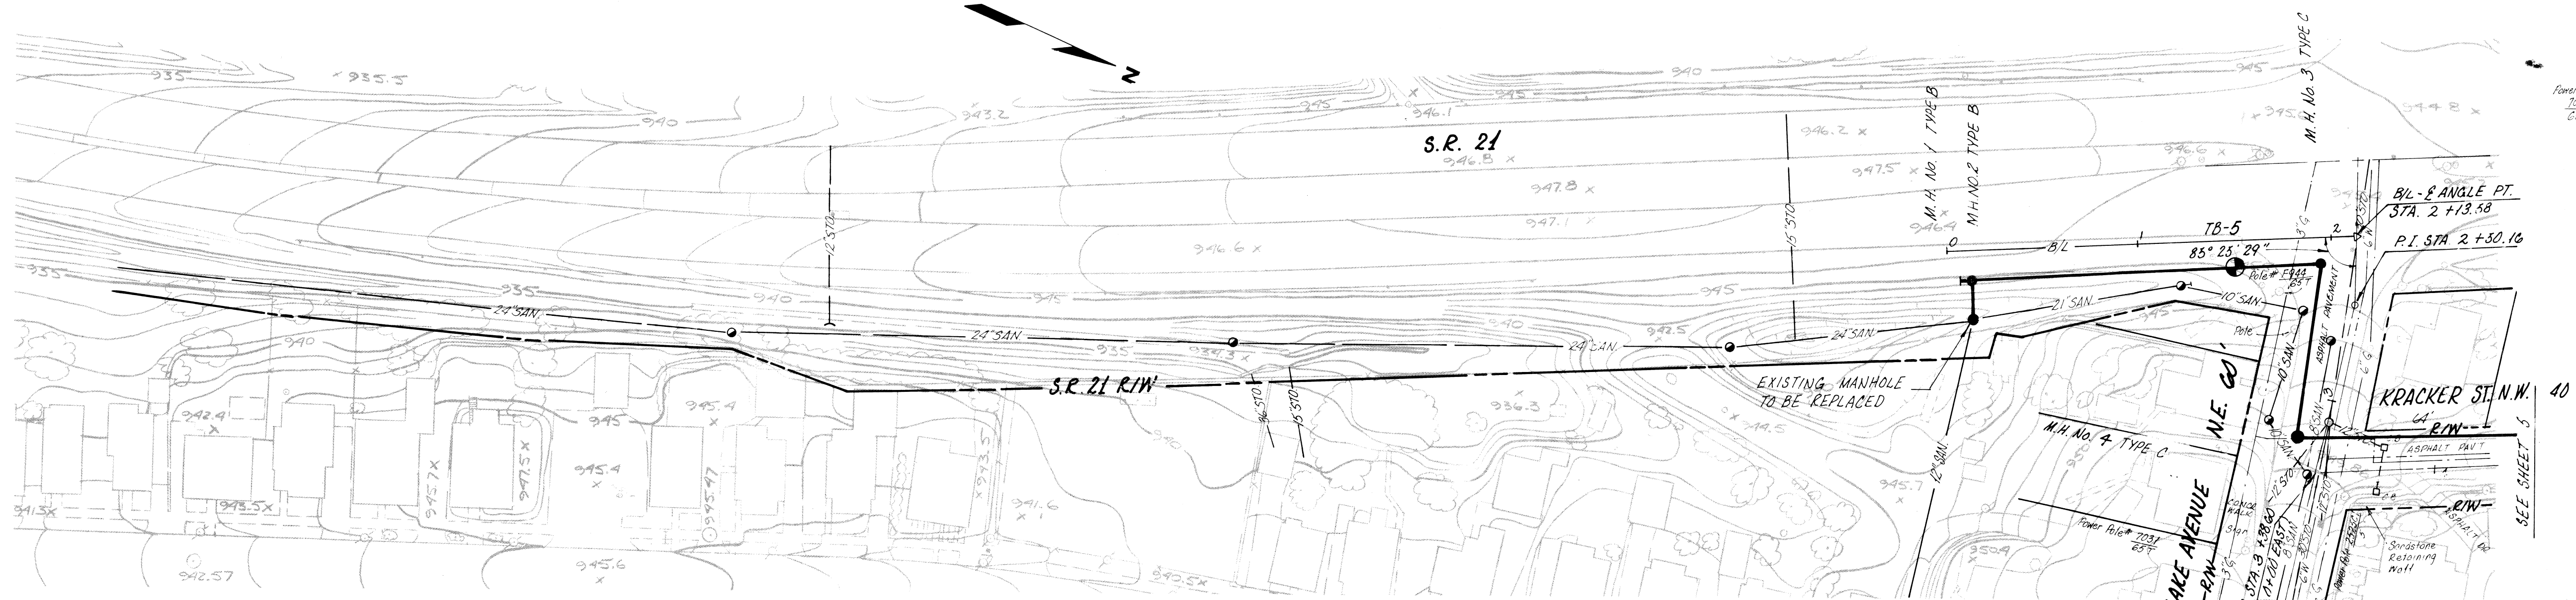
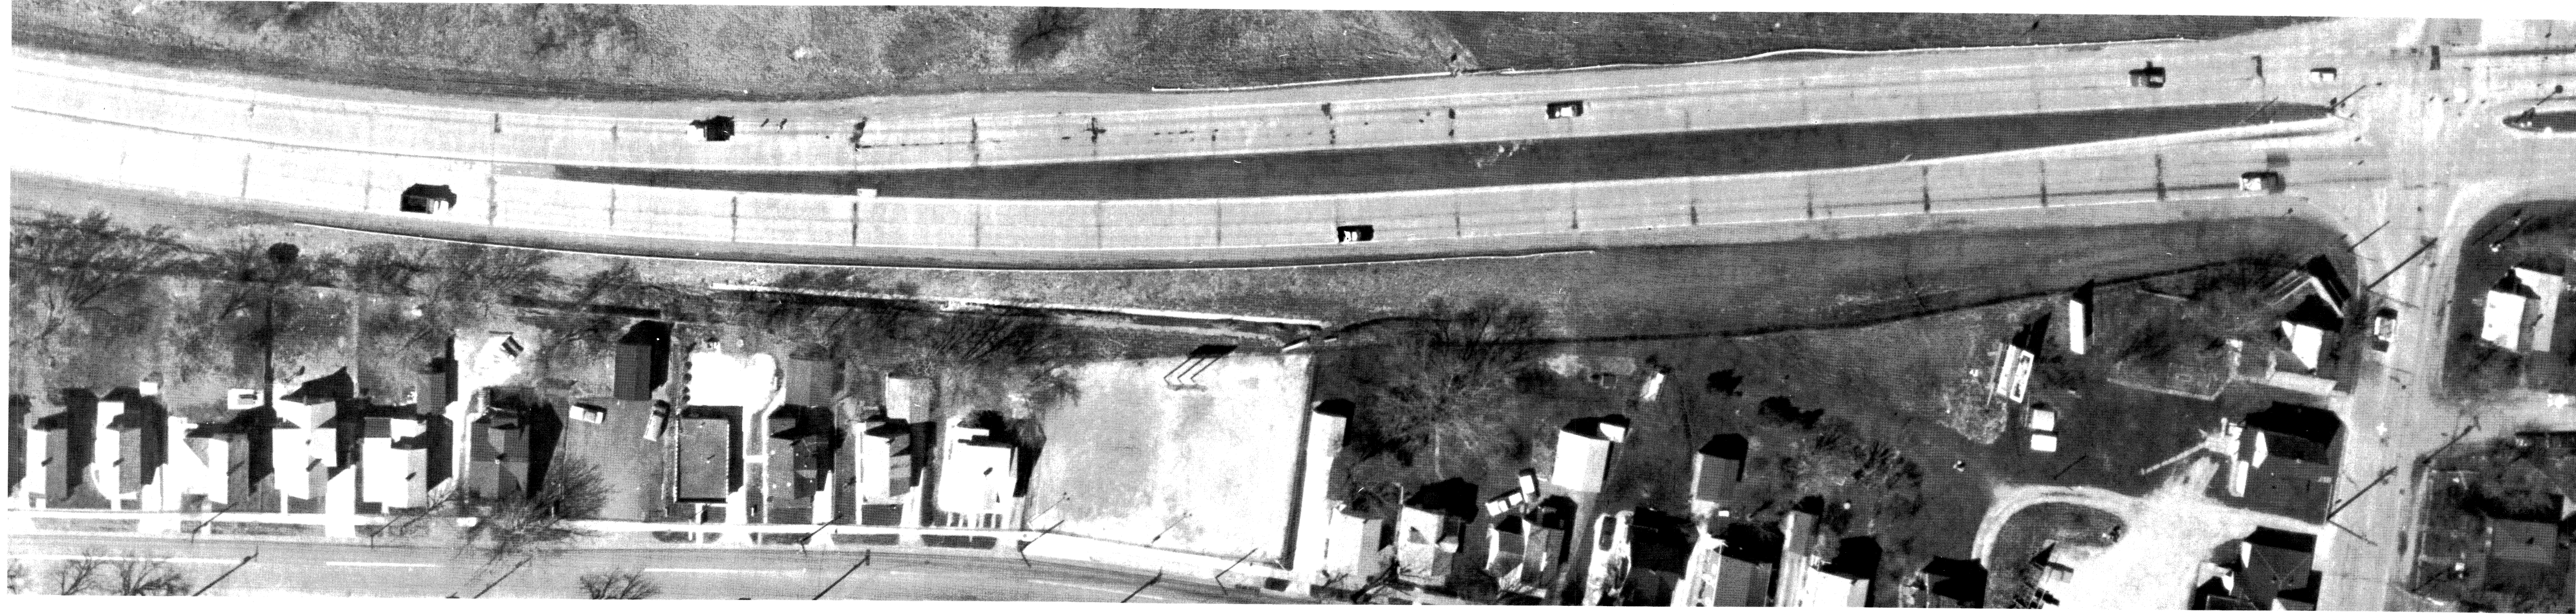


NOTE: SEE SHEET 2 FOR SERVICE BRANCH SCHEDULE.

LAKE AVENUE
PAVEMENT REPLACEMENT
2 1/2" ASPHALT CONCRETE WITH
9" AGGREGATE BASE.

BENCH MARK:
TOP BOLT - FIRE HYDRANT @ NW
CORNER OF S.R. 21 AND LAKE
STREET INTERSECTION.
ELEV. = 943.67

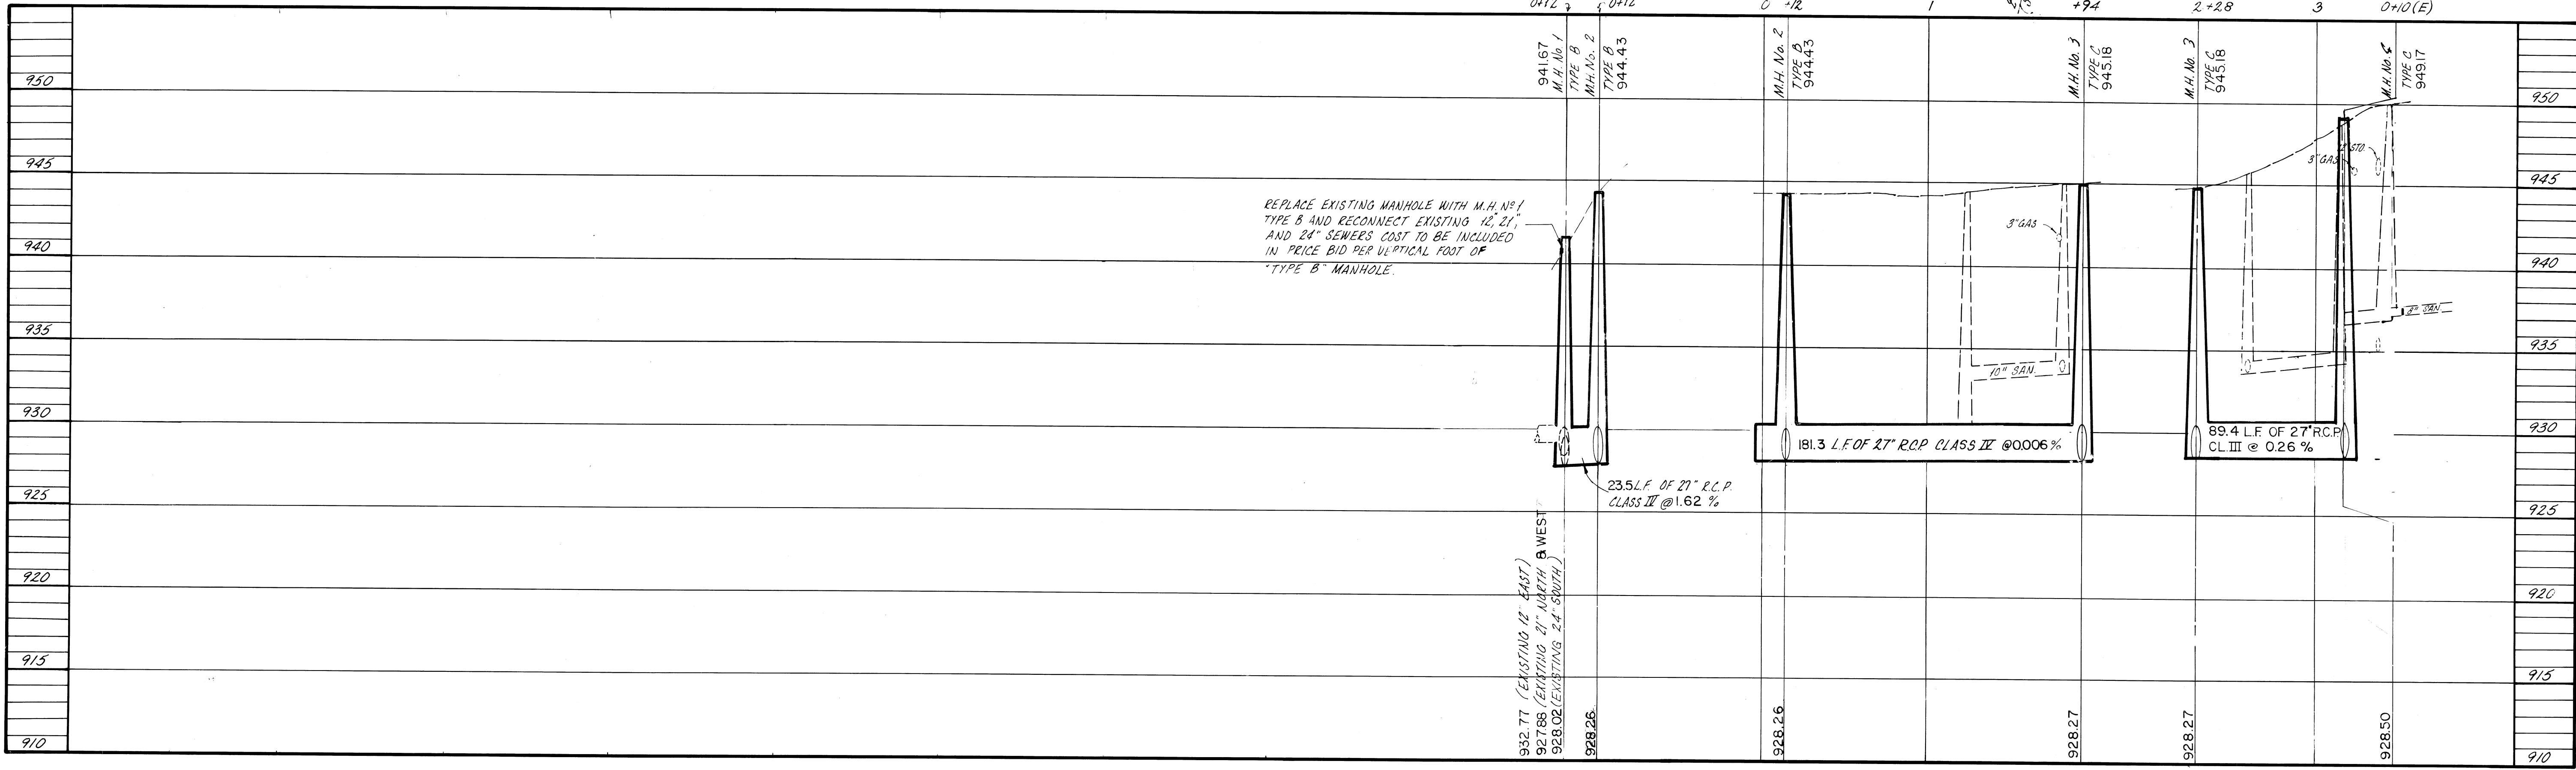

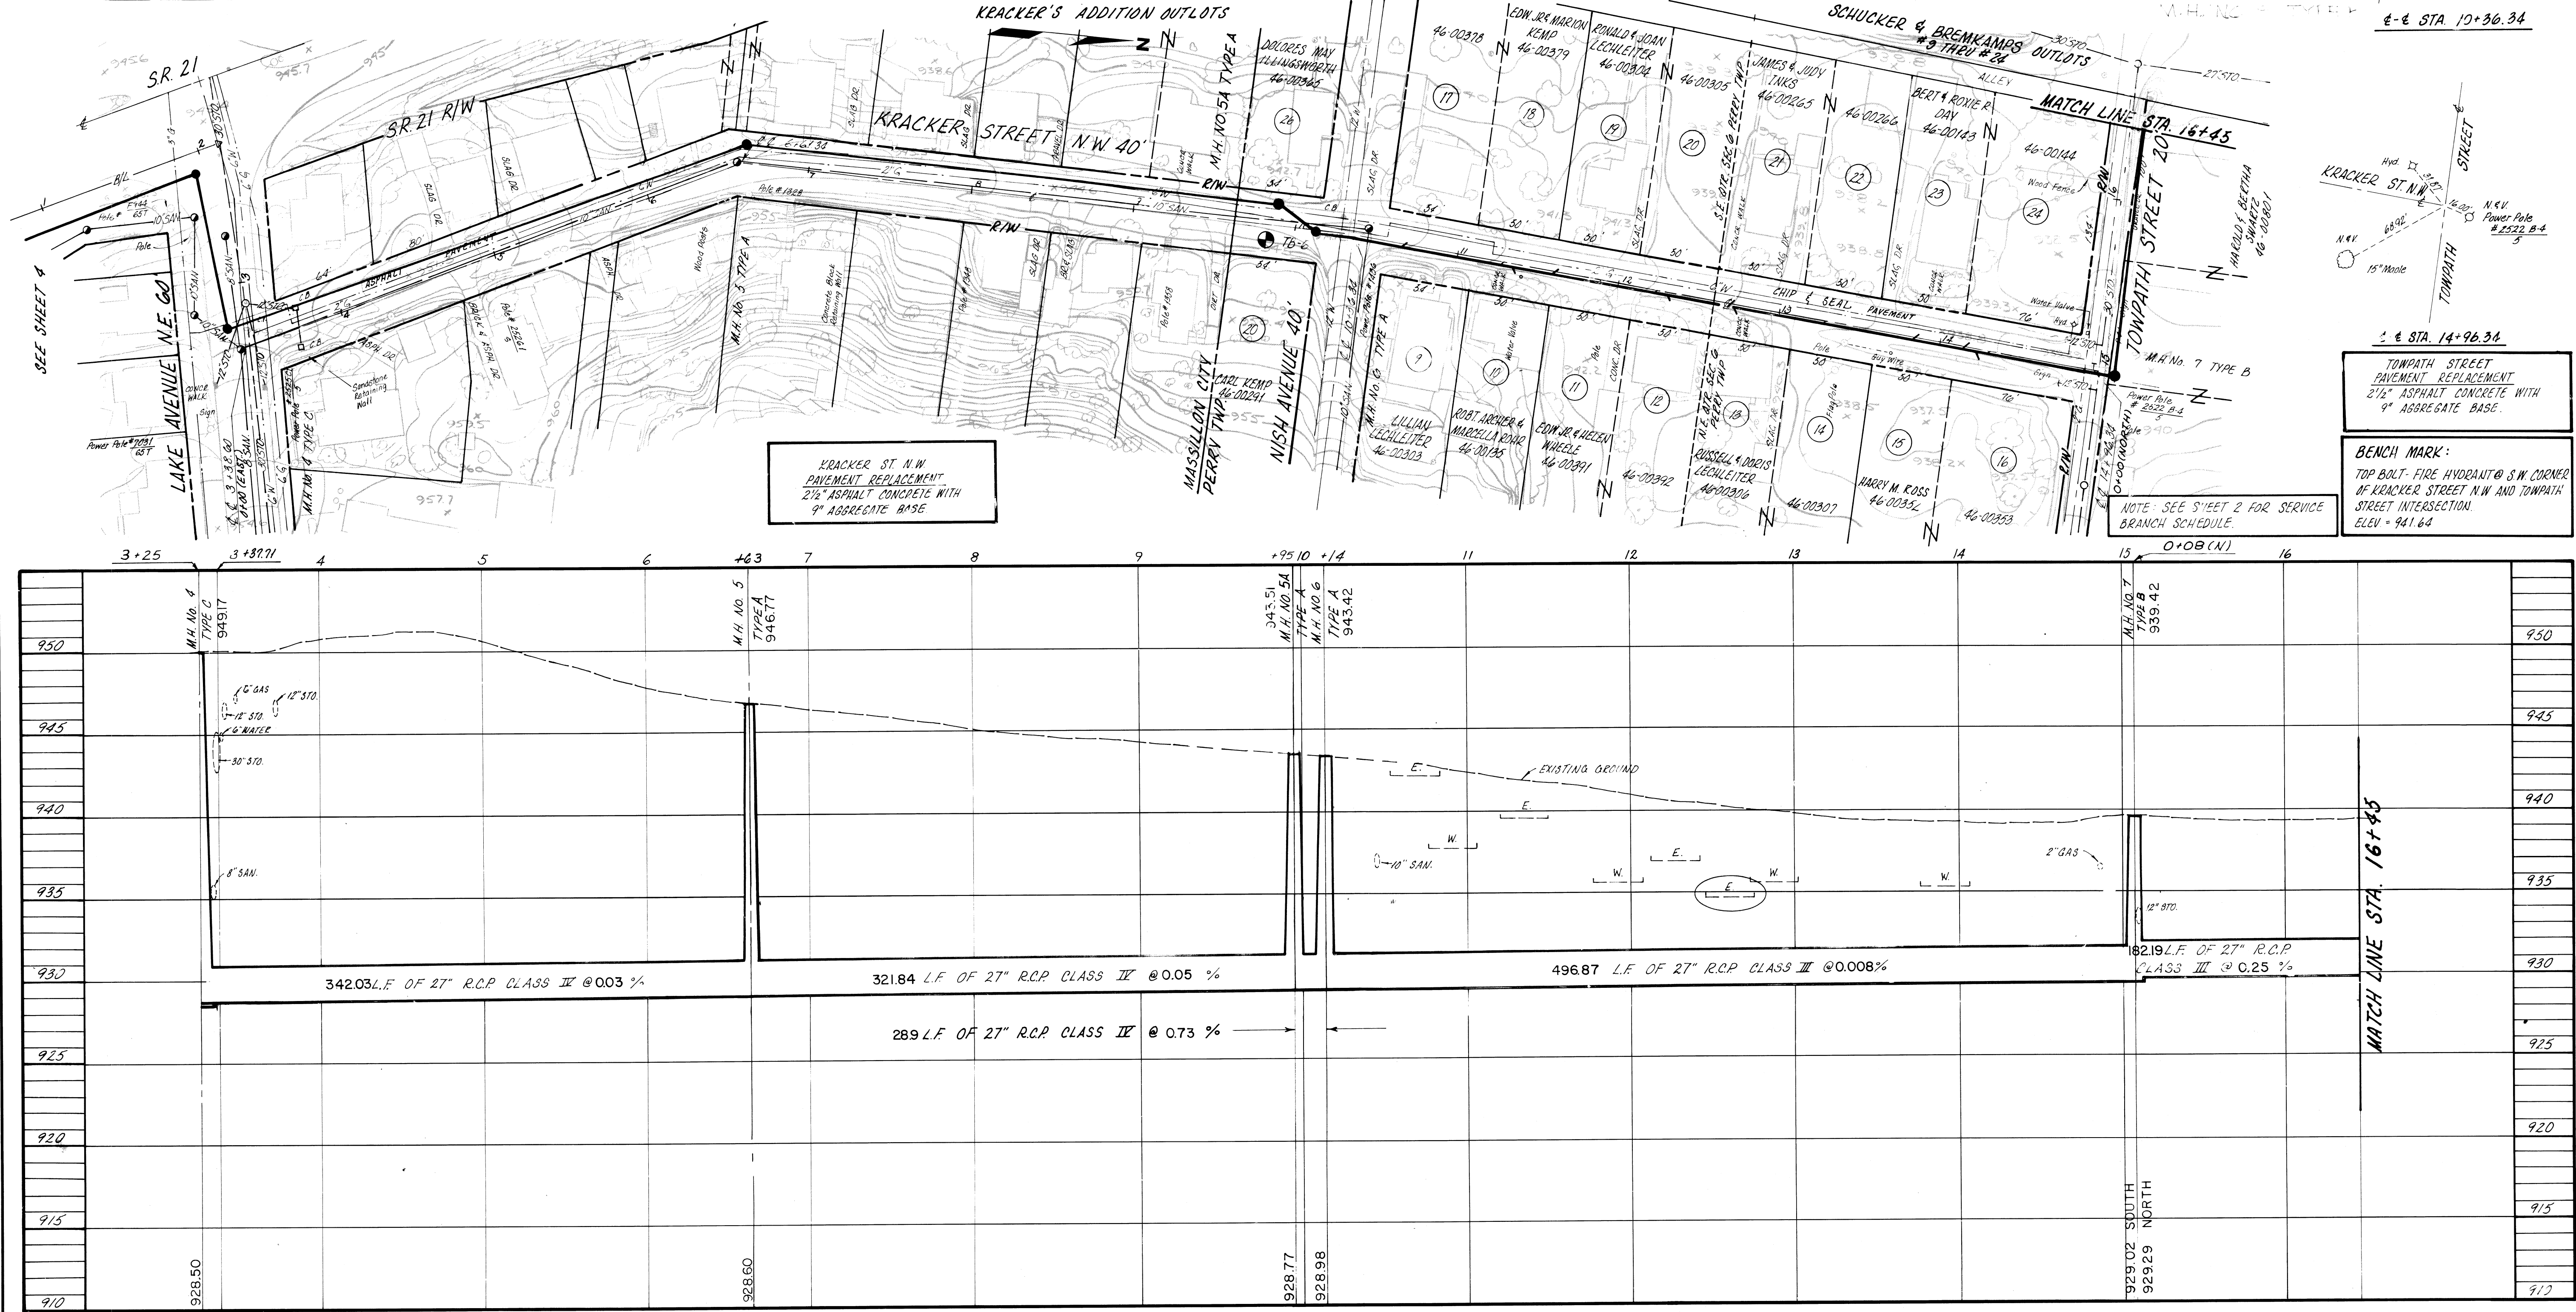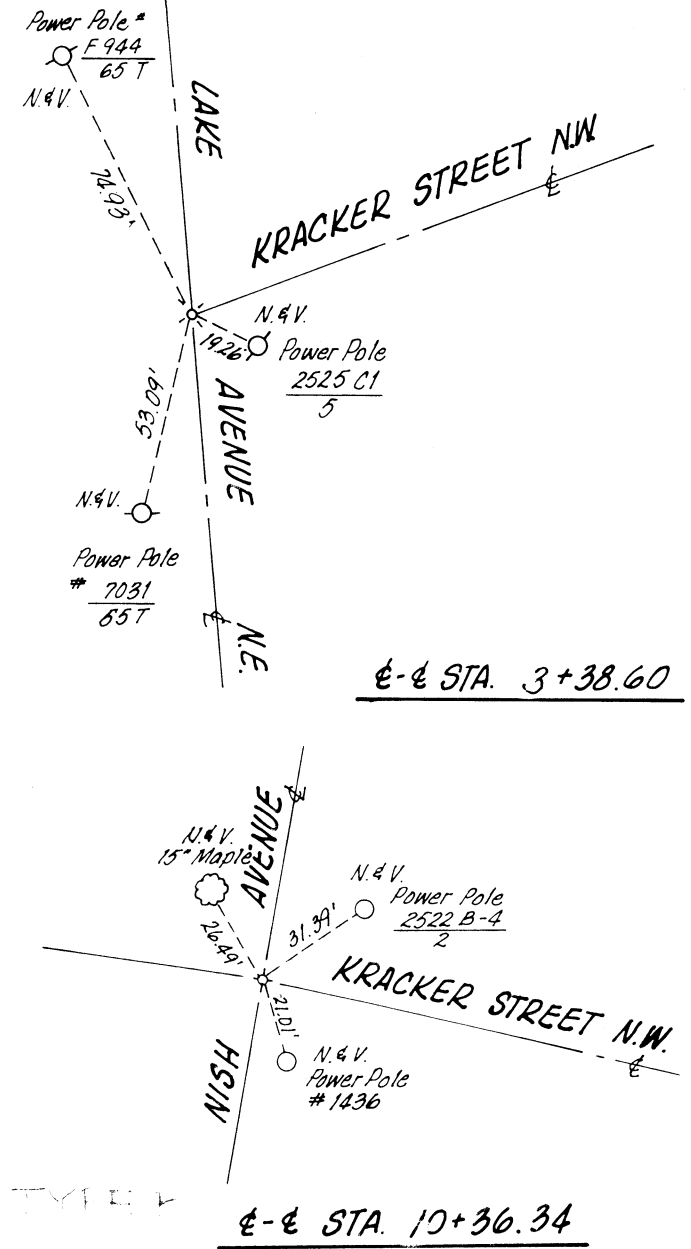

STARK COUNTY, OHIO
SANITARY SEWER IMPROVEMENTS
PROJECT NO. 429
PLAN AND PROFILE

SCALE: HORIZ. 1"=50' VERT. 1"=5'

5 OF 14


P-1

FINAL MEAS 5/65 RLW JR.
DRAWN BY: J.A.S.+FEW
CHECKED BY: R.J.T.
REVISION DATE: JUNE 13, 1994
DATE: JUNE, 1993


FRANK A. THOMAS & ASSOCIATES, INC.
CONSULTING ENGINEERS
WILLOUGHBY, OHIO

FTA INC.

CONTRACT :

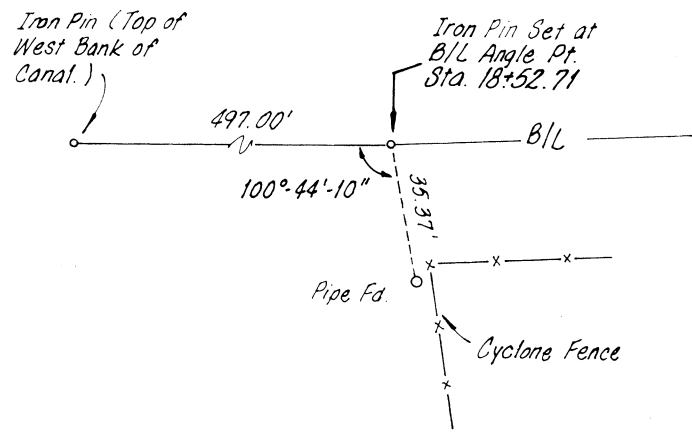

B/L ANGLE PT. STA. 18+52.71

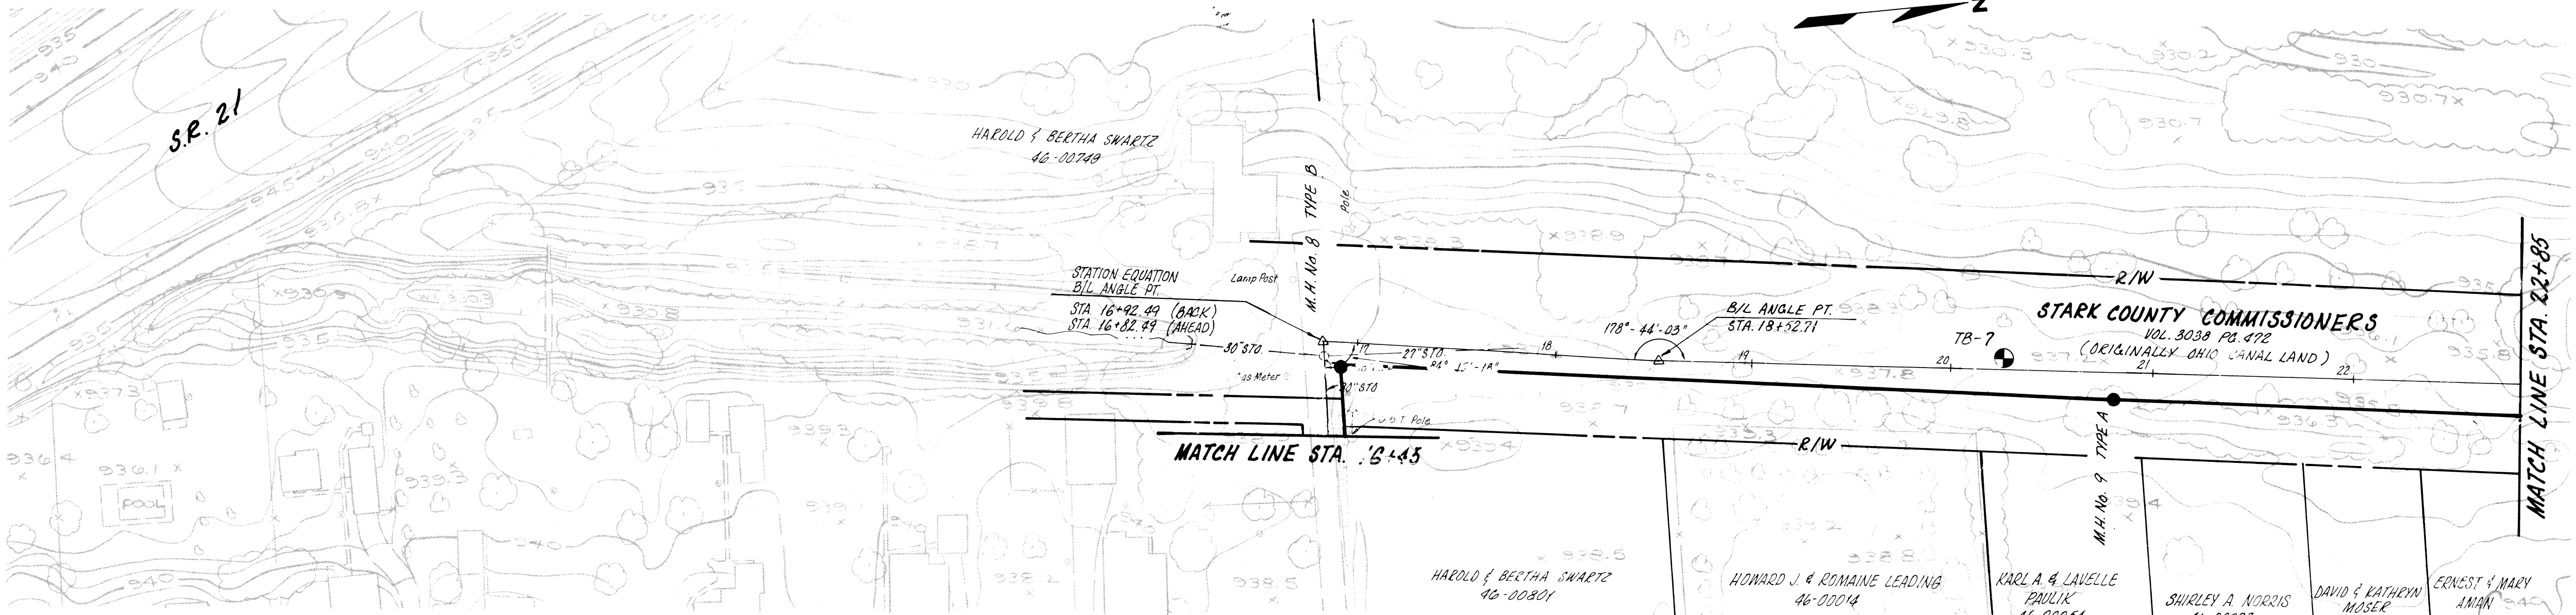




NOTE: SEE SHEET 2 FOR SERVICE BRANCH SCHEDULE.

NOTE: SUITABLE BACKFILL (AS PER ITEM 1 OF THE SPECIFICATIONS) SHALL BE PLACED TO THE PROPOSED GRADE WHERE NOTED WITH SIDE SLOPES AT 2:1. MAINTAIN A 4" MINIMUM COVER OVER SEWER. COST TO BE INCLUDED IN PRICE BID PER LINEAL FOOT OF SEWER WHERE FILL IS DESIGNATED AT MANHOLES. FILL TO WITHIN 1' OF T.C. WITH SIDE SLOPES AT 2:1.


TOWPATH STREET PAVEMENT REPLACEMENT 2 1/2" ASPHALT CONCRETE WITH 9" AGGREGATE BASE.

BENCH MARK: TOP 20" FIRE HYDRANT @ S.W. CORNER OF KRAECKER ST. N.W. AND TOWPATH ST. INTERSECTION. ELEV = 941.64

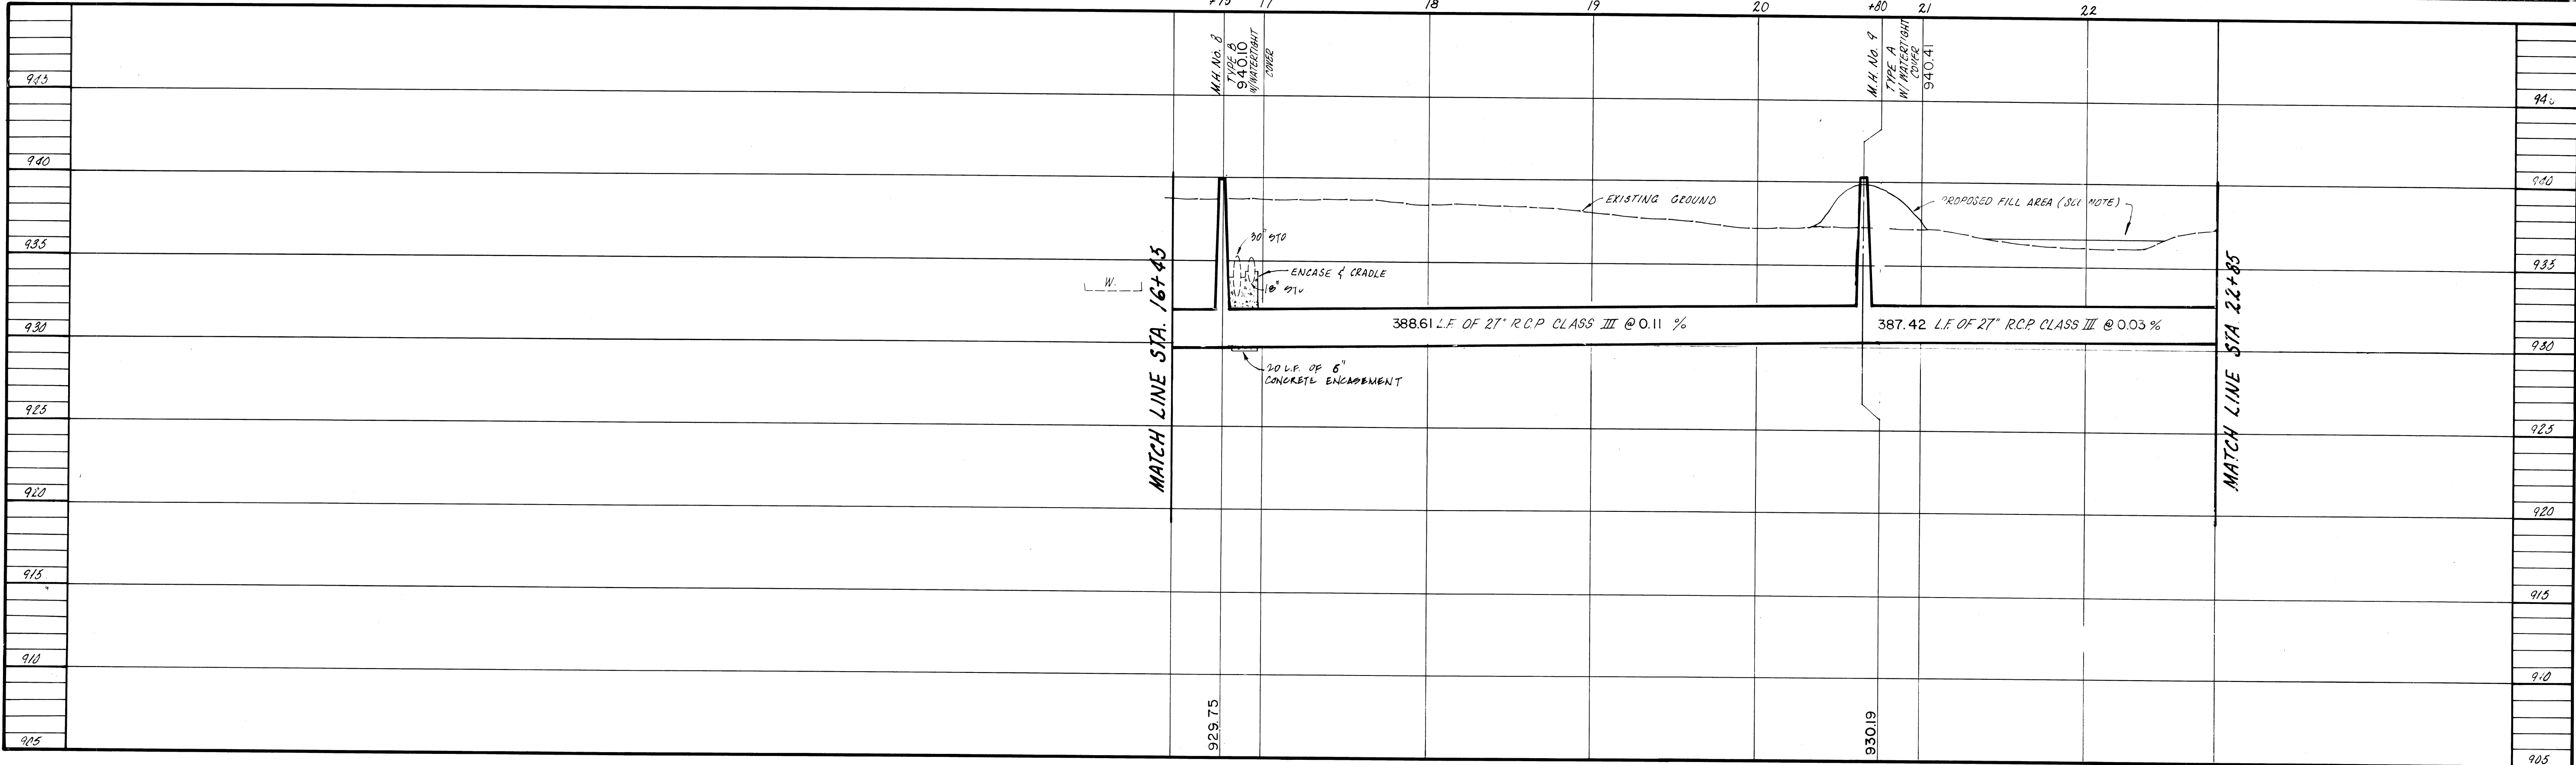

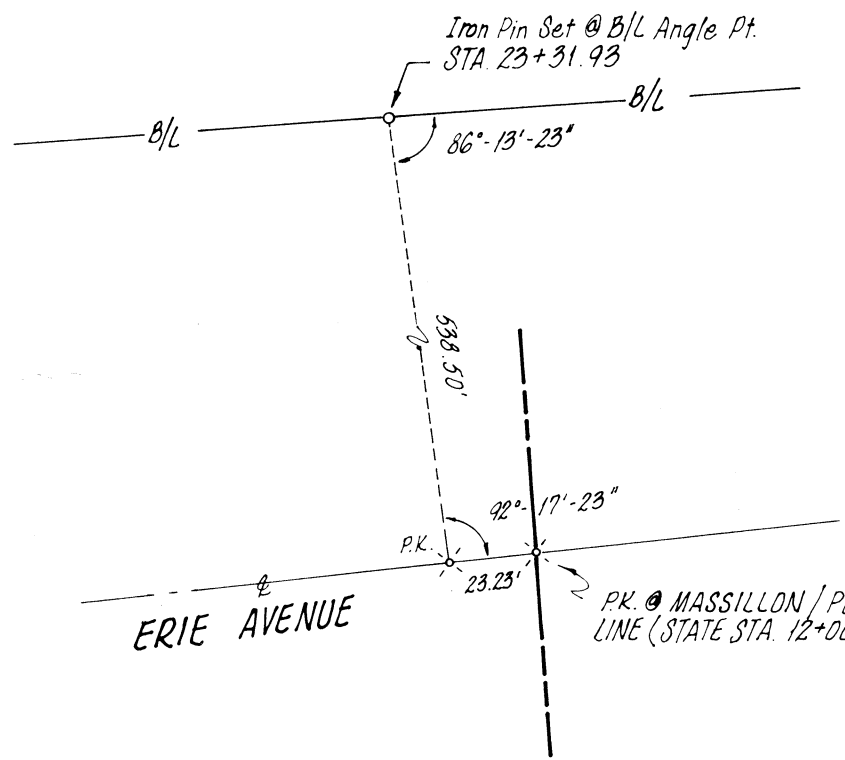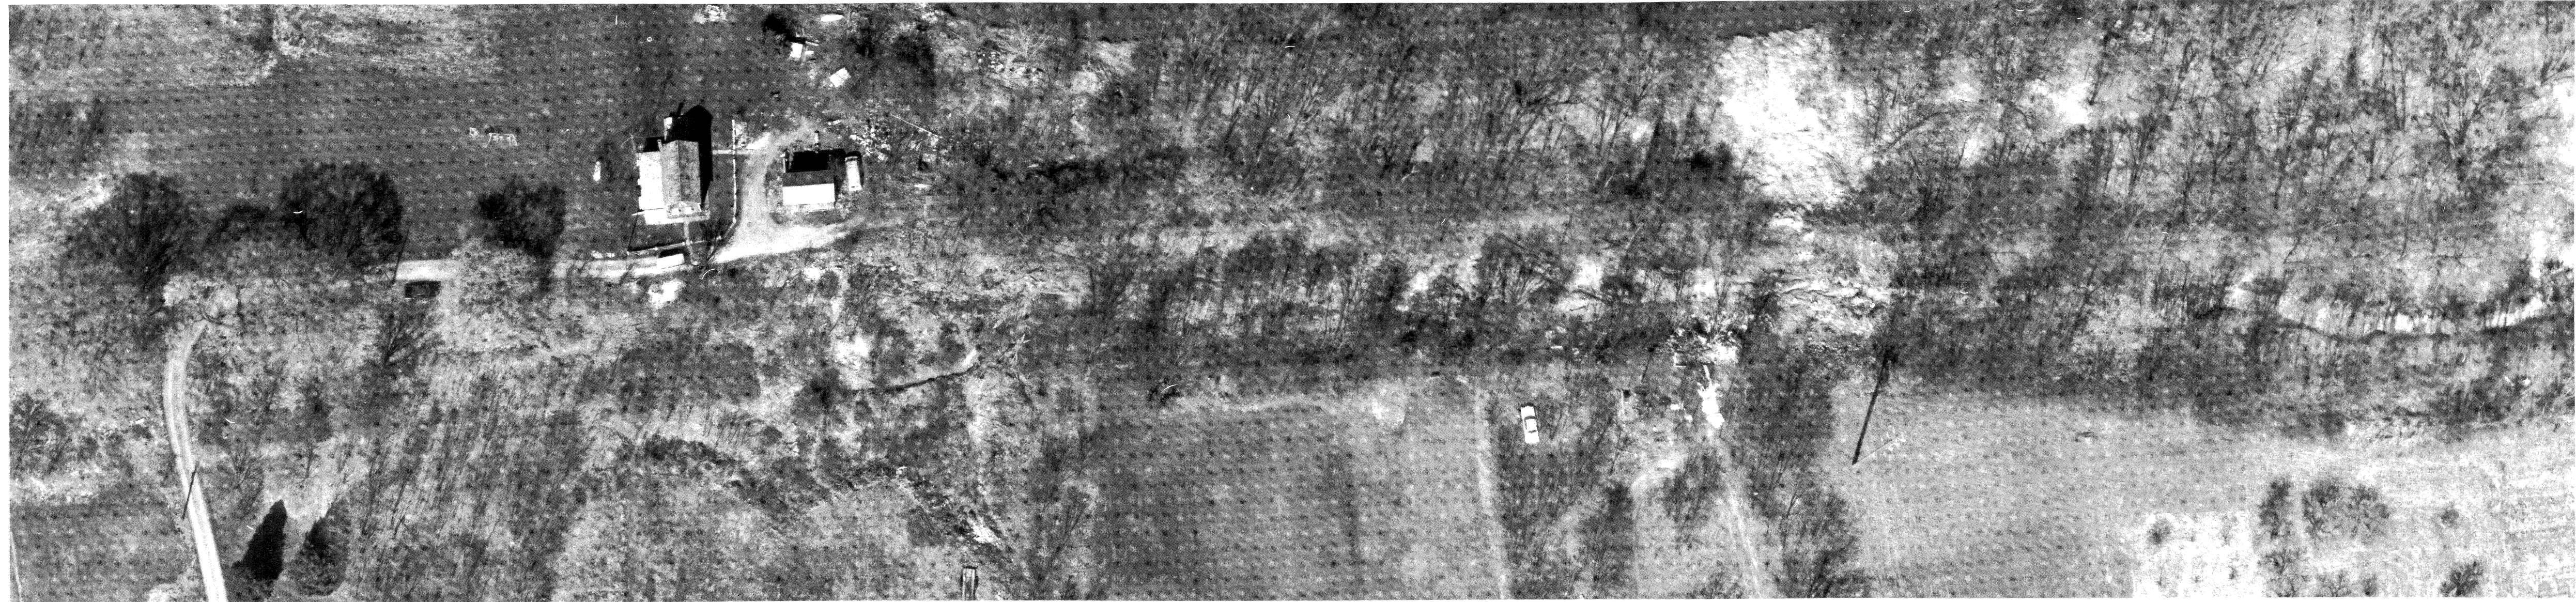

B/L ANGLE PT. STA. 23+31.93

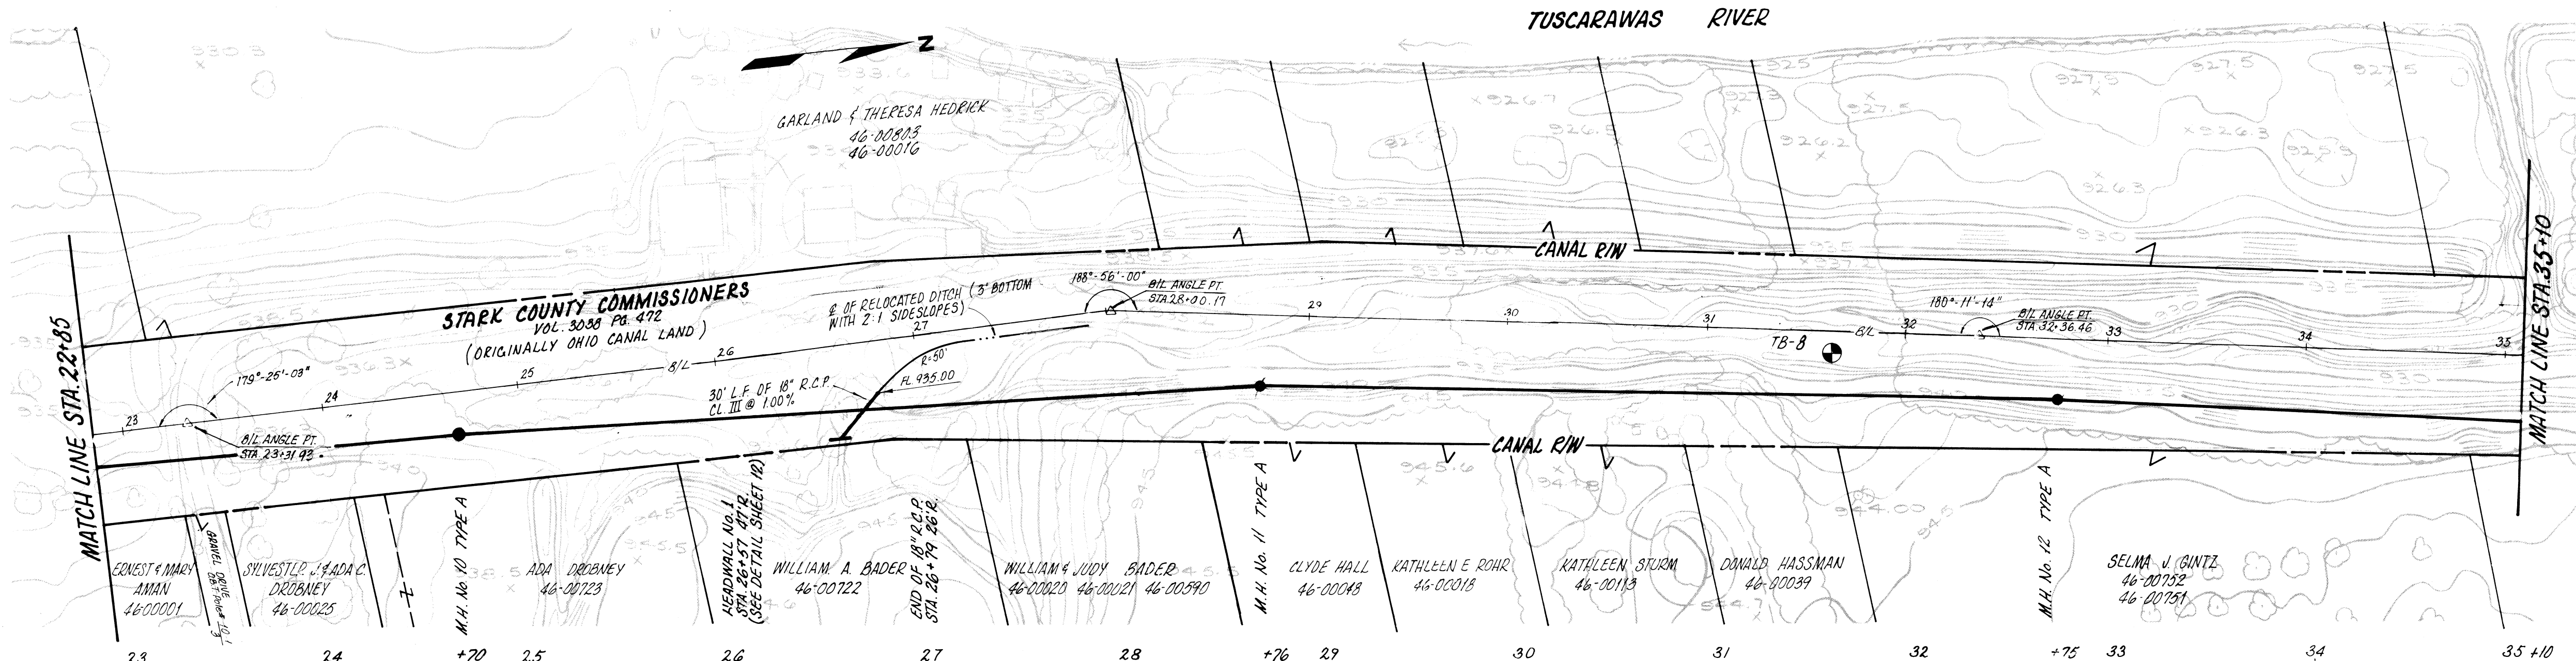

NOTE: SEE SHEET 2 FOR SERVICE BRANCH SCHEDULE.

NOTE: SUITABLE BACKFILL (AS PER ITEM 1 OF THE SPECIFICATIONS) SHALL BE PLACED TO THE PROPOSED GRADE WHERE NOTED WITH SIDE SLOPES AT 2:1. MAINTAIN A 4" MINIMUM COVER OVER SEWER. COST TO BE INCLUDED IN PRICE BID PER LINEAL FOOT OF SEWER. WHERE FILL IS DESIGNATED AT MANHOLES: FILL TO WITHIN 1' OF T.C. WITH SIDE SLOPES AT 2:1.

BENCH MARK:
NAIL 10' UP WEST SIDE OF POWER POLE No. 303-L @ STA 23+25+60' R. ELEV. = 940.89



FINAL MEAS 5/05 RLW JR

DRAWN BY: J.A.S., F.E.W.

CHECKED BY: R.J.I.

DATE: JUNE, 1963

FRANK A. THOMAS & ASSOCIATES, INC.

CONSULTING ENGINEERS

WILLOUGHBY, OHIO

STARK COUNTY, OHIO

SANITARY SEWER IMPROVEMENTS

PROJECT NO. 429

PLAN AND PROFILE



SCALE: 1" = 50' HOR. 1" = 5' VERT.

7 OF 14 SHEETS


P-1

FTA INC.

31131

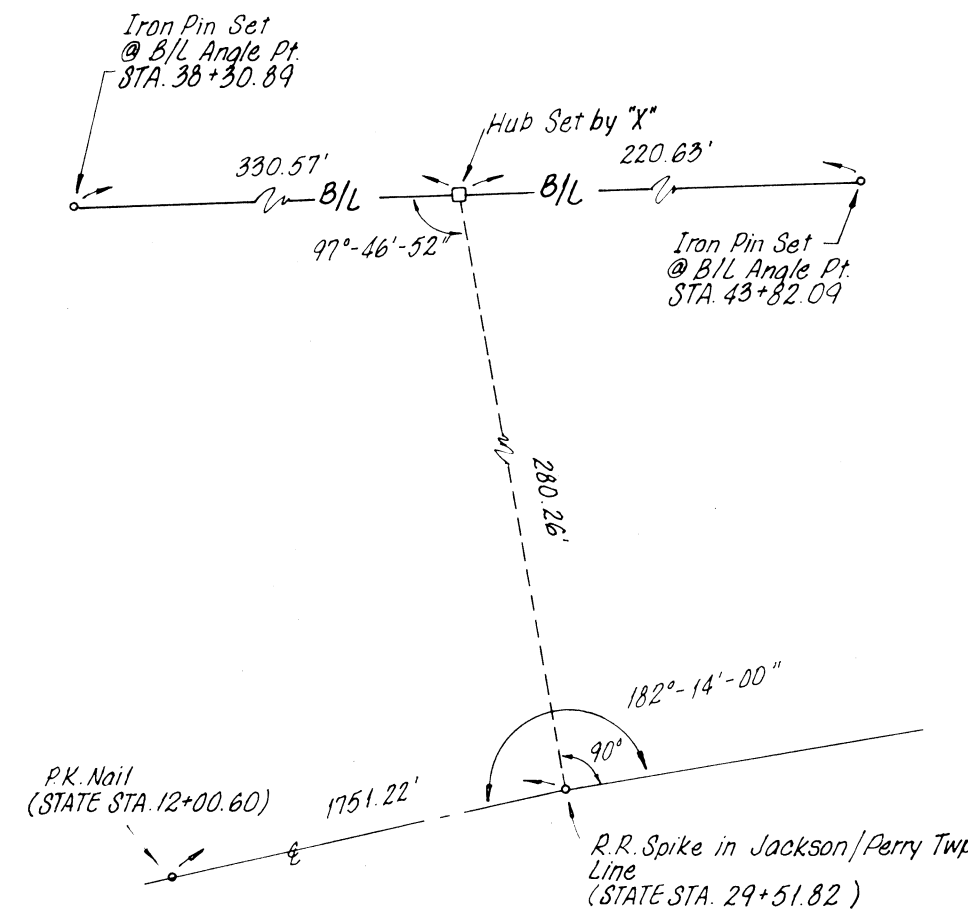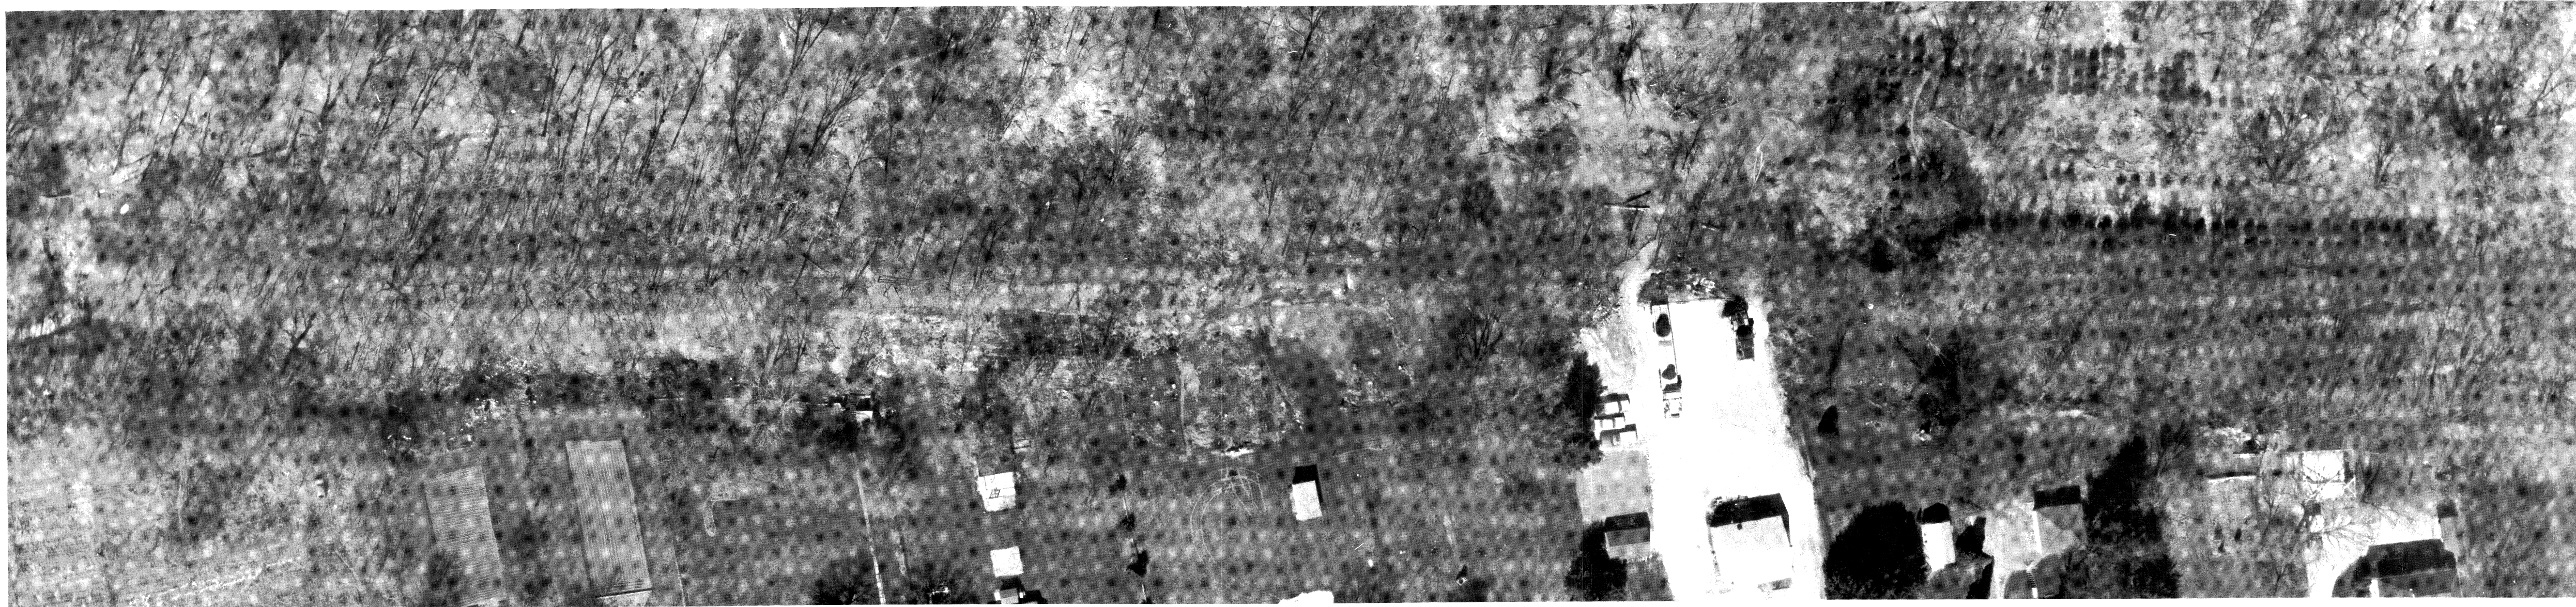


B/L ANGLE PTS.
STA. 38+30.89 & STA. 43+82.09

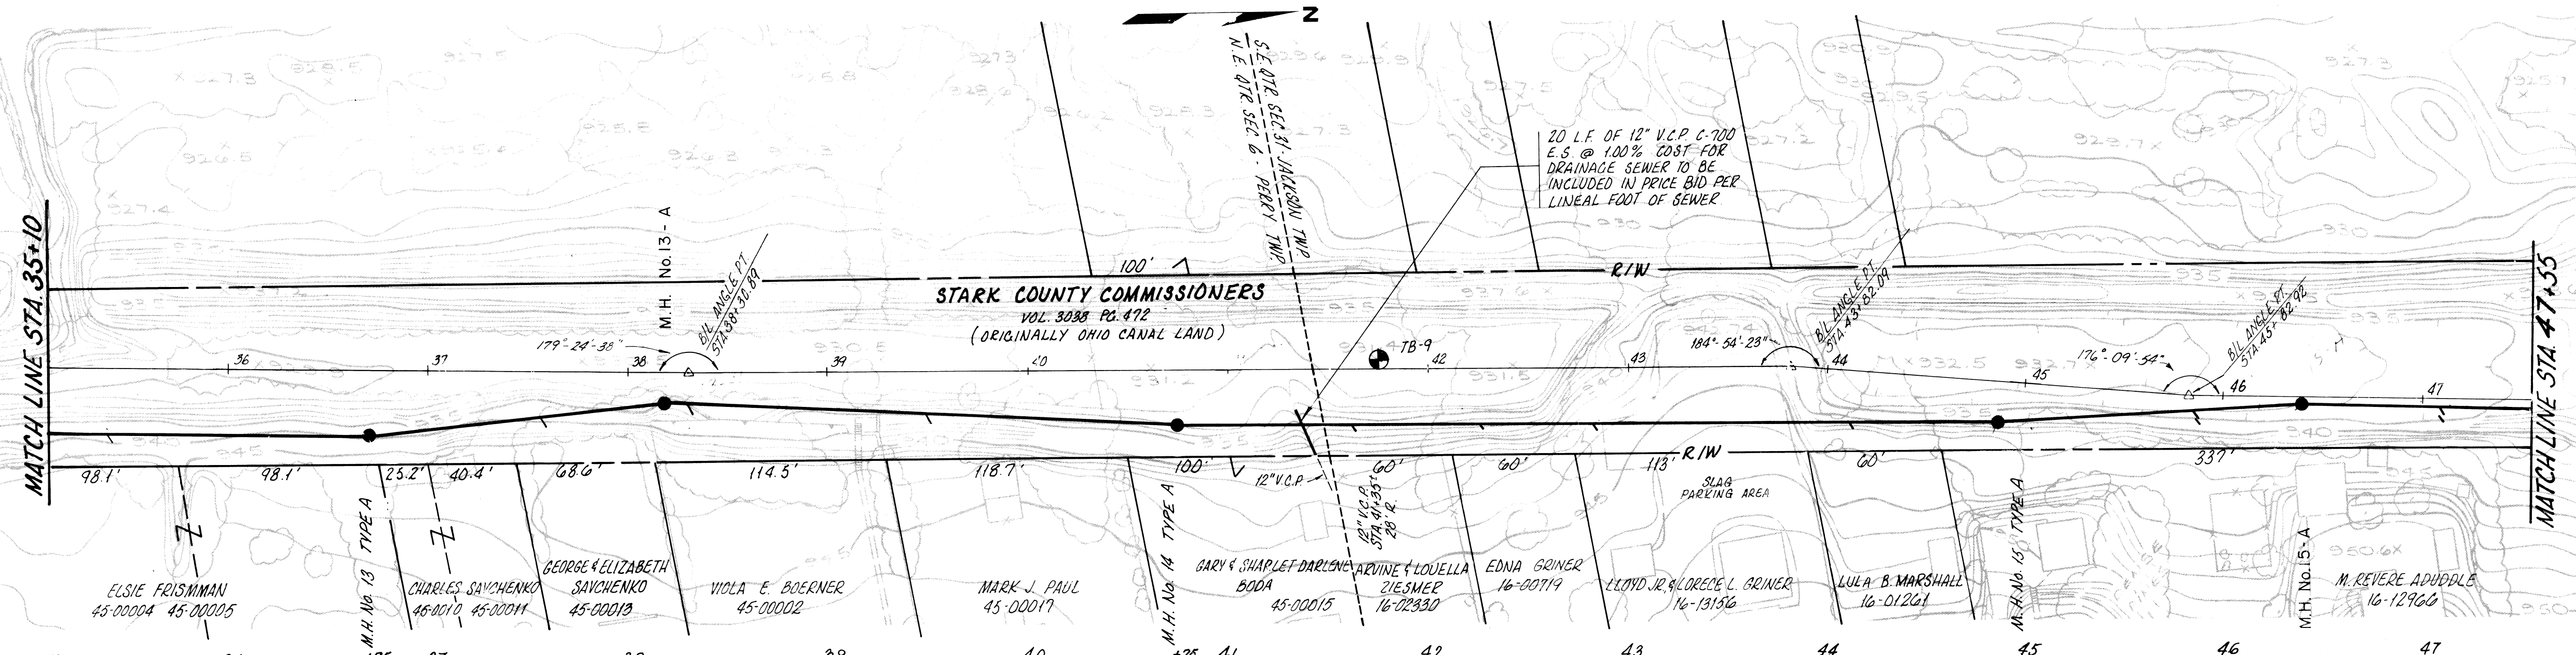

NOTE: SEE SHEET 2 FOR SERVICE BRANCH SCHEDULE.

NOTE: SUITABLE BACKFILL (AS PER ITEM 1 OF THE SPECIFICATIONS) SHALL BE PLACED TO THE PROPOSED GRADE WHERE NOTED WITH SIDE SLOPES AT 2:1. MAINTAIN A 4' MINIMUM COVER OVER SEWER. COST TO BE INCLUDED IN PRICE BID PER LINEAL FOOT OF SEWER WHERE FILL IS DESIGNATED AT MANHOLES: FILL TO WITHIN 1' OF T.C. WITH SIDE SLOPES AT 2:1.


BENCH MARK:
NAIL 0.5' UP EAST SIDE OF
10" TREE @ STA 40+02-29'L.
ELEV. = 935.78

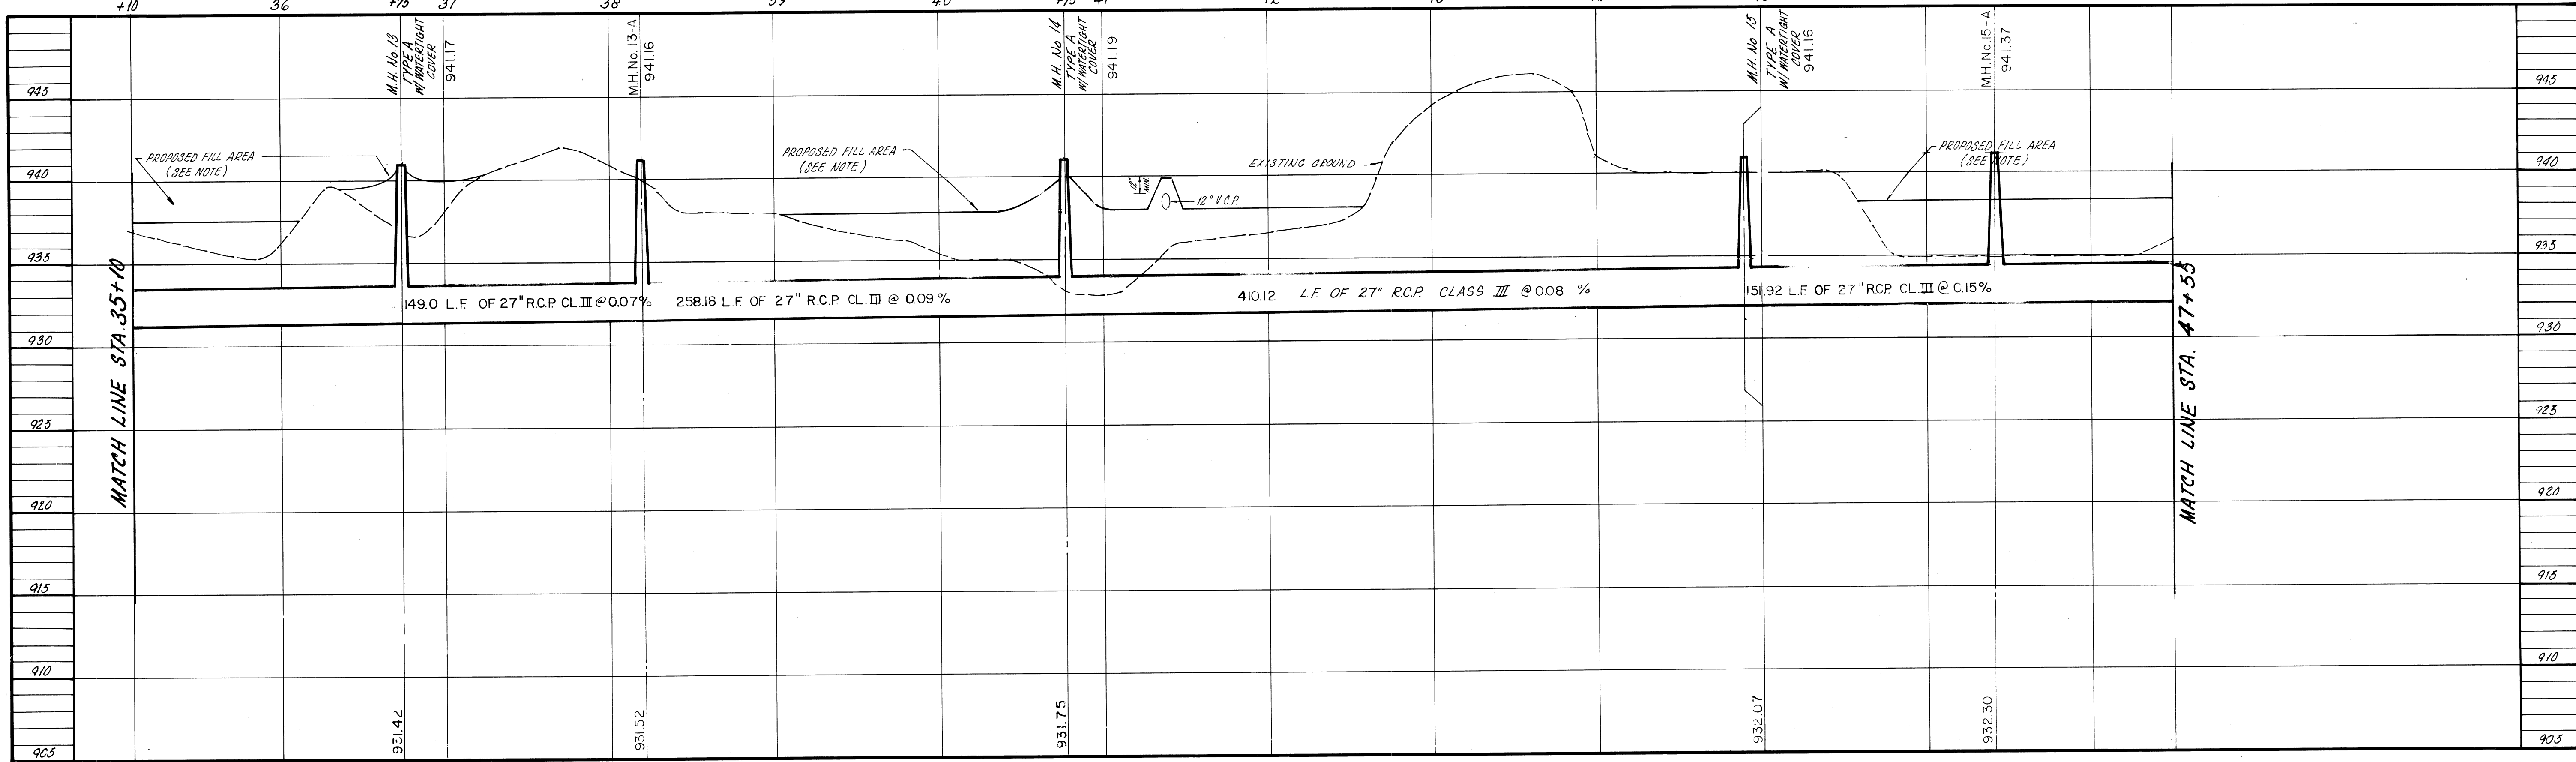

FINAL MEAS 5/85 RLW JR.
DRAWN BY: J.A.S., PEW.
CHECKED BY: R.J.L.
DATE: JUNE 1985




FRANK A. THOMAS & ASSOCIATES, INC.
CONSULTING ENGINEERS
WILLOUGHBY, OHIO

STARK COUNTY, OHIO
SANITARY SEWER IMPROVEMENTS
PROJECT NO. 429
PLAN AND PROFILE

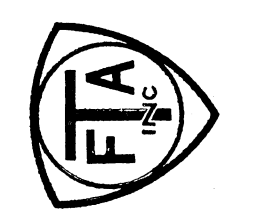

SCALE: HOR. 1"=50' VERT. 1"=5'
8 OF 14 SHEETS
P-1

CONTRACT 1

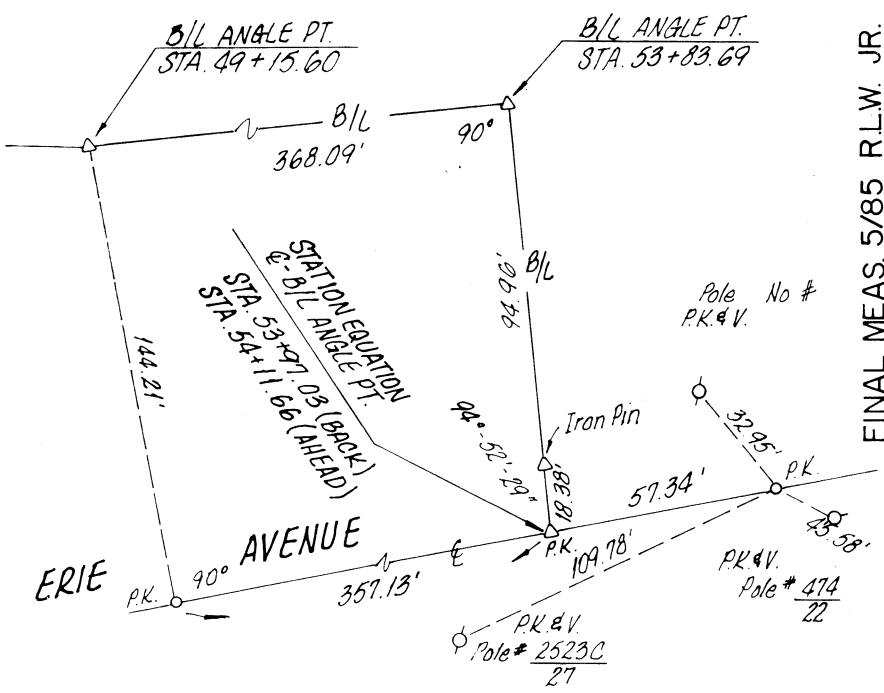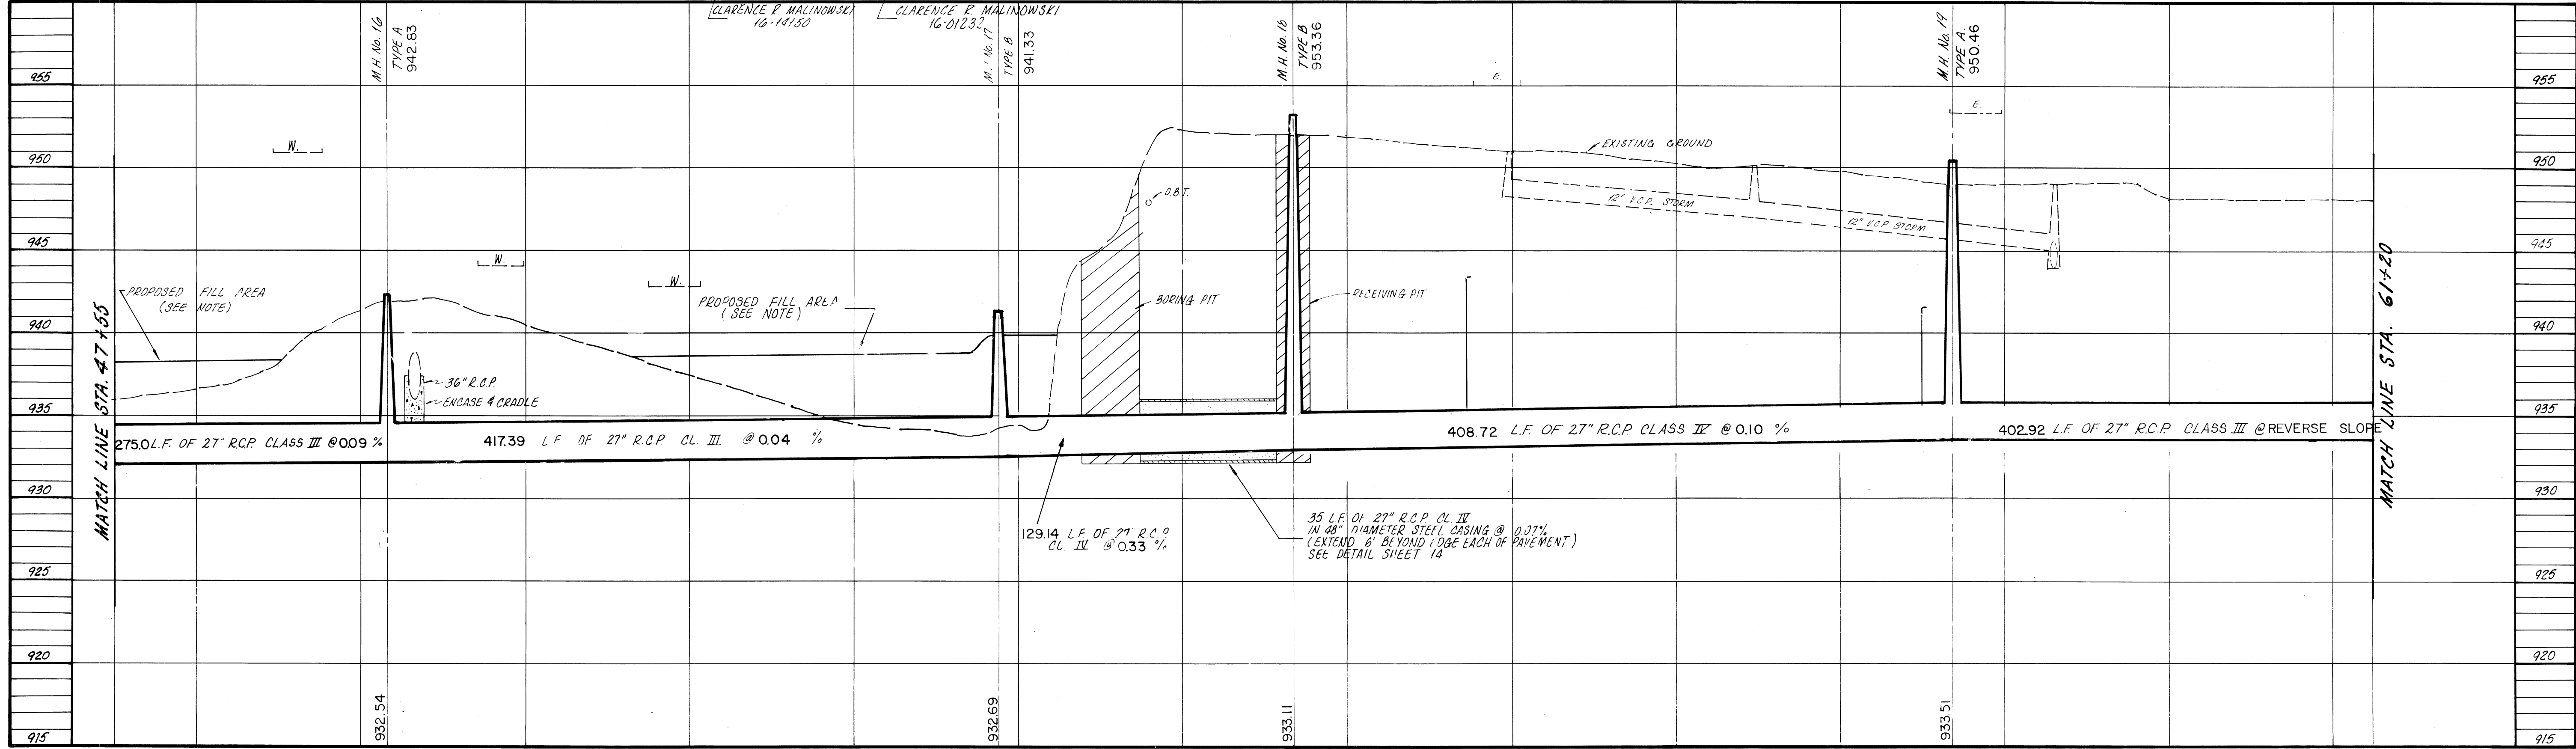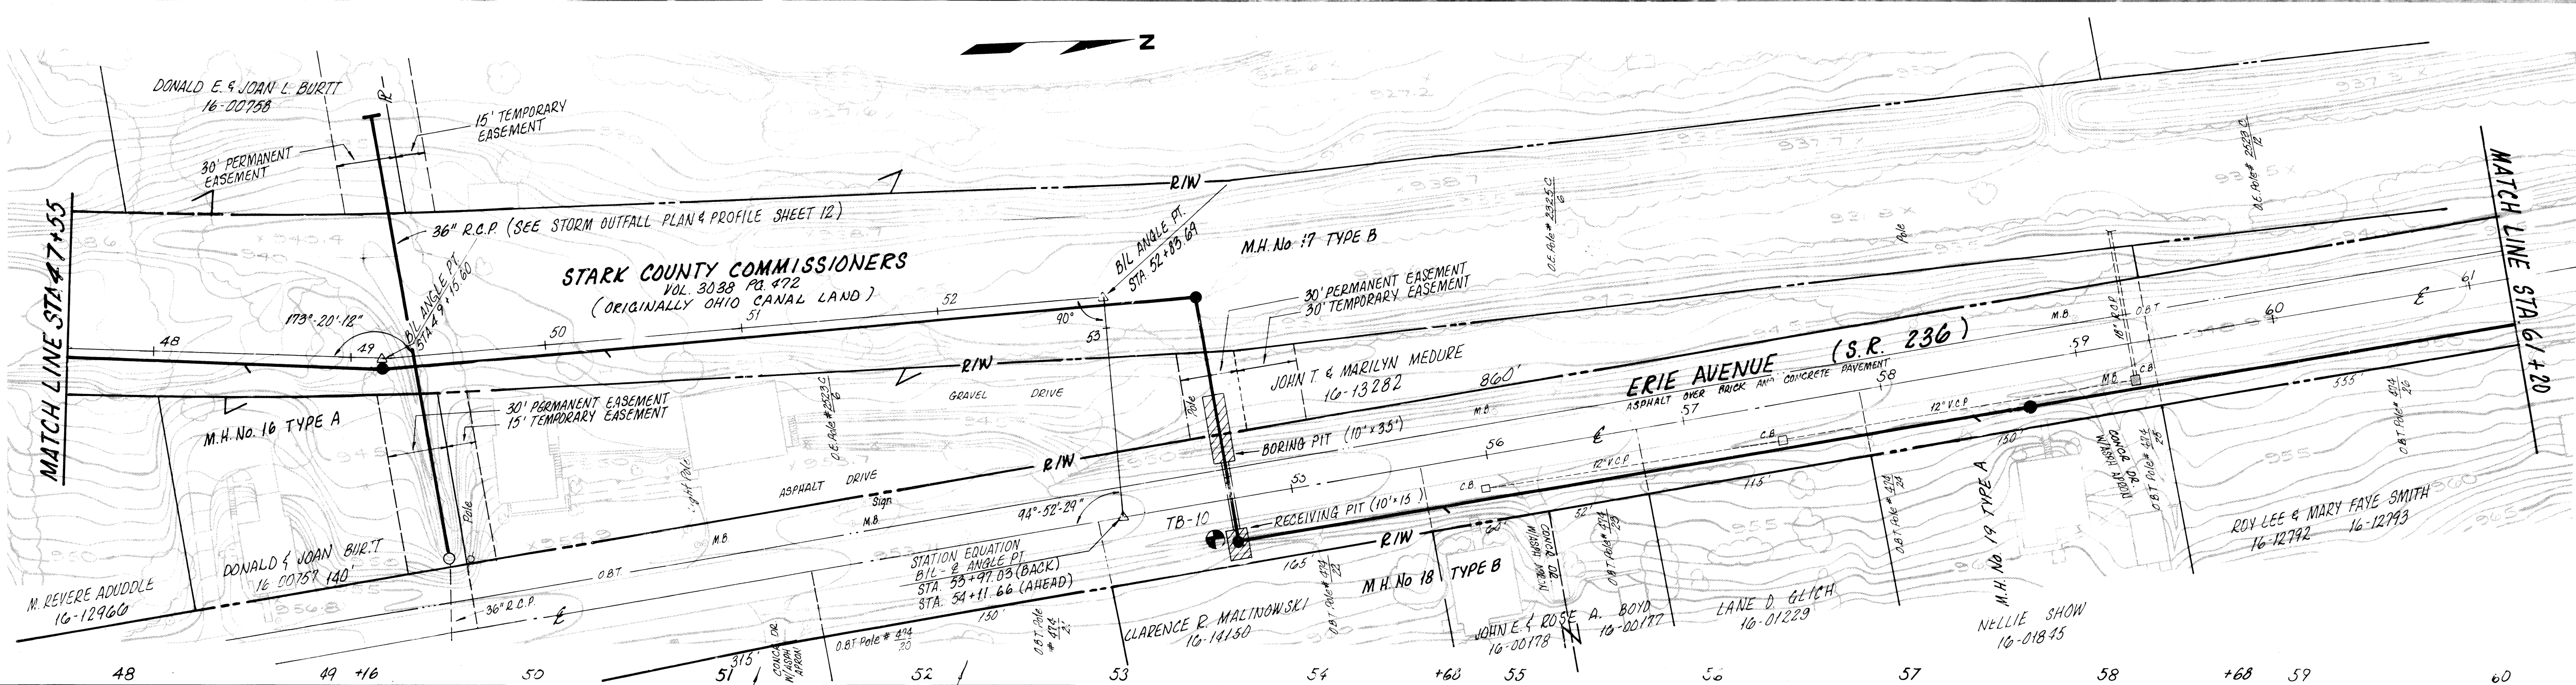

REFERENCES

NOTE:
FOR BORING DETAIL SEE SHEET NO. 12.

NOTE:
SUITABLE BACKFILL (AS PER ITEM 1 OF THE SPECIFICATIONS) SHALL BE PLACED TO THE PROPOSED GRADE WHERE NOTED WITH SIDE SLOPES AT 2:1. MAINTAIN A 4\"/>

ALL C.B. REPLACEMENTS WITHIN S.R. 236 TO CONFORM WITH O.D.O.T. STD. 119 2-2-B

NOTE: SEE SHEET 2 FOR SERVICE BRANCH SCHEDULE

THEEETING SHALL BE LEFT IN PLACE FROM STA. 54+73 TO STA. 61+20 ALONG THE WEST SIDE OF TRENCH.


ERIE AVENUE (S.R. 236) PAVEMENT REPLACEMENT 2\"/>

BENCH MARK:
NAIL 1.3\"/>

DRAWN BY: J.A.S. LEW
CHECKED BY: R.J.I.
DATE: JUNE 1983



FRANK A. THOMAS & ASSOCIATES, INC.
CONSULTING ENGINEERS
WILLOUGHBY, OHIO

STARK COUNTY, OHIO
SANITARY SEWER IMPROVEMENTS
PROJECT NO. 429
PLAN AND PROFILE

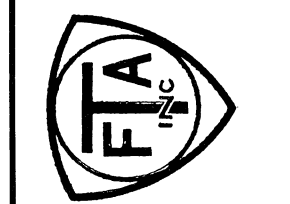

SCALE: 1\"/>

CONTRACT 1

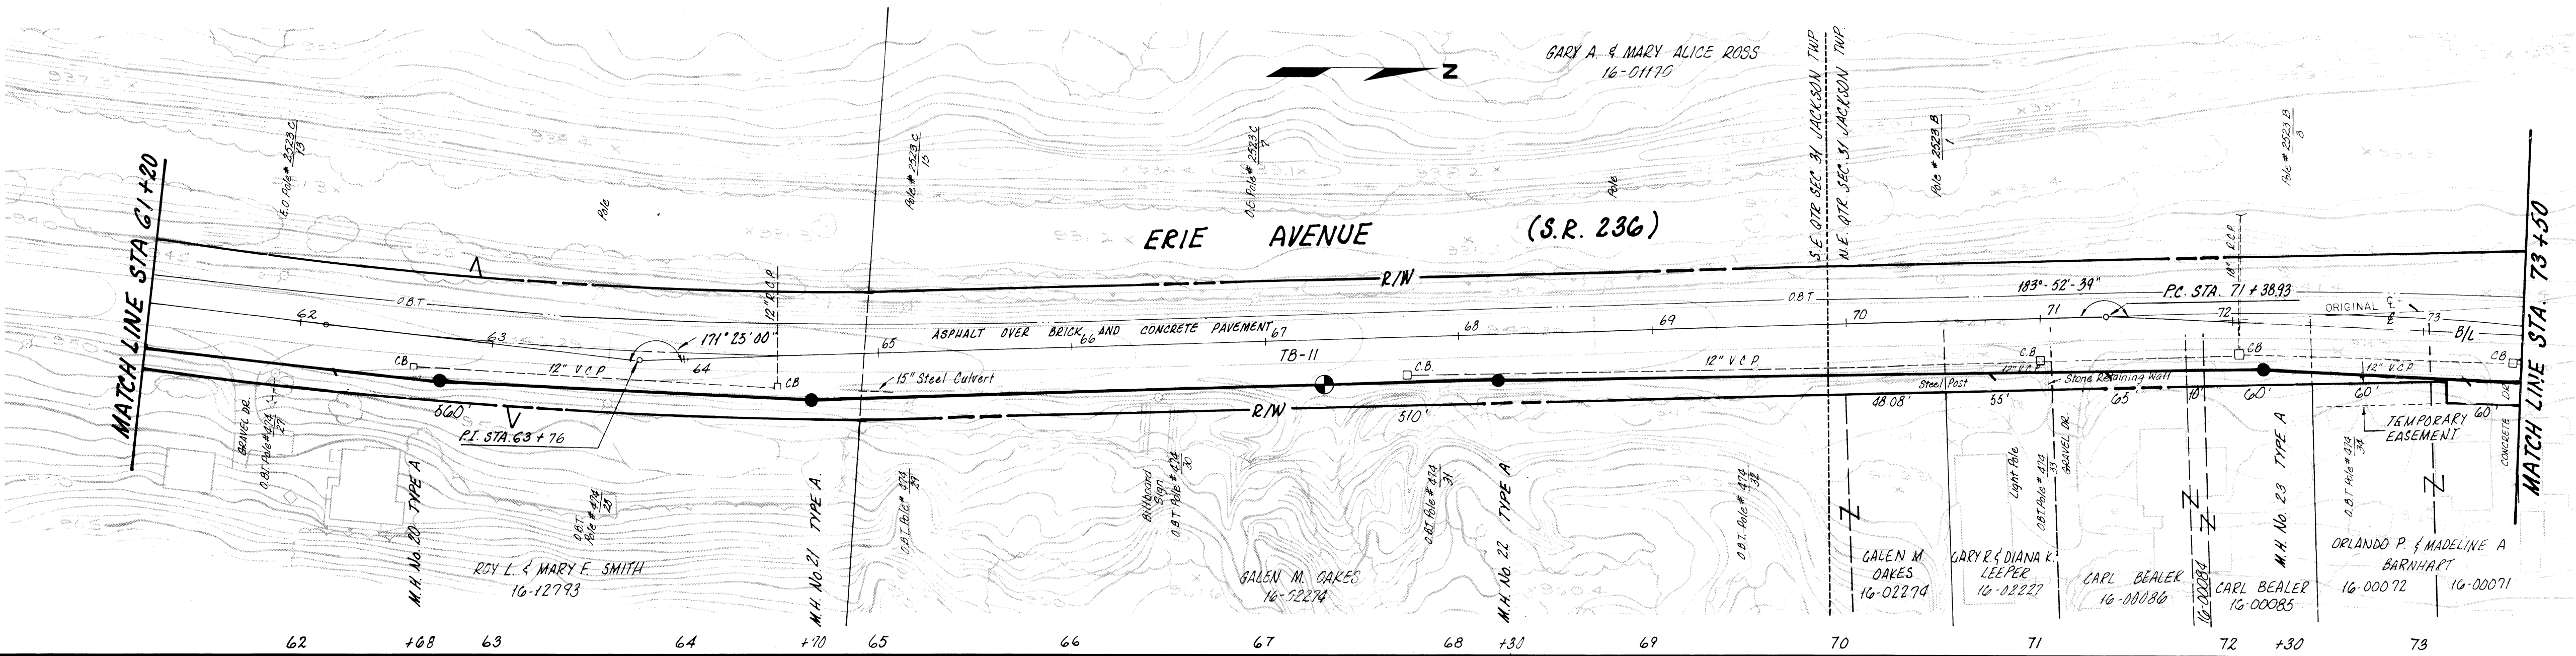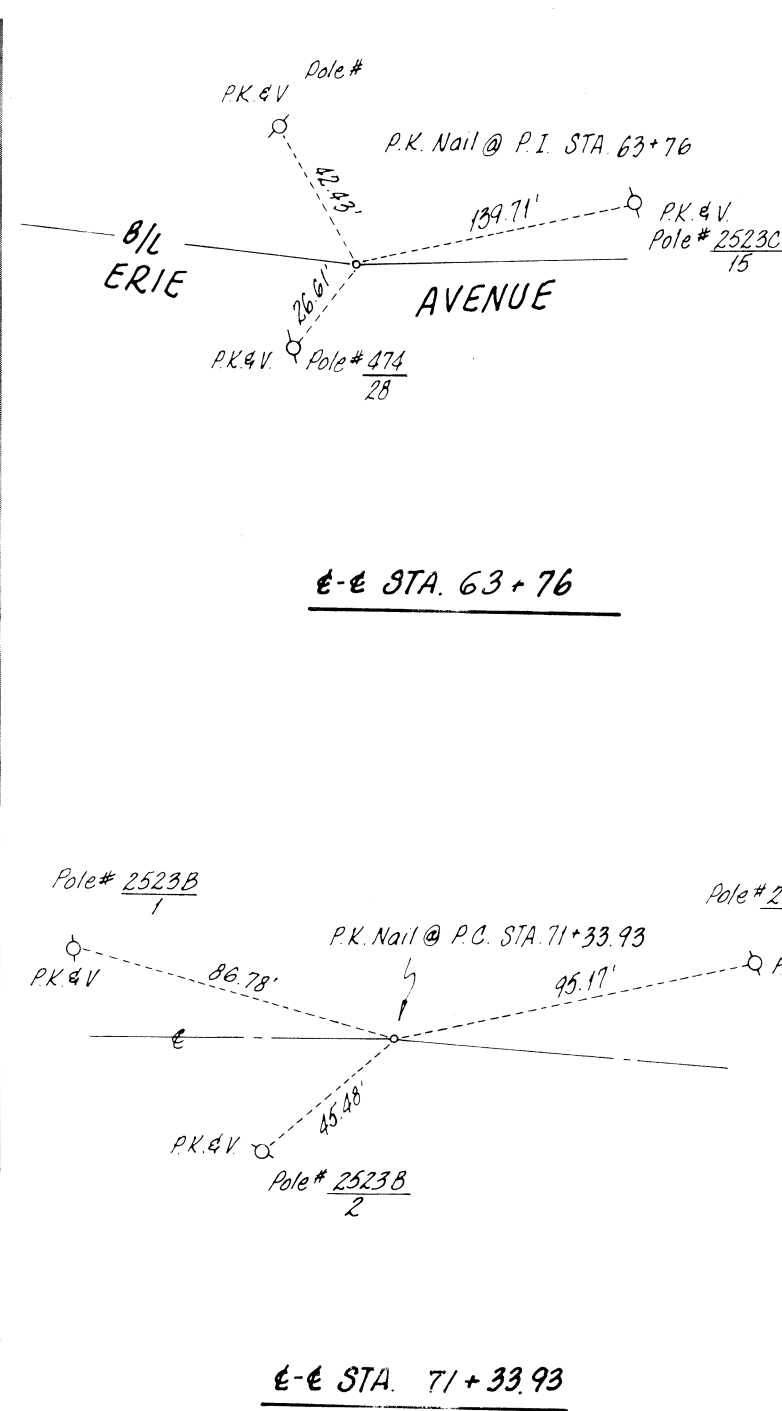


NOTE: SEE SHEET 2 FOR SERVICE
BRANCH SCHEDULE.

SHEETING SHALL BE LEFT IN PLACE
FROM STA. 61+20 TO STA. 64+70 ALONG
THE WEST SIDE OF THE TRENCH.

ALL C.B. REPLACEMENTS WITHIN
S.R. 236 TO CONFORM WITH O.D.O.T.
STD. NO. 2-2-B.

ERIE AVENUE (S.R. 236)
PAVEMENT REPLACEMENT
2 1/2\"/>

BENCH MARK:
NAIL 1.5' UP EAST SIDE OF
POLE NO. 2523 B
ELEV. = 944.22

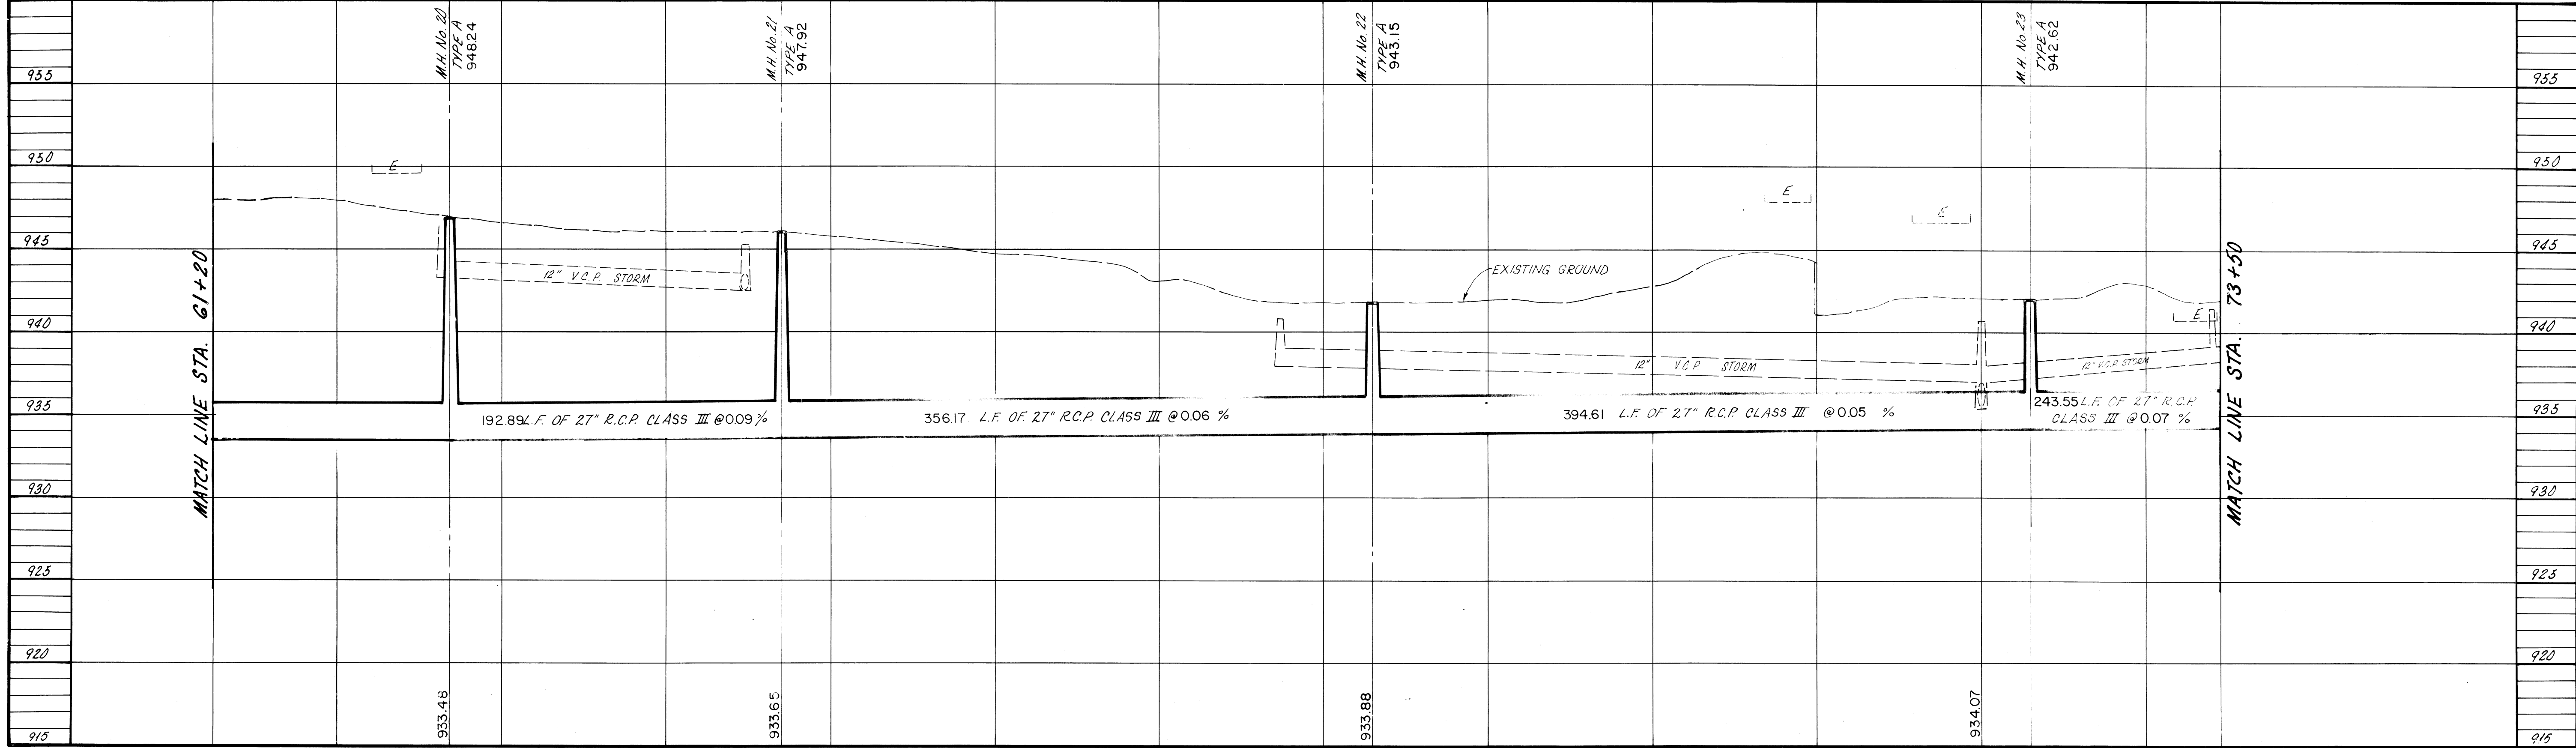


FINAL MEAS 5/85 RLW JR.

DRAWN BY: J.A.S., FEW
CHECKED BY: R.J.I.
DATE: JUNE, 1993




FRANK A. THOMAS & ASSOCIATES, INC.
CONSULTING ENGINEERS
WILLOUGHBY, OHIO

STARK COUNTY, OHIO
SANITARY SEWER IMPROVEMENTS
PROJECT NO. 429
PLAN AND PROFILE

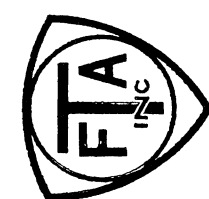

SCALE: HOR. 1"=50' VERT. 1"=5'
81131
10 OF 14 SHEETS

P-1

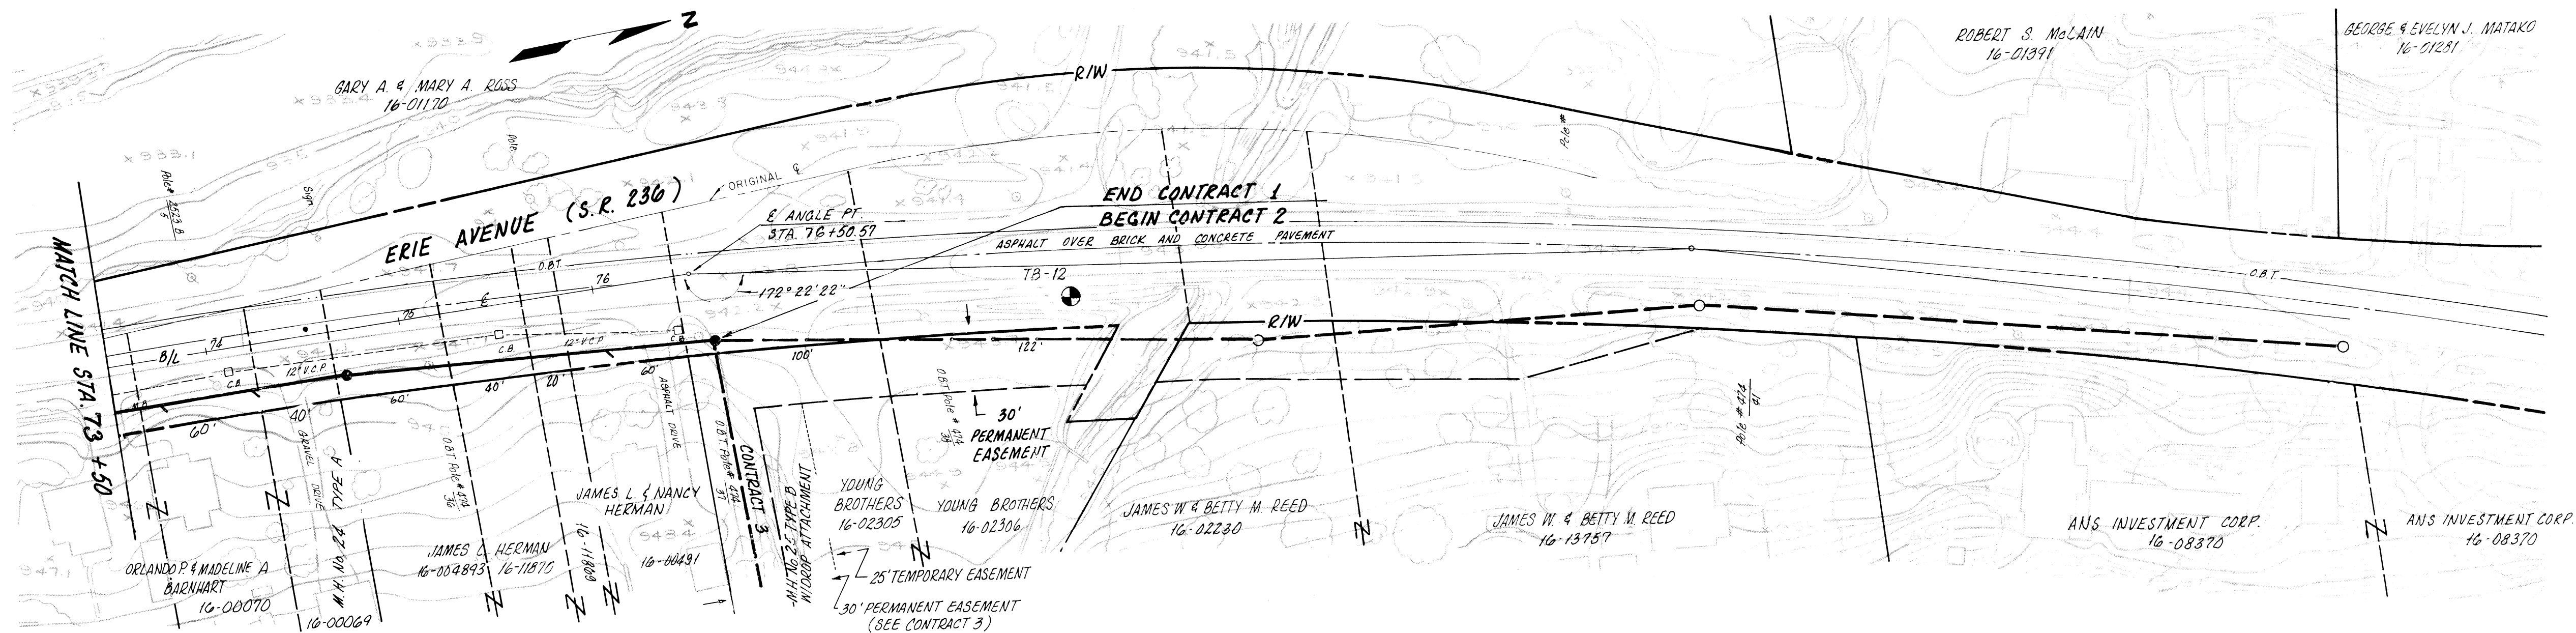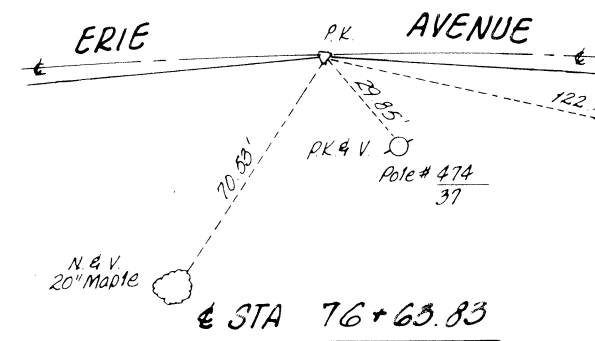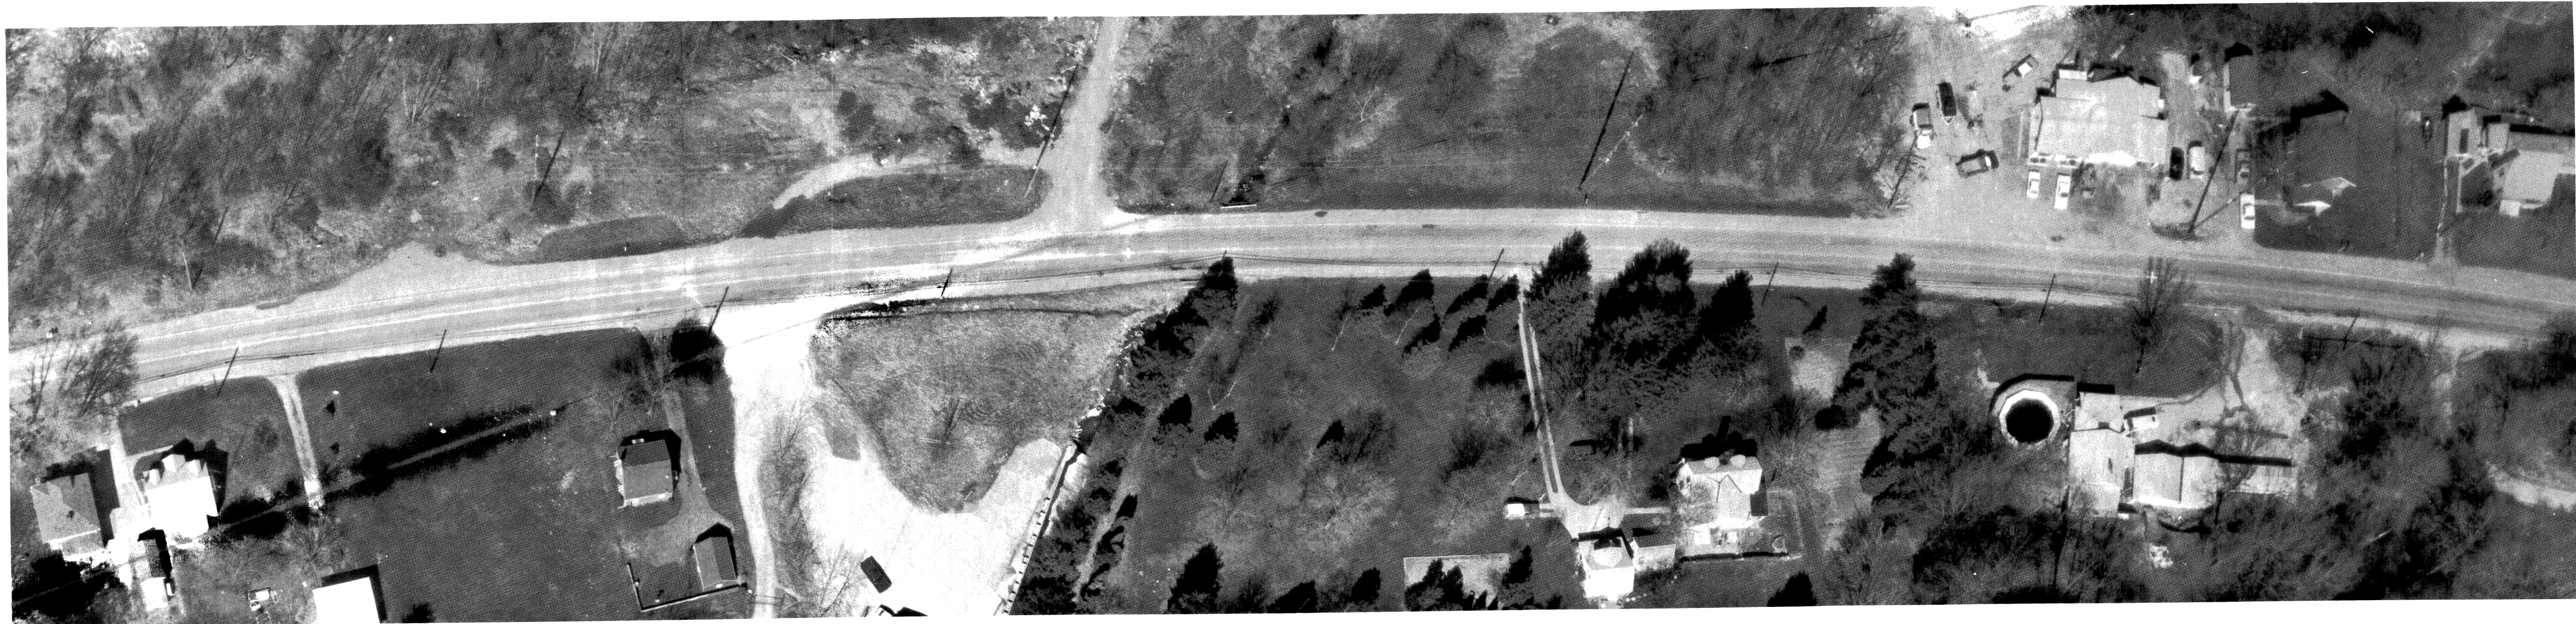


ALL C.B. REPLACEMENTS WITHIN S.R. 236 TO CONFORM WITH O.D.O.T. STD. N° 2-2-B

NOTE: SEE SHEET 2 FOR SERVICE BRANCH SCHEDULE.

ERIE AVENUE (S.R. 236) PAVEMENT REPLACEMENT, 2 1/2" ASPHALT CONCRETE WITH 10" PORTLAND CEMENT CONCRETE BASE.


BENCH MARK: RAILROAD SPIKE 0.5' UP SOUTH SIDE OF POLE No. 474 38 ELEV. = 943.71

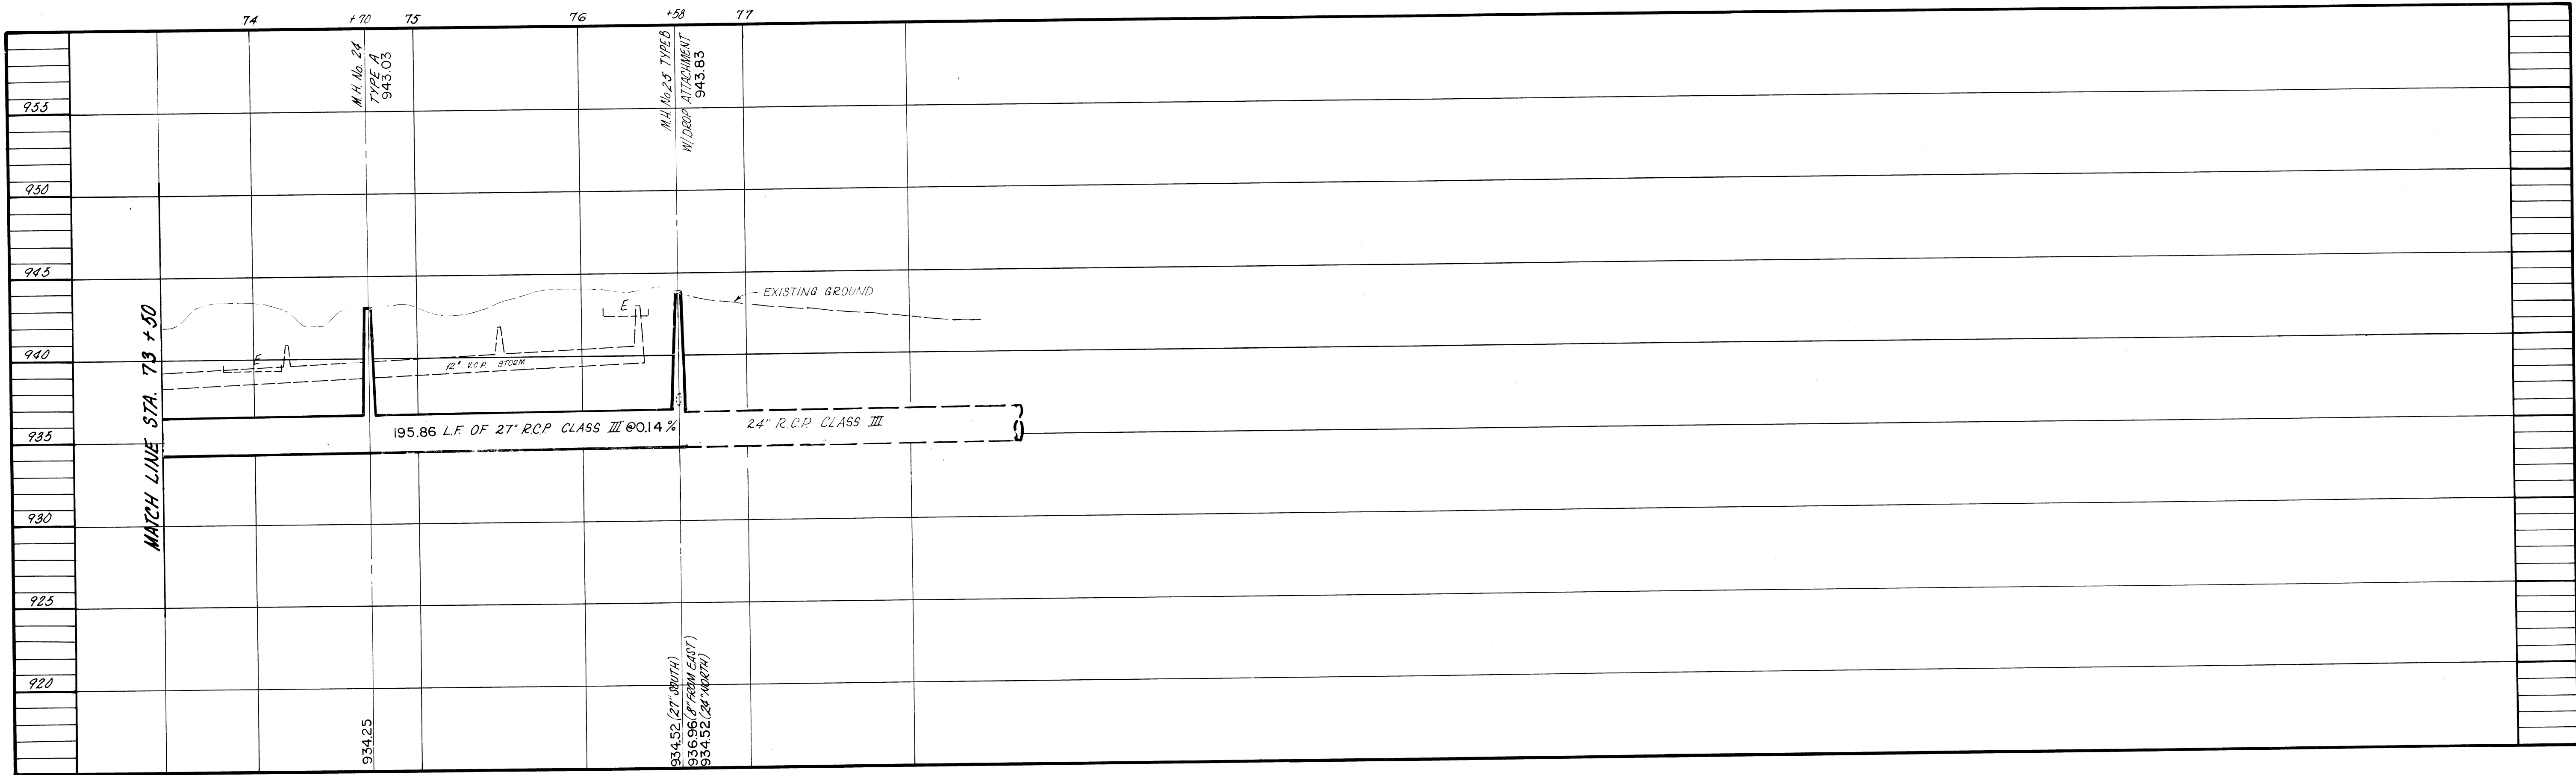


FINAL MEAS 5/85 RLW JR.
DRAWN BY: J.A.S., FEW
CHECKED BY: R.J.I.
DATE: JUNE, 1983

FRANK A. THOMAS & ASSOCIATES, INC.
CONSULTING ENGINEERS
WILLOUGHBY, OHIO

STARK COUNTY, OHIO
SANITARY SEWER IMPROVEMENTS
PROJECT NO. 429
PLAN AND PROFILE

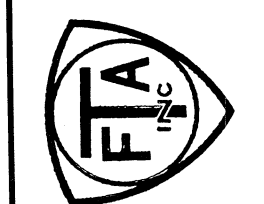


SCALE: 1" = 50' HORIZ. 1" = 5' VERT.
11 OF 14 SHEETS


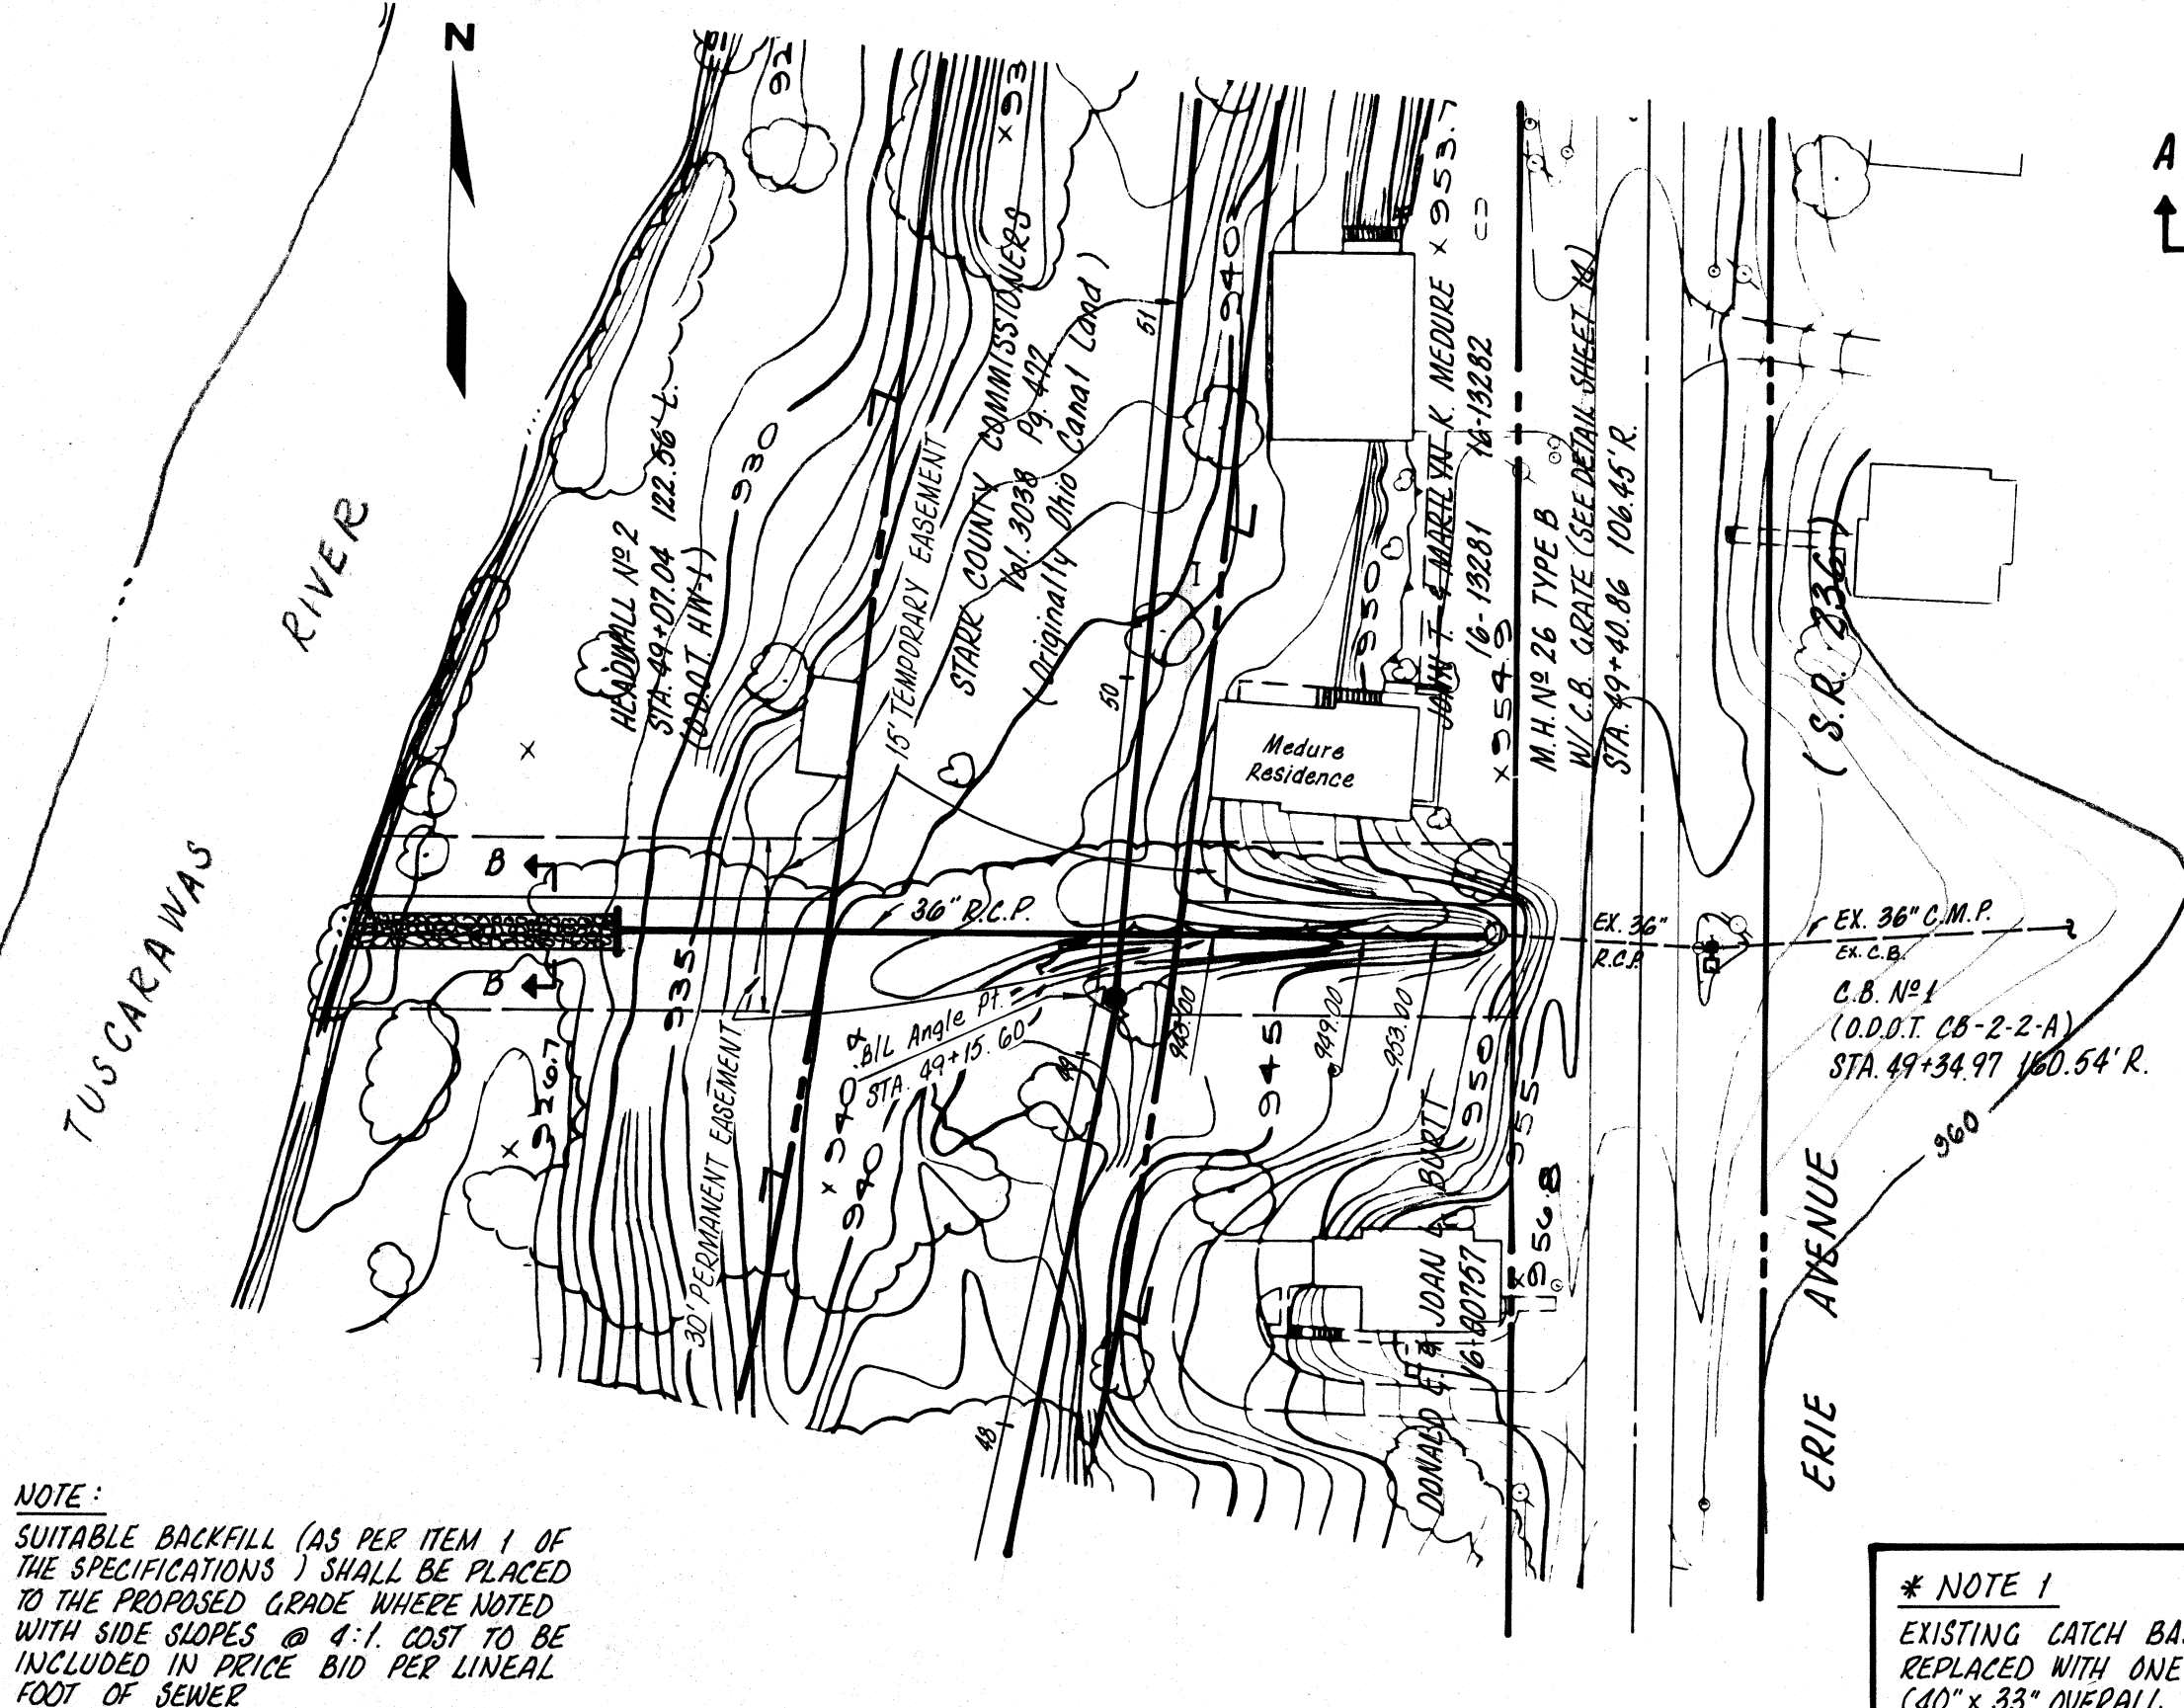


NOTE:
SUITABLE BACKFILL (AS PER ITEM 1 OF THE SPECIFICATIONS) SHALL BE PLACED TO THE PROPOSED GRADE WHERE NOTED WITH SIDE SLOPES @ 4:1. COST TO BE INCLUDED IN PRICE BID PER LINEAL FOOT OF SEWER




STORM OUTFALL PLAN

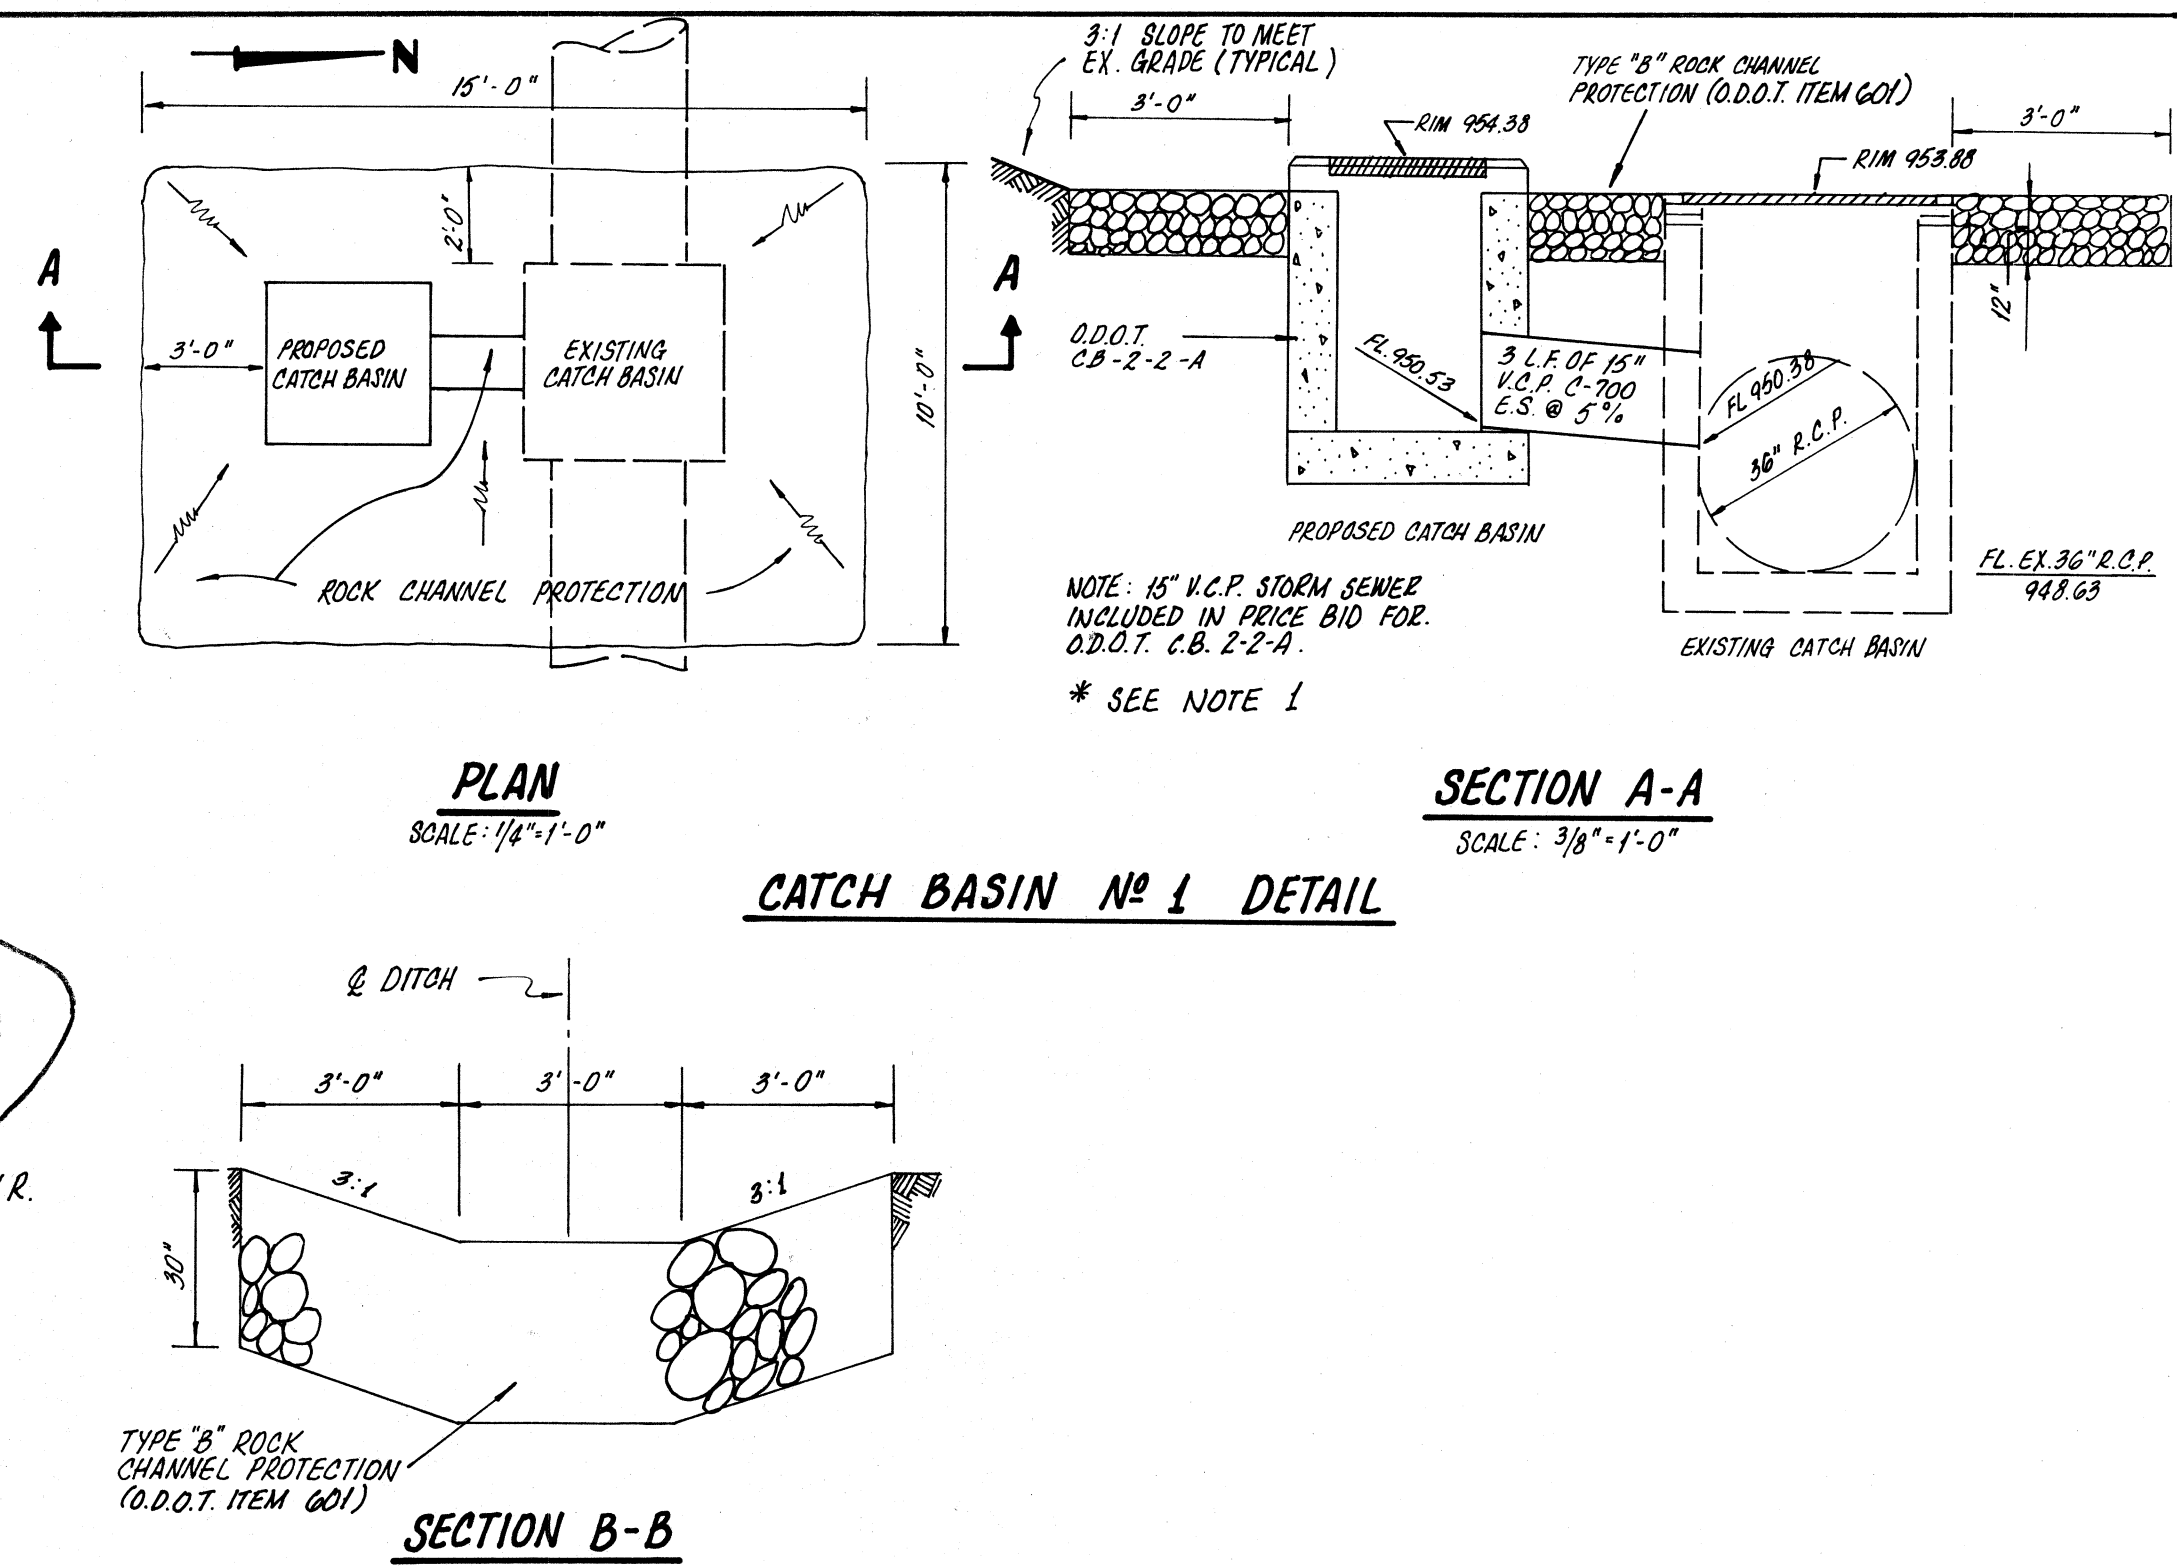

* NOTE 1
EXISTING CATCH BASIN GRATE TO BE REMOVED AND REPLACED WITH ONE (1) NEENAH R-4899 ANGLE FRAME (40" x 33" OVERALL DIMENSION) AND TWO (2) NEENAH R-4780 GRATES (19 1/2" x 32" EACH) OR EQUAL. BOTH CATCH BASINS SHALL BE CLEANED OF ALL LOOSE DEBRIS AT THE COMMENCEMENT OF GRADING AROUND THE STRUCTURES.

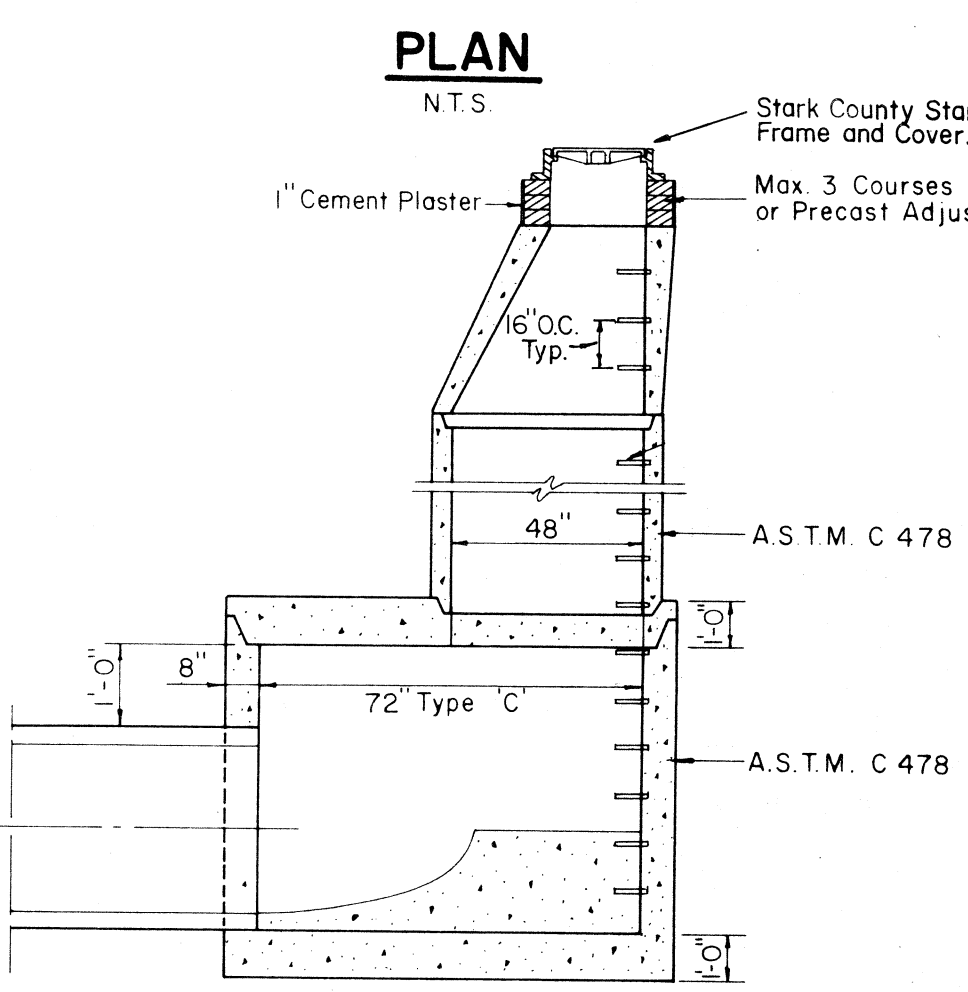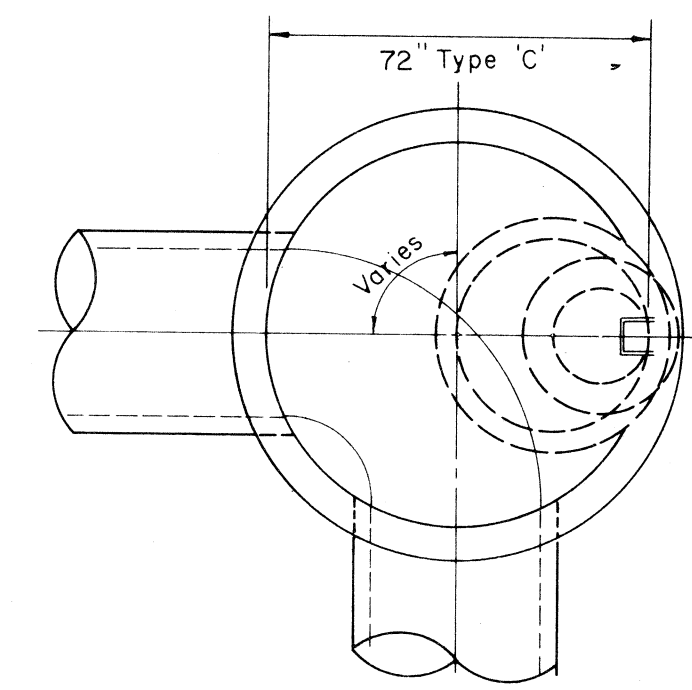


PRECAST MANHOLE TYPE C

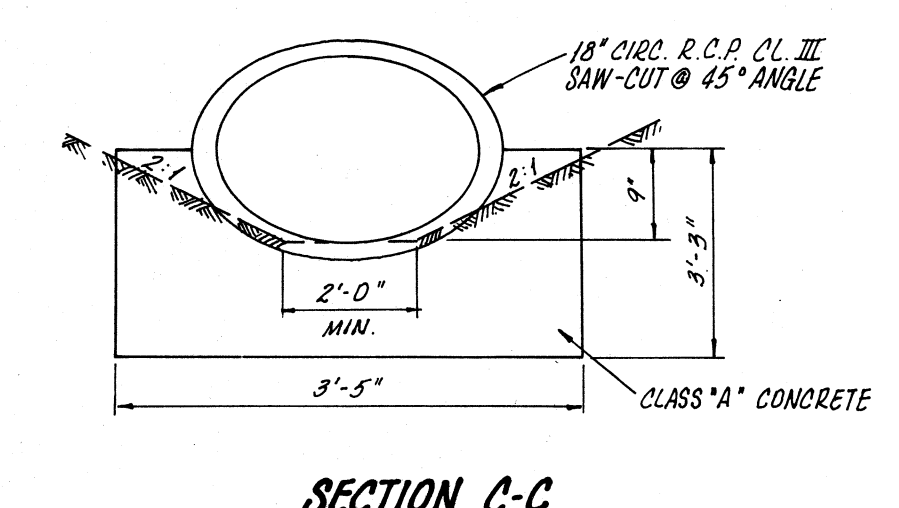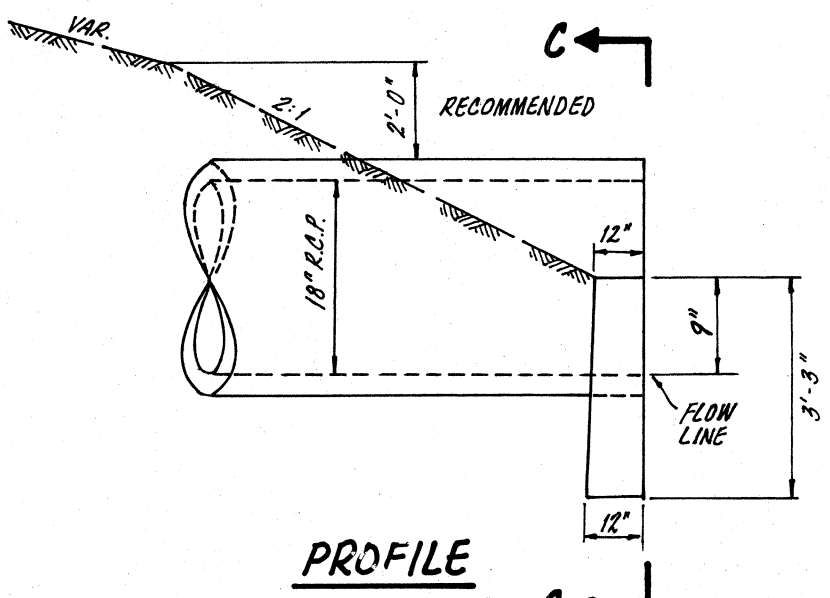
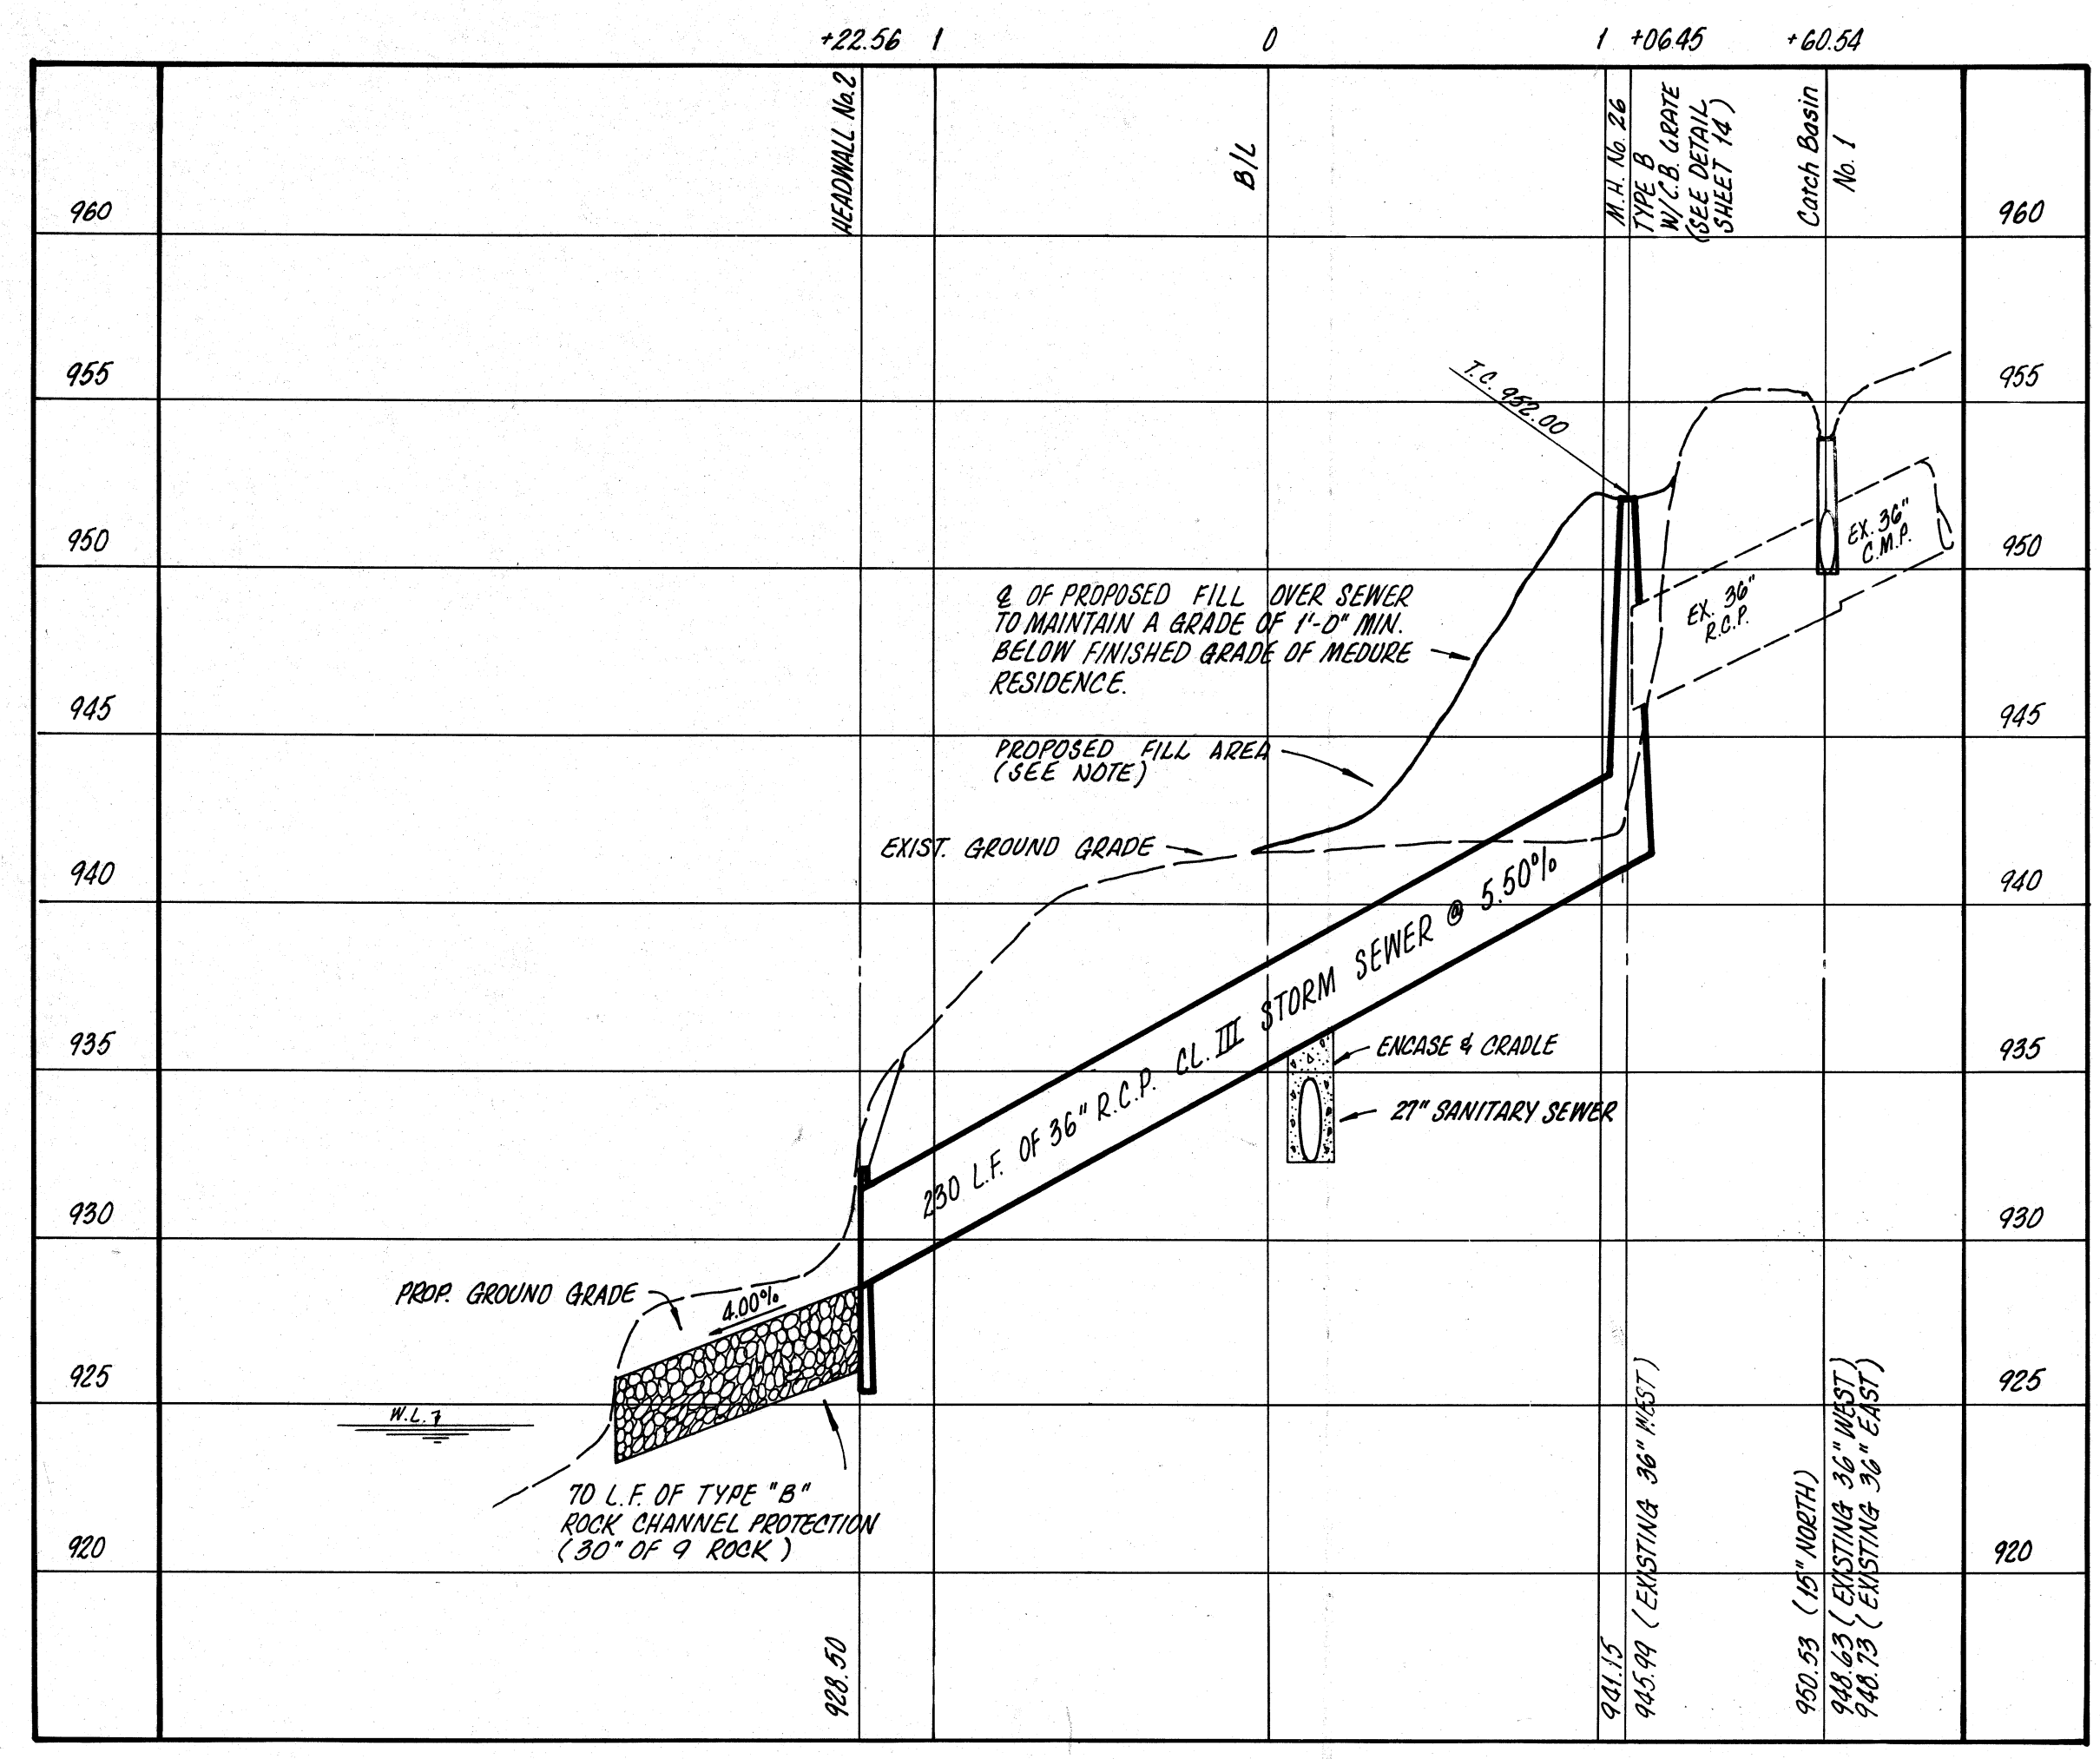



CARRIER PIPE	STEEL CASING PIPE
6" DIA.	14" DIA. - 0.25" THICKNESS
8" DIA.	18" DIA. - 0.25" THICKNESS
27" DIA.	48" DIA. - 0.375" THICKNESS

HEADWALL No 1
(SHEET 7 - STA. 26+37)
N.T.S.

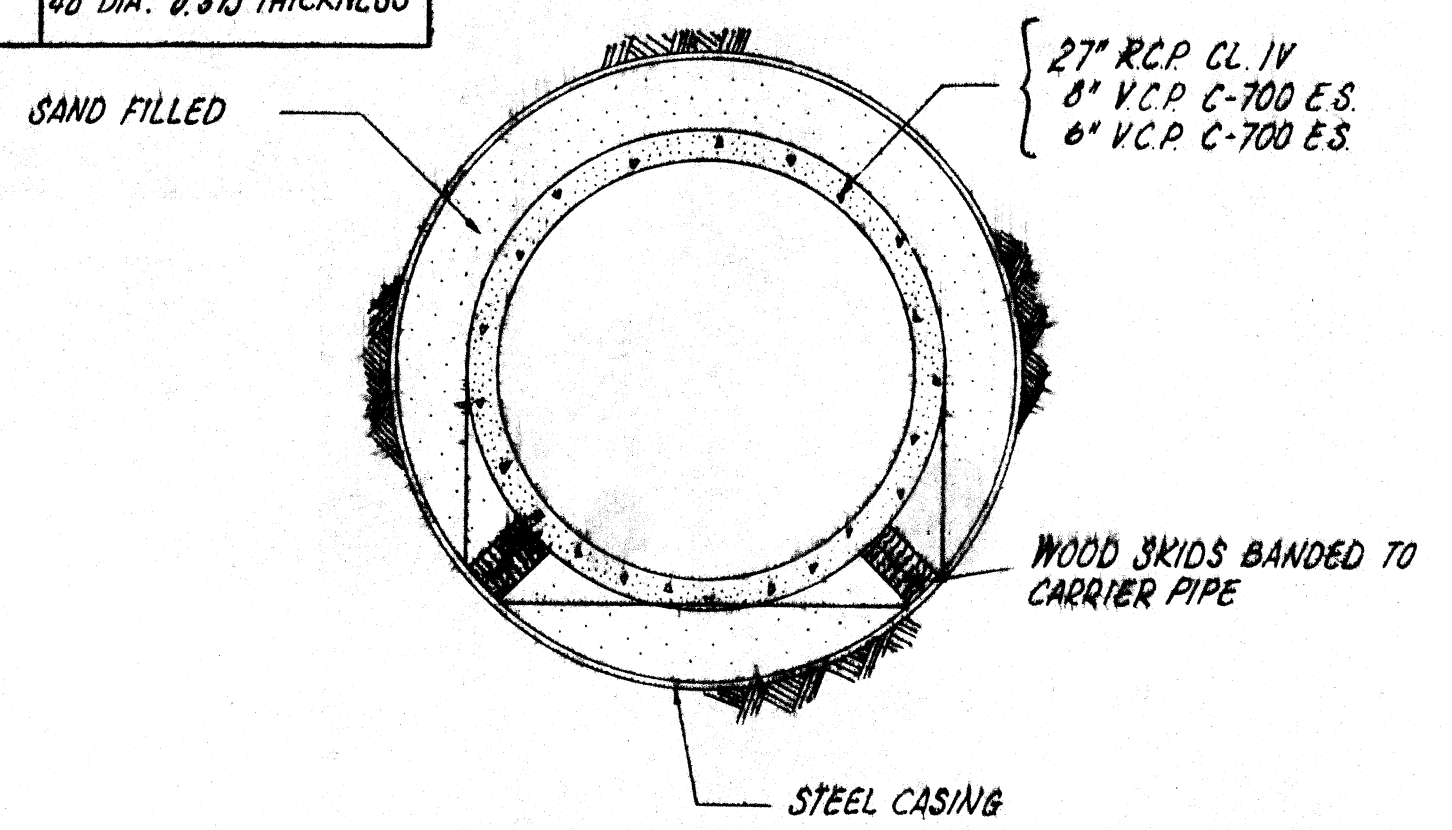


BORING DETAIL
NO SCALE

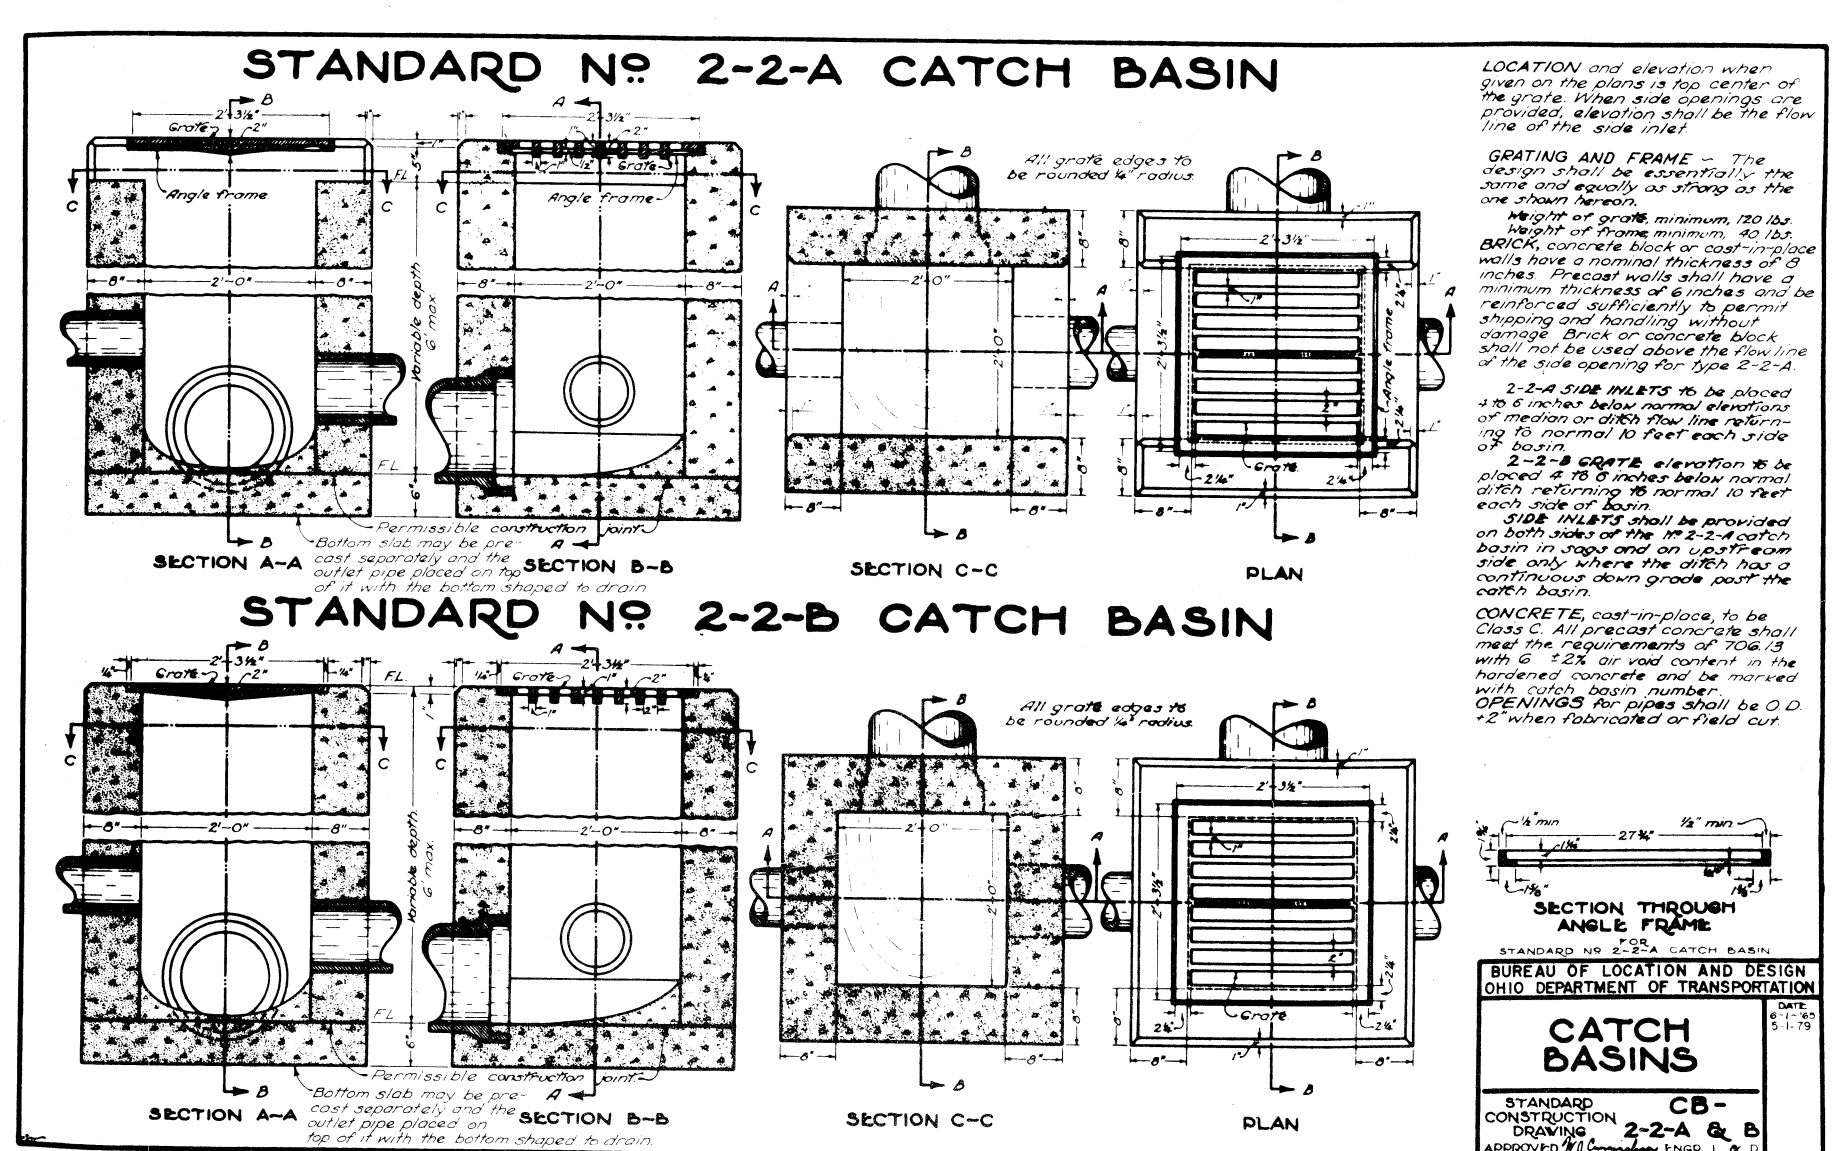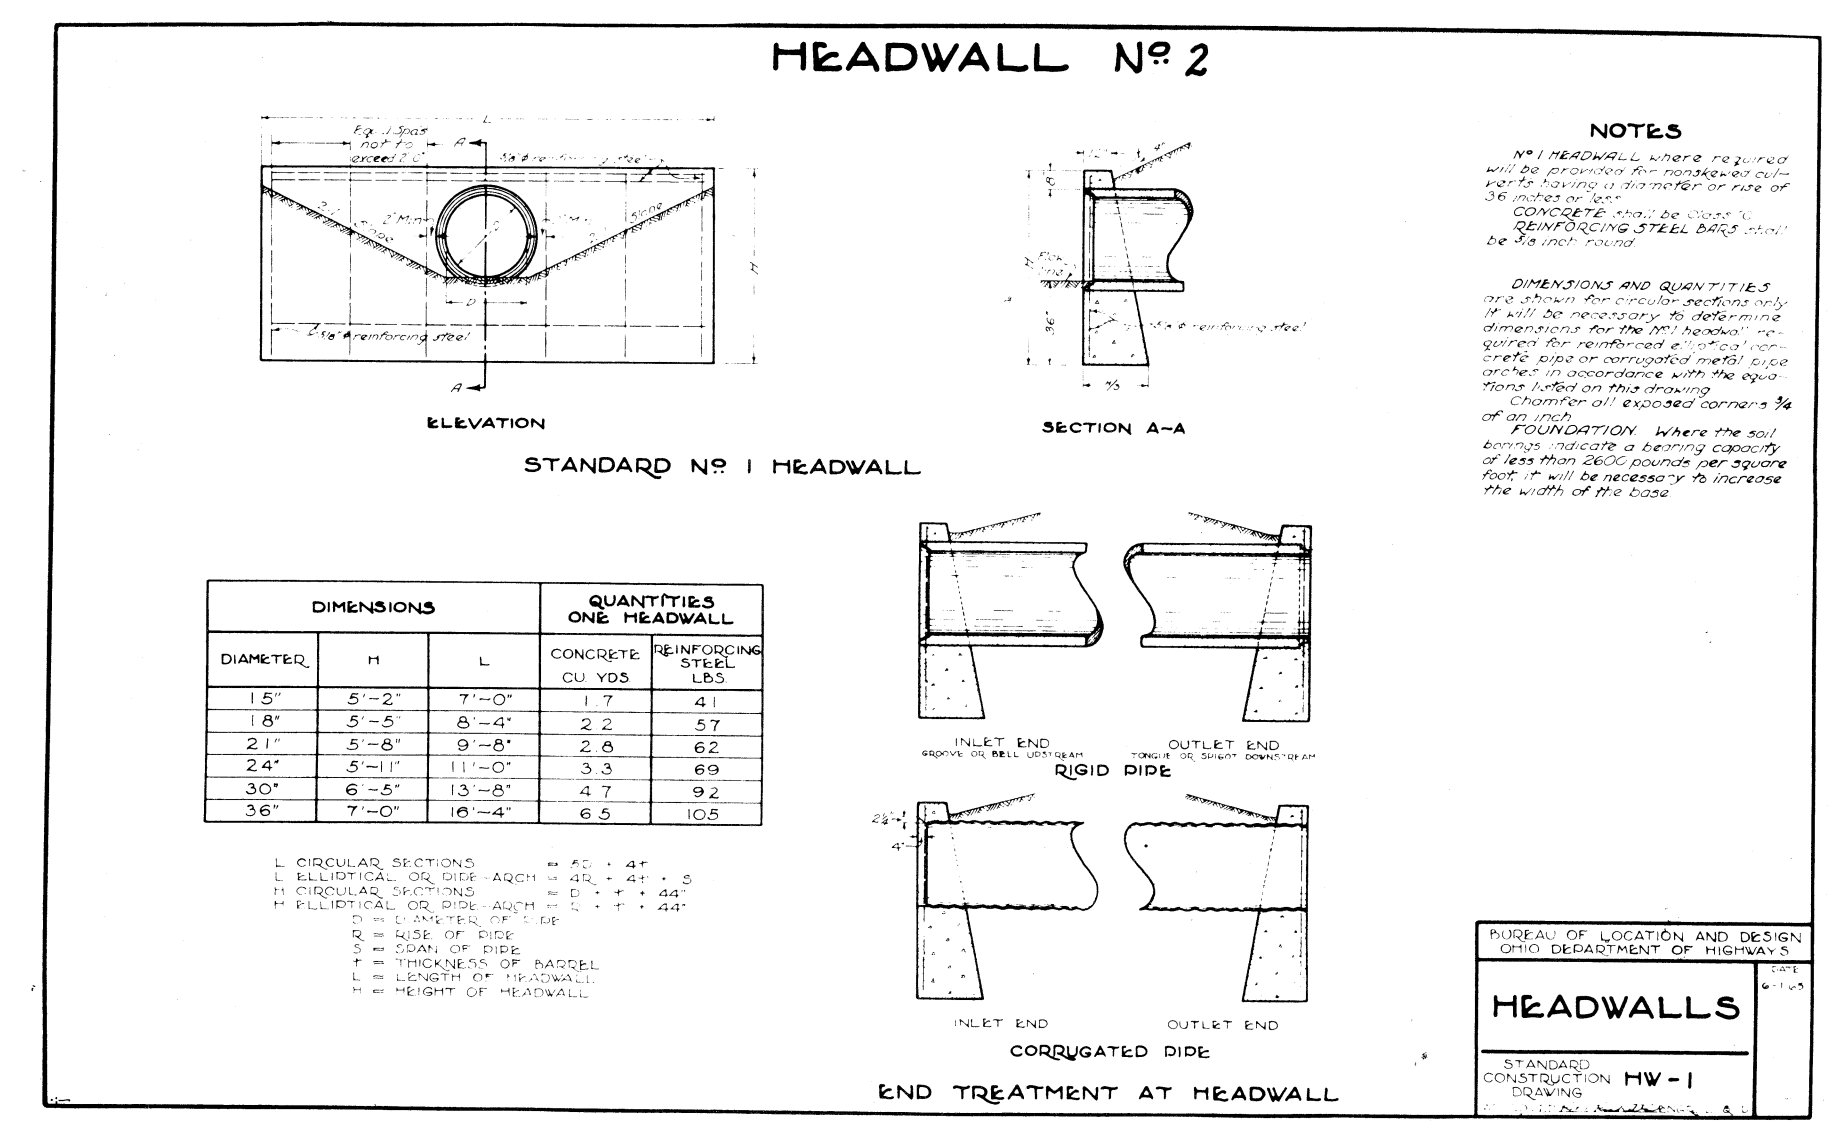


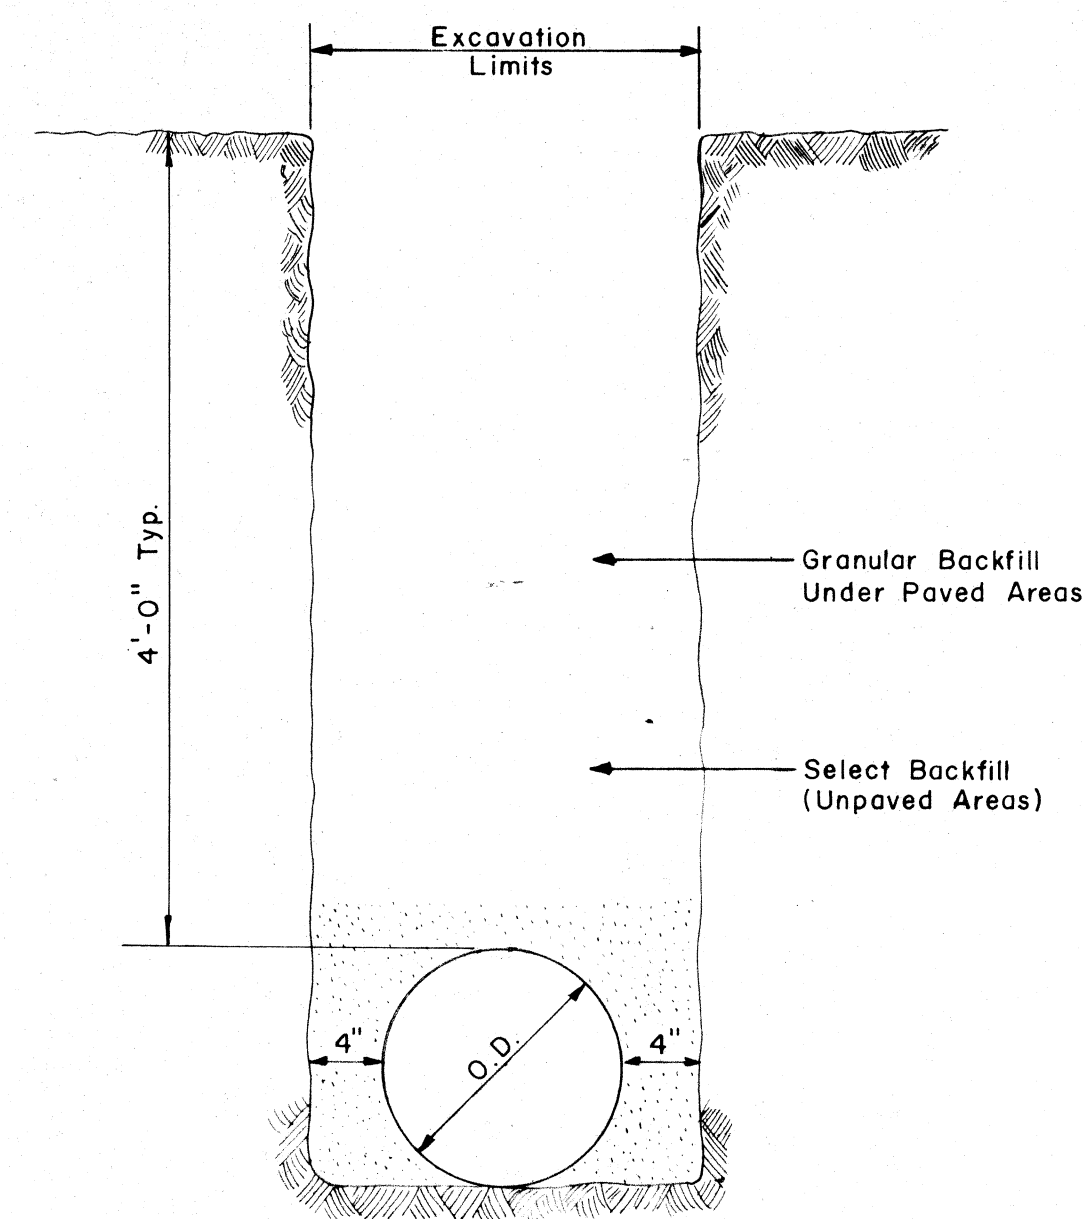



**FORCE MAIN
TRENCH DETAIL**
(LAYING CONDITION 'A')

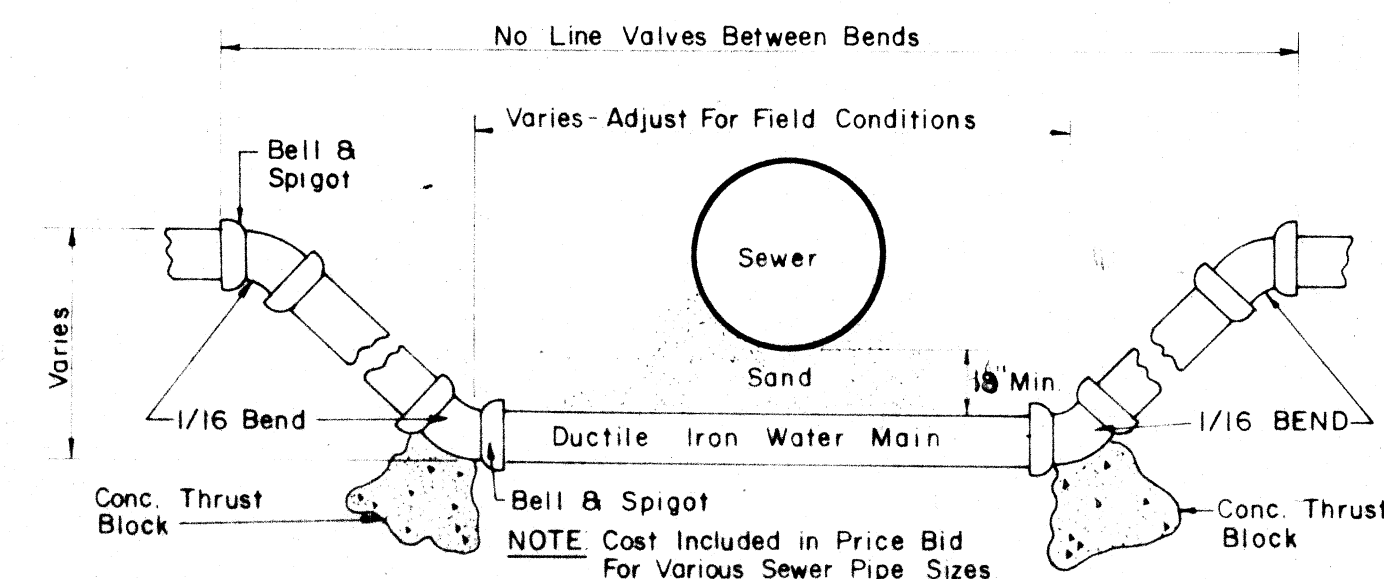



DETAIL OF WATER MAIN LOWERING
NO SCALE

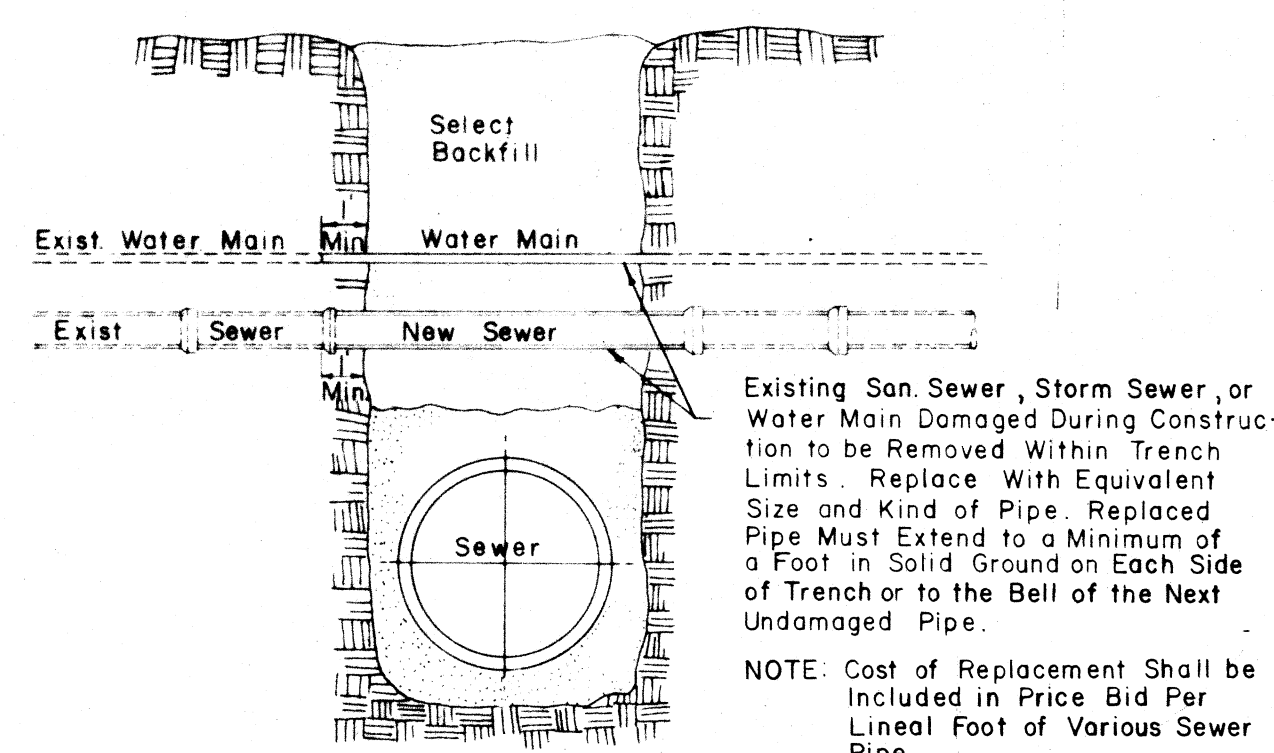


DETAIL OF REPLACEMENT
NO SCALE

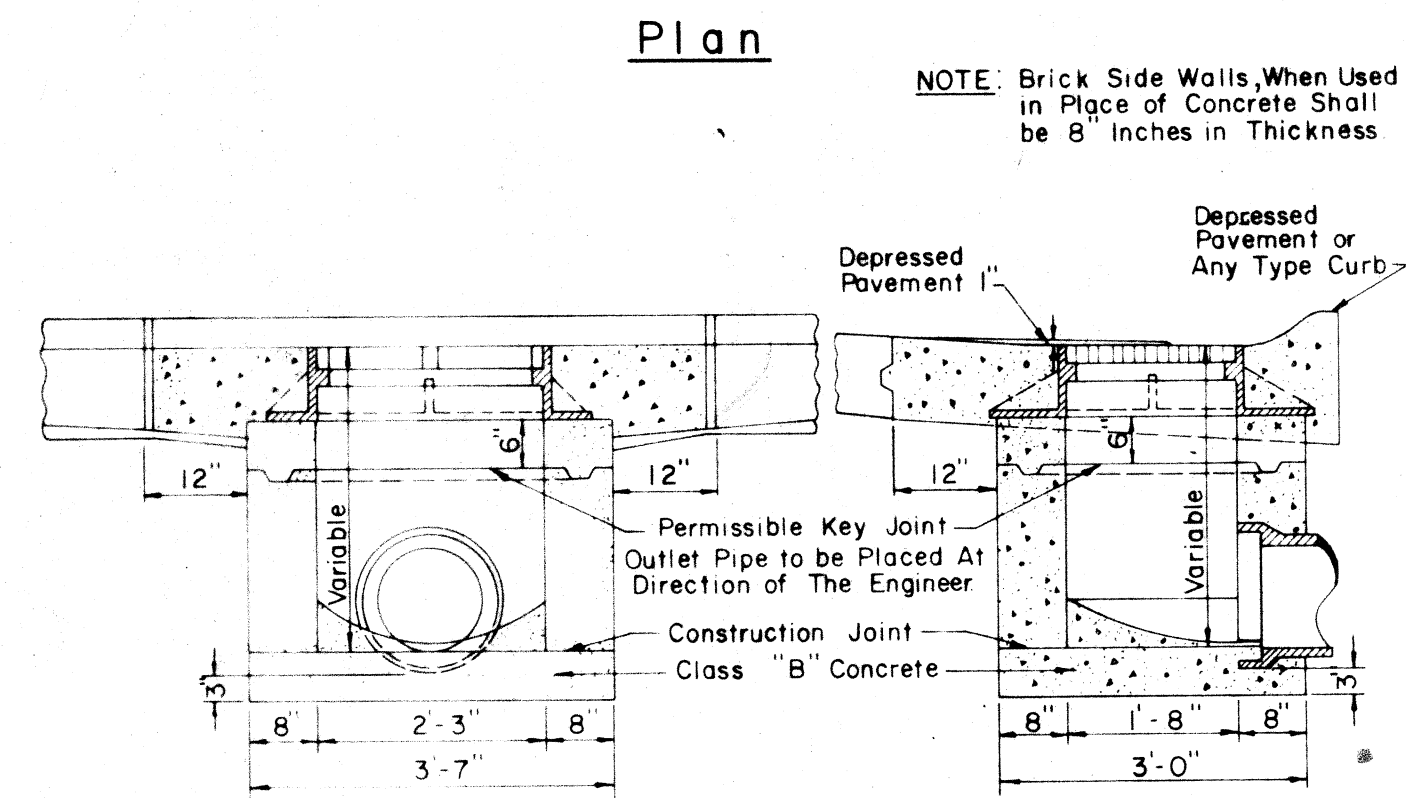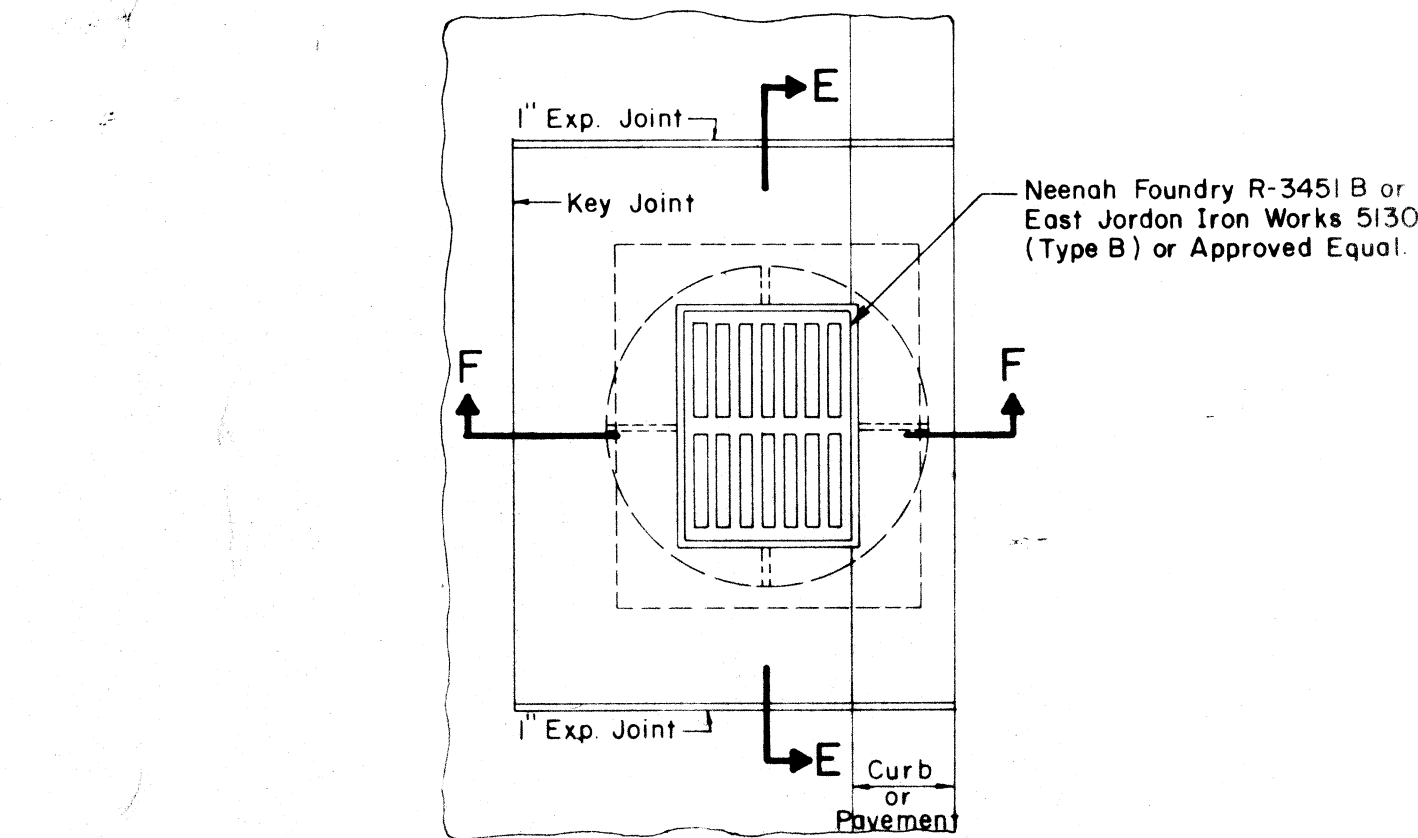


Section E-E
Section F-F
STANDARD CATCH BASIN
NO SCALE

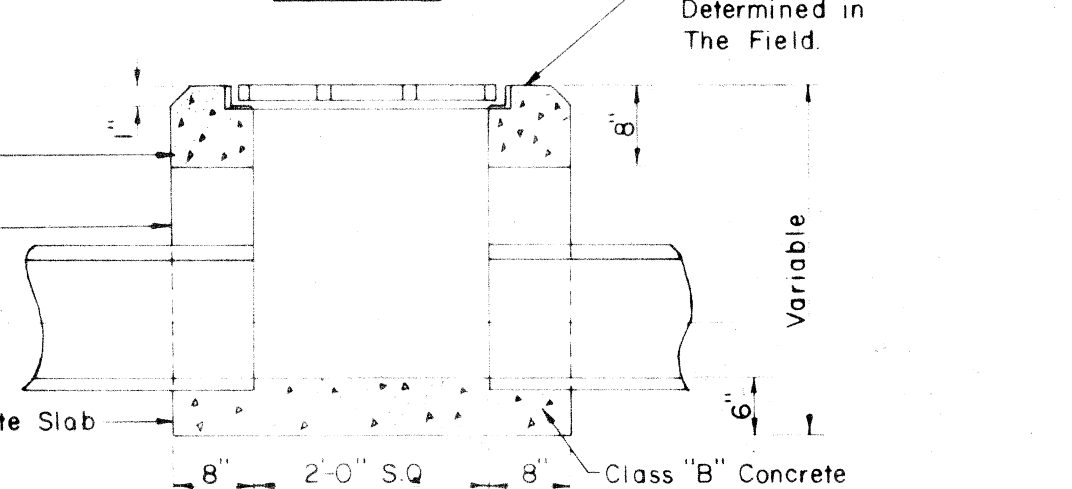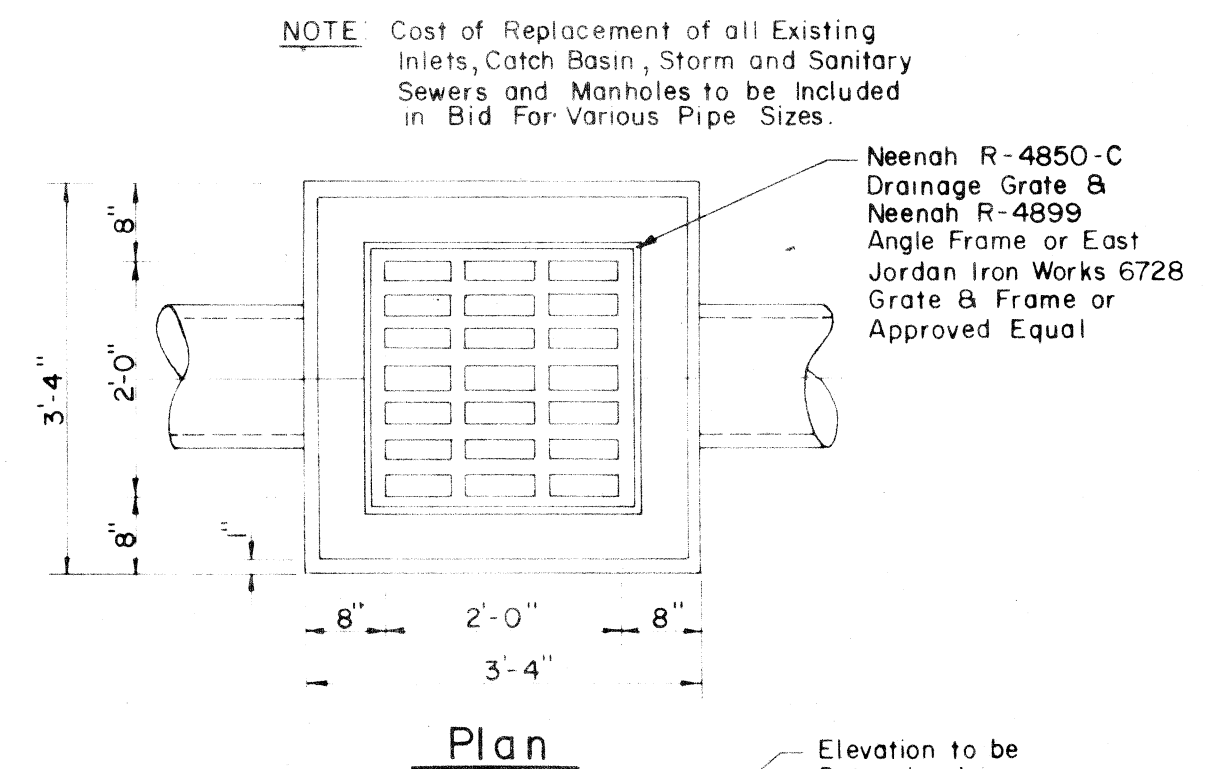


Section
STANDARD INLET DETAIL
NO SCALE

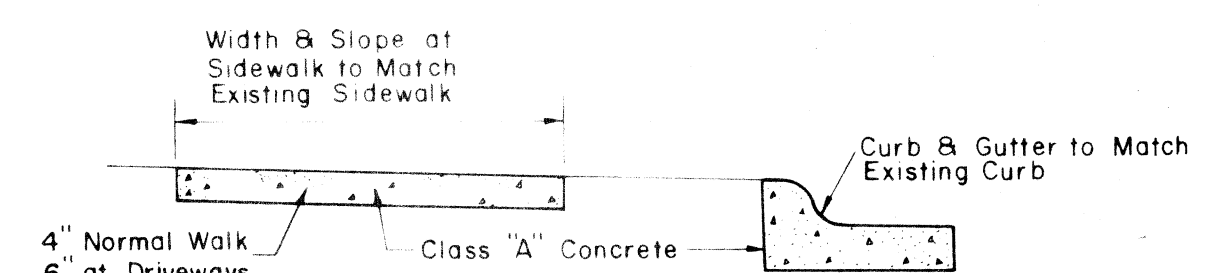


SIDEWALK CURB & GUTTER DETAIL
NO SCALE

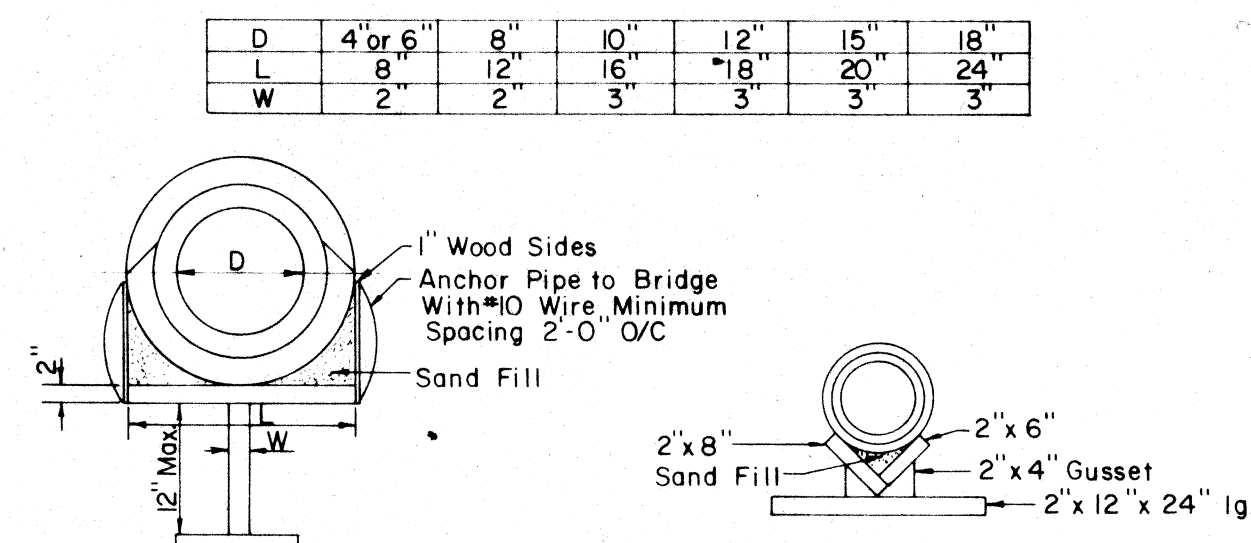


Section E-E
Section F-F

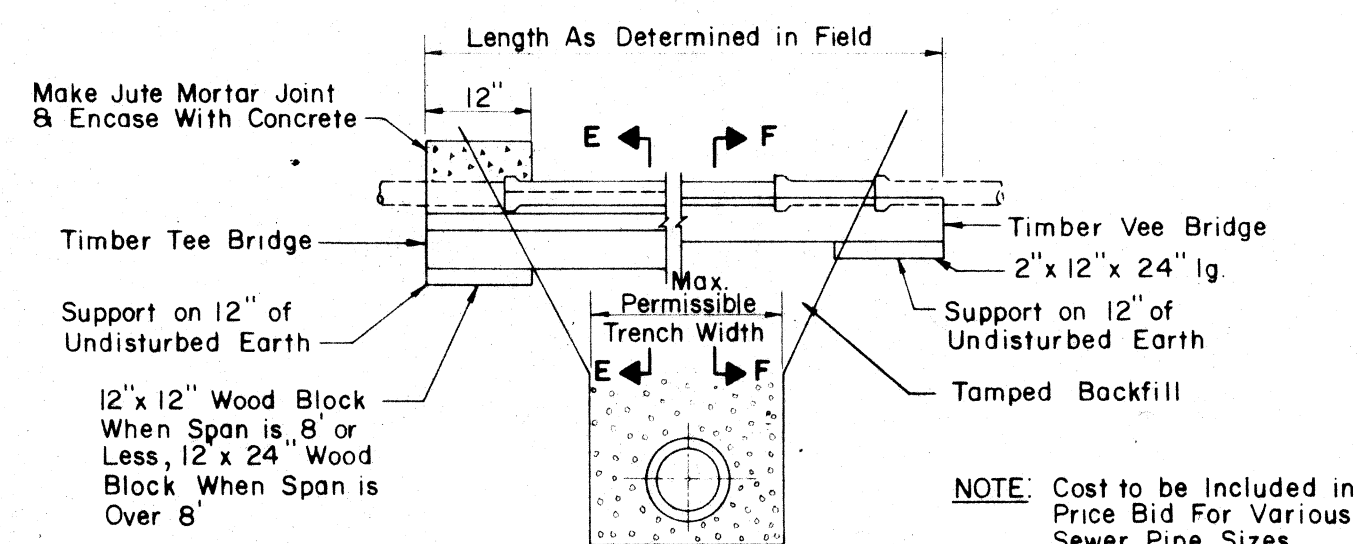

**RESTORE EXIST SEWER
PIPE LINES**
NO SCALE

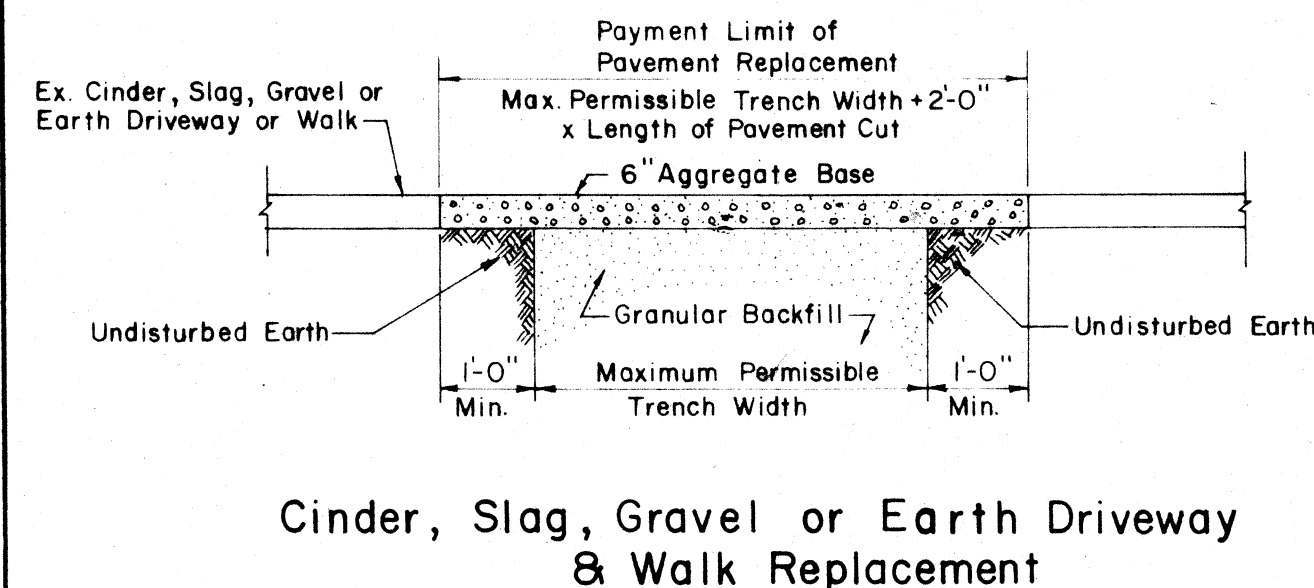


Cinder, Slag, Gravel or Earth Driveway & Walk Replacement

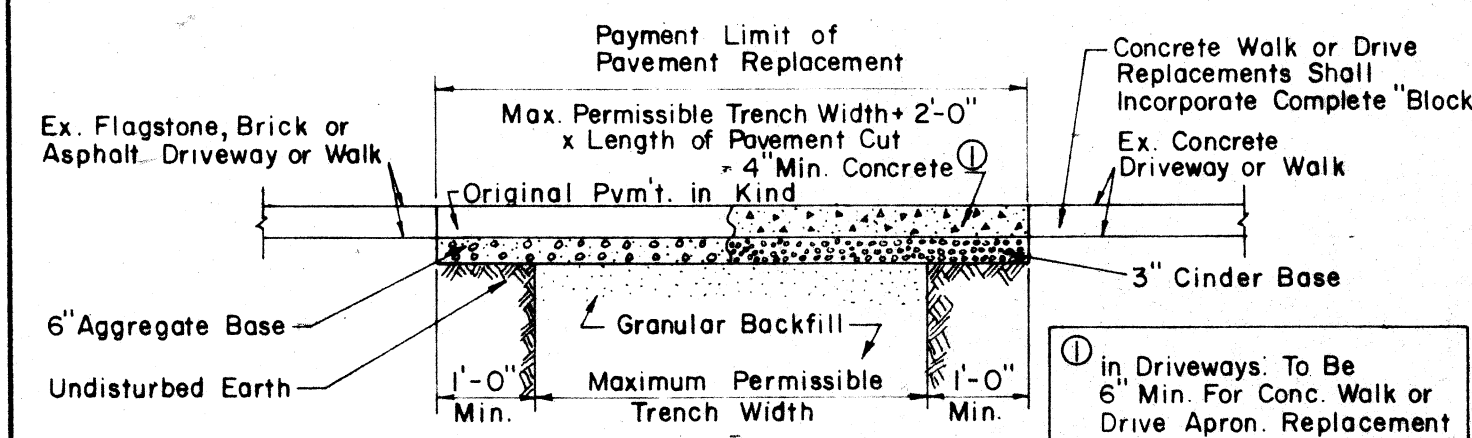


Brick, Flagstone, Asphalt, or Concrete Driveway & Walk Replacement

TYPICAL REPAIR OF PAVEMENT OPENING
NO SCALE

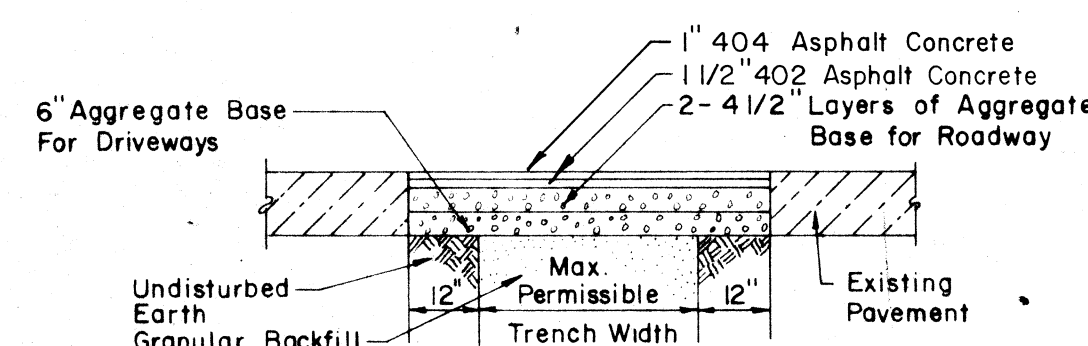


Asphalt Concrete Surface Course
Aggregate Base Course

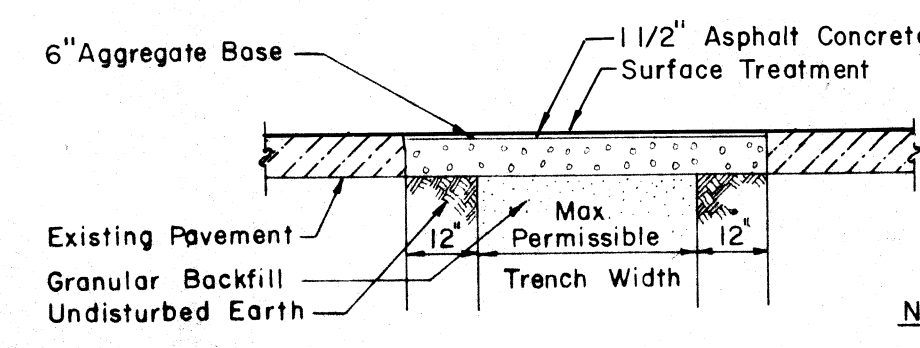


Aggregate Base
With Seal Coat Surface Treatment

**TYPICAL PAVEMENT
REPLACEMENT SECTIONS**
NO SCALE

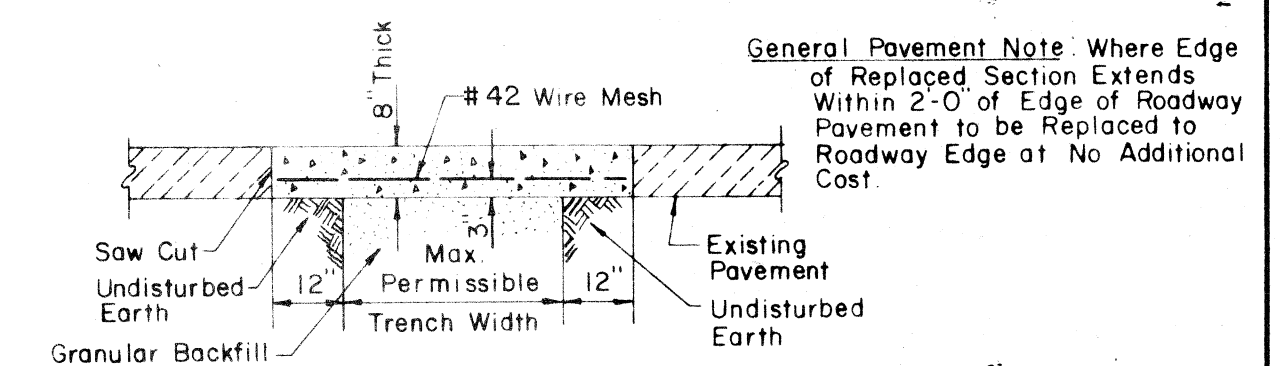

Portland Cement Concrete Base Or Surface

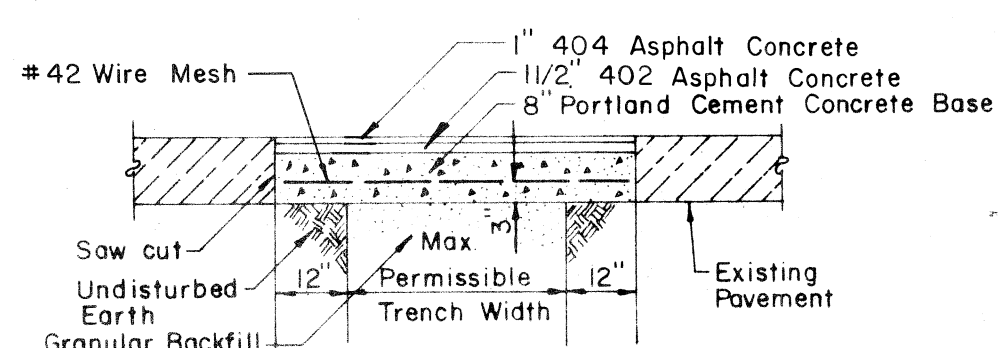

Asphalt Concrete Surface Course
Portland Cement Concrete Base Course

**TYPICAL PAVEMENT
REPLACEMENT SECTIONS**
NO SCALE

