


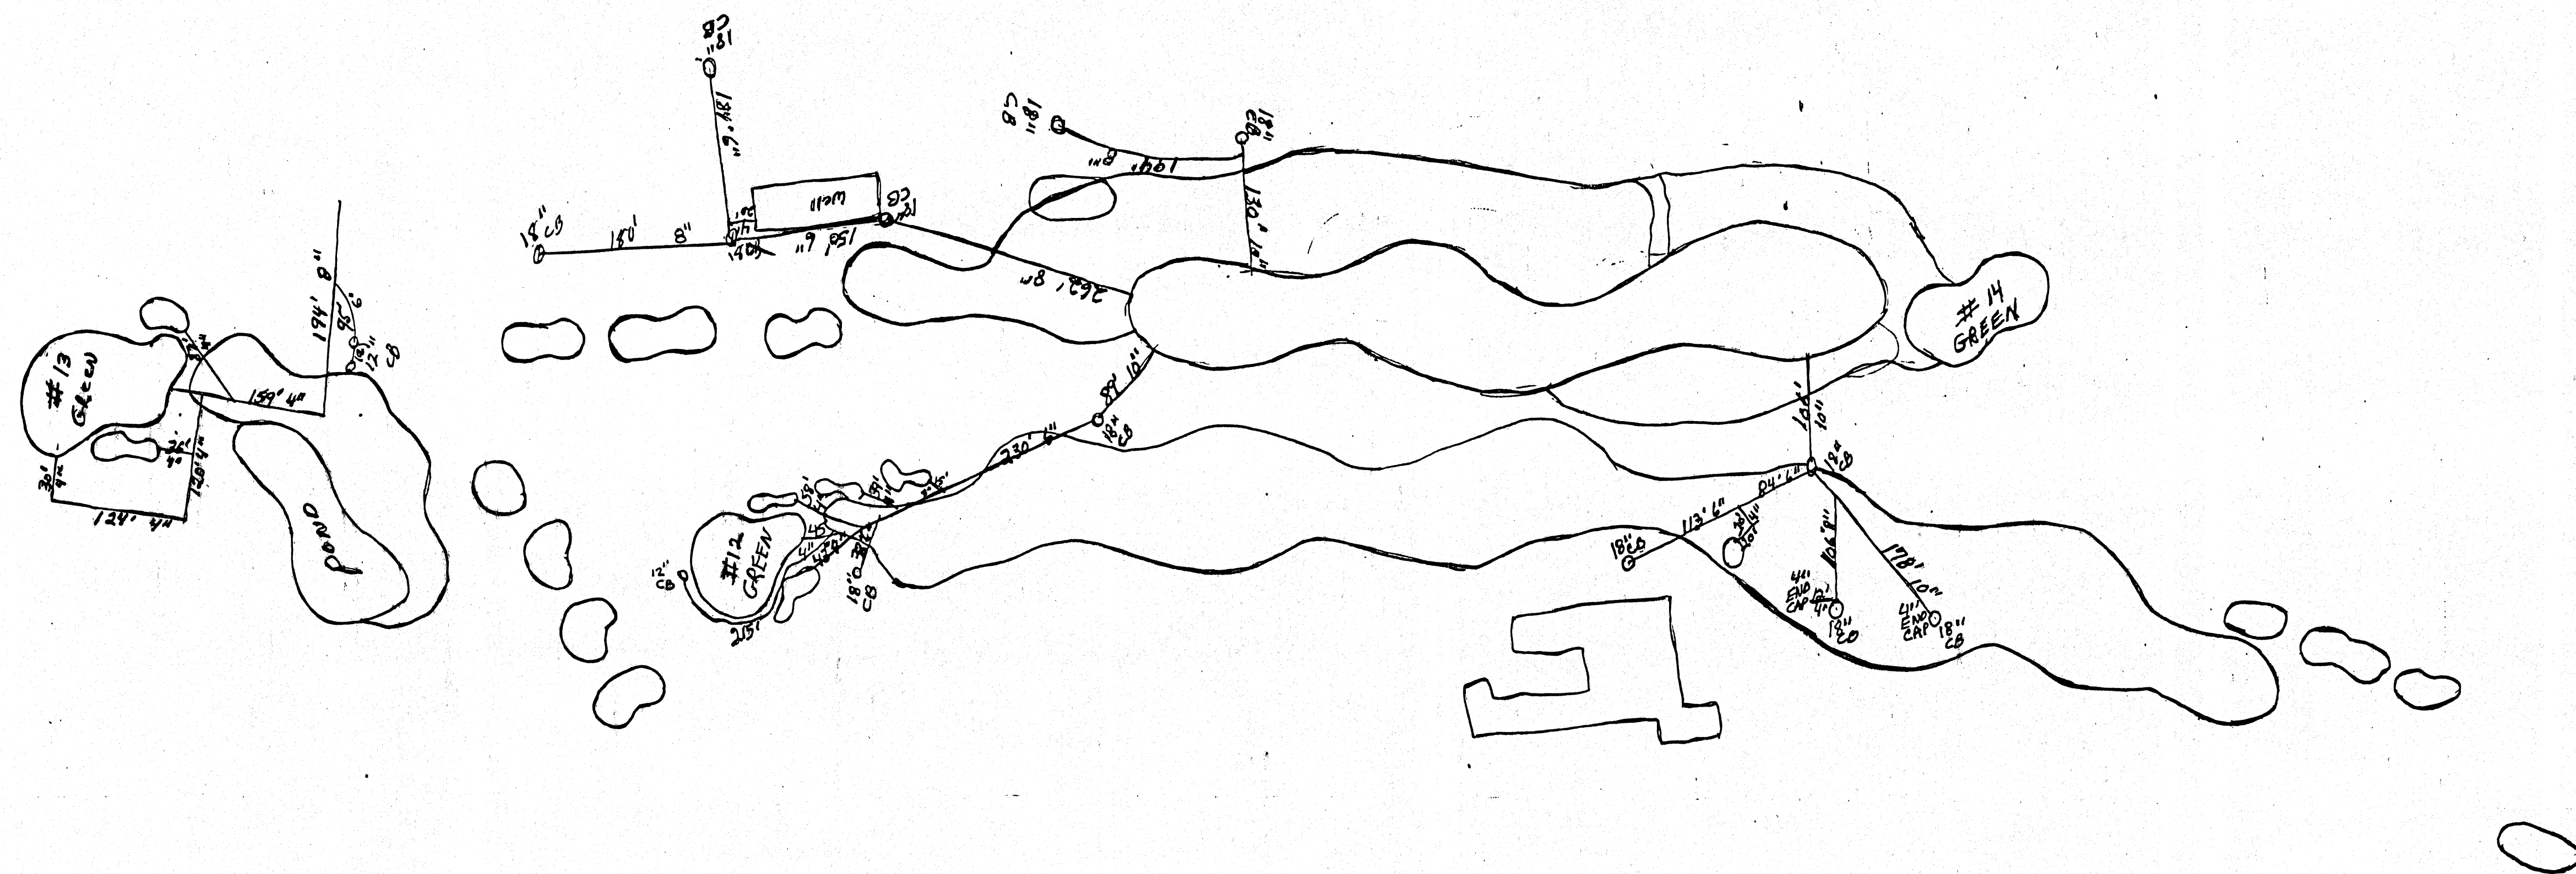

DRAINAGE SYSTEM AS-BUILTS
HOLES : 12, 13 & 14

1-24-01