


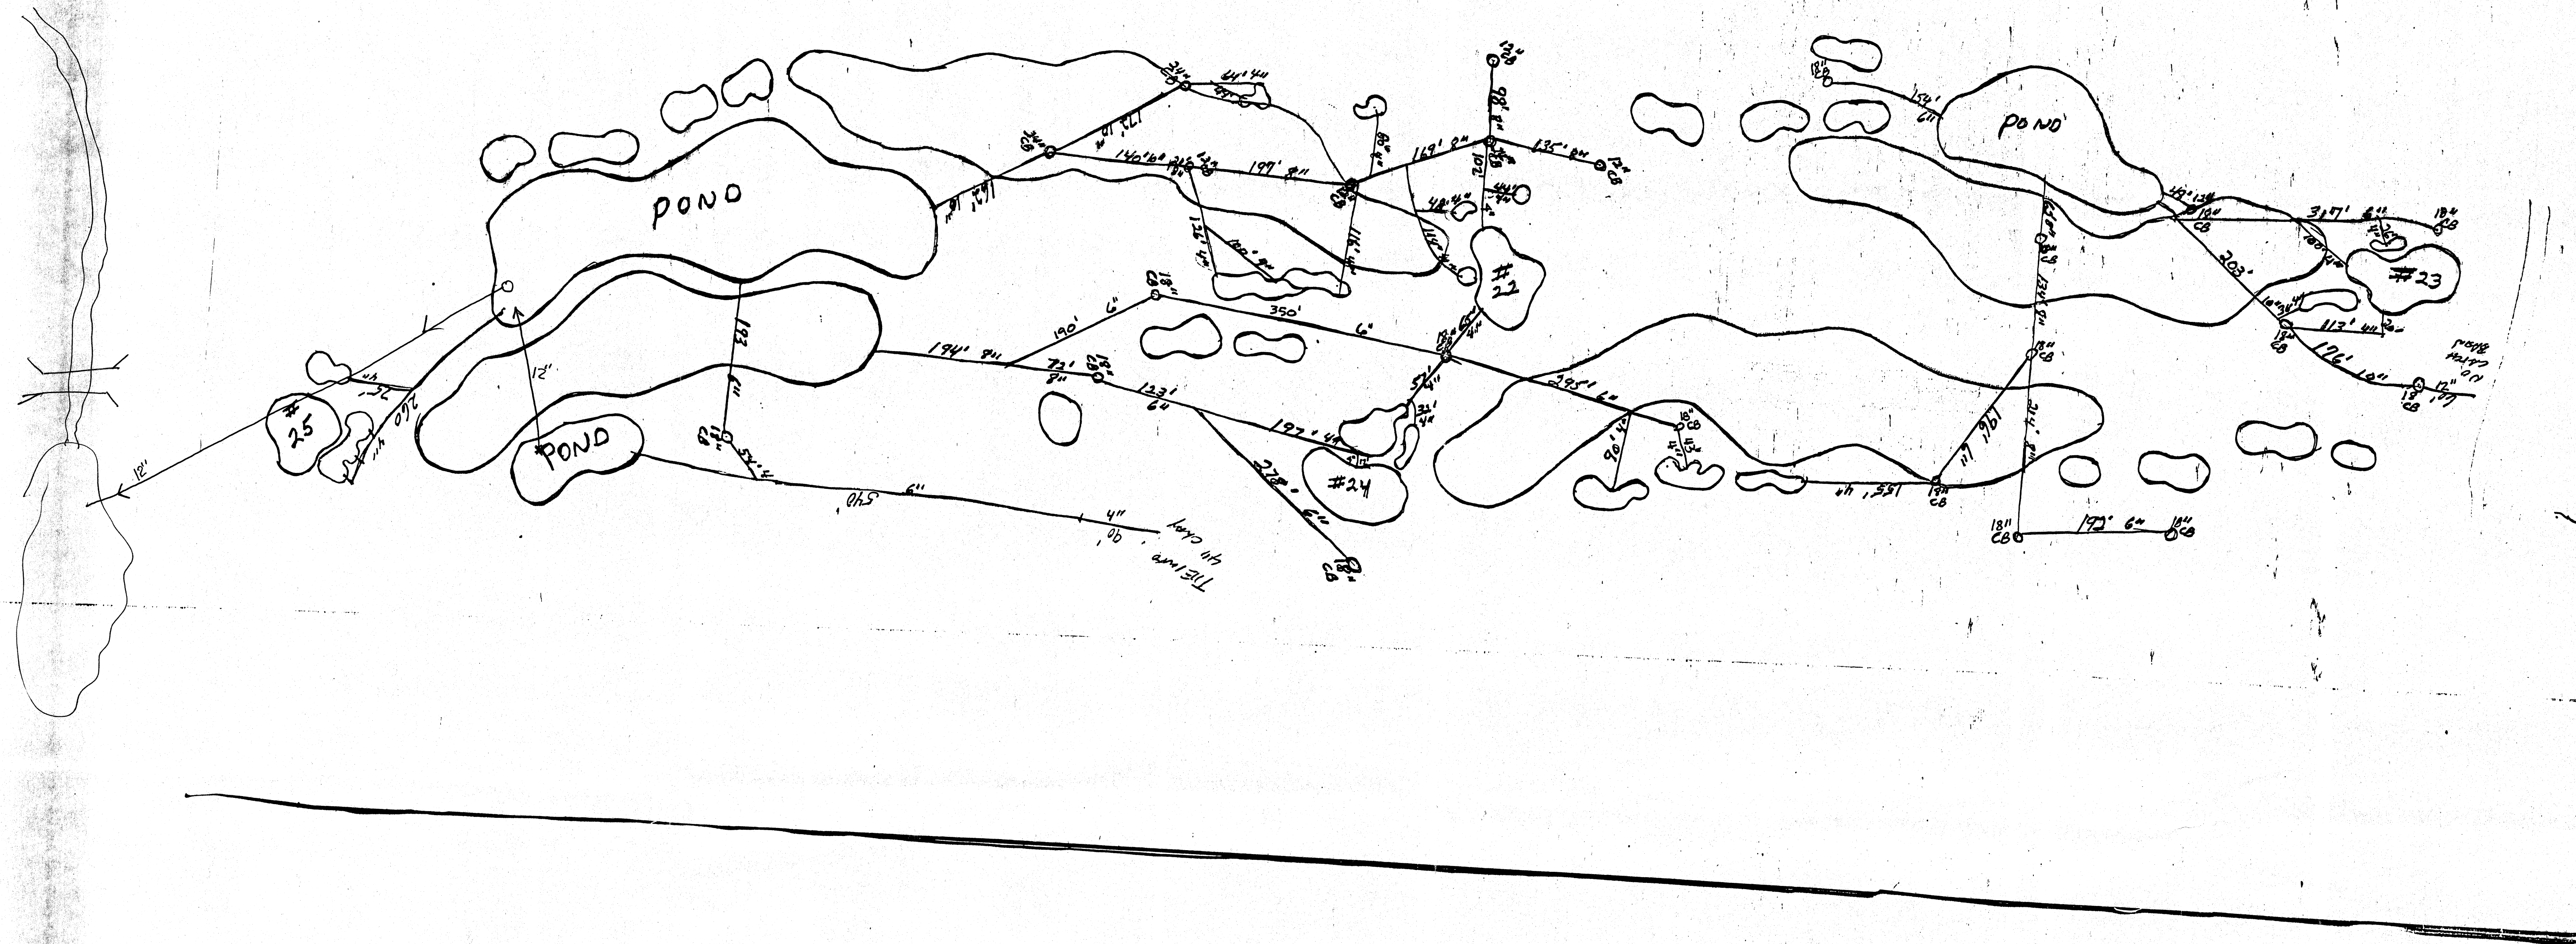

DRAINAGE SYSTEM AS-BUILTS
HOLES = 22, 23, 24 & 25

1-24-01