


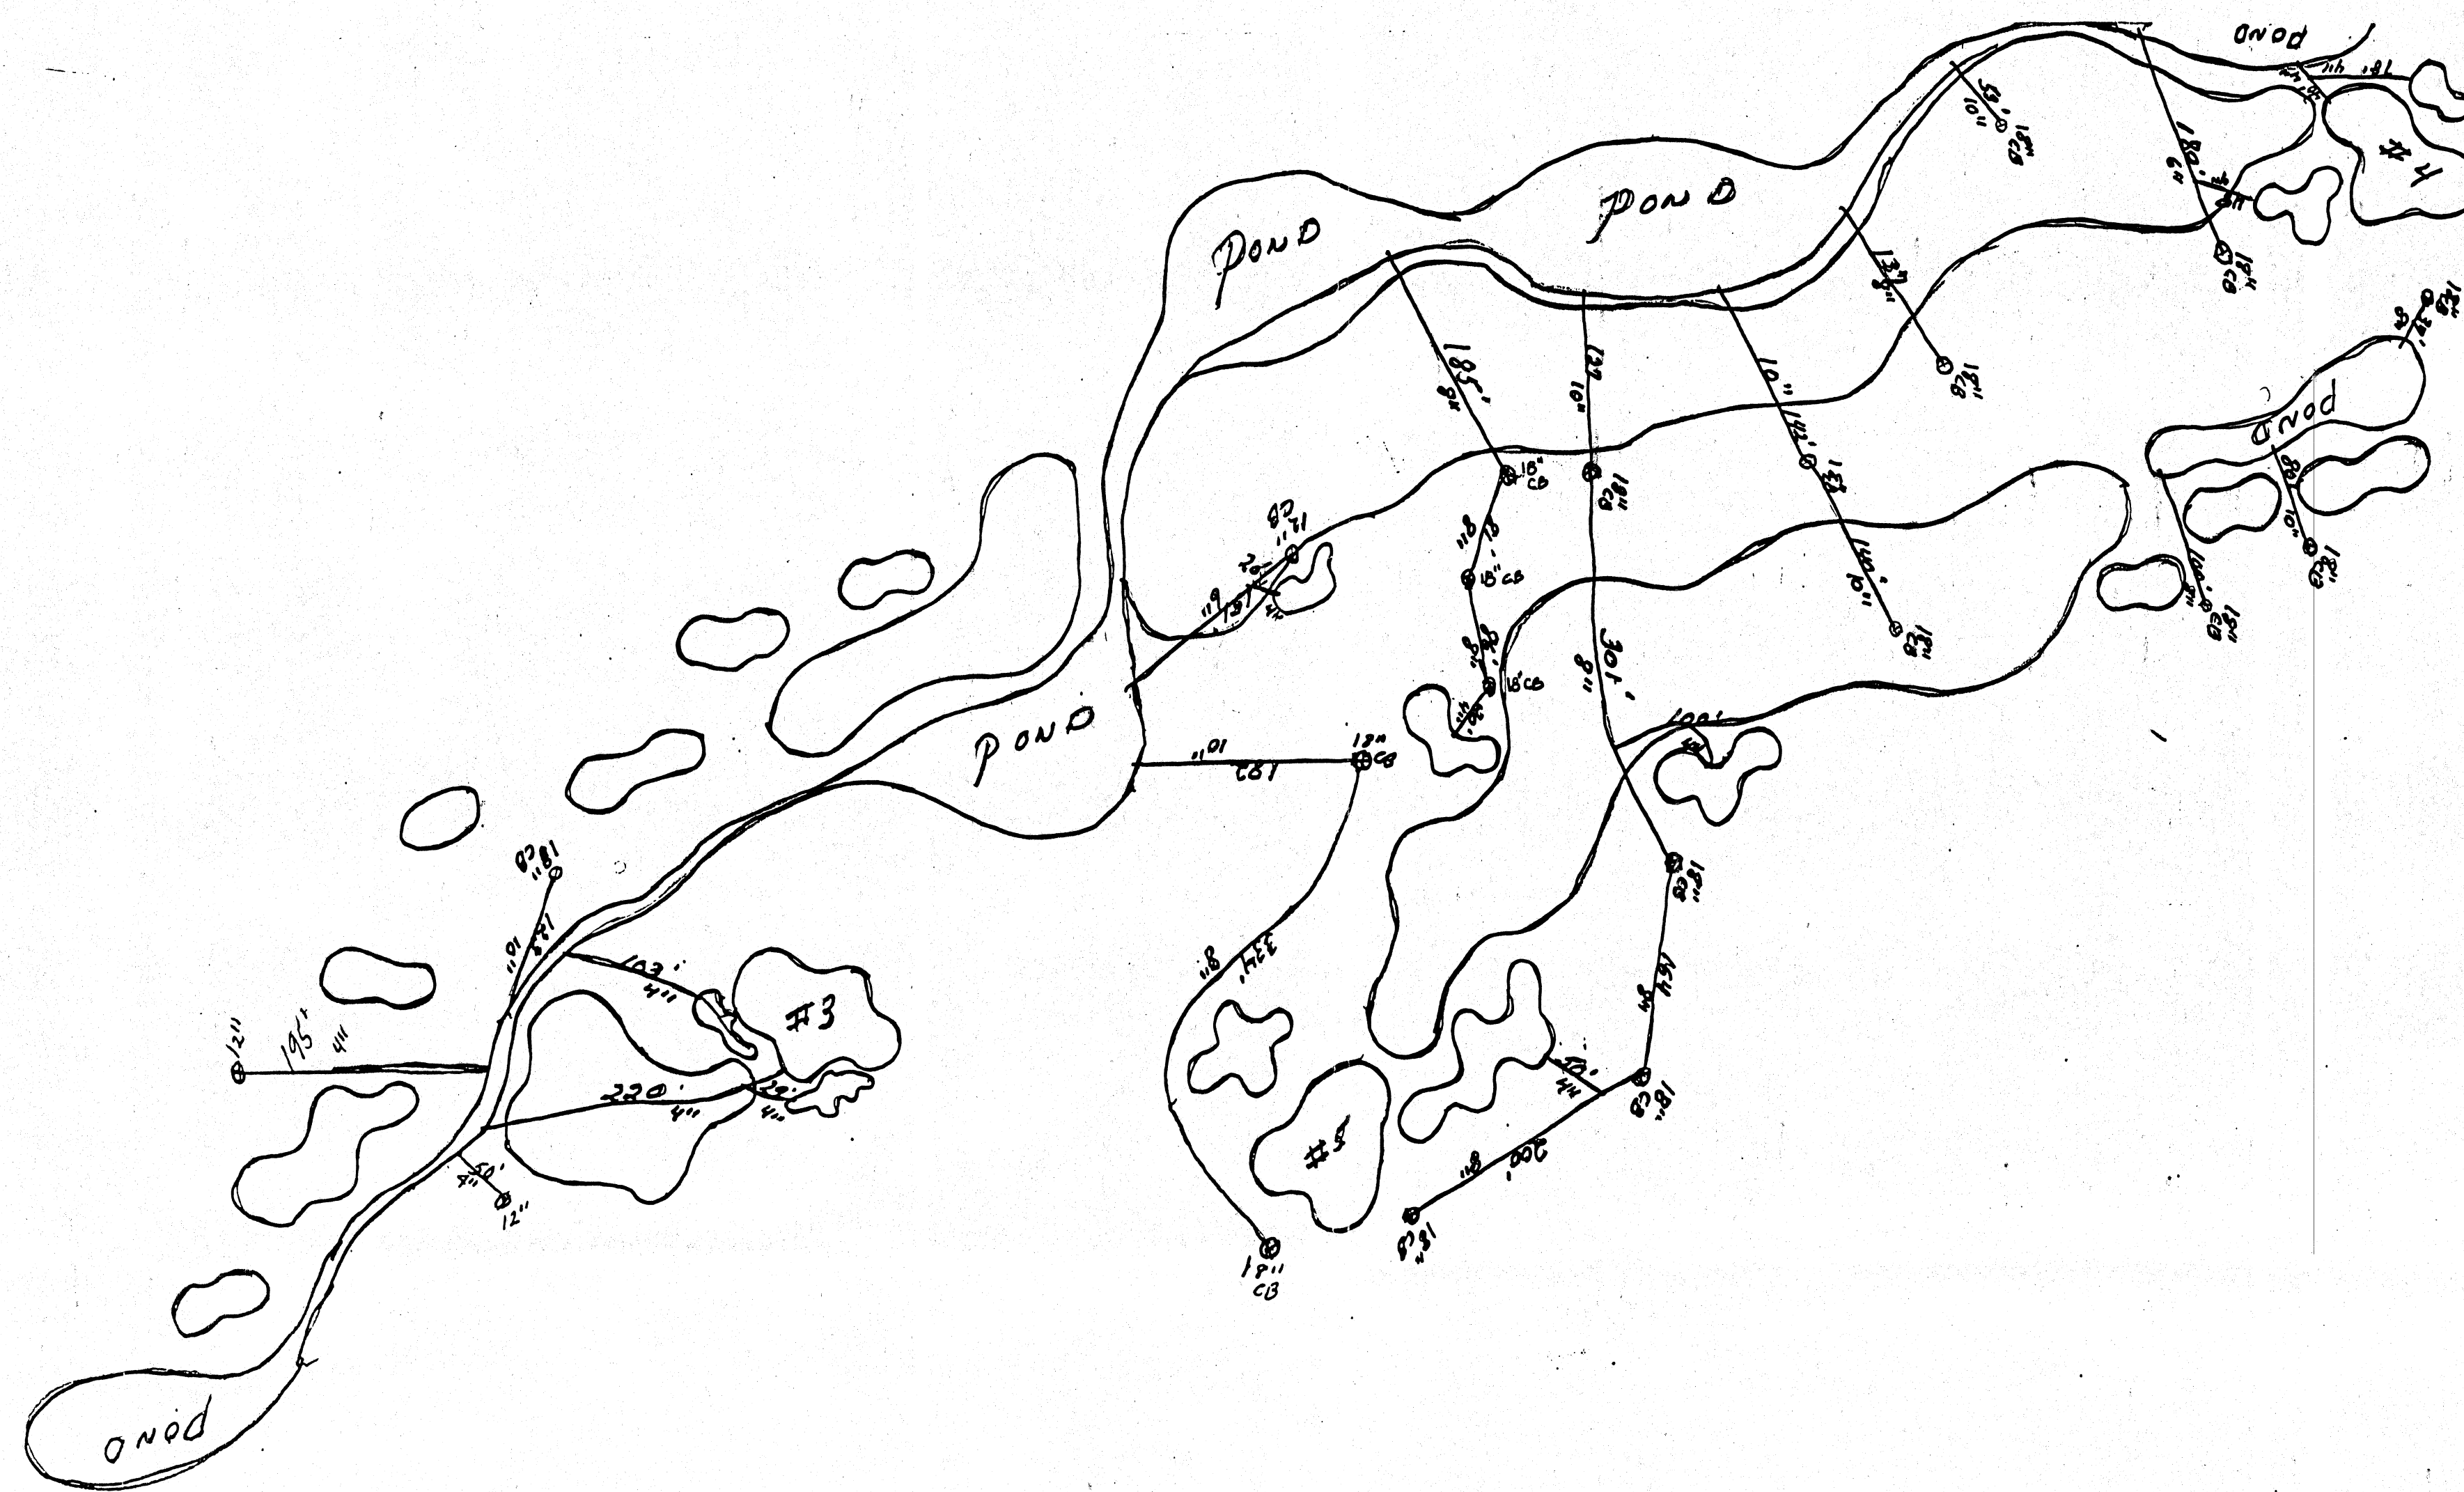

DRAINAGE SYSTEM AS-BUILTS
HOLES : 3, 4 & 5

1-24-01