

Nº 10076

FOLLOWING DATA TO BE ANSWERED BY INSPECTOR
AND SIGNED WHEN RETURNED

DATE INSPECTED 3-12-91

IF SO HOW AND LOCATION FROM
FIRST MANHOLE DOWN STREAM

HOUSE NO. 628

DISTANCE FROM FIRST MANHOLE
DOWN STREAM TO DITCH AT
CURB LINE AND DEPTH

SIZE OF PIPE USED 6"


70'

WAS LATERAL AT CURB? yes

WAS ATTACHED TO MAIN yes

NAME OF CONTRACTOR Louisville Excavating

SHOW BY DIAGRAM RELATION OF LATERAL TO WALL OF BUILDING SERVED.

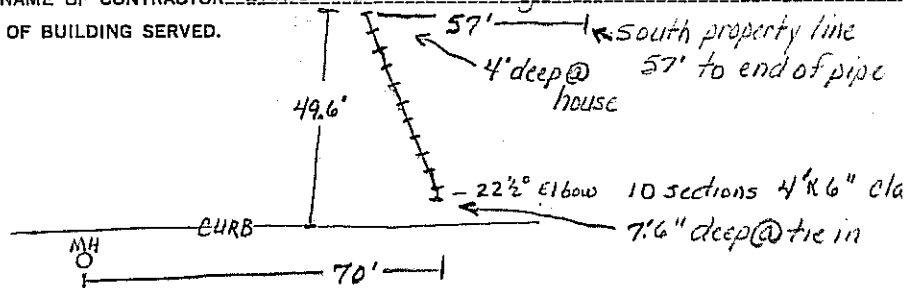

SIGNED

Douglas L. McLean
Inspector for City

FILED AT ENGINEER'S OFFICE

REMARKS

No foundation when pipe was laid

Tap

Nº 10076

OFFICE OF THE DIRECTOR OF PUBLIC SEWERS
PERMIT TO TAP SEWER

MASSILLON, OHIO,

3-11

RECEIVED OF

FIFTY DOLLARS

FEE OF \$

50

FOR WHICH PERMISSION IS GRANTED

LOUISVILLE EXCA

TO TAP

SANITARY

SEWER ON THE

RIGHT

OF

28 TH

AVE.
ST.

TYPE OF STREET

CHIP & SEAL

THE PREMISES BEING LOT NO.

14319

HOUSE NO.

628

WORK TO BE DONE IN ACCORDANCE WITH ORDINANCE NO. 19-1971 DULY PASSED BY THE CITY COUNCIL, AND
OF THE DEPARTMENT OF PUBLIC SERVICE.

NAME OF CONTRACTOR

LOUISVILLE EXCA.

**Note: This permit covers work outside of building only. Any work
walls of building is subject to Massillon Board of Health Regulations.**