

N^o 10261

FOLLOWING DATA TO BE ANSWERED BY INSPECTOR
AND SIGNED WHEN RETURNED

DATE INSPECTED 2-4-93

IF SO HOW AND LOCATION FROM
FIRST MANHOLE DOWN STREAM

48'

HOUSE NO. 2380

SIZE OF PIPE USED 6"


DISTANCE FROM FIRST MANHOLE
DOWN STREAM TO DITCH AT
CURB LINE AND DEPTH

WAS LATERAL AT CURB? YES


WAS ATTACHED TO MAIN YES

NAME OF CONTRACTOR Superior Paving

SHOW BY DIAGRAM RELATION OF LATERAL TO WALL OF BUILDING SERVED.

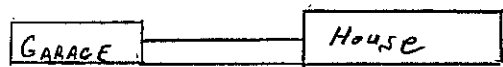

SIGNED Bill Pappas
Inspector for City

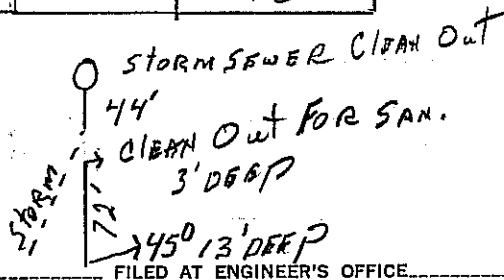

FILED AT ENGINEER'S OFFICE

REMARKS At 44' North of Storm Sewer Clean Out A Clean Out Was Installed For SA
Storm & SAN SEWER ARE "NOT CONNECTED TOGETHER"

Nº 10261

Tap

OFFICE OF THE DIRECTOR OF PUBLIC SE
PERMIT TO TAP SEWER

MASSILLON, OHIO, *Jan 28*

RECEIVED OF

Superior Paving & Motels

FEE OF \$ *5*

FOR WHICH PERMISSION IS GRANTED

Same

TO TAP

San

SEWER ON THE

North

OF

Amberwood Ct NE

AVE.

ST. TYPE OF STREET

THE PREMISES BEING LOT NO.

14735

, HOUSE NO.

2380

WORK TO BE DONE IN ACCORDANCE WITH ORDINANCE NO. 19-1971 DULY PASSED BY THE CITY COUNCIL, AND
OF THE DEPARTMENT OF PUBLIC SERVICE.

NAME OF CONTRACTOR

Superior

Marlene K Oster
1 unit

**Note: This permit covers work outside of building only. Any work
walls of building is subject to Massillon Board of Health Regulations.**