

FOLLOWING DATA TO BE ANSWERED BY INSPECTOR
AND SIGNED WHEN RETURNED

Nº 2104

Date Inspected April 14 - 1926

If so how and location from
first manhole down stream

House No. Lot 2889

Distance from first manhole
down stream to ditch at
curb line and depth

Size of pipe used 6"


Was lateral at curb?

Was attached to main yes

Name of Contractor

Show by diagram relation of lateral to wall of building served.

Geo Brunner

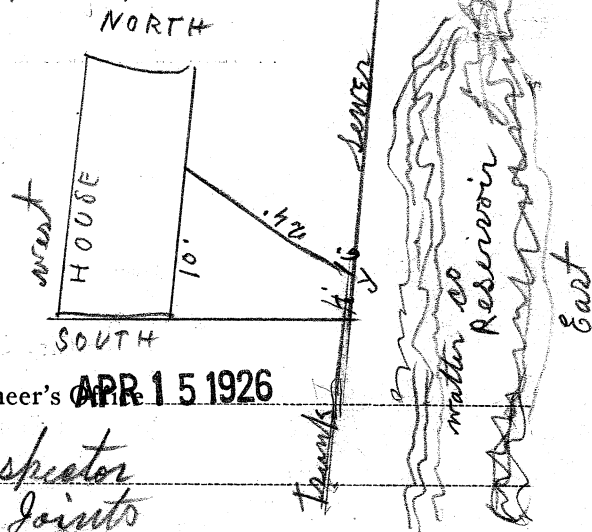

Signed

Clark Elson

Inspector for City

Filed at Engineer's

APR 15 1926

Remarks

This job was partly done without Inspector
This Pipe was laid with Tar filler joints

OFFICE OF THE DIRECTOR OF PUBLIC SERVICE

Nº 2104

PERMIT TO TAP SEWER

Massillon, O., March 8th 1926

Received of James Brunken fee of \$ 2.00

for which permission is granted A. J. Halap

to tap Sanitary sewer, on the west side

of Hill in the road Ave., the premises being Lot. No. 289 St.

House No. Work to be done in accordance with Ordinance No. 2323, duly passed

by the City Council, and Rules of the Department of Public Service.

Name of Contractor James Brunken