

FOLLOWING DATA TO BE ANSWERED BY INSPECTOR
AND SIGNED WHEN RETURNED

Nº 2105

Date Inspected April 19 - 1926

If so how and location from
first manhole down stream

House No. _____

Distance from first manhole
down stream to ditch at
curb line and depth _____

Size of pipe used 6"


Was lateral at curb? NO

Was attached to main NO

Name of Contractor

Joe Brunner

Show by diagram relation of lateral to wall of building served.

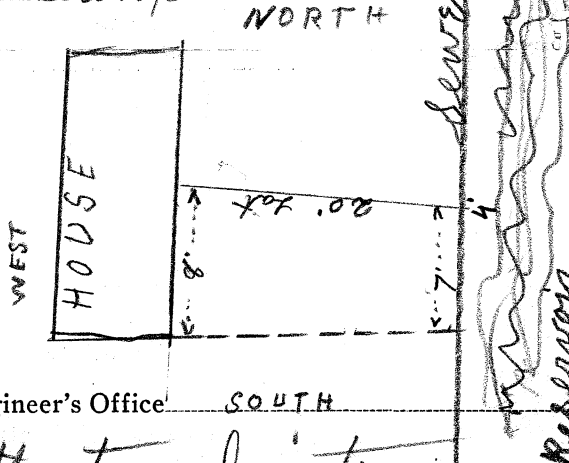

Signed Clark Elser
Inspector for City

Filed at Engineer's Office

Remarks This Pipe was Laid with Tar Joints

APR 19 1926

OFFICE OF THE DIRECTOR OF PUBLIC SERVICE

Nº 2105

PERMIT TO TAP SEWER

Massillon, O., June 25th 1926

Received of James Buchanan fee of \$ 1.00

for which permission is granted C. J. Guly

to tap Sanitary sewer, on the east side

of William St. Ave., the premises being Lot. No. 1794
St.

House No. Work to be done in accordance with Ordinance No. 2323, duly passed
by the City Council, and Rules of the Department of Public Service.

Name of Contractor W. A. Smith

4/19/26

8:00