

**FOLLOWING DATA TO BE ANSWERED BY INSPECTOR
AND SIGNED WHEN RETURNED**

Nº 2695

Date Inspected Aug. 11 1927

If so how and location from first manhole down stream

House No. 7215

Distance from first manhole down stream to ditch at

Size of pipe used 6"


curb line and depth

Was lateral at curb?

Was attached to main

Name of Contractor

Show by diagram relation of lateral to wall of building served.

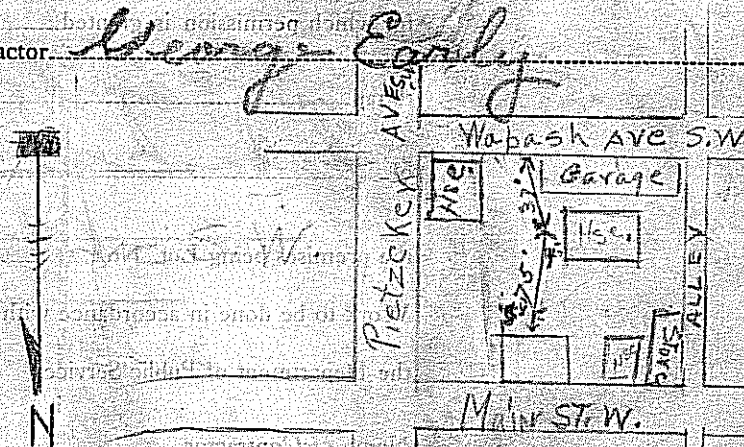

Signed

Harold Lahr.
Inspector for City

Filed at Engineer's Office

AUG 12 1927

Remarks

Old pipe was laid 37" from edge of pavement
and 7' deep.

OFFICE OF THE DIRECTOR OF PUBLIC SERVICE

Nº 2695

PERMIT TO TAP SEWER

1:00
o'clock.

Massillon, O., Aug 11 1922

Received of Geo. E. Smith fee of \$ 2.00

for which permission is granted Mrs. Clara Lomady

to tap Main St. sewer, on the 10th month

of Walnut St. Ave., Type of Street: paved St.

the premises being Lot. No. 205 House No. 725 1/2

Work to be done in accordance with Ordinance No. 2323, duly passed by the City Council, and Rule No. 1 of the Department of Public Service.

Name of Contractor Geo. E. Smith

NOTE. This permit covers work outside of building only. Any work inside walls of building is subject to Massillon Board of Health Regulations.