

**FOLLOWING DATA TO BE ANSWERED BY INSPECTOR
AND SIGNED WHEN RETURNED**

No. 3735

Date Inspected 7-31-35

I so how and location from
first manhole down stream

House No. 119

Distance from first manhole
down stream to ditch at
curb line and depth

Size of pipe used 6" PRESS
TILE

37' FROM M.H. 2' 6" DEEP
NORTH


Was lateral at curb? YES

Name of Contractor

Was attached to main Lot 23

Show by diagram relation of lateral to wall of building served.

14' FROM CURB TO 6' X 6' YEL Leading
around house to stack.

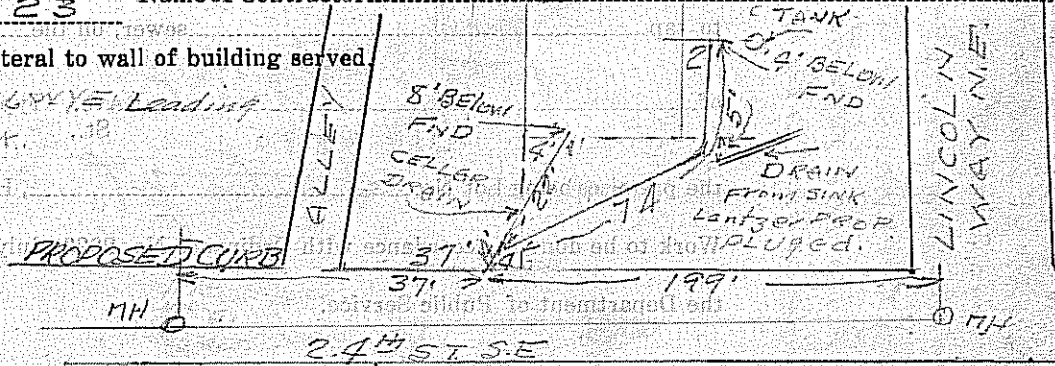

Signed Shertee

Filed at Engineer's Office

Inspector for City

Remarks:

AUG 1 1935

The old sewer to this lot was taking care of two houses by whom it was laid is not known but whoever it was had the pipe 1 foot lower in the rear than it was close to the out let. The pipe was laid over gas line (McQuinn for witness.) They having no permit tried to sneak it in the tenants had trouble until new line was put in.

No. 3735

OFFICE OF THE DIRECTOR OF PUBLIC SERVICE

PERMIT TO TAP SEWER

Massillon, O.,

6-27

19

Received of

Samuel L. H. Smith

fee of \$

2.00

for which permission is granted

Samuel L. H. Smith

to tap

Sam

sewer, on the

W. St.

of

29th St SE

Ave., Type of Street

Leif

St.,

the premises being Lot No.

064580

House No.

119

Work to be done in accordance with Ordinance No. 2323, duly passed by the City Council, and by the Department of Public Service.

Name of Contractor

Samuel

NOTE. This permit covers work outside of building only. Any work inside walls of building is subject to Massillon Board of Health Regulations.