

4 hrs -

**FOLLOWING DATA TO BE ANSWERED BY INSPECTOR  
AND SIGNED WHEN RETURNED**

**No. 3741**

Date Inspected 8-1-35

House No. 1510

Size of pipe used 4"

Was lateral at curb? YES

Was attached to main

I so how and location from  
first manhole down stream

Distance from first manhole  
down stream to ditch at  
curb line and depth


Name of Contractor

Show by diagram relation of lateral to wall of building served.

OLD line was laid up and down and an  
old war also pipe was full of roots, was  
replaced by new pipe and laid with  
press tie joints. There is a cross  
on retaining wall of prop line where sewer  
comes out under walk it was  
not dug up at curb. Had a fire hose  
in line at prop line and water running  
in same about 5 minutes. Line was  
clear.

old line about 12' from the h  
they ran sewer over water pipe  
causing a humping line. New line  
goes under pipe with float at 5'

61.5 FT. From SOUTH CURB Pearl T

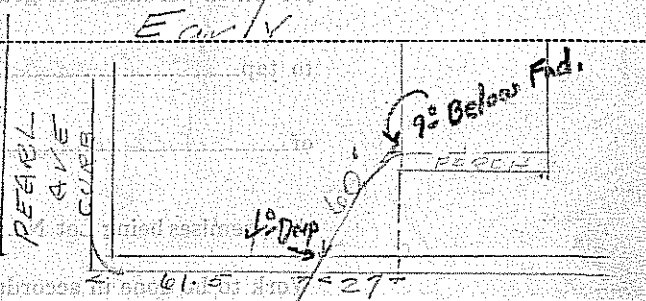

Signed

*clear*

Inspector for City

Filed at Engineer's Office

Remarks:

*Therger*

**AUG 1 1935**

*OK*

# OFFICE OF THE DIRECTOR OF PUBLIC SERVICE

No 3741

## PERMIT TO TAP SEWER

Massillon, O. Aug 1<sup>st</sup> 19

Received of Perkins Bldg and Loan fee of \$ 2

for which permission is granted Geo Early

to tap Sanitary sewer, on the East

of Eric St. Ave., Type of Street Caved  
St.,

the premises being Lot No. 3843, House No. 1510

Work to be done in accordance with Ordinance No. 2828, duly passed by the City Council, and by the Department of Public Service.

Name of Contractor Geo Early

**NOTE.** This permit covers work outside of building only. Any work inside walls of building is subject to Massillon Board of Health Regulations.