



CITY OF MASSILLON, OHIO

151 LINCOLN WAY EAST
MUNICIPAL GOVERNMENT ANNEX
CITY ADMINISTRATION BUILDING
MASSILLON, OHIO 44646
PHONE 330-830-1722 FAX 330-830-1786

PERMIT DATE:

12/13/2007

PERMIT NO.

3902

PERMIT TO TAP SANITARY SEWER

This permit is issued subject to the latest Codified Ordinances of the City of Massillon, OH. The City Engineer to be notified 24 hours in advance of start of work (330) 830-1722. All permits issued under this ordinance are void after 120 days from date of issuance.

RECEIVED OF:

PERMIT TYPE:



NEW



REPAIR



CUTOFF

CONTRACTOR INFORMATION

CONTRACTOR: HOLDERBAUM SEWER

CONTACT: GARY

ADDRESS:

CITY:

STATE:

ZIP:

PHONE: (330) 936-2201

FAX:

SURETY:

SITE INFORMATION

OWNER'S NAME: NRP HOMES

STREET NUMBER: 767

STREET NAME: ERIE ST SO

CITY LOT NUMBER: 9933

PURPOSE OF CUT: TAP SANITARY

ZONING CLASS: R-1

STREET SIDE: WEST

PHONE OTHER:

NOTE: This permit covers work outside of the building ONLY. Any work inside walls of the building is subject to the Massillon Board of Health Regulations.

SANITARY SEWER CONNECTION:

USAGE: ☒ RESIDENTIAL ☐ COMMERCIAL ☐ INDUSTRIAL

DATE INSPECTED: ~~WEST~~ 12/19/07

located on the West side of

Erie St S between

Maple Ave SE and

Curky CT SE

Direction from downstream Manhole:

Distance from downstream Manhole:

Connection Length: 116' 0.00 (FEET)

Connection Depth: 11' 0 (FEET)

Size of Sewer Pipe: 6" (INCHES) 24"

Pipe Material: PVC


INSPECTORS NAME: Jeff King

COMMENTS: RUNNING DOWN SIDEWALK TO TIE INTO TRUNK SEWER

SKETCH:

DRAWING #:

#3902

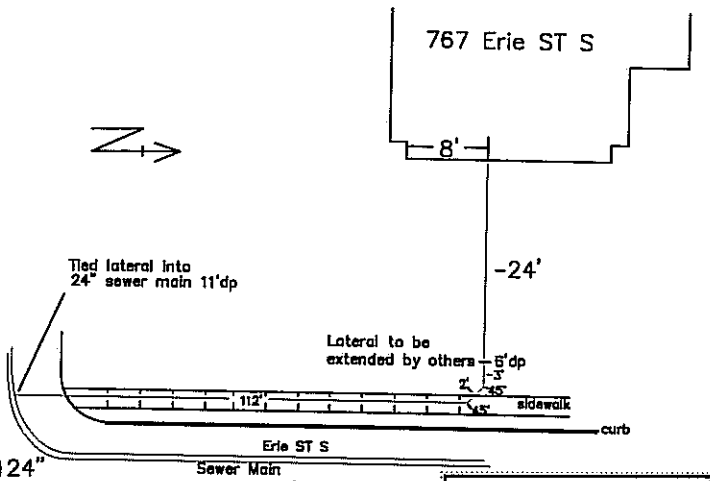

INSPECTION REQUEST:

SANITARY SEWER PERMIT FEE: \$100.00

TOTAL COST: \$100.00

TWO WORKING DAYS BEFORE YOU DIG

Ohio Utilities Protection Service

Call 1-800-362-2764 Toll Free....

Non-Members must be called directly.

AUTHORIZED BY: DIRECTOR OF PUBLIC SAFETY AND SERVICE


ISSUED BY: JASON HAINES

LEGEND


- EX SAN MANHOLE
- EX STORM MANHOLE
- EX COMB MANHOLE
- EX CATCH BASIN
- EX CLEANOUT
- EX HYDRANT
- EX WATER LINE VALVE
- EX WATER SERVICE VALVE
- EX WATER MANHOLE
- EX WATER METER
- PROPOSED INLET PROT
- S/F SILT FENCE
- UTILITY POLE
- UTILITY POLE w/TRANS.
- LIGHT POLE
- GUY ANCHOR
- CHAIN LINK FENCE
- WOOD FENCE
- GAS VALVE
- ELECTRIC GROUND TRANS.
- DECIDUOUS TREE
- CONIFEROUS TREE
- DENOTES 5/8" IRON PIN SET WITH "M NEFF 7315" CAP (UNLESS OTHERWISE NOTED)

TEMPORARY BENCHMARK
NAIL IN POLE 223E20
@ 768 EASR STREET SE
ELEV. - 998.40

PROP ELEV
(EX ELEV)
* 000.00
EX ELEV

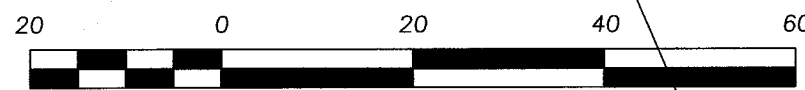

SCALE: 1" = 20'

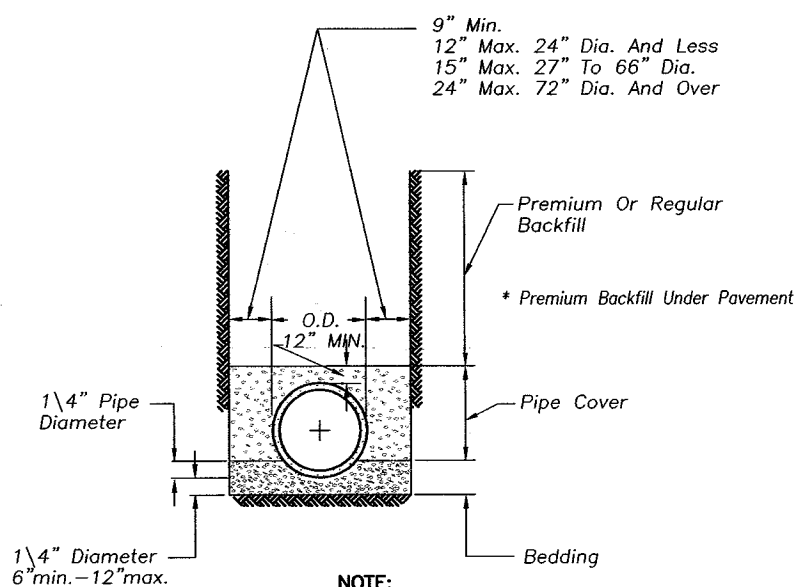

Premium Backfill shall consist of coarse interlocking aggregate no. 6, 67, 68, 7, 78, 8 or limestone screenings.

Pipe Cover shall consist of coarse interlocking aggregate no. 6, 67, 68, 7, 78, 8 or 8.

Bedding shall consist of coarse interlocking aggregate no. 6, 67, 68, 7, 78, 8 or 8 for 60" or smaller diameter pipe, for 66" or larger diameter pipe no. 4 aggregate may also be used.

TYPICAL TRENCH DETAIL

GENERAL NOTES:

1. SIDEWALK AND CURB REPLACEMENT AREAS ARE TO BE EVALUATED ON-SITE WITH CONCRETE CONTRACTOR AND CITY OF MASSILLON ENGINEERING DEPARTMENT PRIOR TO START OF WORK. CONTACT ENGINEERING DEPARTMENT AT 330-830-1722 FOR LICENSE AND PERMIT REQUIREMENTS.
2. STREET OPENING PERMITS REQUIRED FOR ALL WORK IN CITY RIGHT-OF-WAYS. CONTACT ENGINEERING DEPARTMENT AT 330-830-1722 FOR LICENSE AND PERMIT REQUIREMENTS.
3. ALL STORM SEWER LATERAL CONNECTIONS ARE TO BE NEATLY CORE DRILLED INTO EXISTING PIPES, CATCH BASINS, OR CURBS.

2 WORKING DAYS
BEFORE YOU DIG

CALL TOLL FREE 1-800-362-2764

OWN UTILITIES PROTECTION SERVICE

UTILITY STATEMENT

THE UNDERGROUND UTILITIES SHOWN HAVE BEEN LOCATED FROM FIELD SURVEY INFORMATION AND EXISTING DRAWINGS. THE SURVEYOR MAKES NO GUARANTEE THAT THE UNDERGROUND UTILITIES SHOWN COMPRISE ALL SUCH UTILITIES IN THE AREA, EITHER IN SERVICE OR ABANDONED. THE SURVEYOR FURTHER DOES NOT WARRANT THAT THE UNDERGROUND UTILITIES SHOWN ARE IN EXACT LOCATION INDICATED ALTHOUGH HE DOES CERTIFY THAT THEY ARE LOCATED AS ACCURATELY AS POSSIBLE FROM INFORMATION AVAILABLE. THE SURVEYOR HAS NOT PHYSICALLY LOCATED THE UNDERGROUND UTILITIES.

CONSTRUCTION NOTES:

- 1) ALL WORK SHALL CONFORM TO O.B.B.C. AND CITY OF MASSILLON REGULATIONS.
- 2) ALL BACKFILL FOR PAVEMENT, DRIVEWAYS AND DRAINAGE STRUCTURES TO BE PREMIUM BACKFILL.
- 3) ALL PAVEMENT AND SITE WORK SHALL CONFORM TO O.D.O.T. SPECIFICATIONS WHEREVER APPLICABLE.
- 4) NO SLAG PERMITTED ON SITE.
- 5) ALL UTILITY TRENCHES UNDER PAVEMENTS SHALL BE BACKFILLED WITH GRANULAR FILL.
- 6) PLACE FILL MATERIAL IN HORIZONTAL LAYERS NOT EXCEEDING 6" LOOSE DEPTH, AND THOROUGHLY COMPACT TO ADJACENT ORIGINAL GROUND.
- 7) REMOVE TREES, SHRUBS, GRASS AND OTHER VEGETATION IMPROVEMENTS, OR OBSTRUCTIONS INTERFERING WITH INSTALLATION OF NEW CONSTRUCTION. REMOVE SUCH ITEMS FROM OWNER'S PROPERTY AND DISPOSE OF OFF SITE IN A LEGAL MANNER. REMOVAL INCLUDES DIGGING OUT THE STUMPS AND ROOTS.
- 8) LOCATE EXISTING UNDERGROUND UTILITIES IN AREAS OF WORK. IF UTILITIES ARE TO REMAIN IN PLACE, PROVIDE ADEQUATE MEANS OF SUPPORT AND PROTECTION DURING EARTHWORK OPERATIONS. SHOULD UNCHARTED OR INCORRECTLY CHARTED PIPING OR OTHER UTILITIES BE ENCOUNTERED DURING EXCAVATION CONSULT UTILITY OWNER AND/OR OPERATOR OF THE FACILITIES. REPAIR DAMAGED UTILITIES TO SATISFACTION OF UTILITY OWNER.

SEWER NOTES:

- 1) CONTRACTOR WILL VERIFY DEPTH AND LOCATION OF EXISTING SANITARY CONNECTION AND REPORT FINDINGS TO ENGINEER PRIOR TO ANY CONSTRUCTION ON SITE.
- 2) CONTRACTOR SHALL BE RESPONSIBLE FOR ALL UTILITY TAP-IN FEES.
- 3) STORM AND SANITARY SEWER CONNECTIONS TO BE PVC ASTM 3034 SDR 35 @ 1.00 % MINIMUM SLOPE.

SURVEYOR CERTIFICATION

I, HEREBY STATE THIS MAP IS BASED ON AN ACTUAL FIELD SURVEY PREPARED BY ME. THE SURVEY IS CORRECT TO THE BEST OF MY KNOWLEDGE, INFORMATION AND BELIEF. PERMANENT MONUMENTS WERE FOUND OR SET AT ALL LOCATIONS SHOWN HEREON.

ALL DIMENSIONS GIVEN ARE EXPRESSED IN FEET AND DECIMAL PARTS THEREOF. BEARINGS ARE TO AN ASSUMED MERIDIAN AND ARE SHOWN TO INDICATE ANGLES ONLY.

MATTHEW C. NEFF
PROFESSIONAL SURVEYOR #7715

SPLASH BLOCK NOTE:

DOWN SPOUTS SHALL BE SPLASH BLOCKED AWAY FROM THE DWELLING. THE SUMP PUMP DISCHARGE LINE SHALL BE SPLASH BLOCKED AWAY FROM THE DWELLING.

SUMP PUMP NOTE:


A SUMP PUMP IS REQUIRED FOR THE FOUNDATION DRAINS. THE FOUNDATION DRAINS WILL FLOW INTO THE SUMP AND THE PUMP WITH DISCHARGE ONTO A SPLASH BLOCK.

EXISTING DRIVEWAY NOTE:

EXISTING DRIVE RELOCATION IS BEING COORDINATED WITH ADJOINING OWNER.

SIDEWALK NOTE:

EXISTING WALK IS TO BE REMOVED FOR NEW DRIVEWAYS AND THEN REPLACED TO THE NEAREST EXISTING JOINTS.

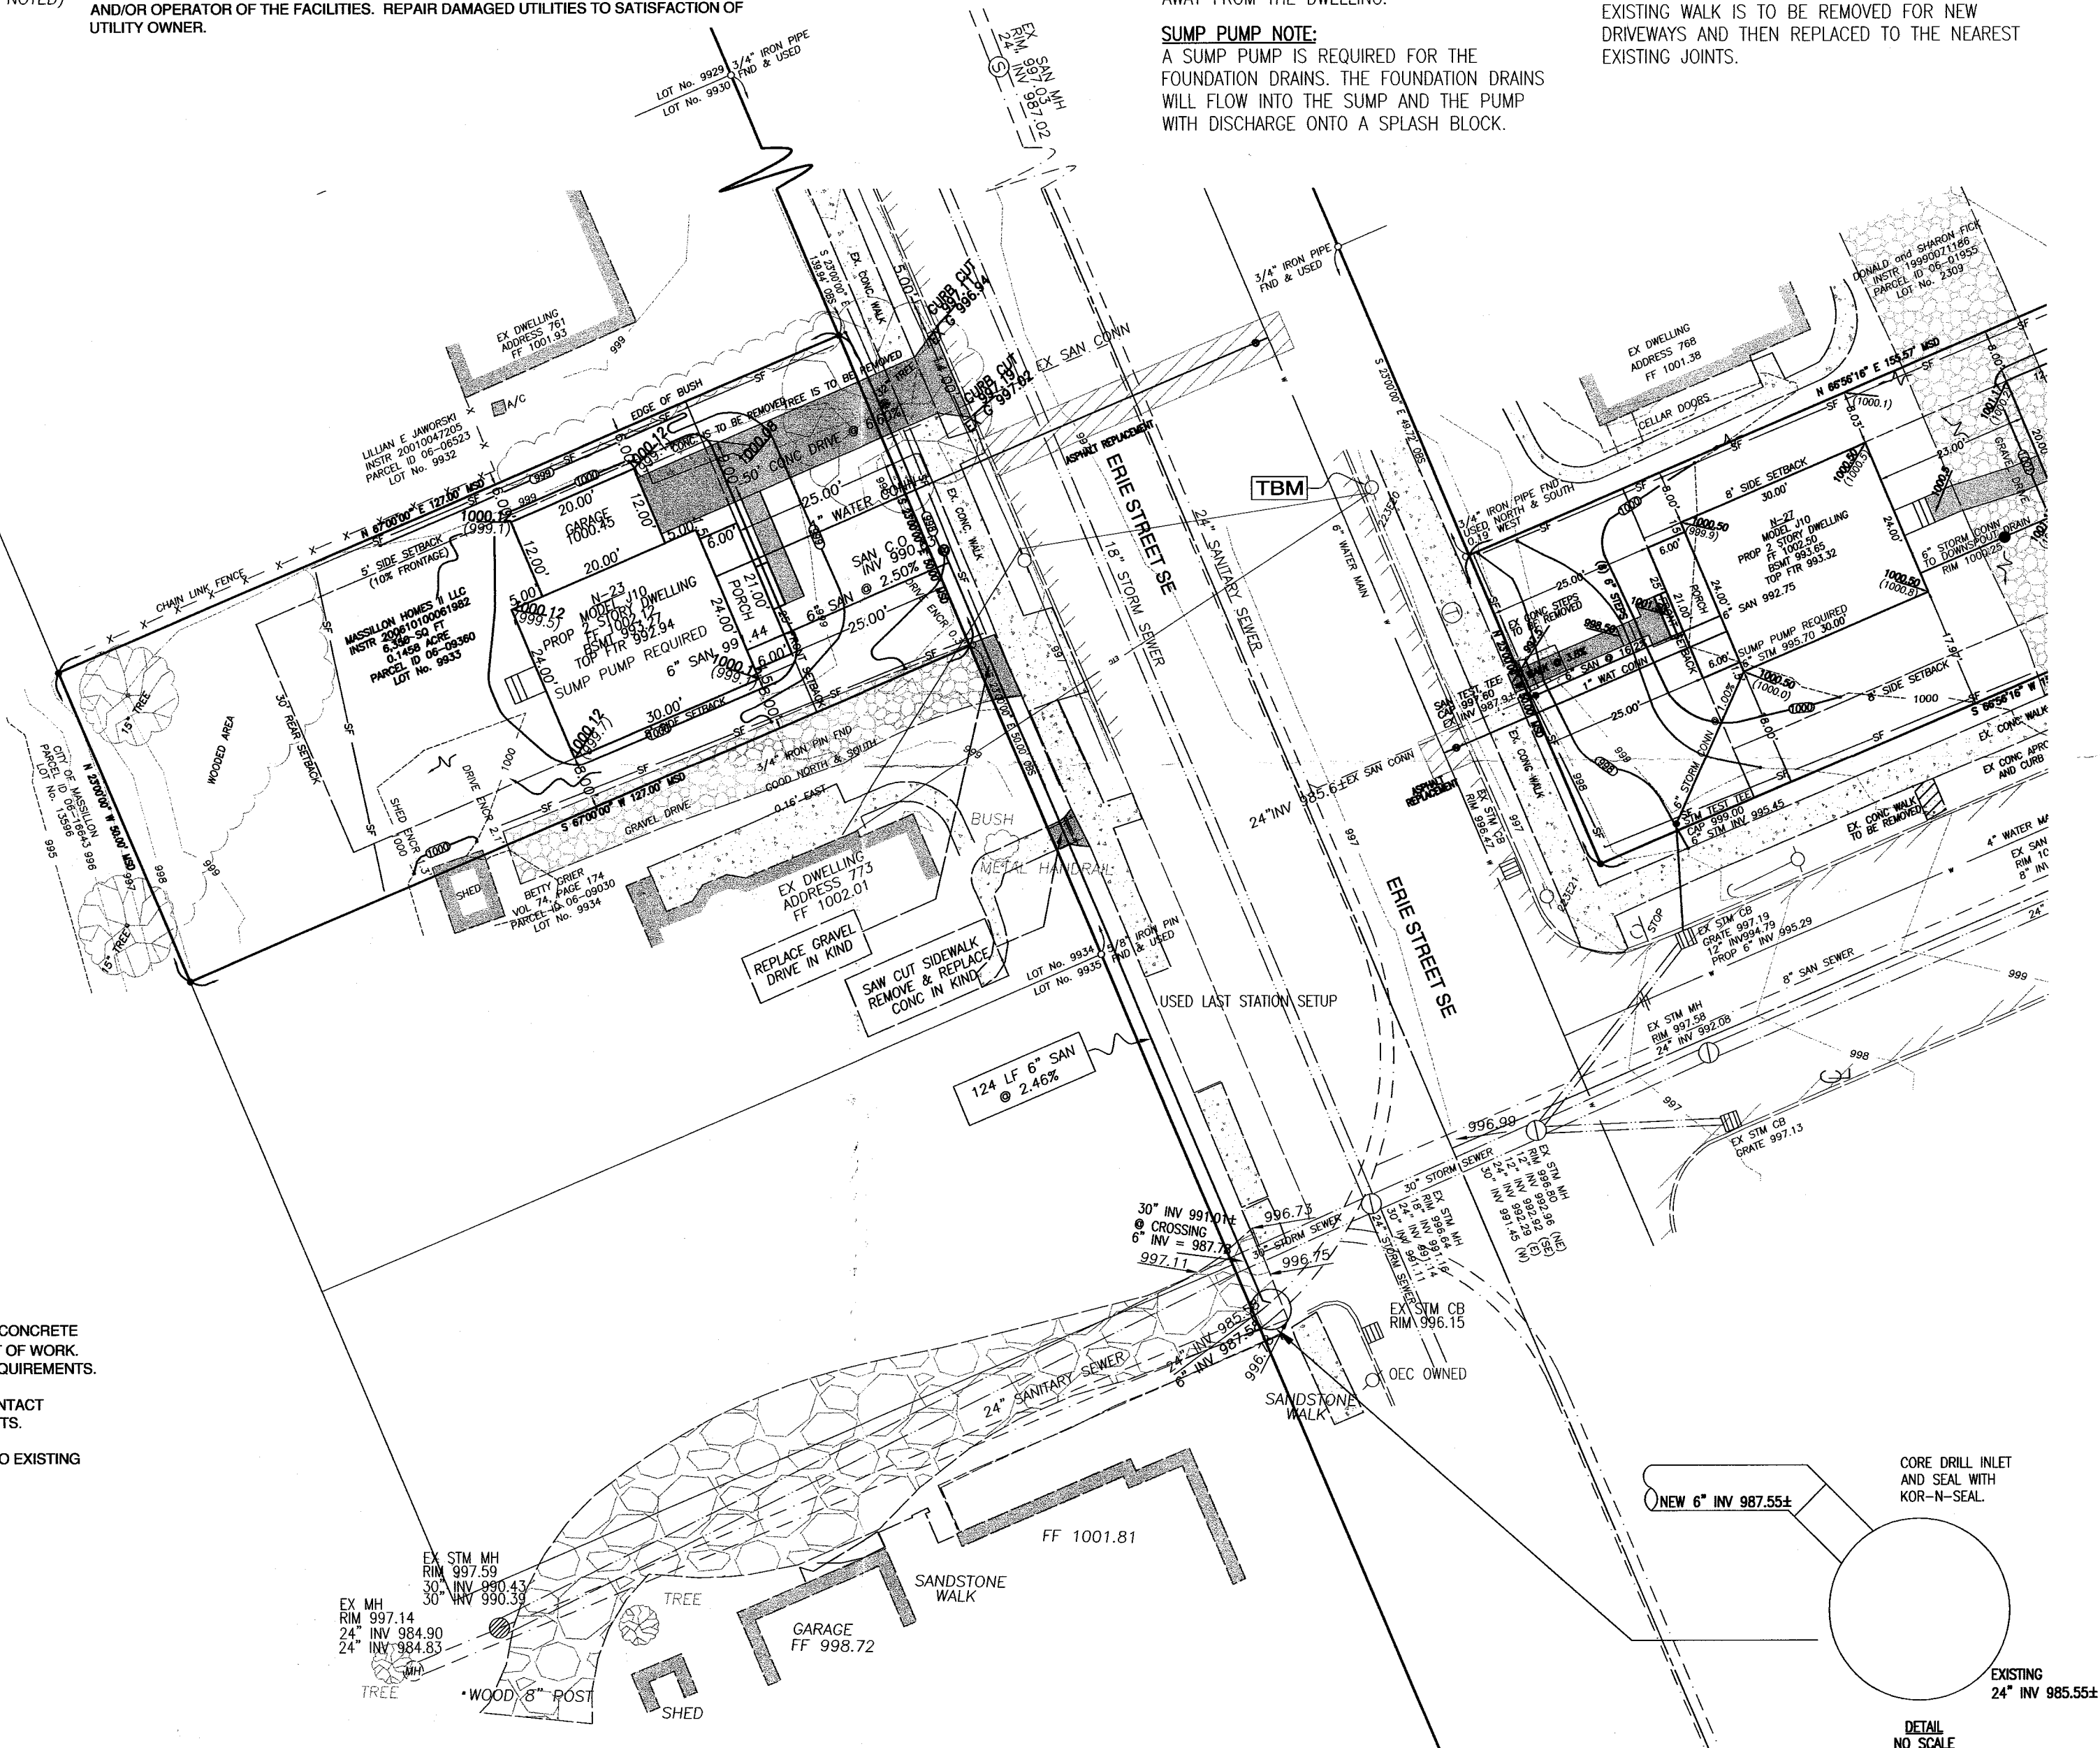

MAINTENANCE ✓ SEWER CALL

CALL RECEIVED BY: Harold

DATE & TIME CALL RECEIVED: 5/16/07 9:50 to 11:30

NAME:

ADDRESS: Erie St S. & Curley Court SE

PHONE #:

PROBLEM & LOCATION: Looking for Lateral

UPSTREAM MANHOLE ADDRESS:

DOWNSTREAM MANHOLE ADDRESS:

LINE LOCATION Street SIZE 18 LENGTH TV 158'

TYPE OF PIPE Clay

UPSTREAM DEPTH DOWNSTREAM DEPTH

OF LINES

ANY SPECIAL INSTRUCTIONS: TV'd this line South

From Curley Court on Erie St.

FOUND: ROOTS GREASE SOLIDS

OTHER

CONDITION OF LINE: ✓ OK PLUGGED

REMARKS:

6.3' East side Lateral	129.4 East side Lateral
38.6 " " "	134.0 West " "
56.6 West " "	157.2' Line starts to Turn West
81.2 East " "	At about 167' the line
85.3 " " "	from Maple comes into this line
93.0 West " "	

DATE COMPLETED 5/16/07 HOURS 1 hr 40 min

SIGNED RV/WA