

**FOLLOWING DATA TO BE ANSWERED BY INSPECTOR
AND SIGNED WHEN RETURNED**

Nº 4004

11
✓ 6

DATE INSPECTED 10/30/38

IF SO HOW AND LOCATION FROM
FIRST MANHOLE DOWN STREAM _____

HOUSE NO. 705

DISTANCE FROM FIRST MANHOLE
DOWN STREAM TO DITCH AT
CURB LINE AND DEPTH _____

SIZE OF PIPE USED 4"


184-6'7" at main

WAS LATERAL AT CURB? _____

NAME OF CONTRACTOR Bio Earley

WAS ATTACHED TO MAIN _____

SHOW BY DIAGRAM RELATION OF LATERAL TO WALL OF BUILDING SERVED. 16TH ST. N E.

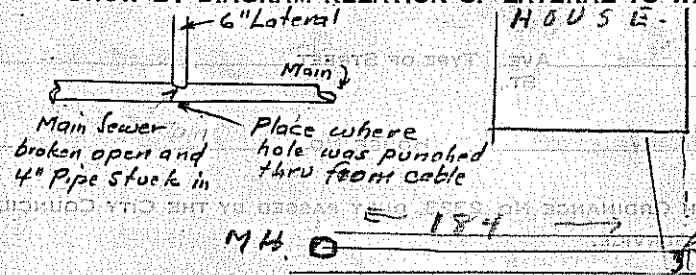

6'7" to top of Pipe

Looks like lateral
put in later, (after
was built) very fir-
found when punching
that cable went thr-
East Side of Main,
about 1 1/2" dia. lat-
filled up with roots
dumped two wash
full of water in and
trickled out slowly.

SIGNED John Ehman
INSPECTOR FOR CITY

FILED AT ENGINEER'S OFFICE

REMARKS: Hole punched through pipe it was full of roots

10/31/38

TO BE ANSWERED BY INSPECTOR

OFFICE OF THE DIRECTOR OF PUBLIC SERVICE

NO 4004

PERMIT TO TAP SEWER

MASSILLON, OHIO,

19

RECEIVED OF

FEE OF \$

FOR WHICH PERMISSION IS GRANTED

TO TAP

SEWER ON THE

OF

AVE., TYPE OF STREET
ST.,

THE PREMISES BEING LOT No.

House No.

WORK TO BE DONE IN ACCORDANCE WITH ORDINANCE No. 2323, DULY PASSED BY THE CITY COUNCIL
RULES OF THE DEPARTMENT OF PUBLIC SERVICE.

NAME OF CONTRACTOR

Note. This permit covers work outside of building only. Any work inside of building is subject to Massillon Board of Health Regulations.