

**FOLLOWING DATA TO BE ANSWERED BY INSPECTOR
AND SIGNED WHEN RETURNED**

✓
1-10
Stm Sew

No. 4060

DATE INSPECTED 11/28/39

**IF SO HOW AND LOCATION FROM
FIRST MANHOLE DOWN STREAM**

32

HOUSE No. SUNOCO GAS STATION

**DISTANCE FROM FIRST MANHOLE
DOWN STREAM TO DITCH AT
CURB LINE AND DEPTH**

32 - 4d

SIZE OF PIPE USED

4" up

WAS LATERAL AT CURB? NO

NAME OF CONTRACTOR

Earley


WAS ATTACHED TO MAIN NO

SHOW BY DIAGRAM RELATION OF LATERAL TO WALL OF BUILDING SERVED.

2' 11" →

ERIE ST. S.

N. →

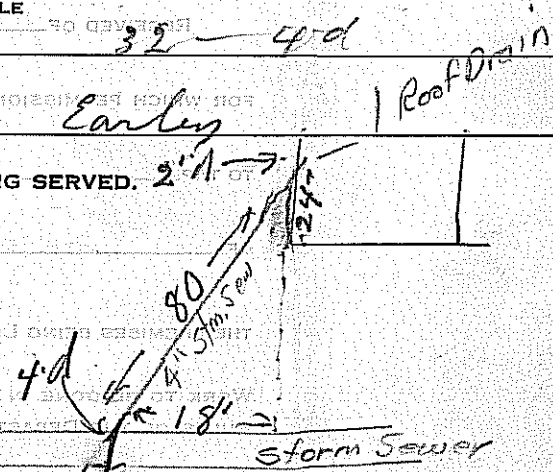

MAO

SIGNED

John E. Egan
INSPECTOR FOR CITY

FILED AT ENGINEER'S OFFICE

11/28/39 OK
GLO

REMARKS:

was laid without inspection see man didn't think it need inspection
account of it being a storm Sew

OFFICE OF THE DIRECTOR OF PUBLIC SERVICE
No. 4060
PERMIT TO TAP SEWER

MASSILLON, OHIO, 7/28 19

RECEIVED OF

FEE OF \$ 2.00

FOR WHICH PERMISSION IS GRANTED

TO TAP

SEWER, ON THE

OF

AVE., TYPE OF STREET
ST.,

THE PREMISES BEING LOT No.

House No.

WORK TO BE DONE IN ACCORDANCE WITH ORDINANCE No. 2323, DULY PASSED BY THE CITY COUNCIL
RULES OF THE DEPARTMENT OF PUBLIC SERVICE.

NAME OF CONTRACTOR

Note. This permit covers work outside of building only. Any work inside of building is subject to Massillon Board of Health Regulations.