

Nº 4429

FOLLOWING DATA TO BE ANSWERED BY INSPECTOR
AND SIGNED WHEN RETURNED

DATE INSPECTED _____

IF SO HOW AND LOCATION FROM
FIRST MANHOLE DOWN STREAM _____

HOUSE NO. 2206

DISTANCE FROM FIRST MANHOLE
DOWN STREAM TO DITCH AT
CURB LINE AND DEPTH _____


SIZE OF PIPE USED 6"

WAS LATERAL AT CURB? —

WAS ATTACHED TO MAIN Yes

NAME OF CONTRACTOR P.E. Bickel

SHOW BY DIAGRAM RELATION OF LATERAL TO WALL OF BUILDING SERVED.

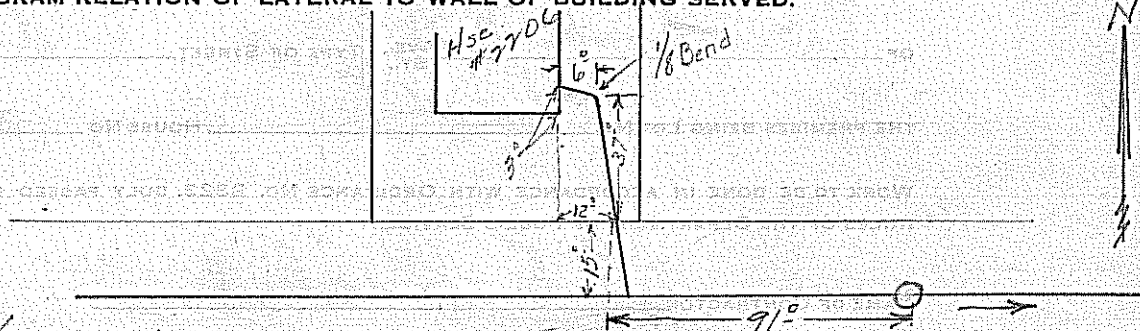

SIGNED Chas. Urban
INSPECTOR FOR CITY

FILED AT ENGINEER'S OFFICE

REMARKS: Lateral connected at time main was constructed

Nº 4429

OFFICE OF THE DIRECTOR OF PUBLIC SERVICE

PERMIT TO TAP SEWER

MASSILLON, OHIO, 9/24

RECEIVED OF

FEE OF \$ 2-

FOR WHICH PERMISSION IS GRANTED

TO TAP

SEWER, ON THE

OF

AVE., TYPE OF STREET

THE PREMISES BEING LOT NO.

HOUSE NO.

WORK TO BE DONE IN ACCORDANCE WITH ORDINANCE NO. 2323, DULY PASSED BY THE CITY COUNCIL
RULES OF THE DEPARTMENT OF PUBLIC SERVICE.

NAME OF CONTRACTOR

Note. This permit covers work outside of building only. Any work
walls of building is subject to Massillon Board of Health Regulations.