


N^o 4902

FOLLOWING DATA TO BE ANSWERED BY INSPECTOR AND SIGNED WHEN RETURNED

DATE INSPECTED 1-14-47IF SO HOW AND LOCATION FROM
FIRST MANHOLE DOWN STREAM12'7' DeepHOUSE NO. 652SIZE OF PIPE USED 6"DISTANCE FROM FIRST MANHOLE
DOWN STREAM TO DITCH AT
CURB LINE AND DEPTHSee SketchWAS LATERAL AT CURB? NoWAS ATTACHED TO MAIN See Sketch NAME OF CONTRACTOR Diana

SHOW BY DIAGRAM RELATION OF LATERAL TO WALL OF BUILDING SERVED.

Note: 8" pipe was laid
to the East from M.H. and
8" x 6" Y is 12' East of M.H.
This was done in case a
street is opened up to the
East from Scott Place.

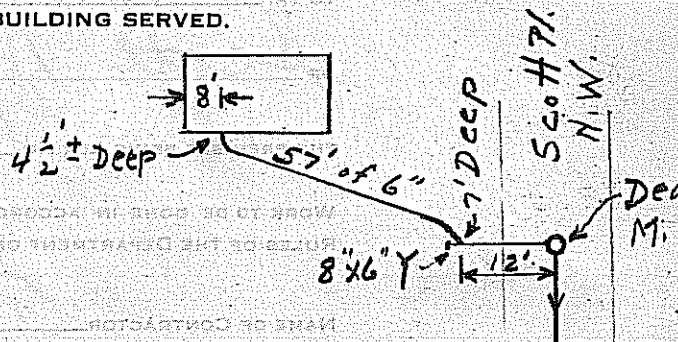

SIGNED

R. J. Snyder

INSPECTOR FOR CITY

FILED AT ENGINEER'S OFFICE

1-24-47

REMARKS:

OFFICE OF THE DIRECTOR OF PUBLIC SERVICE

N^o 4902

PERMIT TO TAP SEWER

MASSILLON, OHIO, 1/13

RECEIVED OF

FEE OF \$ 2.00

FOR WHICH PERMISSION IS GRANTED

TO TAP

SEWER, ON THE

OF

AVE., TYPE OF STREET

THE PREMISES BEING LOT NO.

HOUSE NO.

WORK TO BE DONE IN ACCORDANCE WITH ORDINANCE No. 2323, DULY PASSED BY THE CITY COUNCIL
 RULES OF THE DEPARTMENT OF PUBLIC SERVICE.

NAME OF CONTRACTOR

Note. This permit covers work outside of building only. Any work in walls of building is subject to Massillon Board of Health Regulations.