

Nº 5066

FOLLOWING DATA TO BE ANSWERED BY INSPECTOR
AND SIGNED WHEN RETURNED

DATE INSPECTED 11-13-47

IF SO HOW AND LOCATION FROM
FIRST MANHOLE DOWN STREAM

HOUSE NO. 1013

SIZE OF PIPE USED 6" up ~~DOWN~~ STREAM TO DITCH AT CURB LINE AND DEPTH 61' 6' Deep


WAS LATERAL AT CURB? Yes

WAS ATTACHED TO MAIN

NAME OF CONTRACTOR

Remley

SHOW BY DIAGRAM RELATION OF LATERAL TO WALL OF BUILDING SERVED.

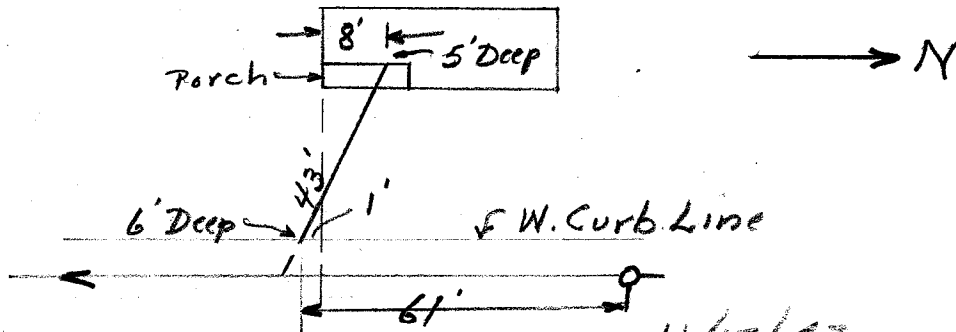

SIGNED

R. F. Snyder

INSPECTOR FOR CITY

FILED AT ENGINEER'S OFFICE

11/17/47

REMARKS:

Existing lateral was laid under walk but was relaid from curb to get greater Depth.

Nº 5066

OFFICE OF THE DIRECTOR OF PUBLIC SERVICE

PERMIT TO TAP SEWER

MASSILLON, OHIO, 11/13

194

RECEIVED OF R. Remy

FEE OF \$ 2.00

FOR WHICH PERMISSION IS GRANTED John Clement

TO TAP San

SEWER, ON THE N

SIDE

OF 2nd N.E.

AVE.,
ST.

TYPE OF STREET Alley

THE PREMISES BEING LOT No. 7811

HOUSE No. 1013

WORK TO BE DONE IN ACCORDANCE WITH ORDINANCE NO. 2323, DULY PASSED BY THE CITY COUNCIL, AND RULES OF THE DEPARTMENT OF PUBLIC SERVICE.

NAME OF CONTRACTOR R. Remy

Note. This permit covers work outside of building only. Any work inside walls of building is subject to Massillon Board of Health Regulations.