

Nº 5105

FOLLOWING DATA TO BE ANSWERED BY INSPECTOR
AND SIGNED WHEN RETURNED

DATE INSPECTED 3-30-48

IF SO HOW AND LOCATION FROM
FIRST MANHOLE DOWN STREAM

Sta. 1+03

HOUSE NO. 317

SIZE OF PIPE USED 6"

DISTANCE FROM FIRST MANHOLE
DOWN STREAM TO DITCH AT
CURB LINE AND DEPTH

112'

7' Deep

WAS LATERAL AT CURB? Yes


WAS ATTACHED TO MAIN

NAME OF CONTRACTOR

Aston

SHOW BY DIAGRAM RELATION OF LATERAL TO WALL OF BUILDING SERVED.

Lateral partly in when
main line was laid.
34' More laid to house
on 3-30-48

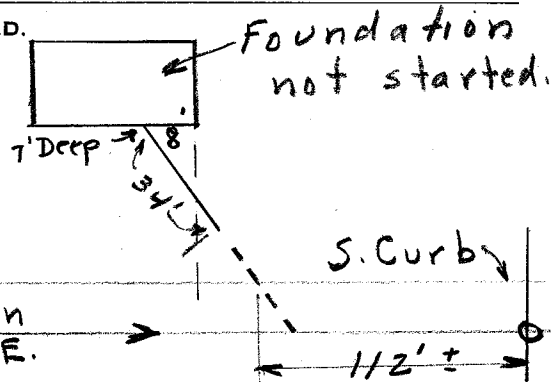

SIGNED

R. F. Snyder
INSPECTOR FOR CITY

FILED AT ENGINEER'S OFFICE

4/1/48

REMARKS:

Nº 5105

OFFICE OF THE DIRECTOR OF PUBLIC SERVICE
PERMIT TO TAP SEWER

MASSILLON, OHIO.

4/1 1948

RECEIVED OF

C. P. Kenner

FEE OF \$

2.00

FOR WHICH PERMISSION IS GRANTED

W. Aston

TO TAP

Sanitary

SEWER, ON THE

Gravel

SIDE

OF

Indiana NE

AVE., TYPE OF STREET

South

THE PREMISES BEING LOT NO.

10749 ~~XXXX~~

HOUSE NO.

317

WORK TO BE DONE IN ACCORDANCE WITH ORDINANCE NO. 2323, DULY PASSED BY THE CITY COUNCIL, AND
RULES OF THE DEPARTMENT OF PUBLIC SERVICE.

NAME OF CONTRACTOR

W. Aston

Note. This permit covers work outside of building only. Any work inside walls of building is subject to Massillon Board of Health Regulations.