

15/24

No 5981

FOLLOWING DATA TO BE ANSWERED BY INSPECTOR
AND SIGNED WHEN RETURNED.

DATE INSPECTED 12-20-52

IF SO HOW AND LOCATION FROM
FIRST MANHOLE DOWN STREAM

HOUSE NO. 21-30

SIZE OF PIPE USED 6"

DISTANCE FROM FIRST MANHOLE
DOWN STREAM TO DITCH AT
CURB LINE AND DEPTH

166'

8' DE

WAS LATERAL AT CURB? yes


WAS ATTACHED TO MAIN yes

NAME OF CONTRACTOR

A. DIANA

SHOW BY DIAGRAM RELATION OF LATERAL TO WALL OF BUILDING SERVED

SEWER WAS LAID THROUGH OLD
HOUSE WITH 4" SOIL PIPE
AND BETWEEN HOUSE A" VON
SLIPSEAL PIPE WAS USED
REPLACED ALL OF THIS
WITH 6" V.S. PIPE

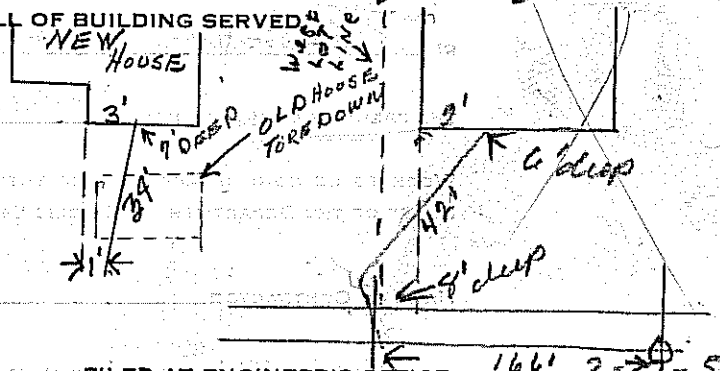

3-27-63
A. J. DIANA

SIGNED [Signature]
INSPECTOR FOR CITY

FILED AT ENGINEER'S OFFICE 166' 2-27-53

REMARKS: GOING TO BUILD ON WEST OF HOUSE NOW STANDING

№ 5981

OFFICE OF THE DIRECTOR OF PUBLIC SERVICE

PERMIT TO TAP SEWER

MASSILLON, OHIO, 1/6/53

RECEIVED OF A. J. Diana

FEE OF 20

FOR WHICH PERMISSION IS GRANTED Alexander Beveridge

TO TAP sanitary

SEWER, ON THE north

OF Placemont St

AVE.,
ST.,

TYPE OF STREET dirt

THE PREMISES BEING LOT NO. 6033-6034

HOUSE NO. 2130

WORK TO BE DONE IN ACCORDANCE WITH ORDINANCE No. 2323, DULY PASSED BY THE CITY COUNCIL
RULES OF THE DEPARTMENT OF PUBLIC SERVICE.

NAME OF CONTRACTOR A. J. Diana

Note. This permit covers work outside of building only. Any work in walls of building is subject to Massillon Board of Health Regulations.