

N^o 7159

FOLLOWING DATA TO BE ANSWERED BY INSPECTOR
AND SIGNED WHEN RETURNED

DATE INSPECTED 10-2-89

IF SO HOW AND LOCATION FROM
FIRST MANHOLE DOWN STREAM _____

HOUSE NO. 1508

SIZE OF PIPE USED 6"


DISTANCE FROM FIRST MANHOLE
DOWN STREAM TO DITCH AT
CURB LINE AND DEPTH 101' SOUTH OF MH @ peak 7'

WAS LATERAL AT CURB? YES

WAS ATTACHED TO MAIN NO

NAME OF CONTRACTOR G J D'Amico

SHOW BY DIAGRAM RELATION OF LATERAL TO WALL OF BUILDING SERVED.

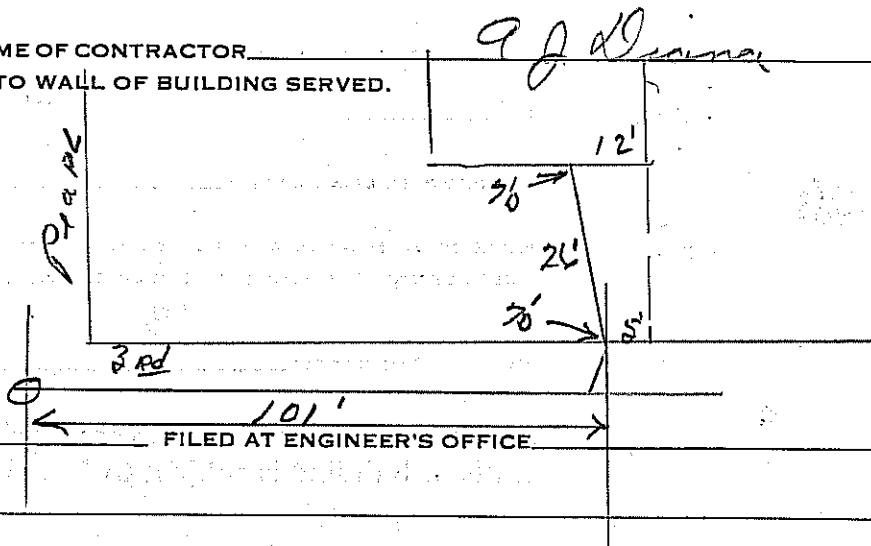

SIGNED

Roy Latham
INSPECTOR FOR CITY

FILED AT ENGINEER'S OFFICE

REMARKS _____

OFFICE OF THE DIRECTOR OF PUBLIC SERVICE

NO. 7159

PERMIT TO TAP SEWER

MASSILLON, OHIO, 10/11, 1911

RECEIVED OF A. J. Mann FEE OF \$ 2

FOR WHICH PERMISSION IS GRANTED Henry J. Mann

TO TAP Side SEWER ON THE East

OF 3rd A.E. AVE. ST. TYPE OF STREET hard surface

THE PREMISES BEING LOT NO. 5352, HOUSE NO. 1508

WORK TO BE DONE IN ACCORDANCE WITH ORDINANCE No. 2323, DULY PASSED BY THE CITY COUNCIL
RULES OF THE DEPARTMENT OF PUBLIC SERVICE.

NAME OF CONTRACTOR A. J. Mann

Note This permit covers work outside of building only. Any work in walls of building is subject to Massillon Board of Health Regulations.