


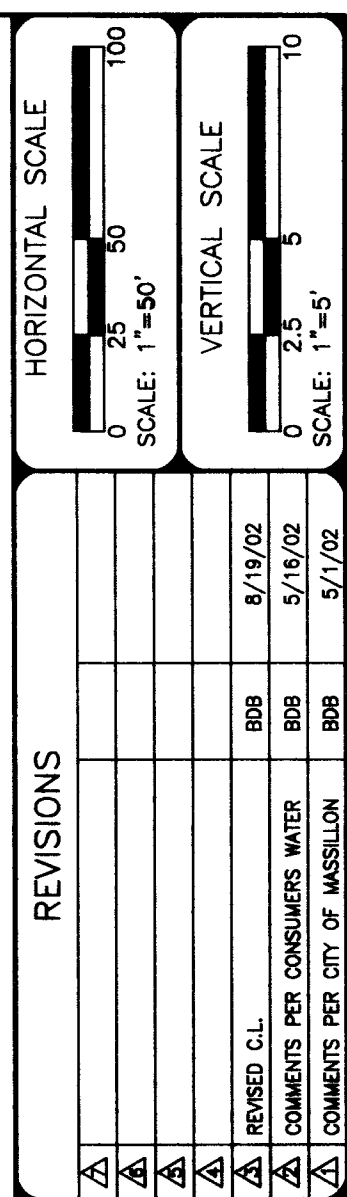


NOTES:

1. SIDEWALKS NOT REPRESENTED ON PLAN FOR CLARITY. SEE INTERSECTION DETAILS (SHEET 7) FOR HANDICAP RAMPS.
2. CONTRACTOR MUST CONSTRUCT ALL WATER LINES AND WATER SERVICE LINES SUCH THAT A MINIMUM OF 10' HORIZONTAL CLEARANCE, 18" VERTICAL CLEARANCE ABOVE SANITARY SEWER AND A MINIMUM OF 12" CLEARANCE BELOW STORM SEWER IS MAINTAINED.

COOPER & ASSOCIATES, LLP
ENGINEERS AND SURVEYORS

BRYAN J. ASHMAN
JEROLD E. GEIB

PHONE (330) 452-5731
FAX NO (330) 452-9110

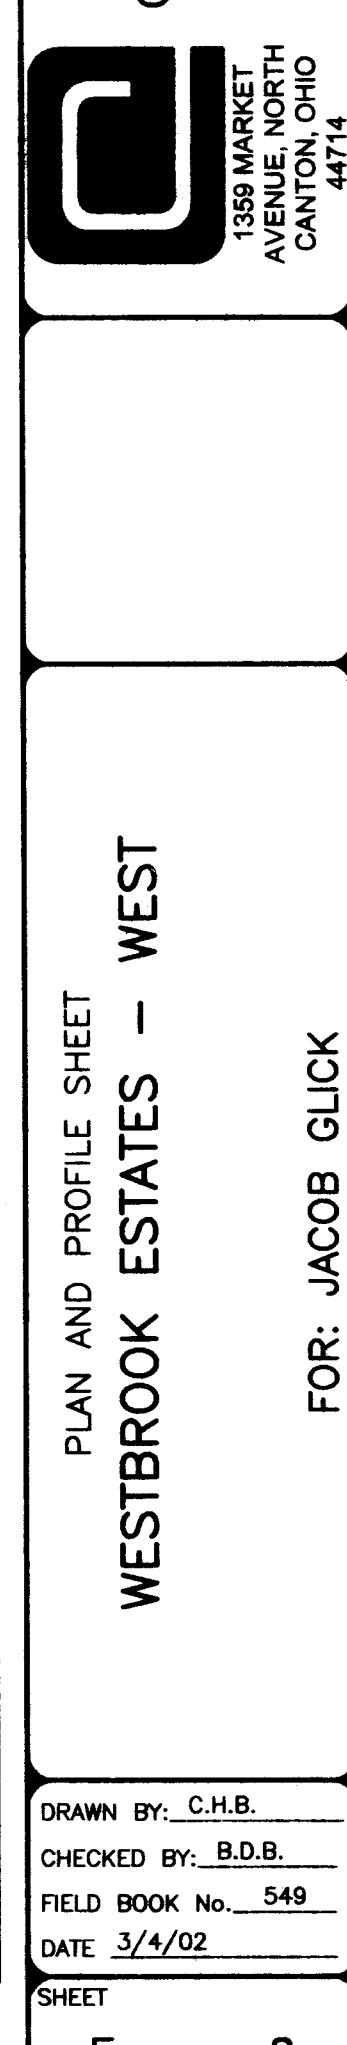

WOODSTONE AVE. N.W.

PROJ. #: 01142

02 SD 05

WESTBROOK ESTATES - WEST
OUTLOT 772 IN THE CITY OF MASSILLON, SITUATED IN
PART OF THE N.W. QUARTER OF SECTION 10,
TOWNSHIP-12 (TUSCARAWAS TWP.), RANGE-10
STARK COUNTY, OHIO

JACOB GLICK
4600 LINCOLN WAY WEST
MASSILLON, OHIO 44647
CONTACT: JACOB GLICK
PHONE: (330) 832-7897

THIS 14th DAY OF May, 2002

522 L. H.
CITY OF MASSILLON ENGINEER


THIS 16 DAY OF MAY, 2002

Donald Snyder
CONSUMERS OHIO WATER COMPANY

THIS _____ DAY OF _____, 20____.

THIS DAY OF _____, 20_____.

D# DENOTES STORM STRUCTURE NUMBER
PD# DENOTES STORM PIPE NUMBER
D DENOTES 6" STORM LATERAL, COMPLETE
S# DENOTES SANITARY STRUCTURE NUMBER
PS# DENOTES SANITARY PIPE NUMBER
S DENOTES 6" SANITARY LATERAL, COMPLETE
 _____ DENOTES PROPOSED WATERLINE
W DENOTES 1" WATER SERVICE AND CURB BOX COMPLETE
 _____ EXISTING WATERLINE
M _____ EXISTING STORM SEWER
N _____ EXISTING SANITARY SEWER
G _____ EXISTING GAS LINE
 (00.00) DENOTES "AS-BUILT" DIMENSION OR ELEVATION

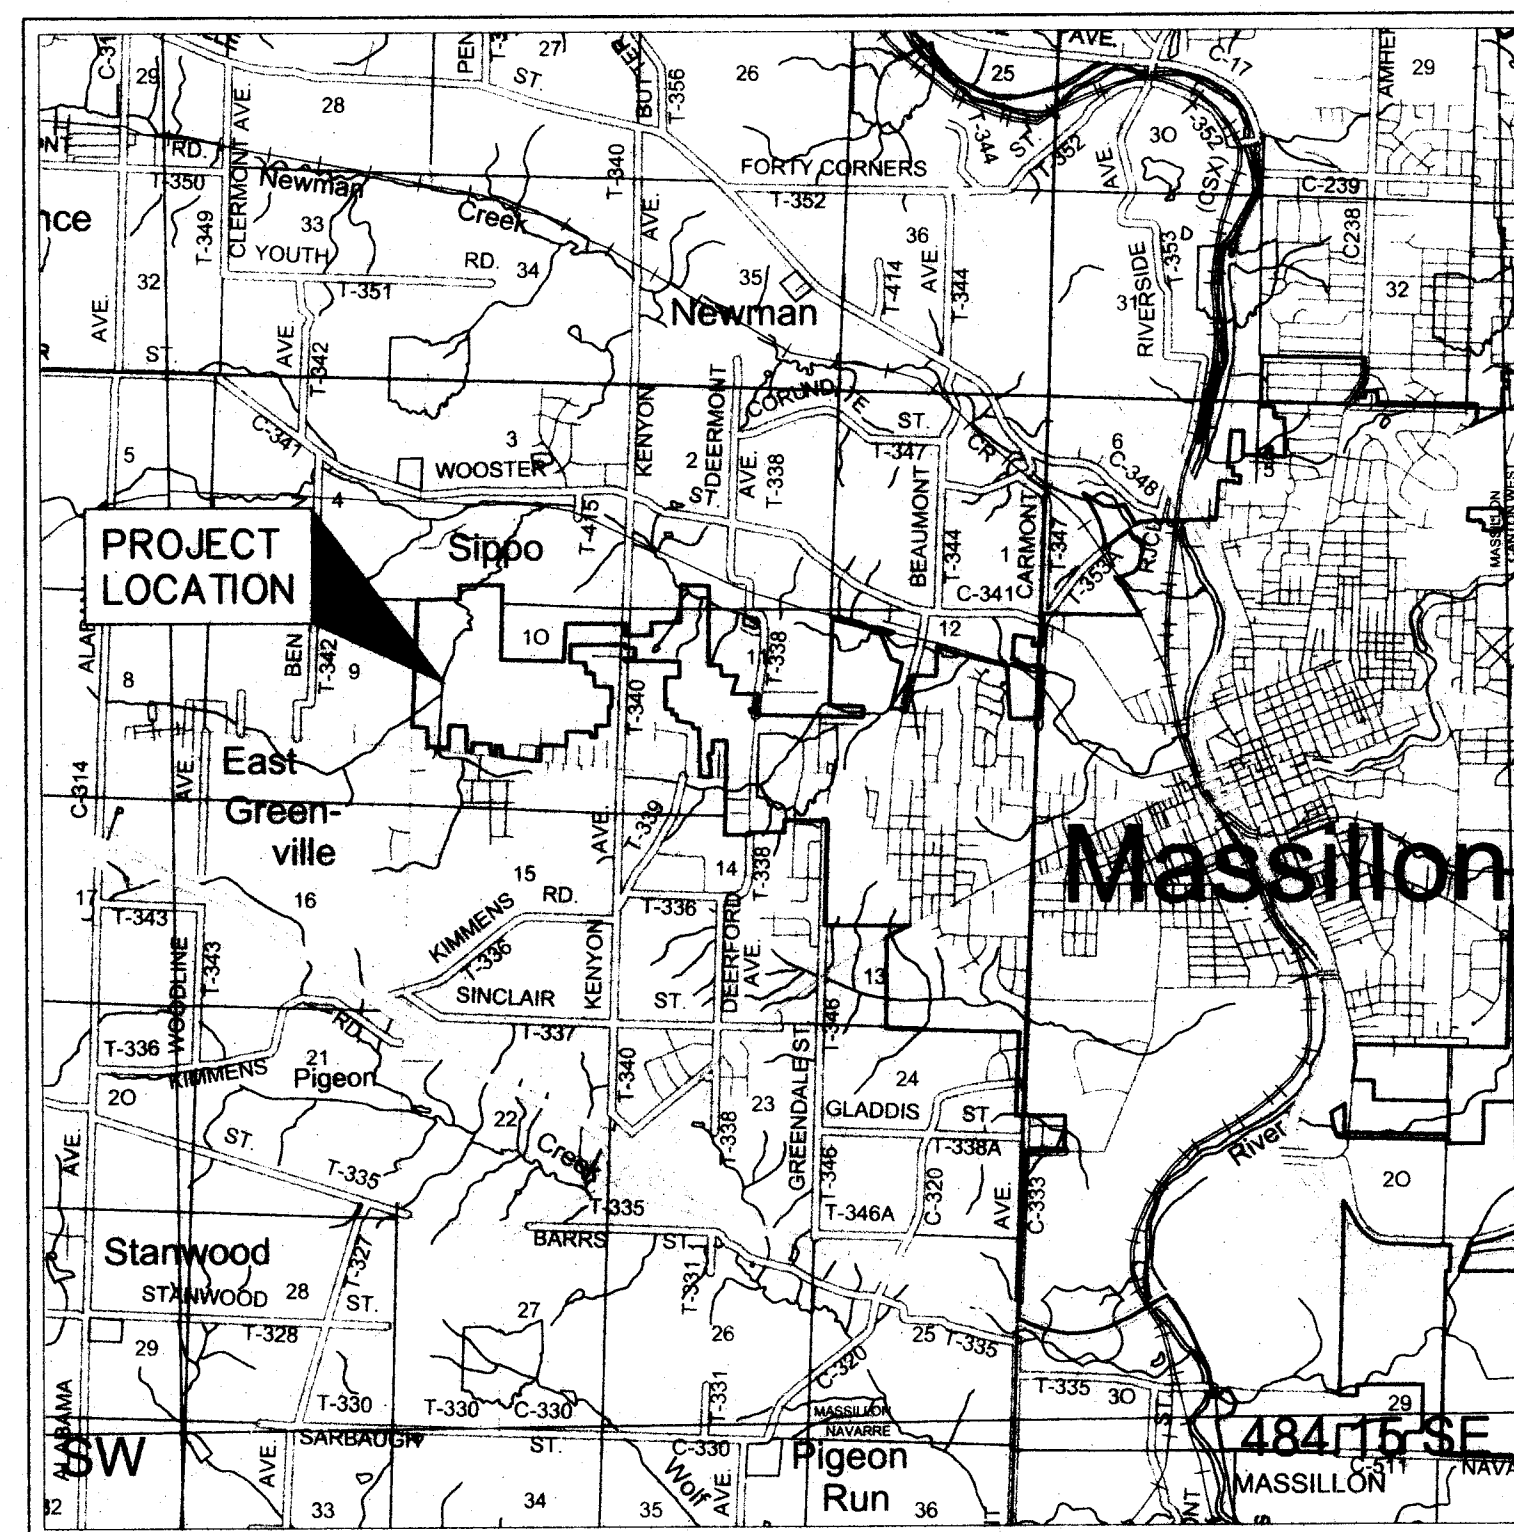

2 WORKING DAYS
BEFORE YOU DIG
CALL TOLL FREE 800-362-2764
OHIO UTILITIES PROTECTION SERVICE

ENGINEERS ESTIMATE		
TOTAL L.F. ROADWAY	1,504	\$173,162.02
TOTAL L.F. SANITARY SEWER	1,561	\$114,283.20
TOTAL L.F. STORM SEWER	1,890	\$ 93,295.00

[illegible][illegible]

1. TITLE SHEET
2. PROJECT SCHEMATIC
3. TYPICAL SECTIONS AND QUANTITIES
4. GENERAL NOTES
5. WOODSTONE AVE. - PLAN AND PROFILE
6. UTOPIA CIRCLE - PLAN AND PROFILE and DETENTION BASIN
7. INTERSECTION DETAILS
8. GRADING PLAN
- 1E-4E. STORMWATER POLLUTION PREVENTION PLANS

JUN 12 2005

OHIO EPA NEDC

DRAWN BY: C.H.B.
CHECKED BY: B.D.B.
FIELD BOOK No. 54
DATE 3/4/02

SHEET
1 OF 8


TITLE SHEET

PROJ.# 01142


HNland Projects R2\01142\dwg\01142.DWG 05/14/2002 10:51:16 AM EDT

02 30 05

MAURICE P.
MORSHEISER, ETAL
R.I.No.96002567
79.97 Ac.

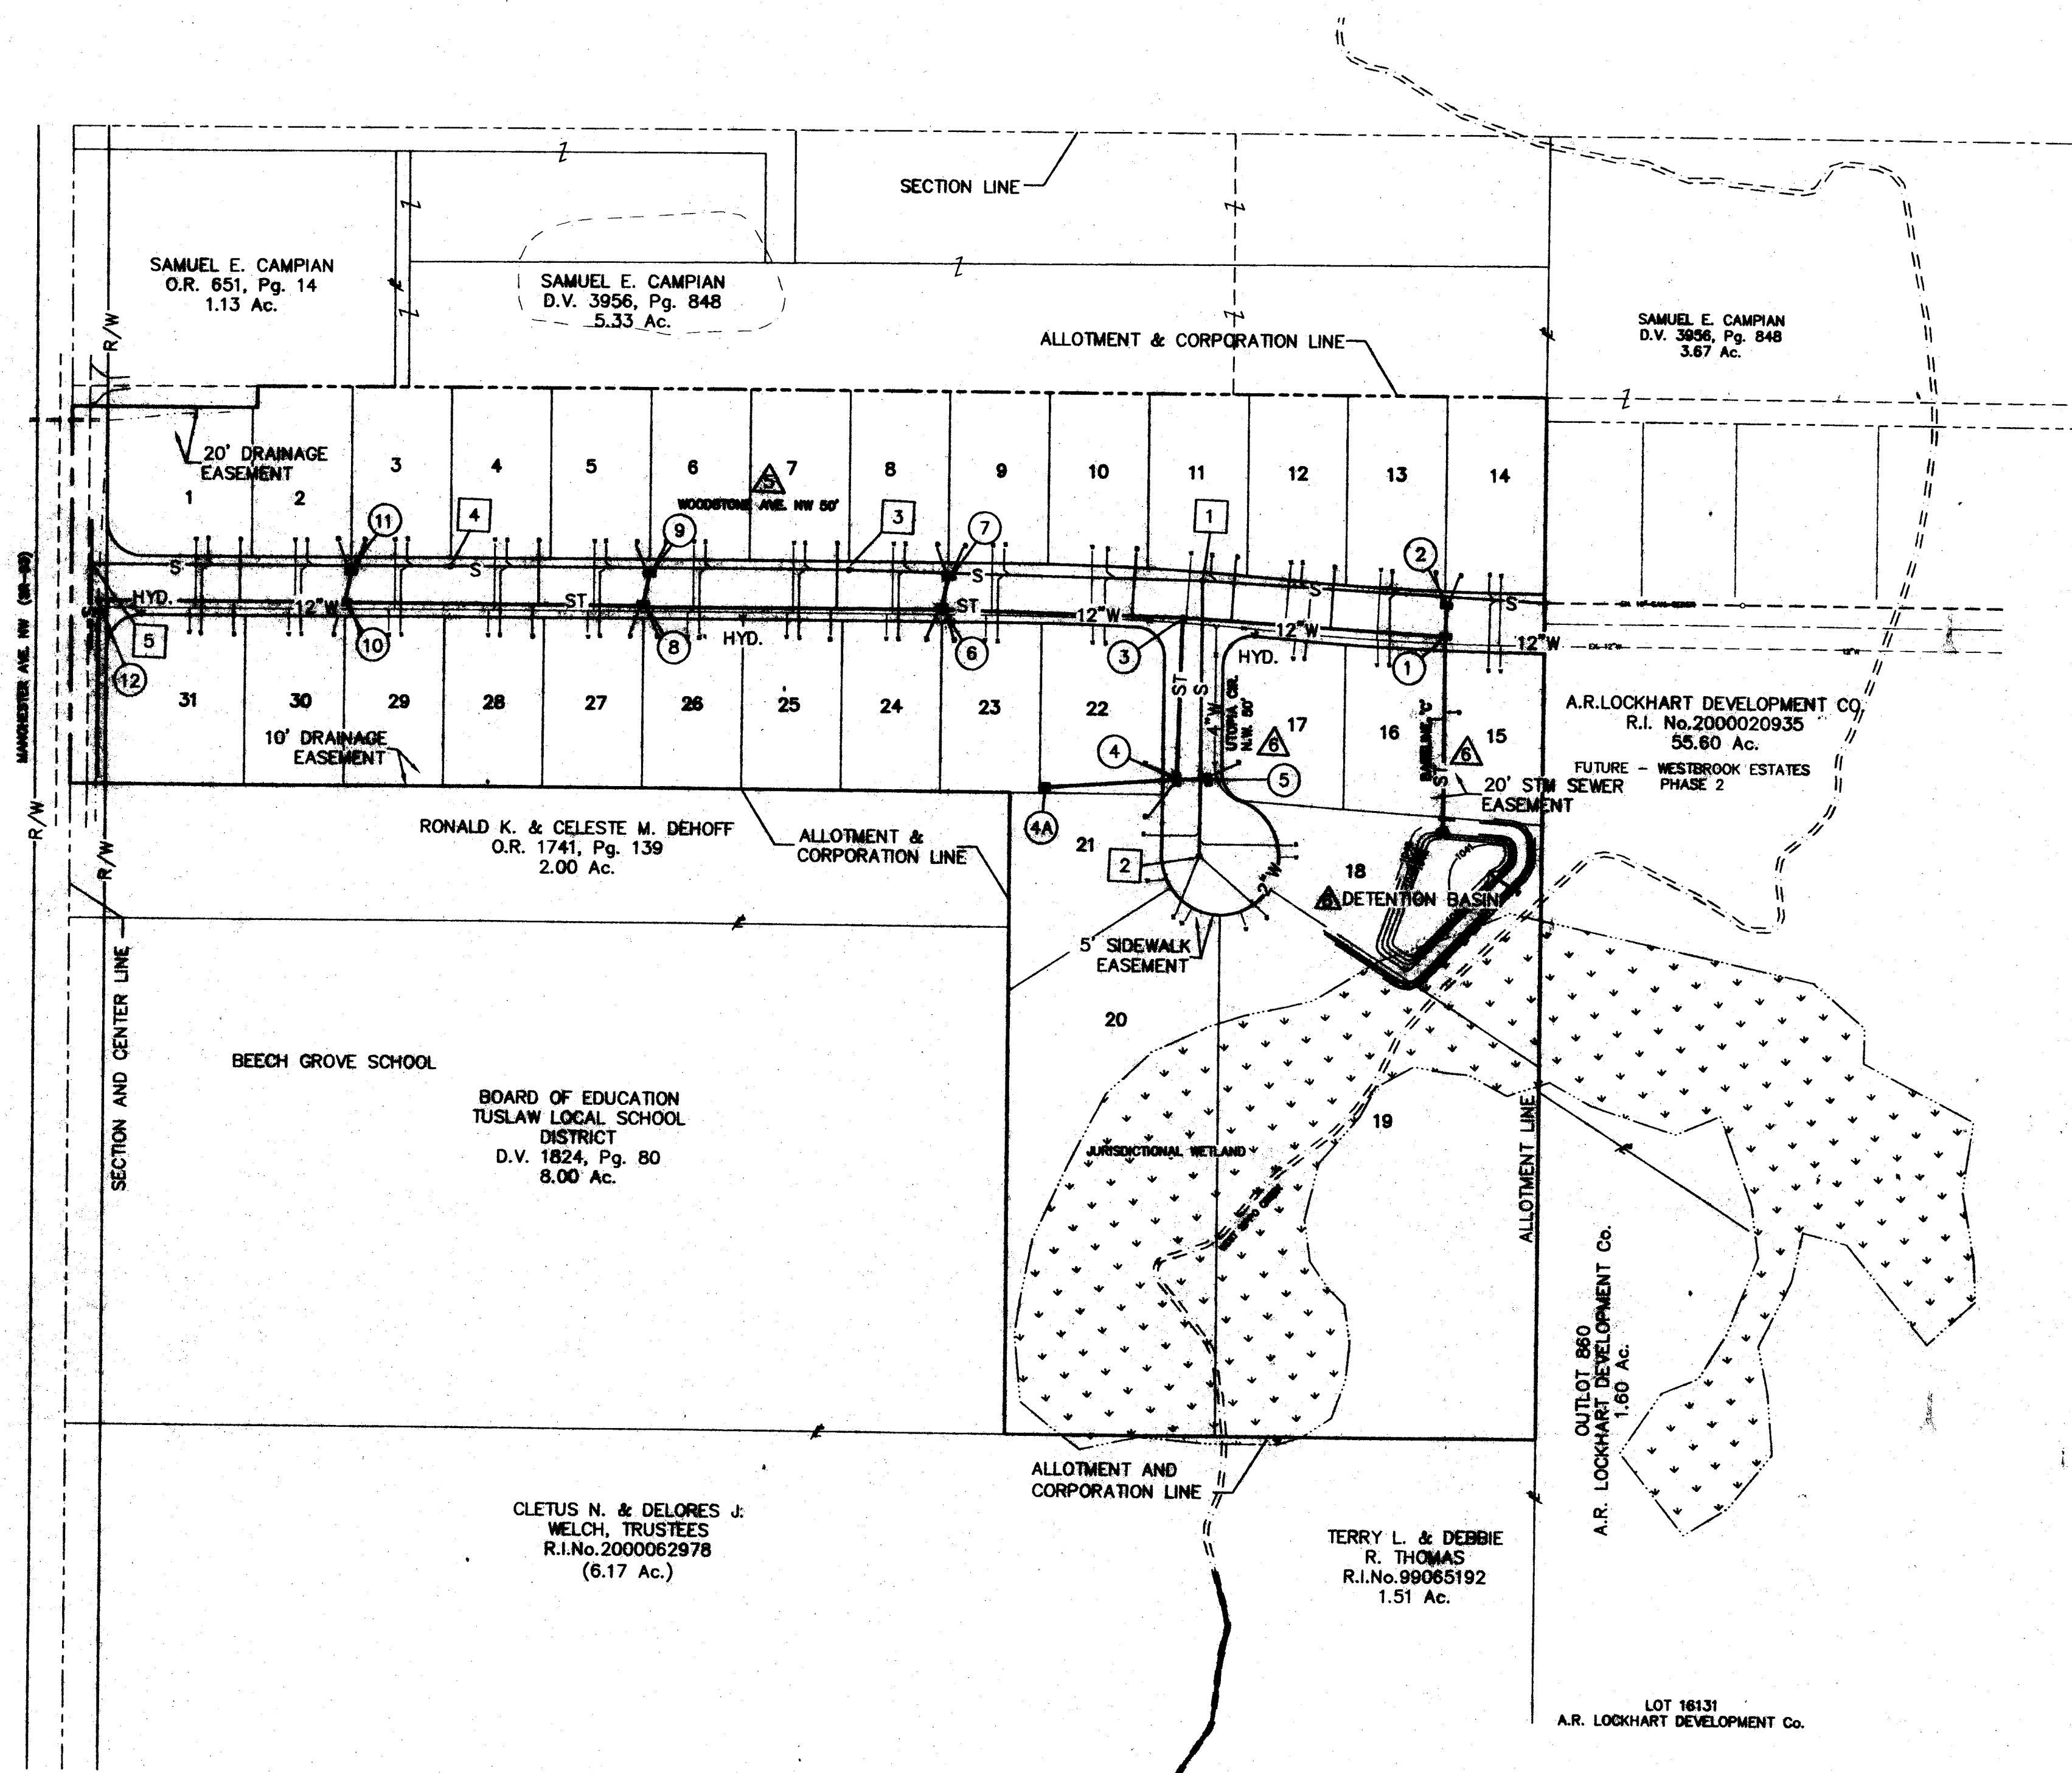

LEGEND
S# SANITARY STRUCTURE NUMBER
D# STORM STRUCTURE NUMBER
REFERENCE SHEET NUMBER

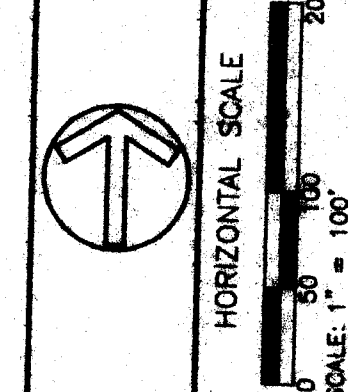

REVISIONS	
1	ADD COMMENTS PER CITY OF MASSACHUSETTS
2	ADD COMMENTS PER CITY OF MASSACHUSETTS

COOPER & ASSOCIATES, LLP
ENGINEERS AND SURVEYORS
BRYAN J. ASHMAN
JEROLDE E. GEIB
PHONE (330) 482-5731
FAX (330) 482-9719

1389 MARKET
AVENUE, NORTH
CANTON, OHIO
44703

XXXXXXXXXXXXXXXXXXXXXXXXXXXX
SEWERAGE
APPROVED
OHIO ENVIRONMENTAL PROTECTION AGENCY
AS EVIDENCED BY COPY OF
LETTER OF APPROVAL
HERE TO ATTACHED
XXXXXXXXXXXXXXXXXXXXXXXXXXXX


PROJECT SCHEMATIC
WESTBROOK ESTATES - WEST
FOR: JACOB GLICK

DRAWN BY: C.H.B.
CHECKED BY: B.D.B.
FIELD BOOK No. 549
DATE 3/4/02
SHEET
2 OF 8
PROJECT SCHEMATIC
01142

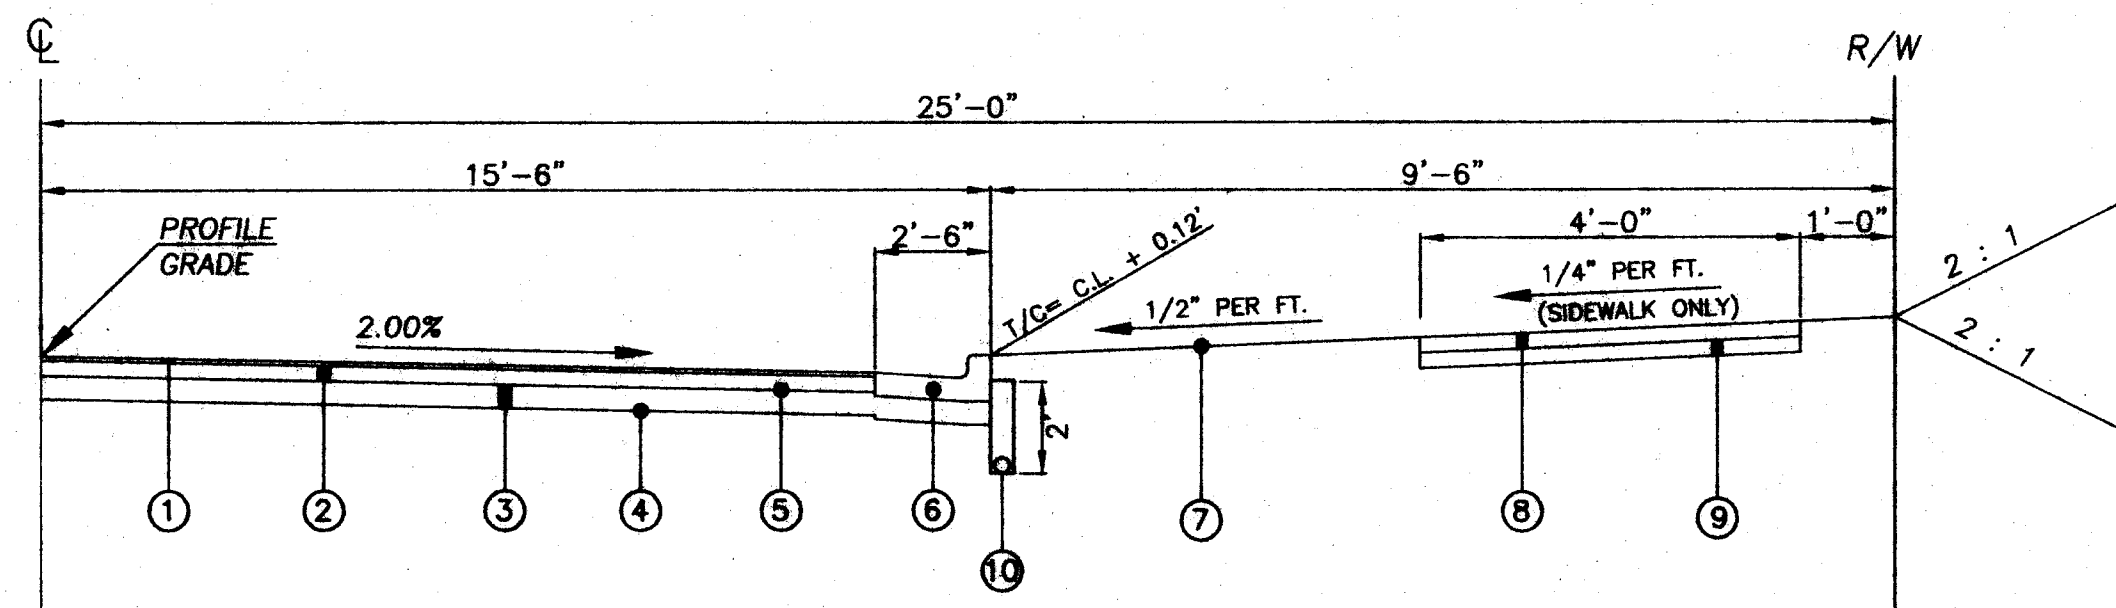

- ① ITEM 404 1 1/2" ASPHALT CONCRETE SURFACE
- ② ITEM 301 4" BITUMINOUS AGGREGATE BASE
- ③ ITEM 304 6" AGGREGATE BASE
- ④ ITEM 203 COMPACTED SUBGRADE
- ⑤ ITEM 408 BITUMINOUS PRIME COAT
- ⑥ ITEM 609 MASSILLON STANDARD CURB AND GUTTER
- ⑦ ITEM 659 SEEDING AND MULCHING
- ⑧ ITEM 608 4" CONCRETE SIDEWALK (6" Ø DRIVES)
- ⑨ ITEM 304 4" AGGREGATE BASE
- ⑩ ITEM 605 4" UNDERDRAIN (INSTALL ONLY IF DIRECTED BY CITY OF MASSILLON ENGINEER DURING CONSTRUCTION & INSPECTION OF SUBGRADE IN CUT AREAS ONLY.)

50' R/W TYPICAL SECTION

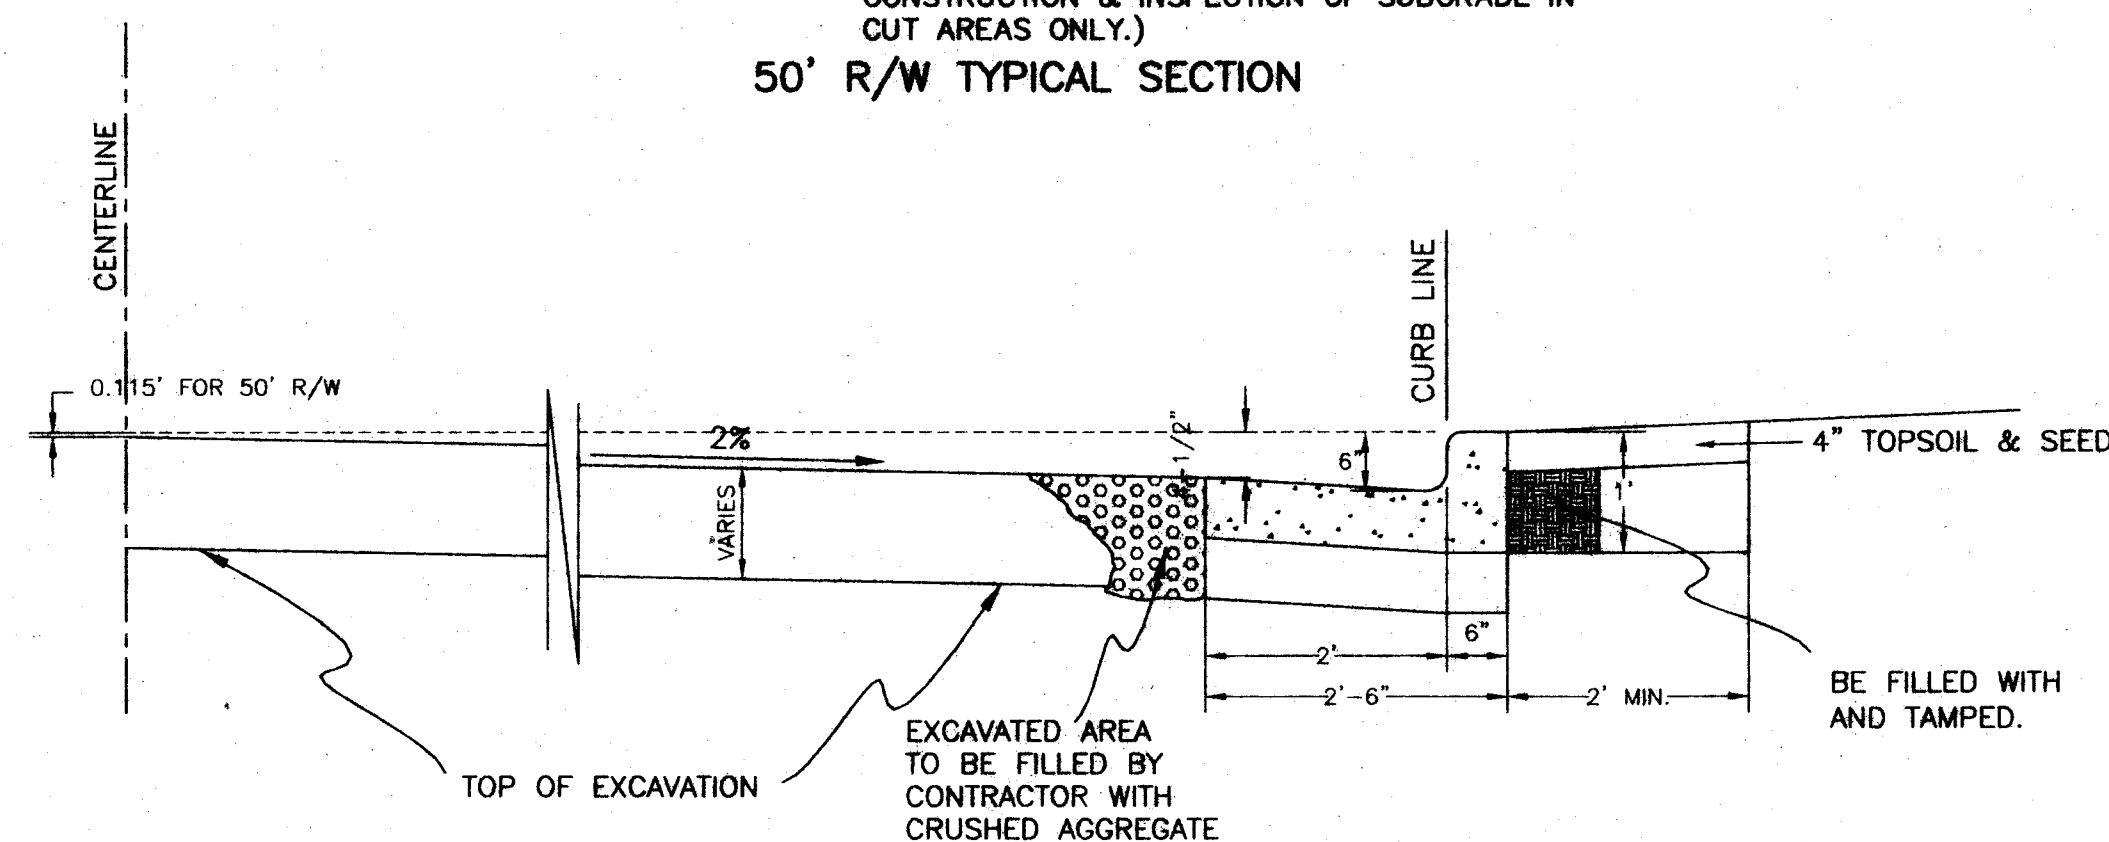

MASSILLON STANDARD CURB AND GUTTER DETAIL

NOTES

GRATE

FOR A "SINGLE" STRUCTURE, GRATE, FRAME AND BACK SHALL BE EAST JORDAN IRON WORKS CATALOG No. 7030 CURB INLET FRAME, GRATE AND BACK (OR EQUIVALENT). GRATE SHALL BE TYPE M2 AND BACK SHALL BE TYPE T1.

FOR A "DOUBLE" STRUCTURE, GRATE, FRAME AND BACK SHALL BE EAST JORDAN IRON WORKS CATALOG No. 7031 DOUBLE INLET FRAME, GRATE AND CURB BOX (OR EQUIVALENT). GRATE SHALL BE TYPE M2 AND BACK SHALL BE TYPE T1.

APPROVED EQUIVALENT

TYPE "A": NEENAH FOUNDRY CATALOG No. R-3246 CURB INLET FRAME, GRATE, CURB BOX. GRATE SHALL BE TYPE "C" AND CURB BOX SHALL HAVE A 2" RADIUS CURB FACE.
TYPE "A" DOUBLE: NEENAH FOUNDRY CATALOG No. R-3295-A DOUBLE UNIT INLET FRAME, GRATE AND CURB BOX. GRATE SHALL BE TYPE "C" AND CURB BOX SHALL HAVE A 2" RADIUS CURB FACE.

GRATES SHALL BE BICYCLE SAFE.

CASTINGS

THE DESIGN SHALL BE ESSENTIALLY THE SAME AND EQUALLY AS STRONG AS THE SPECIFIED CASTINGS. THE MINIMUM COMBINED WEIGHT OF THE FRAME, GRATE AND BACK SHALL BE 400 LBS.

BEARING AREAS

THE FRAME AND GRATE SHALL BE SO FITTED AND FINISHED AS TO PROVIDE A FIRM AND EVEN SEAT. NO PROJECTIONS SHALL EXIST ON BEARING AREAS OF EITHER CASTING AND THE GRATE SHALL SEAT WITHOUT ROCKING.

WALLS

WHEN USED IN PLACE OF CONCRETE, BRICK SIDE WALLS SHALL BE 8" NOMINAL THICKNESS WITH 1/2" INCH CEMENT MORTAR PLASTERED INSIDE AND OUT.

PRECAST CONSTRUCTION

CONCRETE SHALL MEET THE REQUIREMENTS OF CMS 706.13 WITH A MINIMUM OF 4% ENTRAINED AIR IN THE HARDENED CONCRETE. PRECAST WALLS SHALL HAVE A MINIMUM THICKNESS OF 8" AND REINFORCING SHALL BE SUFFICIENT TO PERMIT SHIPPING AND PLACEMENT WITHOUT DAMAGE.

OPENINGS



PIPE OPENINGS SHALL BE THE O.D. OF THE PIPE BEING SUPPLIED PLUS 2" WHEN FABRICATED OR FIELD CUT. THE INTERSTITIAL SPACE SHALL BE FILLED WITH GROUT PER CMS 601.

BLOCKOUT

PORTION BLOCKED OUT OF THE PAVEMENT SHALL BE PLACED AFTER THE CASTING HAS BEEN SET. PAYMENT SHALL BE INCLUDED AS PART OF THE ASPHALT PRICE.


PAYMENT

ALL MATERIALS AND LABOR, INCLUDING EXCAVATION AND BACKFILL, SHALL BE PAID FOR UNDER ITEM 604 - CATCH BASIN, TYPE "A" OR CATCH BASIN, TYPE "A" DOUBLE.

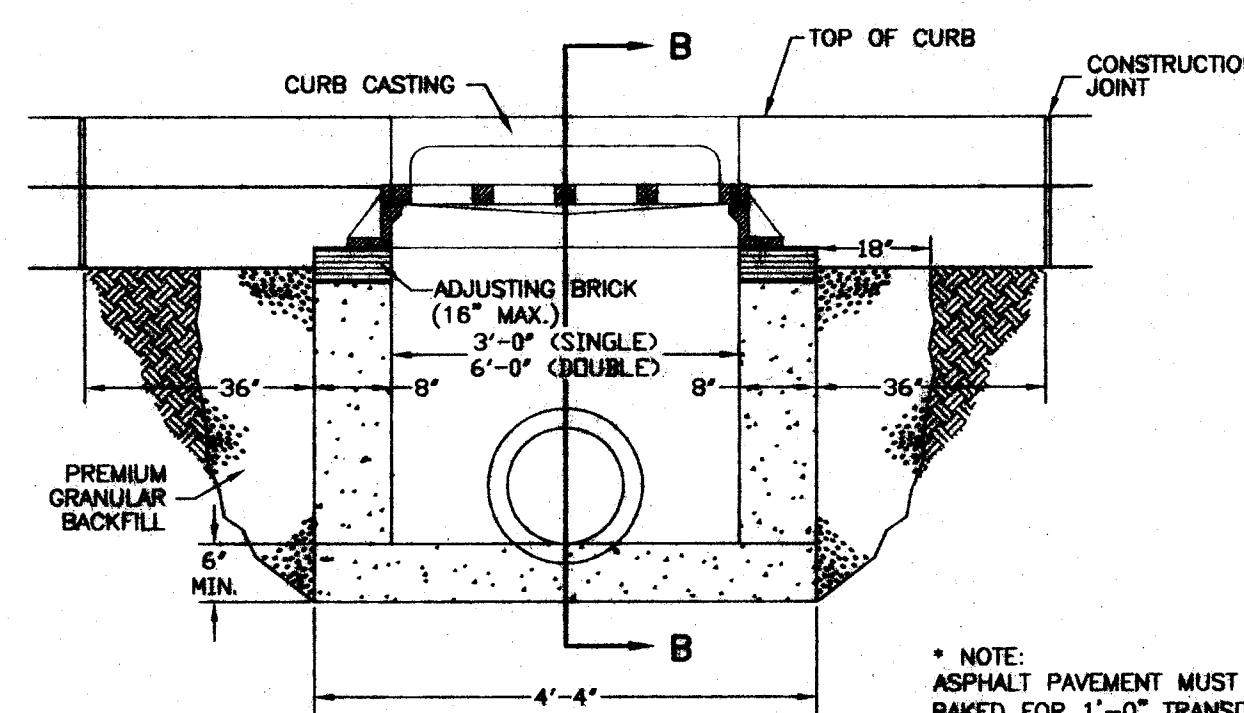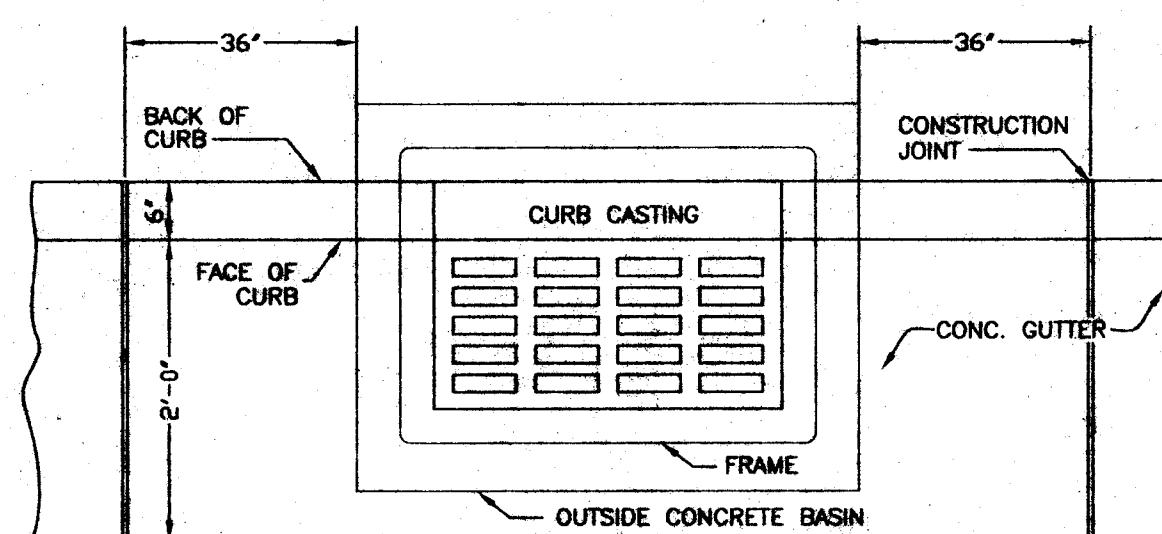

SECTION A-A

TYPE "A" CATCH BASIN

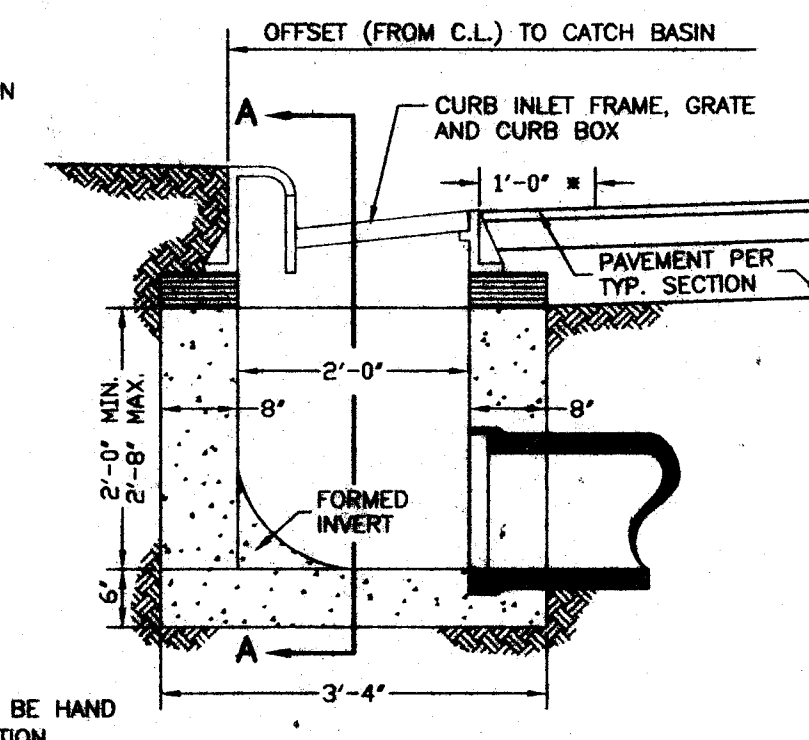


SECTION B-B

* NOTE: ASPHALT PAVEMENT MUST BE HAND RAKED FOR 1'-0" TRANSITION

ITEM	DESCRIPTION	UNIT	QTY
ROADWAY CONSTRUCTION			
203	ROADWAY EMBANKMENT	CY	1310
203	ROADWAY EXCAVATION	CY	2780
203	SITE EMBANKMENT (INCLUDING DETENTION BASIN)	CY	3680
203	SITE EXCAVATION (INCLUDING DETENTION BASIN)	CY	2226
203	SUBGRADE COMPACTION	SY	5577
203	INTERCEPTION SWALE, SEE SHEET 8	LUMP	1
203	TRENCHING FOR UTILITIES	LF	3008
301	4" BITUMINOUS AGGREGATE BASE (50' R/W)	CY	527
304	6" AGGREGATE BASE	CY	930
304	4" AGGREGATE BASE	CY	146
404	1.5" ASPHALT CONCRETE SURFACE COURSE	CY	196
408	BITUMINOUS PRIME COAT @ 0.4 GAL/SY	GAL	1939
604	STD COUNTY MONUMENTS	EA	4
608	CONCRETE SIDEWALKS (4' WIDE), BY LOT OWNER	SF	11951
608	CONCRETE CURB RAMPS, BY LOT OWNER	EA	4
609	CONCRETE CURB AND GUTTER (MASSILLON STD.)	LF	3008
659	SEEDING AND MULCHING	SY	1716
WATERLINE			
638	1" COPPER TYPE K SERVICE LINE W/CURB BOX COMPLETE	EA	31
638	12" DCIP (PC350 W/ POLYWRAP)	LF	1232
638	12" GATE VALVE W/BOX	EA	3
638	12" PLUG & MARKER	EA	1
638	12"x4" MJ TEE	EA	1
638	12" PLUG & BLOWOFF ASSY. REMOVED	EA	1
638	2" BLOWOFF ASSY COMPLETE	EA	1
638	2" HDPE TUBING W/ MARKING TAPE & TRACER WIRE	LF	213
638	4" DCIP (CL 52)	LF	123
638	4" GATE VALVE W/BOX	EA	1
638	4" PLUG W/ 2" TAP	EA	1
638	HYDRANT ASSEMBLY COMPLETE (TYPE 1)	EA	3
SANITARY SEWER			
603	8" SANITARY SEWER (EXCLUDING PIPE INSIDE MANHOLES)	LF	299
603	10" SANITARY SEWER (EXCLUDING PIPE INSIDE MANHOLES)	LF	1262
603	6" SERVICE SEWER	LF	1169
604	8" PLUG AND MARKER	EA	2
603	8"x8" Y-BRANCH OR T-BRANCH	EA	2
14	CONNECTION INTO EXISTING SEWER	EA	1
603	10"x8" Y-BRANCH OR T-BRANCH	EA	27
604	(6) MANHOLES - ODOT MH No.3	VF	51
STORM SEWER			
207	EROSION CONTROL PER SWP3	LUMP	1
603	12" STORM SEWER TYPE B	LF	506
603	12" STORM SEWER TYPE C	LF	30
603	16" STORM SEWER TYPE B	LF	967
603	18" STORM SEWER TYPE B	LF	227
603	24" STORM SEWER TYPE B	LF	10
603	24" STORM SEWER TYPE C	LF	150
603	8" STORM LATERALS AND FITTINGS	LF	715
603	ADJUST EXISTING CULVERTS PER SHEET 8, NOTE 7	LUMP	1
604	CATCH BASIN: ODOT 2-2B	EA	1
604	CATCH BASIN: TYPE A	EA	10
604	HEADWALL (ODOT HW-4B MOD FULL HT) - 12" PIPE	EA	2
604	HEADWALL (ODOT HW-4B MOD FULL HT) - 24" PIPE	EA	1
604	STORM MANHOLE: ODOT MH No.3	EA	2

ESTIMATED QUANTITIES NOTES

1.) ITEM NUMBERS SHOWN IN THE QUANTITY TABLE REFER TO SPECIFICATION ITEMS IN THE MOST RECENT EDITION OF THE STATE OF OHIO, DEPARTMENT OF TRANSPORTATION "CONSTRUCTION AND MATERIAL SPECIFICATIONS". THE CONTRACTOR SHALL BE RESPONSIBLE FOR PERFORMING THE PROPOSED WORK IN ACCORDANCE WITH THESE REFERENCED SPECIFICATIONS.

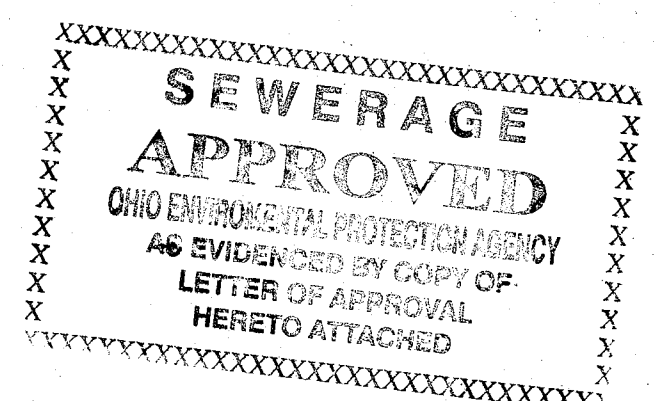

TYPICAL SECTIONS, QUANTITIES AND MISCELLANEOUS DETAILS

WESTBROOK ESTATES - WEST

FOR: JACOB GLICK

DRAWN BY: C.H.B.

CHECKED BY: B.D.B.

FIELD BOOK No. 549

DATE 3/4/02

SHEET 3 OF 8

PROJ. # 01142

TYPICAL SECTIONS, QUANTITIES AND MISCELLANEOUS DETAILS

H:\Land Projects R2\01142.dwg 05/02/2002 04:08:50 PM EDT

CITY OF MASSILLON GENERAL NOTES

- 1.) CONTRACTOR SHALL CHECK DETAIL DRAWINGS FOR MINIMUM GRADE AND BACKFILL REQUIREMENTS.
- 2.) ALL COMBINATION CONCRETE CURB AND GUTTER TO BE MASSILLON STANDARD EXCEPT WHERE VARIATIONS ARE TO BE EXTENDED OR MET - SEE SPECIFICATION BOOK AND PLANS.
- 3.) EXCAVATION FOR CONCRETE CURB AND GUTTER SHALL BE INCLUDED IN THE COST PER LINEAL FOOT OF SAID CURB AND GUTTER.
- 4.) ALL CATCH BASINS AND MANHOLES TO BE ADJUSTED TO GRADE WHERE NECESSARY.
- 5.) ALL CONCRETE TO BE 1:2: 4-6 BAG MIX. 28 DAY - 3000 PSI COMPRESSIVE STRENGTH: MAX. SLUMP TO BE 4".
- 6.) CONTRACTOR SHALL PAY CITY OF MASSILLON AT THE RATE OF TIME AND ONE-HALF OF REGULAR RATE AFTER 4:30 P.M. MONDAY THROUGH FRIDAY. SATURDAYS ALL DAY AT TIME AND ONE-HALF.
- 7.) ALL MATERIALS USED WILL BE NEW - NO SALVAGED MATERIAL WILL BE ACCEPTED EXCEPT CASINGS, AS APPROVED.
- 8.) IF CONTRACTOR EXCAVATES DEEPER THAN NECESSARY FOR CURB AND GUTTER, CONTRACTOR WILL FURNISH ODOT 304 AGGREGATE AND TAMP BEFORE CURB AND GUTTER IS CONSTRUCTED.
- 9.) IF SUBGRADE IS UNSUITABLE, CONTRACTOR WILL EXCAVATE AND REPLACE SUCH MATERIAL WITH CRUSHER RUN GRAVEL, AT THE DISCRETION OF THE INSPECTOR OR CITY ENGINEER. THIS FILL TO BE PLACED IN 6" LAYERS OR LESS. SAID FILL TO BE COMPACTED TO 95% LABORATORY DRY WEIGHT BEFORE ADDITIONAL LAYERS ARE ADDED. CONTRACTOR WILL BE PAID FOR EXTRA GRAVEL AND EXCAVATION. THIS COMPACTION TO BE DONE BEFORE FORMS ARE PLACED.
- 10.) ALL EXTRA PAY ITEMS WILL HAVE THE APPROVAL OF THE BOARD OF CONTROL BEFORE EXTRA ITEMS ARE INSTALLED.
- 11.) CONTRACTOR TO BACKFILL CURB IMMEDIATELY AFTER CURB HAS BEEN IN PLACE FOR 48 HOURS.
- 12.) CONTRACTOR WILL NOTIFY ENGINEER WHEN HE IS IN NEED OF CONSTRUCTION STAKES AND THIS OFFICE WILL COMPLY WITHIN A PERIOD OF 48 HOURS.
- 13.) ALL STORM SEWER PIPES WITHIN PAVEMENT LIMITS SHALL BE REINFORCED CONCRETE PIPE (ODOT 706.02) AND SHALL BE TYPE 'B' CONDUIT IN ACCORDANCE WITH ODOT 603 CLASS 'B' BEDDING AND GRANULAR BACKFILL. ALL STORM SEWER OUTSIDE PAVEMENT LIMITS SHALL BE SMOOTH LINED CORRUGATED POLYETHYLENE (ODOT 944) OR REINFORCED CONCRETE PIPE (ODOT 706.02) AND SHALL BE TYPE 'C' CONDUIT IN ACCORDANCE WITH ODOT 603 WITH CLASS 'C' BEDDING AND SUITABLE SOIL BACKFILL.
- 14.) DOWNSPOUT HEADERS SHALL BE 6" PVC (SDR 21) PIPE (UNLESS OTHERWISE NOTED ON THE PLANS) AND SHALL BE DIRECTLY CONNECTED TO THE STORM SEWER WITH APPROVED TEE OR SADDLE CONNECTIONS. HEADERS SHALL EXTEND 12' INTO THE LOTS OR BEYOND FURTHEST UTILITY, WHICHEVER IS GREATER.
- 15.) CONTRACTOR SHALL NOTIFY ALL UTILITY COMPANIES BEFORE ANY WORK IS BEGUN. THE CITY OF MASSILLON IS NOT RESPONSIBLE FOR ANY LOST TIME DUE TO UTILITY RELOCATION.
- 16.) MANHOLES AND CATCH BASINS SHALL BE CONSTRUCTED IN CONFORMANCE WITH MASSILLON CITY STANDARDS.
- 17.) CONTRACTOR SHALL CONTACT THE CITY OF MASSILLON ENGINEERING DEPARTMENT (GREG McCUE) AT (330)830-1722 AT LEAST 2 DAYS PRIOR TO THE INITIATION OF CONSTRUCTION TO SCHEDULE A PRE-CONSTRUCTION MEETING.
- 18.) STREET LIGHTING IS REQUIRED. DEVELOPER SHALL COORDINATE WITH ELECTRIC UTILITY COMPANY FOR POLE LOCATION AND TYPE. THE DEVELOPER SHALL INSTALL, AT HIS COST, STREET SIGNS REPRESENTING THE NAMES OF ALL STREETS AT ALL INTERSECTIONS. DEVELOPER ALSO RESPONSIBLE FOR STOP SIGNS AND DIRECTIONAL SIGNS AS NECESSARY. ALL SIGNS SHALL CONFORM WITH CITY OF MASSILLON REGULATIONS.
- 19.) WHEN SPECIFIED ON PLANS OR SPECIFICATIONS, CONTINGENCY ITEMS ARE TO BE PERFORMED ONLY UNDER THE DIRECTION OF THE CITY ENGINEER. THE CONTRACTOR SHALL NOT ORDER ANY CONTINGENCY MATERIAL OR PERFORM ANY WORK UNTIL DIRECTED BY THE ENGINEER. THE ACTUAL WORK LOCATION AND QUANTITIES FOR SUCH ITEMS SHALL BE DOCUMENTED BY THE CONTRACTOR AND THE ENGINEER. THE DEVELOPER IS RESPONSIBLE FOR THE COST OF SUCH ITEMS AND SHALL NOT BE PART OF THE BID DOCUMENT.
- 20a.) BEFORE ACCEPTANCE OF THE ROAD PAVEMENT SUBGRADES BY THE CITY OF MASSILLON ENGINEER, SUBGRADES SHALL BE TESTED IN ACCORDANCE WITH ODOT ITEM 203.13. IN LIEU OF SUBGRADE TESTING PER ITEM 203.13, PROOF ROLLING IN ACCORDANCE WITH ODOT ITEM 203.14 MAY BE SUBSTITUTED.
- 20b.) WHEREVER UNSTABLE SOIL SUBGRADE CONDITIONS ARE ENCOUNTERED THAT ARE UNSUITABLE PER ODOT 203 SPECIFICATIONS AND/OR DETERMINED BY THE CITY OF MASSILLON ENGINEERING DEPARTMENT, ADDITIONAL EXCAVATION AND SUBSEQUENT BACKFILLING SHALL BE DONE BY THE DEVELOPER'S CONTRACTOR AND PAID FOR BY THE DEVELOPER UNTIL SUCH CONDITIONS ARE CORRECTED AND APPROVED BY THE CITY OF MASSILLON ENGINEER.
- 20c.) SUBGRADE TESTING OR PROOF ROLLING MUST BE WITNESSED AND APPROVED BY THE CITY OF MASSILLON ENGINEERING DEPARTMENT PRIOR TO THE PLACEMENT OF THE PAVEMENT SUBBASE MATERIAL. CONTRACTOR SHALL CONTACT THE CITY ENGINEERING DEPARTMENT AT (330) 830-1722 TO SCHEDULE.

SANITARY SEWER NOTES


- 1.) SANITARY SEWERS AND APPURTENANCES SHALL BE CONSTRUCTED ACCORDING TO CITY OF MASSILLON ENGINEERING DEPARTMENT SPECIFICATIONS AND DETAILS IN EFFECT AT TIME OF CONSTRUCTION.
- 2.) ROOF DRAINS, FOUNDATION DRAINS AND OTHER CLEAN WATER CONNECTIONS TO THE SANITARY SEWER ARE PROHIBITED.
- 3.) THE CONTRACTOR SHALL NOTIFY ALL PROPERTY OWNERS ALONG THE ROUTE OF THE SANITARY SEWER AT LEAST THREE (3) DAYS PRIOR TO START OF CONSTRUCTION.
- 4.) THE CONTRACTOR SHALL ALERT THE UTILITIES PROTECTION SERVICE AT LEAST 48 HOURS PRIOR TO START OF CONSTRUCTION.
- 5.) THE CONTRACTOR SHALL BE RESPONSIBLE FOR PROPERLY MAINTAINING EXISTING SANITARY FLOW DURING THE CONSTRUCTION AND TESTING OF THE PROPOSED IMPROVEMENTS. THE CONTRACTOR'S METHODS FOR MAINTAINING FLOW MUST BE APPROVED BY THE CITY OF MASSILLON ENGINEERING DEPARTMENT AT THE PRE-CONSTRUCTION MEETING.
- 6.) ALL ROUGH GRADING TO WITHIN SIX (6) INCHES OF FINISHED GRADE SHALL BE COMPLETED WITHIN THE RIGHT-OF-WAY AND EASEMENTS PRIOR TO SANITARY SEWER CONSTRUCTION.
- 7.) BULKHEADS SHALL BE ERECTED IN EXISTING MANHOLES WHERE TAPS FOR NEW MAINLINE SEWERS ARE MADE AND SHALL REMAIN IN PLACE UNTIL THE NEW SEWERS ARE COMPLETE, TESTED AND APPROVED. IN CASES WHERE A BULKHEAD WOULD INTERRUPT THE FLOW FROM EXISTING SERVICE CONNECTIONS, THE BULKHEAD SHALL BE PLACED IN THE FIRST NEW MANHOLE UPSTREAM OF THE EXISTING MANHOLE.
- 8.) MINIMUM VERTICAL CLEARANCE BETWEEN SANITARY SEWER AND WATERLINE SHALL BE 18 INCHES. MINIMUM HORIZONTAL SEPARATION SHALL BE 10 FT.
- 9.) SANITARY SEWER SERVICE LATERALS SHALL BE 6-INCH DIAMETER AND BE LAID AT NO LESS THAN 1.0% GRADE.
- 10.) FOR NEW SUBDIVISION CONSTRUCTION, SEWER SERVICE LATERALS SHALL EXTEND 12' INTO THE LOTS OR BEYOND FURTHEST UTILITY, WHICHEVER IS GREATER, WHEN THE MAIN SEWER IS IN A STREET RIGHT-OF-WAY, AND SHALL TERMINATE AT THE EASEMENT LINE WHEN THE MAIN SEWER IS IN AN EASEMENT. FOR OTHER SEWER EXTENSIONS, SEWER SERVICE LATERALS SHALL TERMINATE AT THE RIGHT-OF -WAY LINE OR THE EASEMENT LINE, WHICHEVER IS APPLICABLE.
- 11.) SERVICE STACKS SHALL BE DUCTILE IRON PIPE REGARDLESS OF MAIN SEWER MATERIAL. A CAST IRON TEE SHALL BE INSTALLED IN THE MAIN SEWER. CONCRETE ENCASEMENT WILL NOT BE REQUIRED.
- 12.) MINIMUM COVER OVER SANITARY SEWER SHALL BE 4 FT.
- 13.) ACCEPTABLE SANITARY SEWER PIPE MATERIALS ARE AS FOLLOWS:

MATERIAL DESCRIPTION	SPECIFICATIONS		
	PIPE	JOINT	INSTALLATION
PVC SMOOTH EXTERIOR	ASTM D-3034	ASTM D-3212	ASTM D-2321
PVC:			
CLOSED PROFILE (DUAL WALL)	ASTM F-794	ASTM D-3212	ASTM D-2321
CORRUGATED (DUAL WALL)			
RIBBED (OPEN PROFILE)			
PVC CORRUGATED EXTERIOR	ASTM F-949	ASTM D-3212	ASTM D-2321
VCP EXTRA STRENGTH	ASTM C-700	ASTM C-425	ASTM C-12
DCIP (CLASS 52)	AWWA C-151	AWWA C-110/C-111	AWWA C-151
ABS COMPOSITE	ASTM D-2680	ASTM D-2235	ASTM D-2680
PVC COMPOSITE	ASTM D-2680	ASTM D-2584	ASTM D-2680

- 14.) ALL SANITARY SEWERS, 8-INCH DIAMETER AND LARGER, MUST PASS AN INTERNAL TELEVISION INSPECTION. THE CONTRACTOR SHALL PROVIDE COMPLETE INTERNAL INSPECTION VIDEOTAPE TO THE CITY OF MASSILLON ENGINEERING DEPARTMENT. THE VIDEOTAPING PROCEDURE SHALL BE IN ACCORDANCE WITH CITY OF MASSILLON ENGINEERING DEPARTMENT SPECIFICATIONS.
- 15.) A DEFLECTION TEST SHALL BE REQUIRED FOR ALL FLEXIBLE PIPE OF 8-INCH DIAMETER AND LARGER. THE TEST SHALL BE CONDUCTED AT LEAST 30 DAYS AFTER COMPLETION OF BACKFILL AND SHALL BE IN ACCORDANCE WITH CITY OF MASSILLON ENGINEERING DEPARTMENT SPECIFICATIONS. THE ALLOWABLE DEFLECTION RATE SHALL NOT EXCEED FIVE (5%) PERCENT. TESTING SHALL BE IN ACCORDANCE WITH ASTM D-3034.
- 16.) ALL SANITARY SEWERS MUST PASS A LOW PRESSURE AIR TEST, WHICH SHALL BE CONDUCTED IN ACCORDANCE WITH ASTM F-1417 (PLASTIC PIPE) OR ASTM C-828 (CLAY PIPE). THE MAXIMUM ALLOWABLE TEST LEAKAGE SHALL BE 100 GAL/INCH OF DIAMETER/MILE/DAY.
- 17.) MANHOLE CONSTRUCTION SHALL MEET THE REQUIREMENTS OF ASTM C-478 AND C-443. ALL MANHOLES SHALL BE AIR/VACUUM TESTED IN ACCORDANCE WITH AND MEET ALL THE REQUIREMENTS OF ASTM C-1244.
- 18.) CONNECTIONS TO EXISTING MANHOLES SHALL BE CORE DRILLED, WITH BENCHES AND CHANNELS FORMED AND REPAIRED AS NECESSARY.
- 19.) ANY MANHOLE DROP ATTACHMENTS SHALL BE "OUTSIDE" TYPE.
- 20.) MANHOLE TOP OF CASTING ELEVATIONS MAY REQUIRE ADJUSTMENT DURING SITE GRADING. MANHOLE COVERS MAY NOT BE BURIED. UPON COMPLETION OF CONSTRUCTION AND RESTORATION, ALL MANHOLES, PROPOSED AND EXISTING, SHALL BE IN CONFORMANCE IN ALL RESPECTS WITH CITY OF MASSILLON ENGINEERING DEPARTMENT SPECIFICATIONS AND DETAILS.
- 21.) ALL SANITARY SEWER TRENCHES BENEATH PROPOSED OR EXISTING PAVEMENT SHALL BE COMPACTED IN LIFTS, IN A MANNER, AND WITH MATERIAL AS SPECIFIED BY THE CITY OF MASSILLON ENGINEERING DEPARTMENT AND ALL APPLICABLE O.D.O.T. SPECIFICATIONS.


WATERLINE NOTES

- 1.) THE WATER LINE SHALL BE INSTALLED SO THAT 4'-0" OF COVER, FROM GRADE TO THE TOP OF THE WATER LINE, IS MAINTAINED AS A MINIMUM.
- 2.) WATER LINE MATERIALS AND INSTALLATION PROCEDURES SHALL MEET OR EXCEED ALL APPLICABLE A.W.W.A. STANDARDS INCLUDING BUT NOT LIMITED TO C600 AND C651.
- 3.) THE CONTRACTOR SHALL CAREFULLY LAYOUT THE WATER LINE AND ALL RELATED FACILITIES TO INSURE THAT THEY ARE LOCATED WITHIN THE PUBLIC RIGHT-OF-WAY AND/OR DESIGNATED UTILITY EASEMENTS AS INDICATED.
- 4.) MEGALUG RETAINERS REQUIRED AT ALL FITTINGS.
- 5.) THE PROPOSED FACILITIES WILL MAINTAIN A MINIMUM PRESSURE OF 35 P.S.I. DELIVERED TO THE CURB STOP DURING NORMAL OPERATING CONDITIONS.
- 6.) BOOSTER PUMPS ARE NOT PERMITTED ON SERVICE CONNECTIONS. C.O.W.C. MAY GRANT SPECIAL PERMISSION FOR BUILDINGS SIX STORIES AND HIGHER.
- 7.) A TYPE 1 TRENCH SHALL BE USED AND BACKFILLED WITH EXCAVATED MATERIAL PROVIDED THAT SAID MATERIAL CONSISTS OF LOAM, CLAY, SAND, GRAVEL, OR OTHER SUITABLE MATERIAL. BACKFILLING FOR ROAD AND DRIVEWAY CUTS SHALL BE AS A MINIMUM PROPERLY COMPACTED O.D.O.T. 304 AGGREGATE OR AS SPECIFIED BY THE LOCAL JURISDICTION.
- 8.) WATER SERVICES SHALL EXTEND 12' INTO THE LOTS OR BEYOND FURTHEST UTILITY, WHICHEVER IS GREATER, WITH THE CURB BOX INSTALLED 0.50' WITHIN THE RIGHT-OF-WAY.
- 9.) CONTRACTOR MUST CONSTRUCT ALL WATER LINES AND WATER SERVICE LINES SUCH THAT A MINIMUM OF 10' HORIZONTAL CLEARANCE, 18" VERTICAL CLEARANCE ABOVE SANITARY SEWER AND A MINIMUM OF 12" VERTICAL CLEARANCE BELOW STORM SEWER IS MAINTAINED.

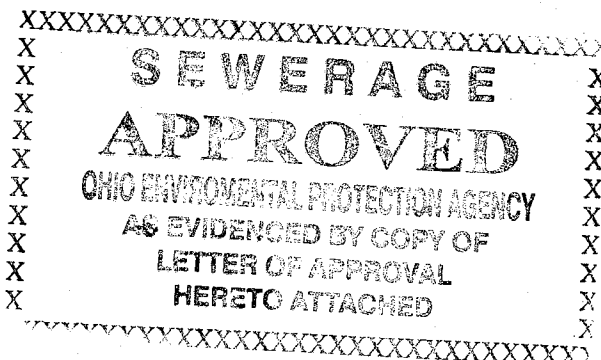

REVISIONS

1	A	
2	A	
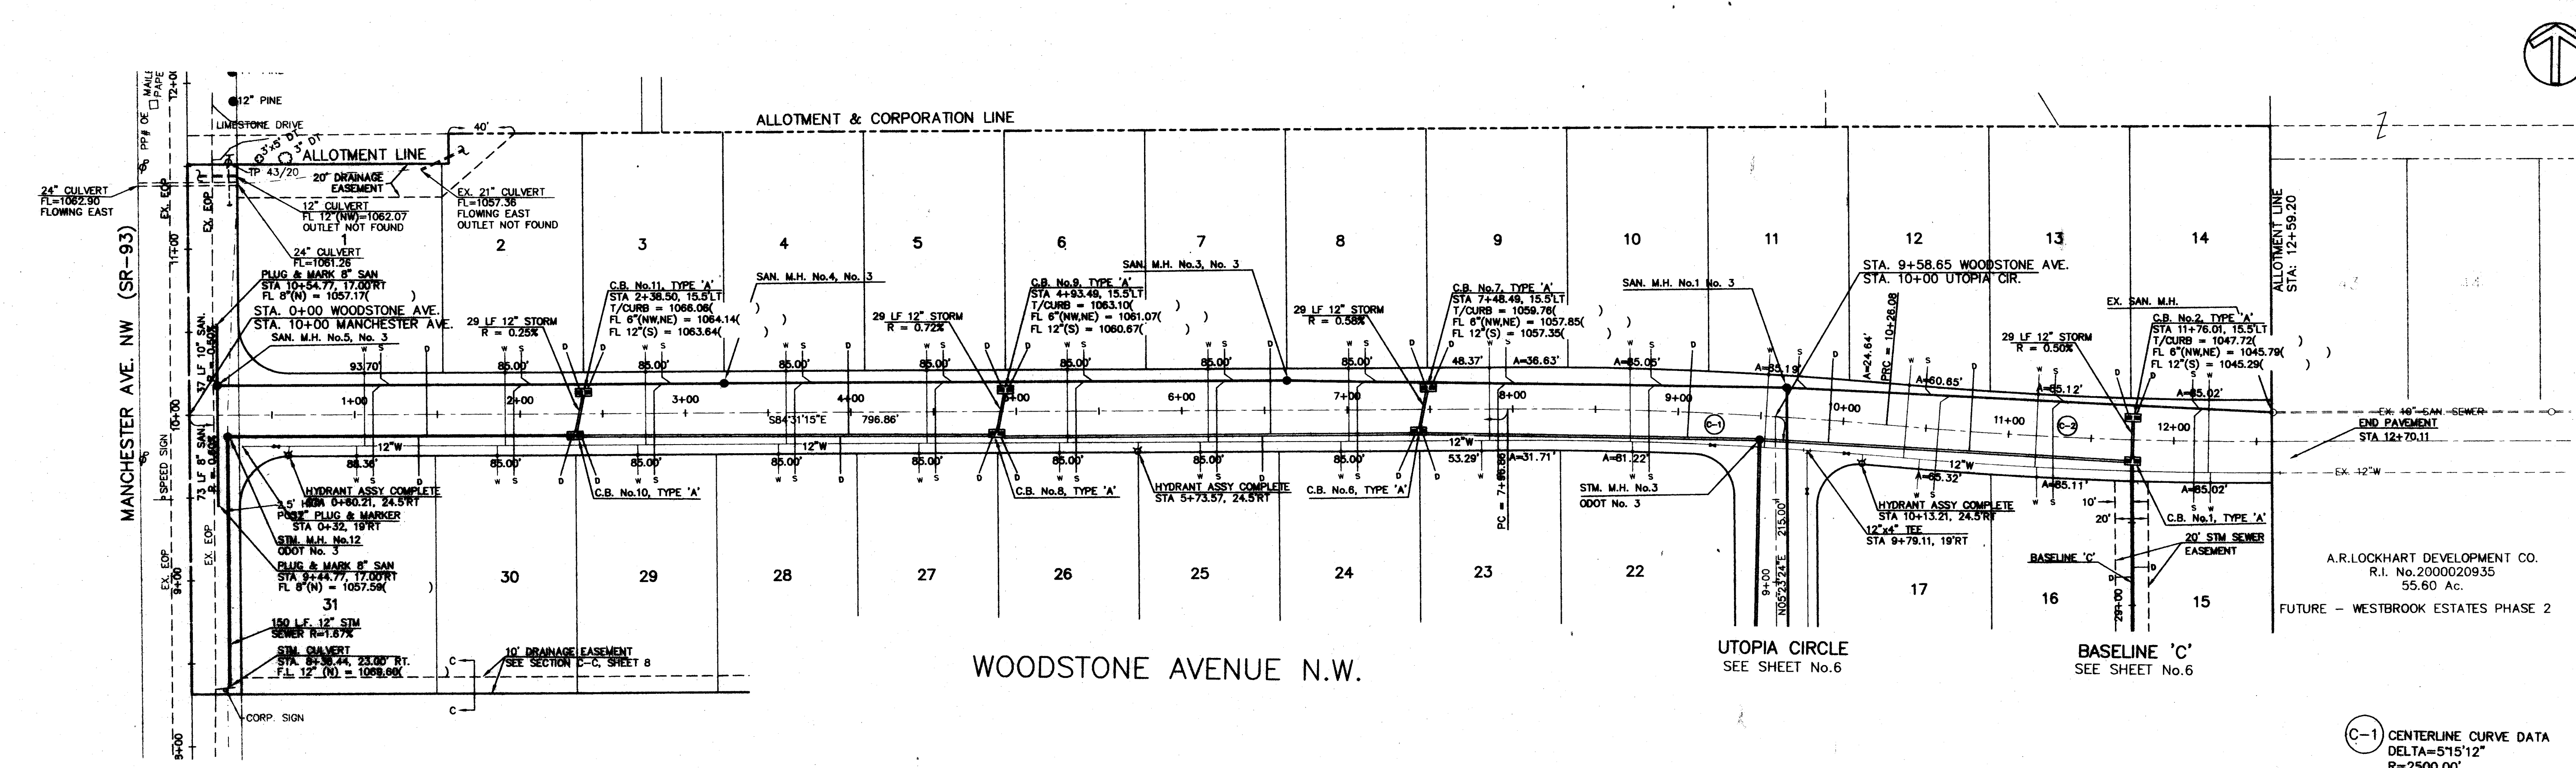


BENCHMARK 'A'
COTTON GIN GEAR SPIKE SET 12" UP THE EAST SIDE OF POWER POLE (NO NUMBER) - 2nd POLE NORTH OF THE NORTH PROPERTY LINE OF BEECH GROVE ELEM. SCHOOL LOC. ON THE WEST SIDE OF MANCHESTER AVE. (SR 93).
ELEV. = 1068.66

BENCHMARK 'B'
COTTON GIN SPIKE SET IN NORTHERN ROOT OF A 24" OAK TREE NEAR OR ON THE NORTH PROPERTY LINE OF BEECH GROVE ELEM. SCHOOL - 90' +/- NORTH OF THE NE CORNER OF THE SCHOOL BUILDING.
ELEV. = 1069.97

- NOTES:**
1. SIDEWALKS NOT REPRESENTED ON PLAN FOR CLARITY. SEE INTERSECTION DETAILS (SHEET 7) FOR HANDICAP RAMPS.
 2. CONTRACTOR MUST CONSTRUCT ALL WATER LINES AND WATER SERVICE LINES SUCH THAT A MINIMUM OF 10' HORIZONTAL CLEARANCE, 18" VERTICAL CLEARANCE ABOVE SANITARY SEWER AND A MINIMUM OF 12" CLEARANCE BELOW STORM SEWER IS MAINTAINED.

- C-1** CENTERLINE CURVE DATA
DELTA=51°5'12"
R=2500.00'
L=229.22'
T=114.69'
C=229.14'
CB=N81°53'39"W
- C-2** CENTERLINE CURVE DATA
DELTA=5°20'34"
R=2500.00'
L=233.12'
T=116.64'
C=233.03'
CB=S81°56'20"E

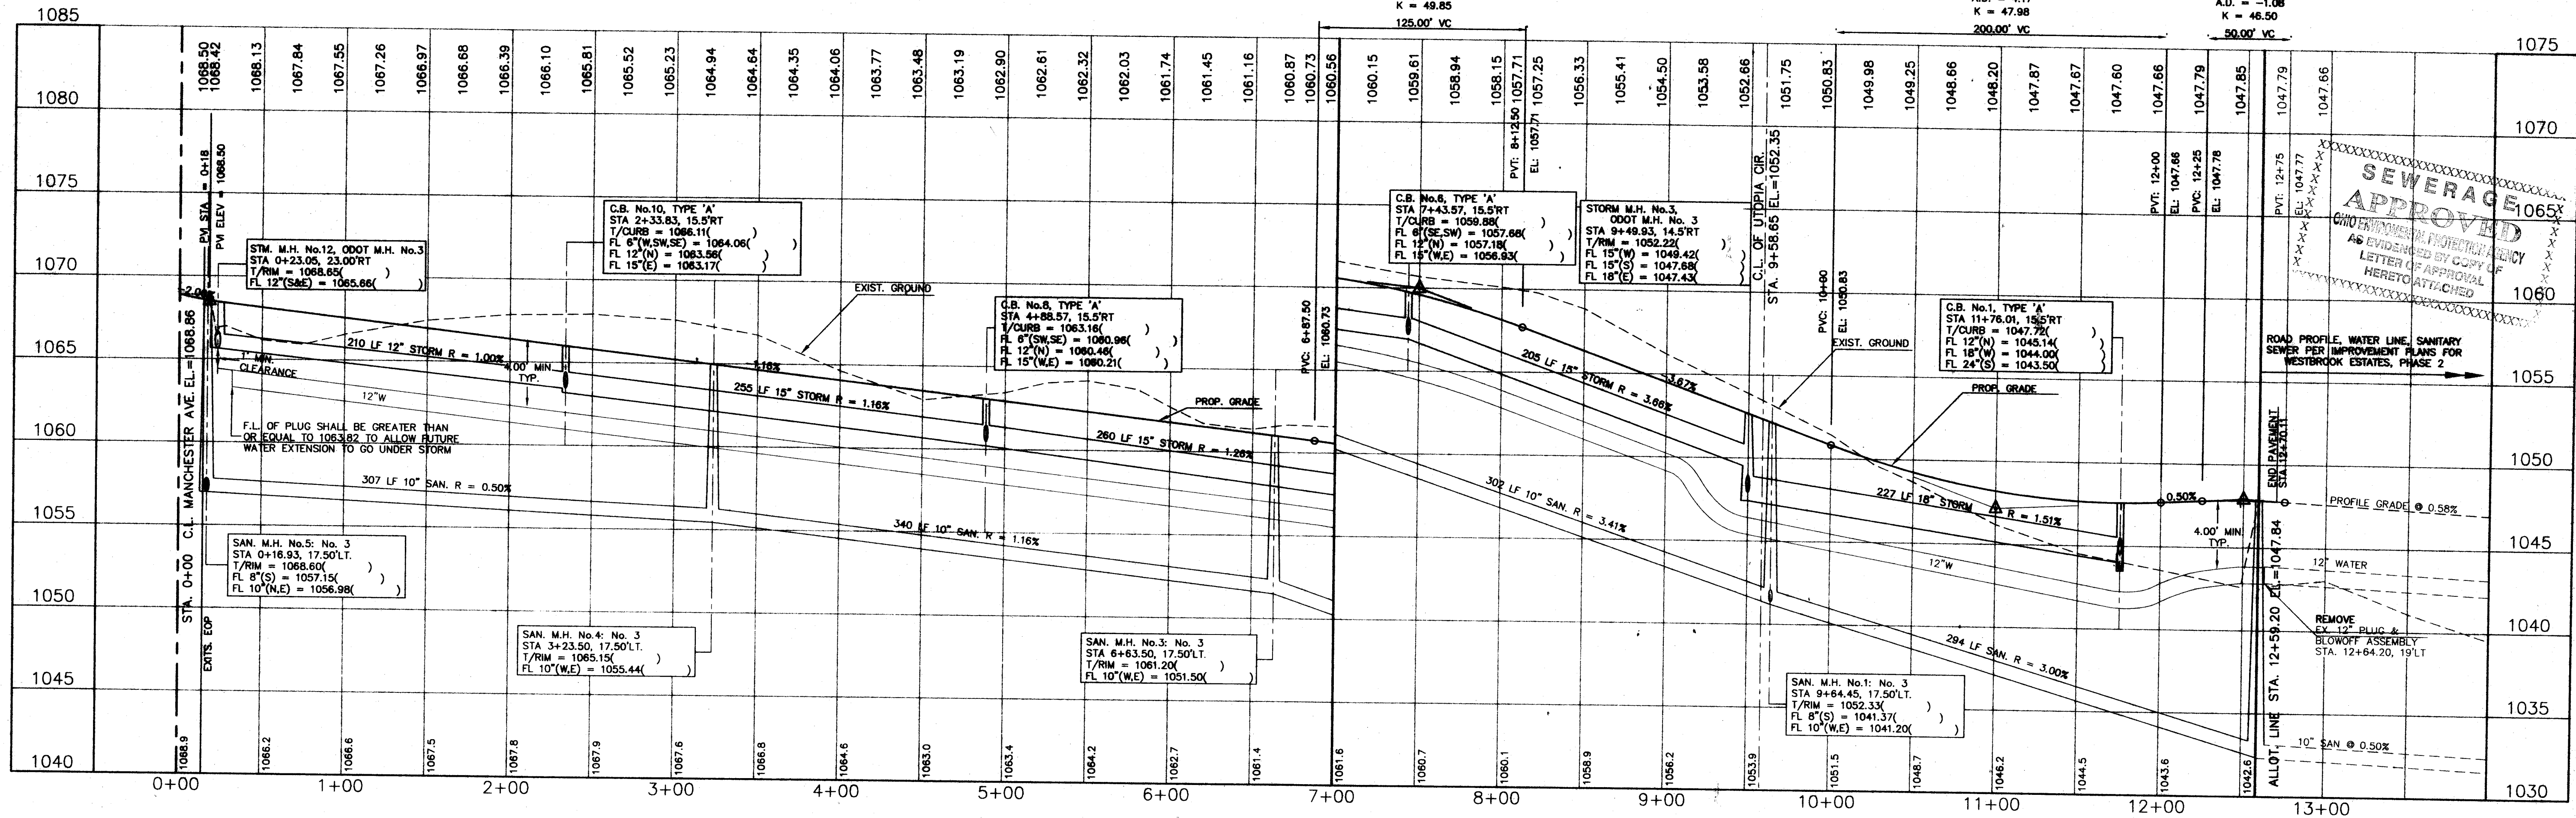

SEWERAGE APPROVED
AS EVIDENCED BY COPY OF LETTER OF APPROVAL HERETO ATTACHED


COOPER & ASSOCIATES, LLP
ENGINEERS AND SURVEYORS
1389 MARKET AVENUE, NORTH CANTON, OHIO 44714
PHONE (330) 462-5731
FAX (330) 462-9110

FOR: JACOB GLICK

WESTBROOK ESTATES - WEST

PLAN AND PROFILE SHEET

DRAWN BY: C.H.B.
CHECKED BY: B.D.B.
FIELD BOOK No. 549
DATE 3/1/02
SHEET 5 OF 8
PROJ. #: 01142

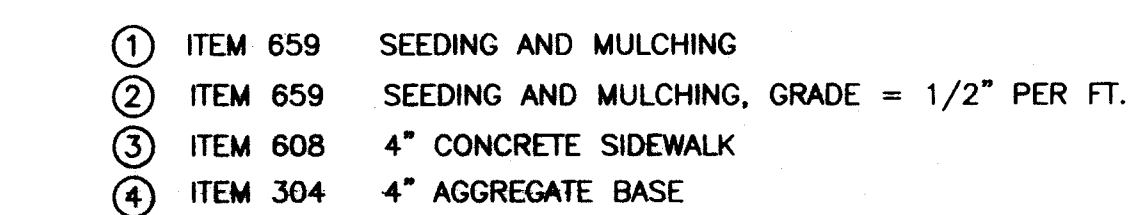


10



INTERSECTION DETAILS

DRAWN BY: C.H.B.
CHECKED BY: B.D.B.
FIELD BOOK No. 549
DATE 3/4/02
SHEET
7 OF 8
PROJ.# 01142

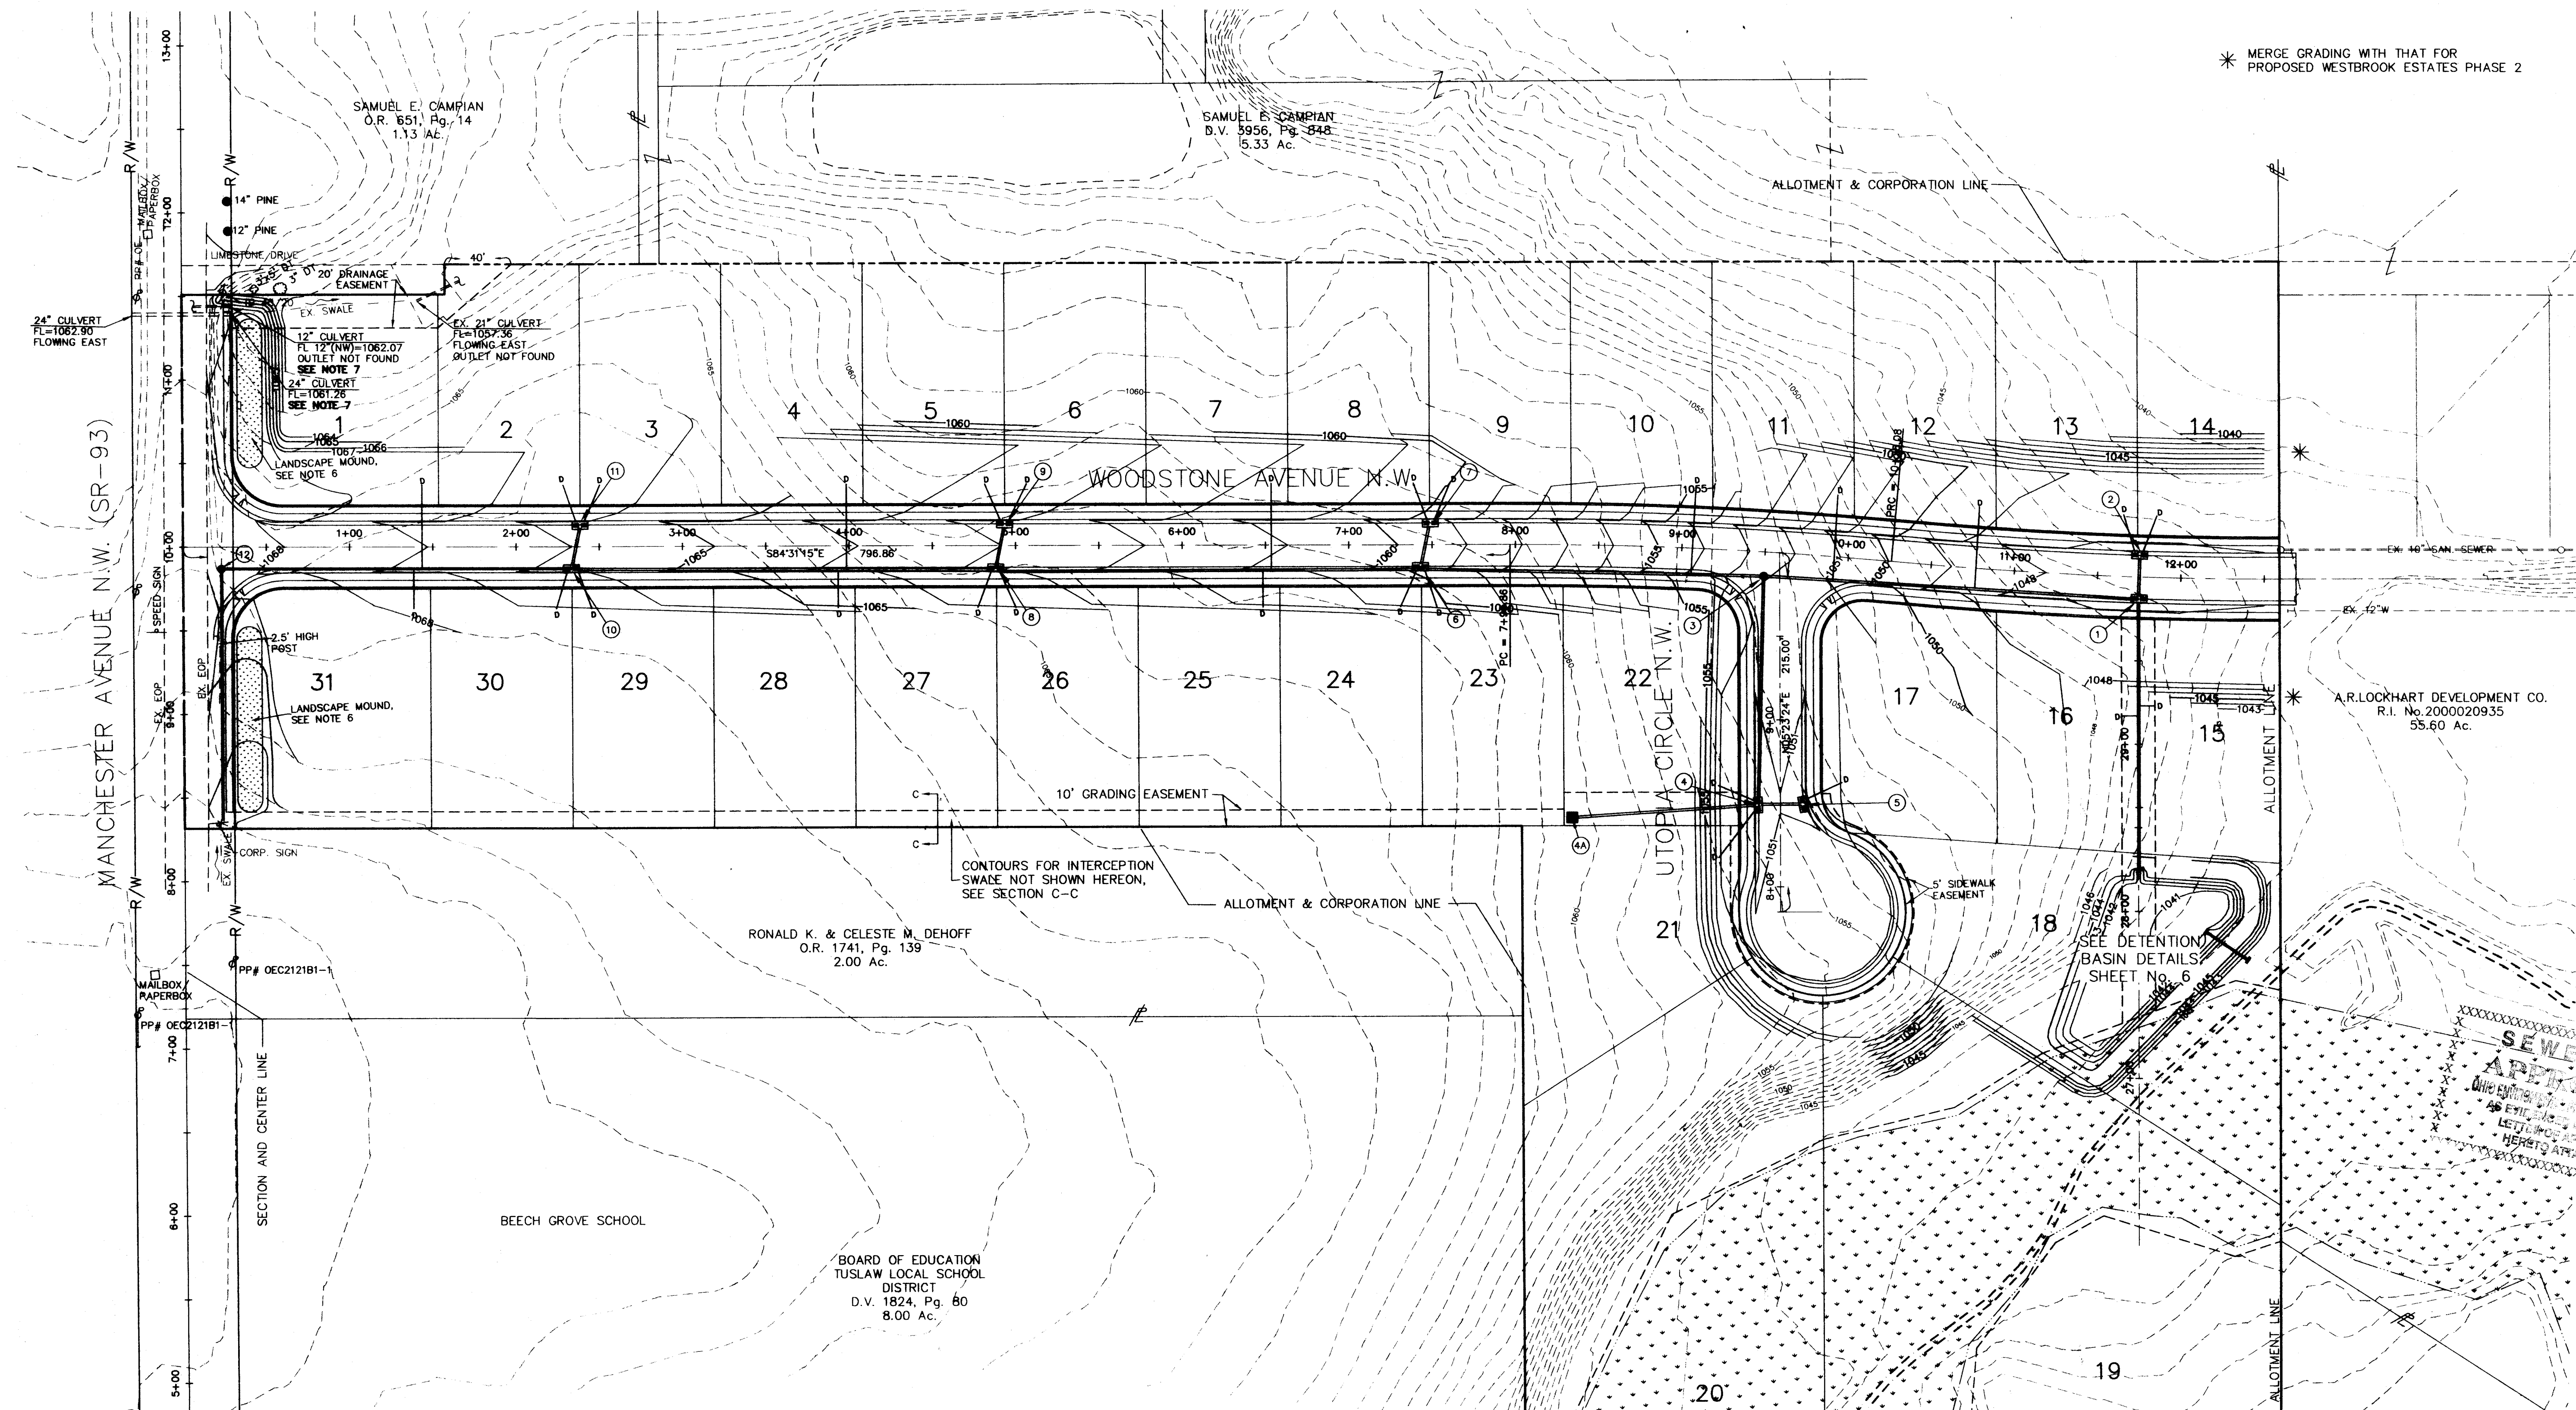

GENERAL NOTES:

- ALL WORK SHALL BE DONE IN ACCORDANCE WITH THE APPLICABLE CODES, ORDINANCES, AND STANDARD SPECIFICATIONS OF CITY OF MASSILLON AND THE STARK COUNTY ENGINEERING DEPARTMENT. IN LIEU OF ANY LOCAL SPECIFICATIONS, WORK SHALL BE PERFORMED IN CONFORMANCE WITH THE STATE OF OHIO DEPARTMENT OF TRANSPORTATION CONSTRUCTION AND MATERIAL SPECIFICATIONS MOST RECENT EDITION.
- IT SHALL BE THE CONTRACTOR'S SOLE RESPONSIBILITY TO CONSTRUCT THE GRADING REPRESENTED ON THIS PLAN USING CONSTRUCTION MEANS AND METHODS THAT WILL PREVENT BODILY INJURY AND/OR DEATH. THE CONTRACTOR SHALL TAKE ANY NECESSARY SAFETY PRECAUTIONS TO COMPLY WITH THE SAFETY REQUIREMENTS OF THE CITY, STATE AND FEDERAL GOVERNMENTS.
- EMBANKMENT CONSTRUCTION AND SUBGRADE COMPACTION SHALL BE IN GENERAL CONFORMANCE WITH ODOT SPECIFICATIONS AND SHALL BE 95% STANDARD PROCTOR FOR GENERAL SITE GRADING.
- CONTOURS REPRESENTED ON THIS PLAN ARE TO THE PROPOSED FINISHED GRADE (PG):
 - PAVEMENT SUBGRADE = PG - 11.5" (PAVEMENT)
 - SITE SUBGRADE = PG - 3" (TOPSOIL)
- SEE THE STORM WATER POLLUTION PREVENTION PLANS FOR EROSION CONTROL MEASURES.
- TO THE EAST OF MANCHESTER AVE., CONTRACTOR SHALL CREATE A LANDSCAPE MOUND (USING EXCESS TOPSOIL) PER OWNERS DIRECTION.
- LOCATED AT THE N.W. CORNER OF THIS ALLOTMENT, EXTEND THE EXISTING 12" AND 24" CULVERT 35 L.F. KEEPING THE EXISTING RATE AND ALIGNMENT.

EARTHWORK SUMMARY


CUT = 5,000 C.Y.
FILL = 5,000 C.Y.

THE EARTHWORK SUMMARY IS TAKEN FROM EXISTING GROUND TO PROPOSED FINISHED GRADE.

BENCHMARK 'A'
COTTON GIN GEAR SPIKE SET 12" UP THE EAST SIDE OF POWER POLE (NO NUMBER) - 2nd POLE NORTH OF THE NORTH PROPERTY LINE OF BEECH GROVE ELEM. SCHOOL LOC. ON THE WEST SIDE OF MANCHESTER AVE. (SR 93).
ELEV. = 1068.66

BENCHMARK 'B'
COTTON GIN SPIKE SET IN NORTHERN ROOT OF 'A' 24" OAK TREE NEAR OR ON THE NORTH PROPERTY LINE OF BEECH GROVE ELEM. SCHOOL - 90' +/- NORTH OF THE NE CORNER OF THE SCHOOL BUILDING.
ELEV. = 1069.97

NOTE: THE DITCH SHALL HAVE A MINIMUM SLOPE OF 1.00%.

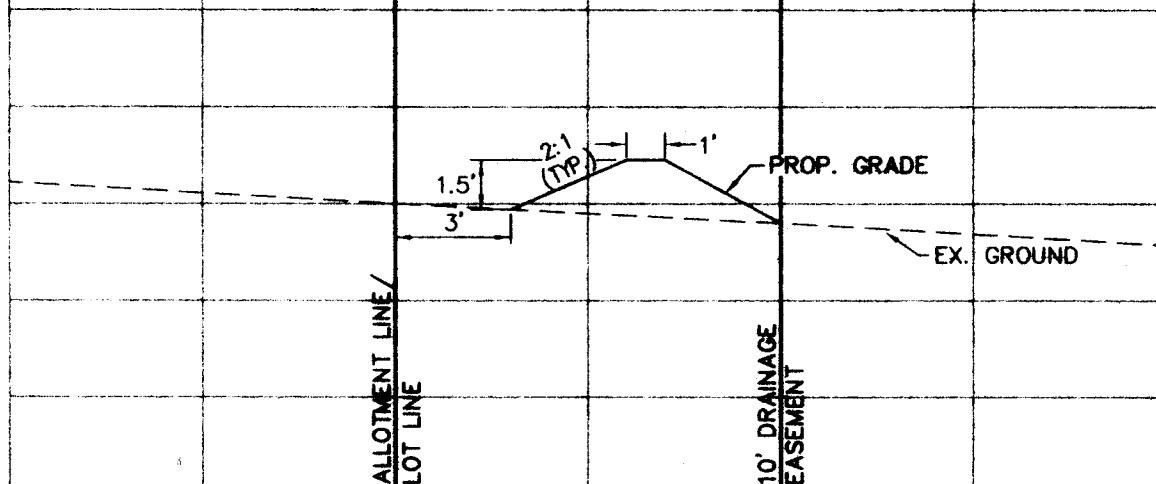

SECTION C-C
INTERCEPTION SWALE
SCALE: N.T.S.

* MERGE GRADING WITH THAT FOR PROPOSED WESTBROOK ESTATES PHASE 2

REVISIONS

1

2

