SITUATED IN THE CITY OF MASSILLON, COUNTY OF STARK, STATE OF OHIO AND BEING ORIGINAL OUTLOT 303.

PROPOSED 14 LOTS

PROJECT APPROVALS
SUBDIVISION IMPROVEMENT PLANS APPROVED BY THE CITY OF MASSILLON ENGINEER THIS DAY OF, 2007.
CITY OF MASSILLON ENGINEER
SANITARY SEWER IMPROVEMENT PLANS APPROVED BY THE CITY OF MASSILLON ENGINEER
THIS DAY OF, 2007.
CITY OF MASSILLON ENGINEER
WATER LINE PLANS APPROVED BY AQUA OHIO, INC. THIS DAY OF, 2007. SUBJECT TO AGREEMENT WITH AQUA OHIO, INC.
AQUA OHIO, INC.
SANITARY SEWER PERMIT-TO-INSTALL HAS BEEN RECEIVED FROM THE OHIO EPA THIS DAY OF, 2007.
WATER LINE PERMIT-TO-INSTALL HAS BEEN RECEIVED FROM THE OHIO EPA THIS DAY OF, 2007.

SANITARY EFFLUENT FROM THIS PROJECT DISCHARGES TO CITY OF MASSILLON.

UTILITY OWNERSHIP

THE LOCATION OF THE UNDERGROUND UTILITIES SHOWN ON THE PLANS ARE AS OBTAINED FROM THE OWNERS OF THE UTILITY AS REQUIRED BY SECTION 153.64 O.R.C.

WATER: AQUA OHIO

870 THIRD STEET NW MASSILLON, OHIO 44647 (330) 832-7600

NUMBER OF LOTS = 14 AREA = 5.1166 ACRES

TOTAL LF OF ROADWAY = 672 LF TOTAL LF PUBLIC SANITARY = 788 LF TOTAL LF PUBLIC STORM = 898 LF 7) TOTAL LF PUBLIC WATER = 835 LF

1910 W MARKET BLDG #1 AKRON, OHIO 44313 (330) 384-4839

10th FLOOR

ELECTRIC: OHIO EDISON

TELEPHONE: AT&T

DOMINION EAST OHIO 1201 EAST 55th STREET

CLEVELAND, OHIO 44103

(216) 736 - 6675

SANITARY: CITY OF MASSILLON


151 LINCOLN WAY EAST MASSILLON, OHIO (330) 830-1722

MASSILLON CABLE TV 814 CABLE CT NW MASSILLON, OHIO 44648 (330) 833-4134

229 WEST 7th STREET


AKRON, OHIO 44308

(330) 384-2237

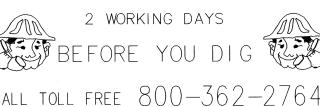

CALL TOLL FREE 800-362-2764 OHIO UTILITIES PROTECTION SERVICE

ONLY APPROVED SIGNED PLANS BY THE CITY ENGINEER ARE TO BE USED FOR CONSTRUCTION

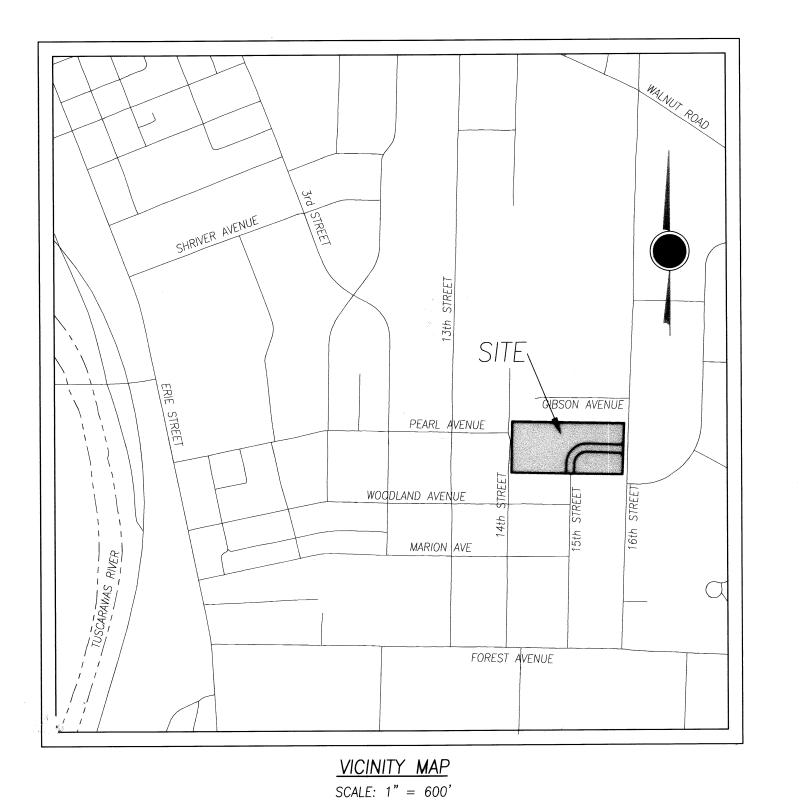

SITE BENCHMARKS:

GIN GEAR IN ASPH PVMT; NW CORNER OF WOODLAND AND 14th ST ELEVATION 1034.93

TOP %" I. PIN MONUMENT; CENTERLINE 15th ST AND SOUTH R/W MARION ELEVATION: 1043.47

INDEX OF SHEETS

TITLE SHEET	. 1
CONSTRUCTION NOTES	2
CONSTRUCTION NOTES	3
STORM WATER POLLUTION PREVENTION PLAN	4
DETENTION BASIN PLAN	5
DETENTION BASIN DETAILS	6
STORM WATER POLLUTION PREVENTION DETAILS	7
TOPOGRAPHIC SURVEY AND DEMOLITION PLAN	8
GRADING PLAN	9
N15 PLAN	10
OVERALL PAVEMENT & UTILITY PLAN	11
PLAN AND PROFILES:	
15th STREET	12
BALLINGER AVENUE; PEARL AVENUE	13
14th STREET	
INTERSECTION DETAILS	15
STANDARD SEWER DETAILS	16
STANDARD WATERMAIN DETAILS	17
TYPICAL SECTIONS & PAVEMENT DETAILS	18
CROSS SECTIONS 15TH STREET & BALLINGER AVENUE	19
CROSS SECTIONS BALLINGER AVENUE & 14TH STREET	20
QUANTITIES	
PAVEMENT 472.83 LF (15TH STREET & BALLINGER AVENUE)	
PAVEMENT 375.79 LF (14TH STREET)	
PAVEMENT 318 LF (16TH STREET)	

PLANS PREPARED BY: M. NEFF DESIGN GROUP

8" SANITARY 664 LF

8" WATER 800 LF 24" STORM 148 LF

18" STORM 428 LF 15" STORM 180 LF

12" STORM 318 LF


PROFESSIONAL SURVEYOR #7315

9.04.08

ASBUILTS 08.26.08

DEVELOPER: MASSILLON HOMES II, LLC 5309 TRANSPORTATION BLVD CLEVELAND, OHIO 44125 MARY HADA (216) 475-9300

ENGINEER: M NEFF DESIGN GROUP 5422 EAST 96TH STREET, SUITE 120 CLEVELAND, OHIO 44125 MATTHEW NEFF, P.E., P.S. (216) 663-8820

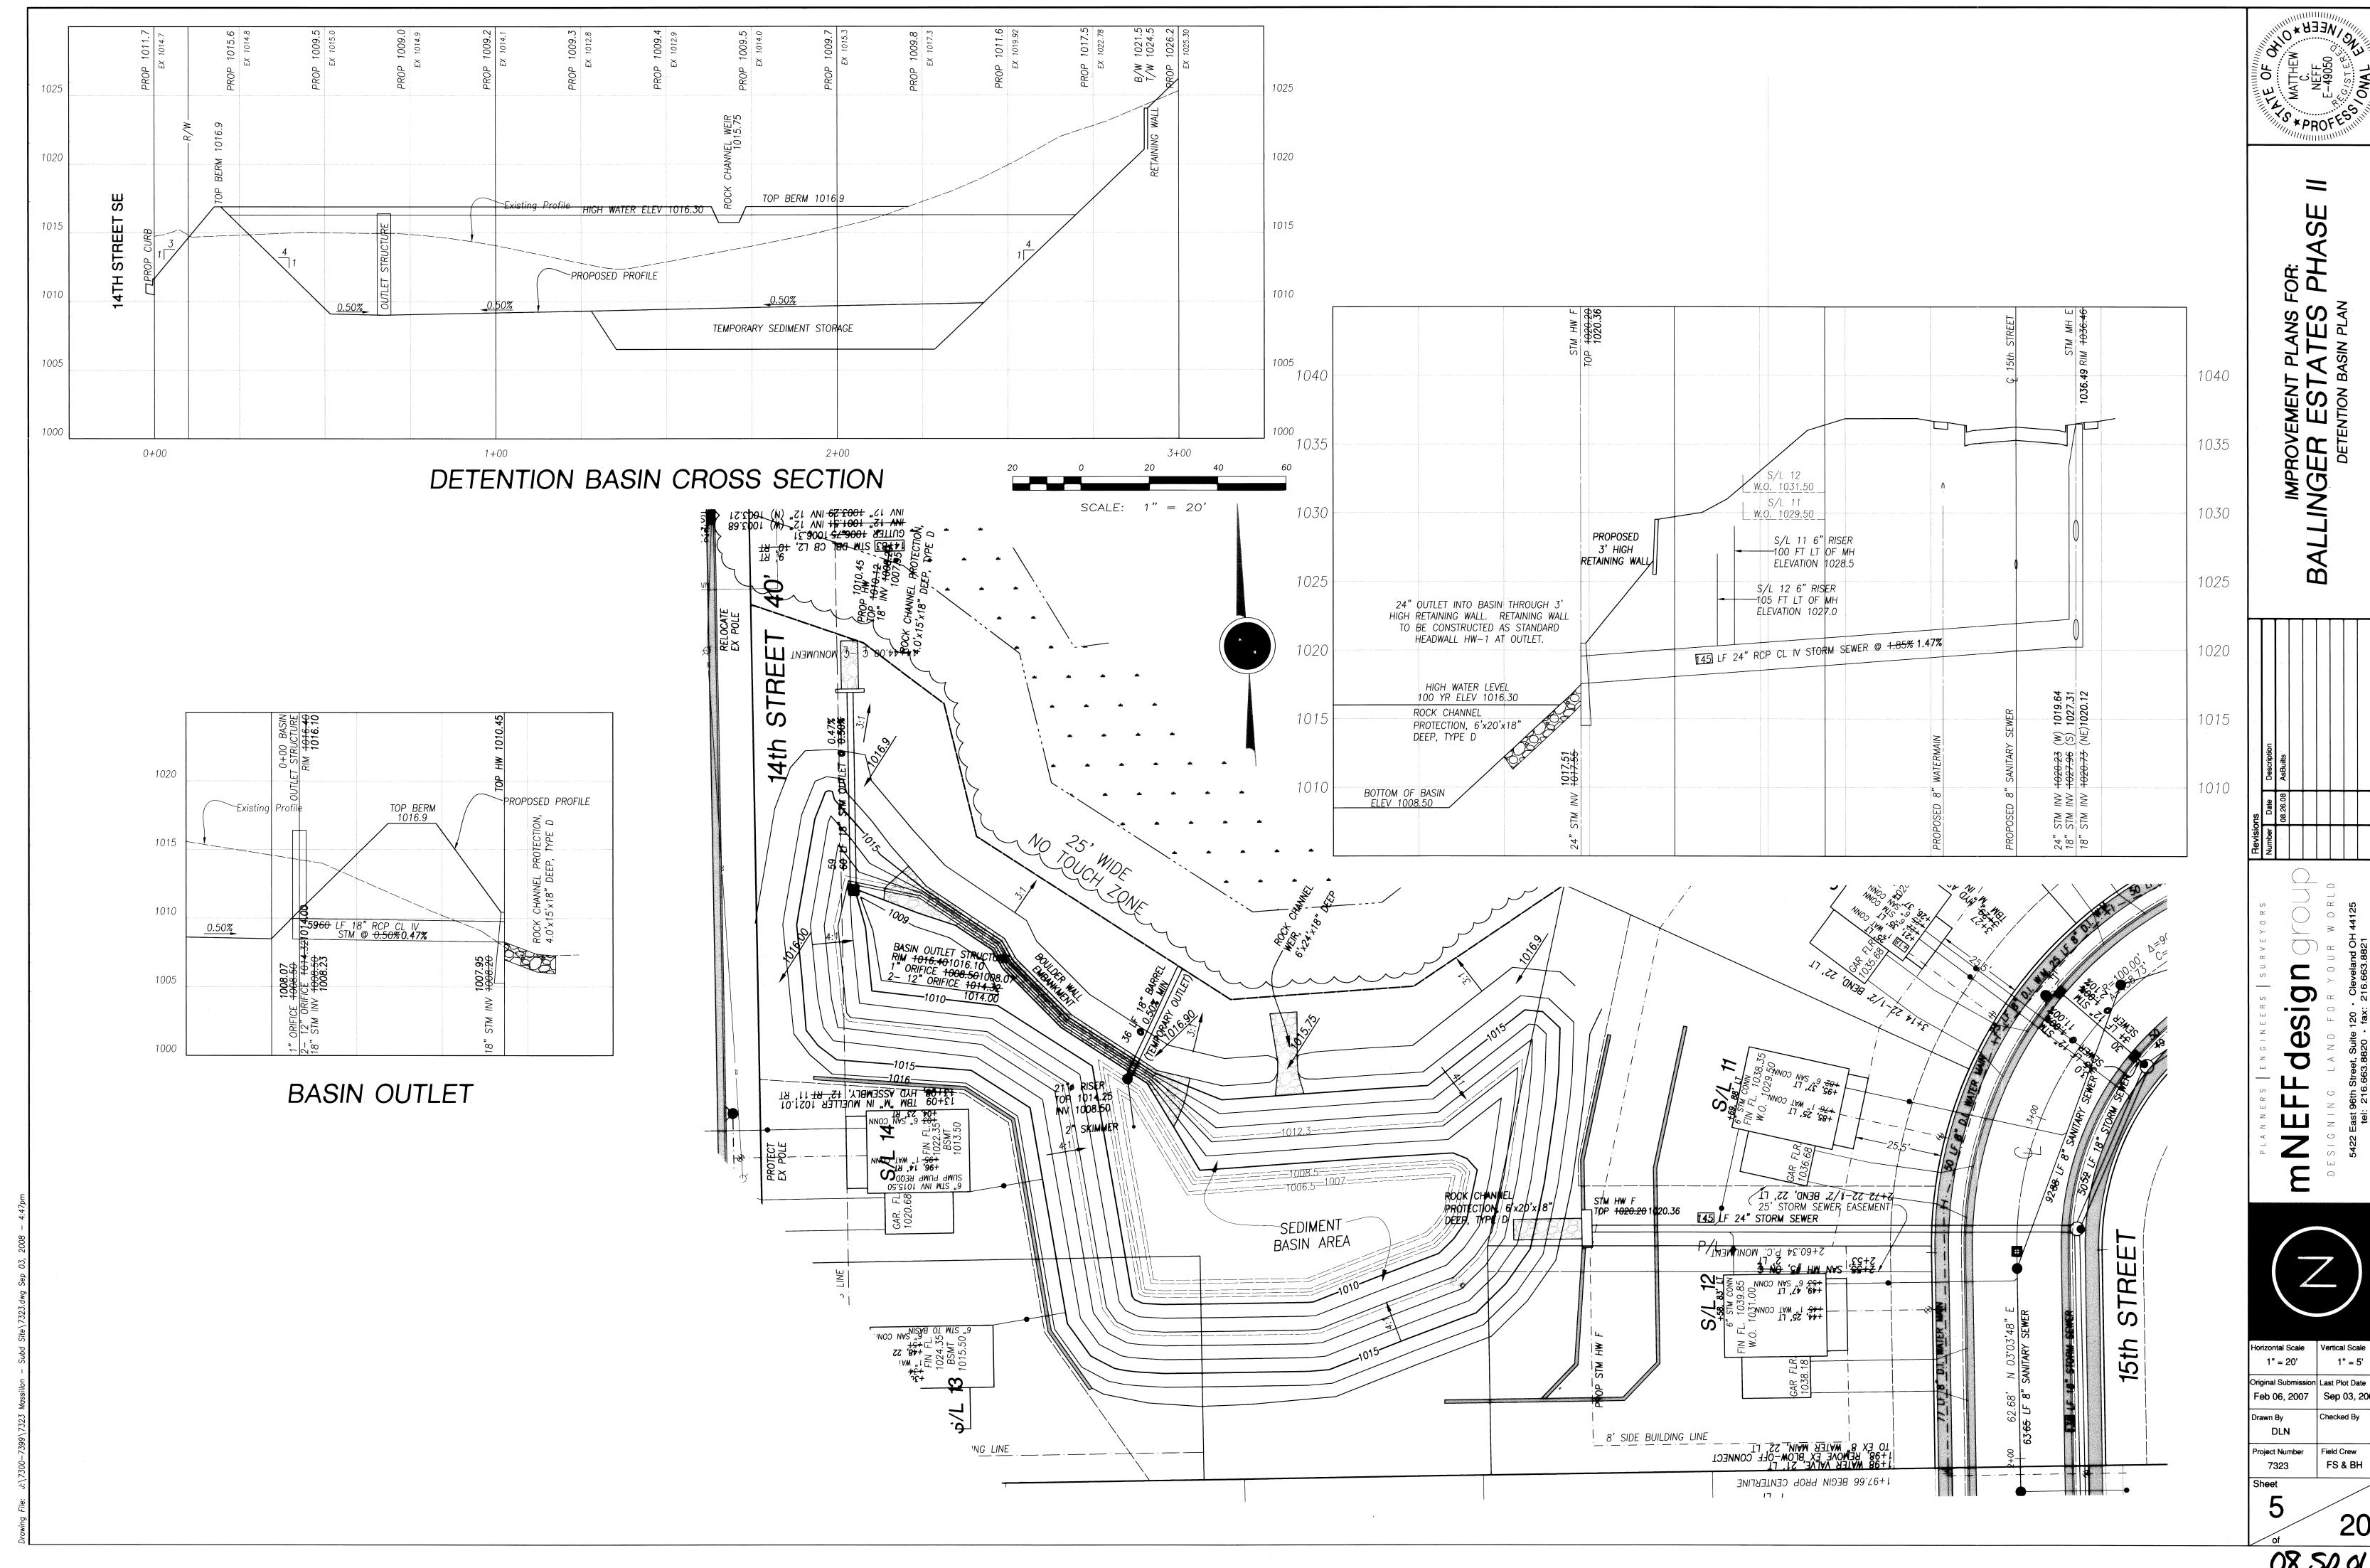


08 50 01


1" = 5'

Checked By


FS & BH

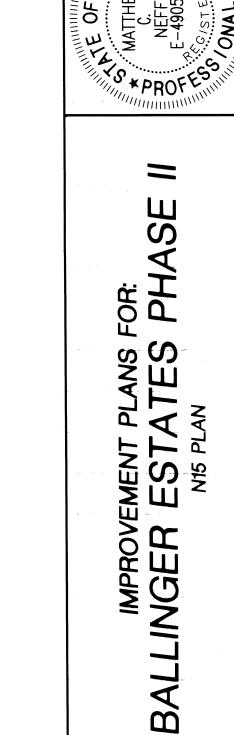

NEER*

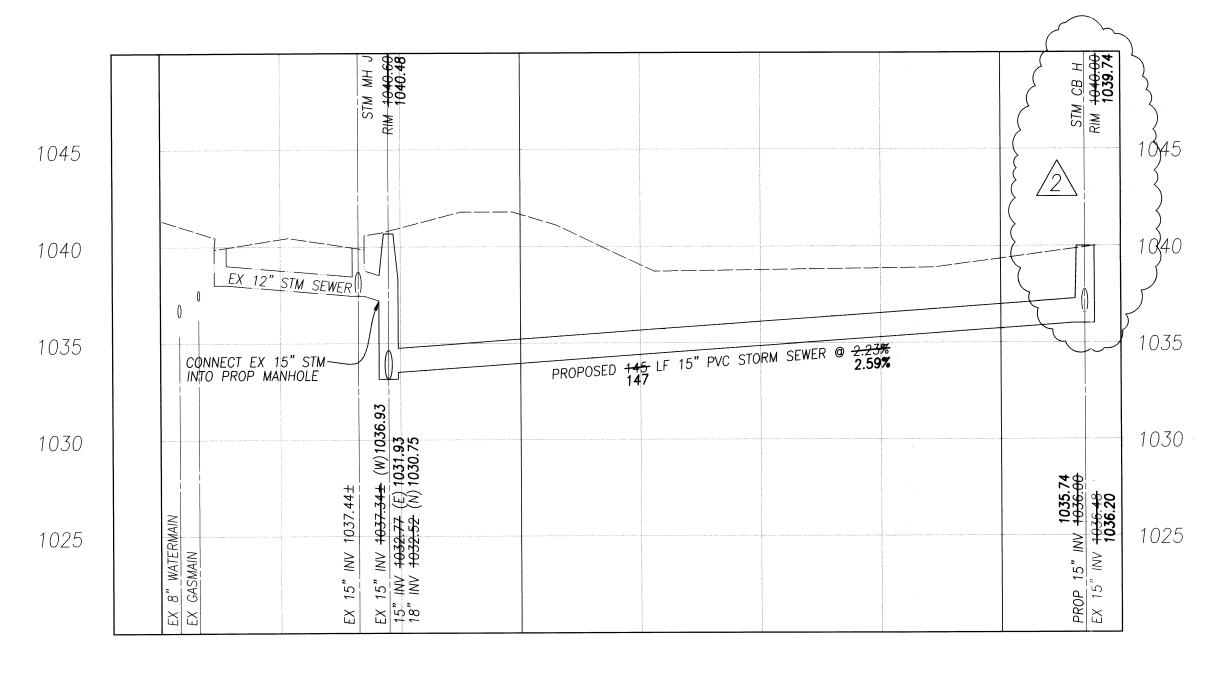

N15 STORM SEWER PROFILE SCALE: 1" = 20'

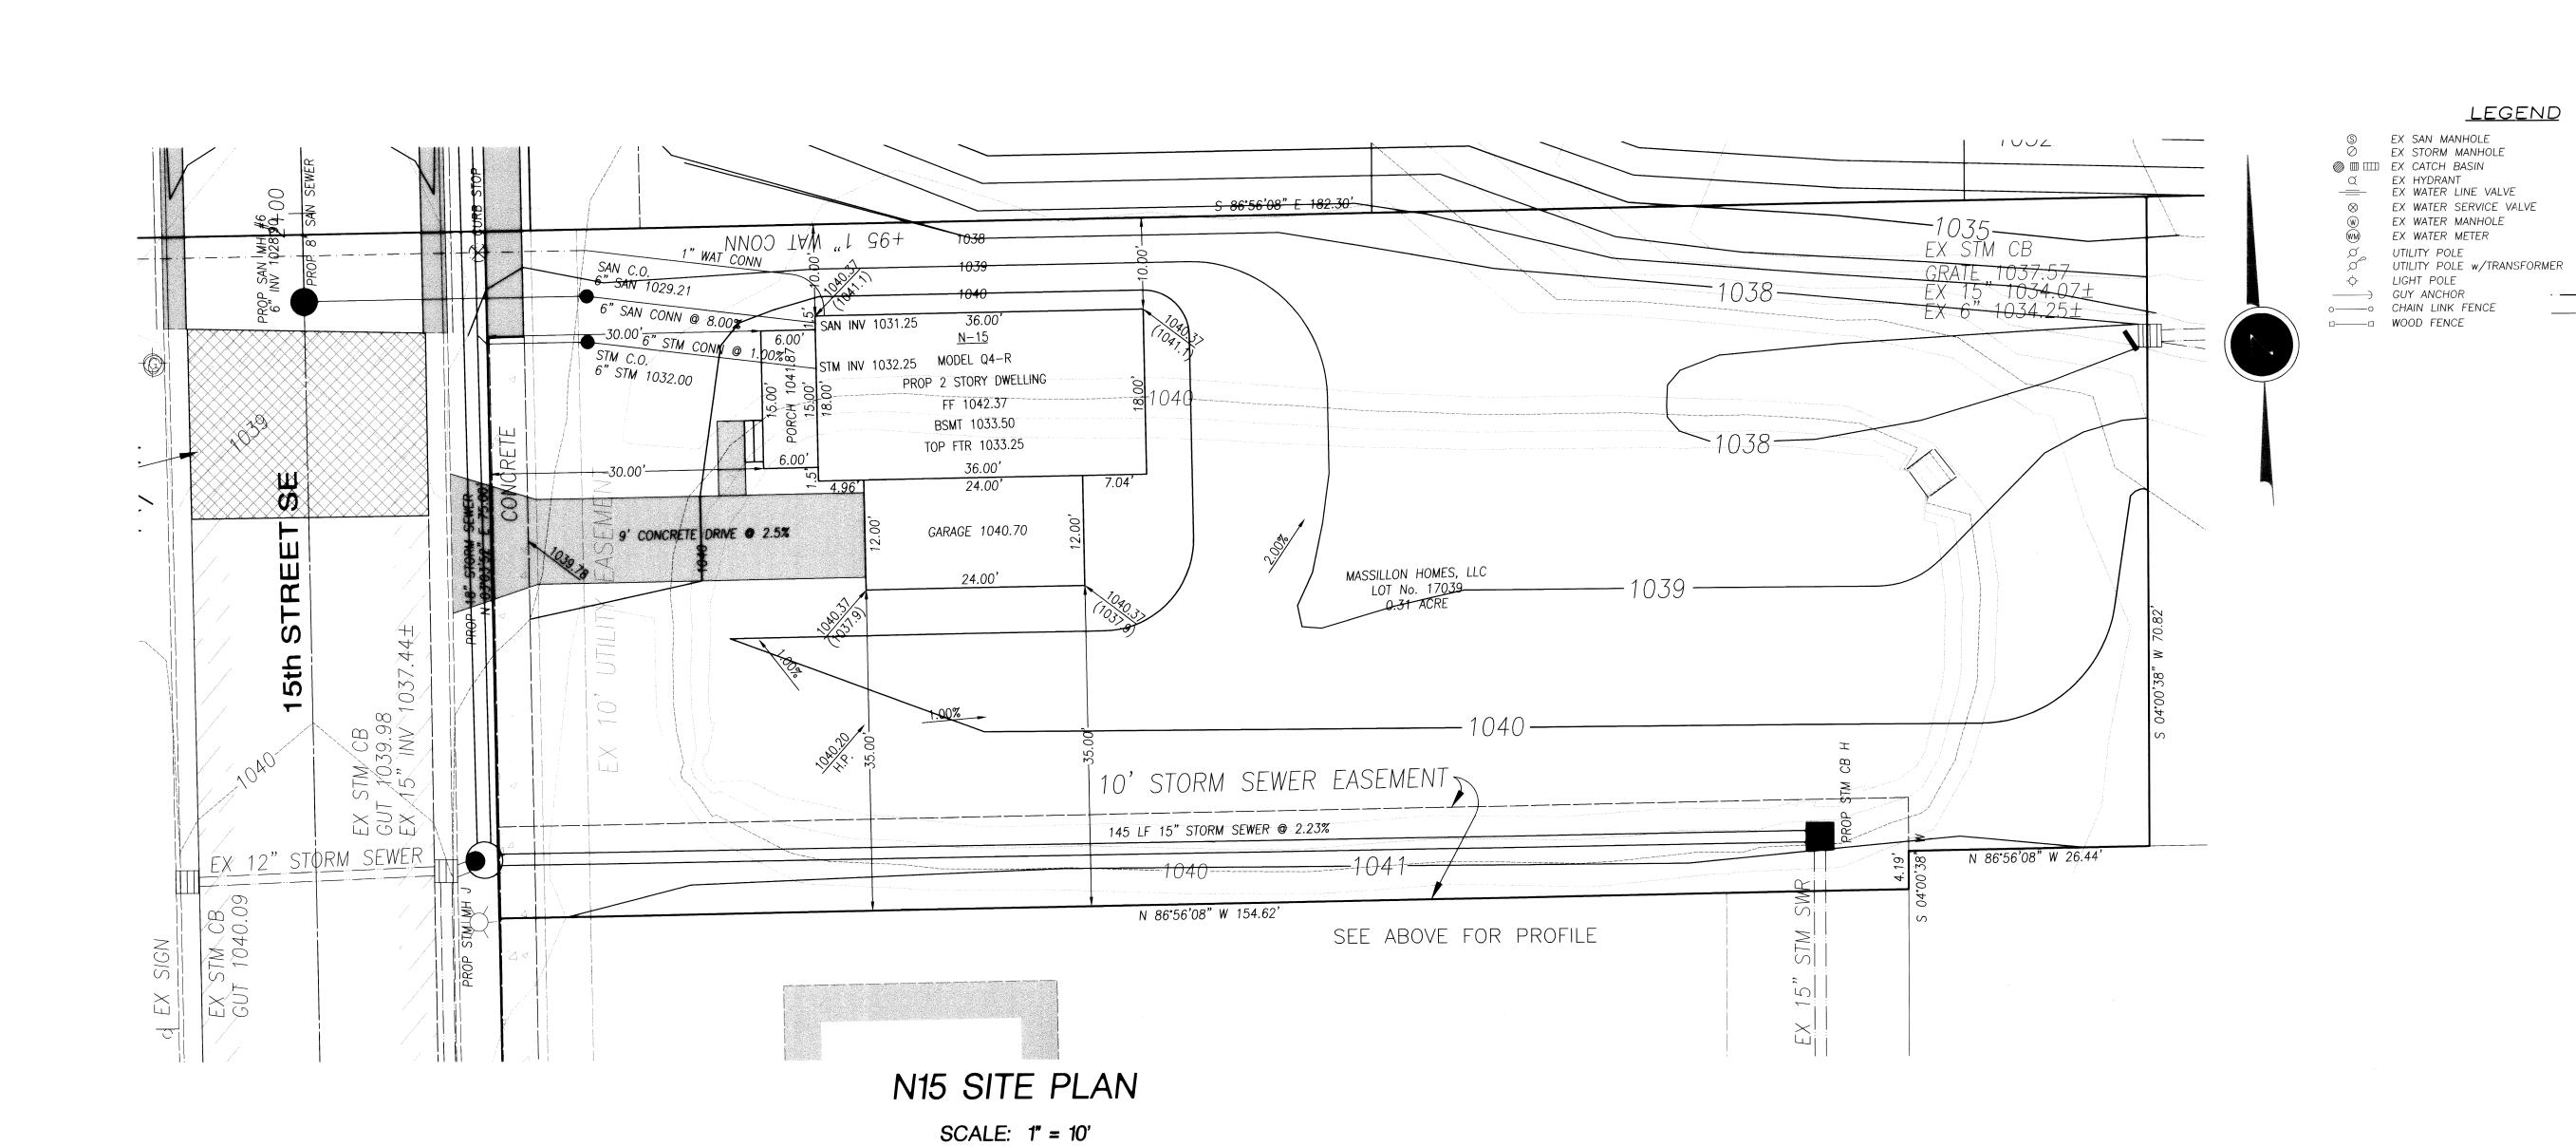

EX STM CB GRATE 1037.57 EX 15" 1034.07: EX 6" 1034.25± CB STRUCTURE TO REMAN

EXISTING HEADWALL TO BE REMOVED.

06-19030

MASSILLON HOMES, L.L.C. LOT No. 17040

EXISTING
HEADWALL AND
STORM SEWER
TO BE REMOVED

N15 DEMOLITION PLAN

SCALE: 1" = 20'

..L.C.

MASSILLON HON LOT No. 1

MASSILLON HOMES LOT No. 170: H.N. 1619

H.N. 166

D D Ш

GAS LINE MARKER GAS VALVE GAS METER

CABLE TV PEDESTAL

ELECTRIC MANHOLE

ELECTRIC METER

DECIDUOUS TREE

CONIFEROUS TREE

ELECTRIC GROUND TRANSFORMER

AS SHOWN Sep 03, 2008 Feb 06, 2007 DLN FS & BH 7323

08 50 01


NNEER


FOR: PHASE PLANS I ATES PROFILE ENT ST IMPROVEME BALLINGER ES

0 esi 0


Vertical Scale 1" = 5'


Original Submission Last Plot Date Sep 03, 2008 Feb 06, 2007 FS & BH

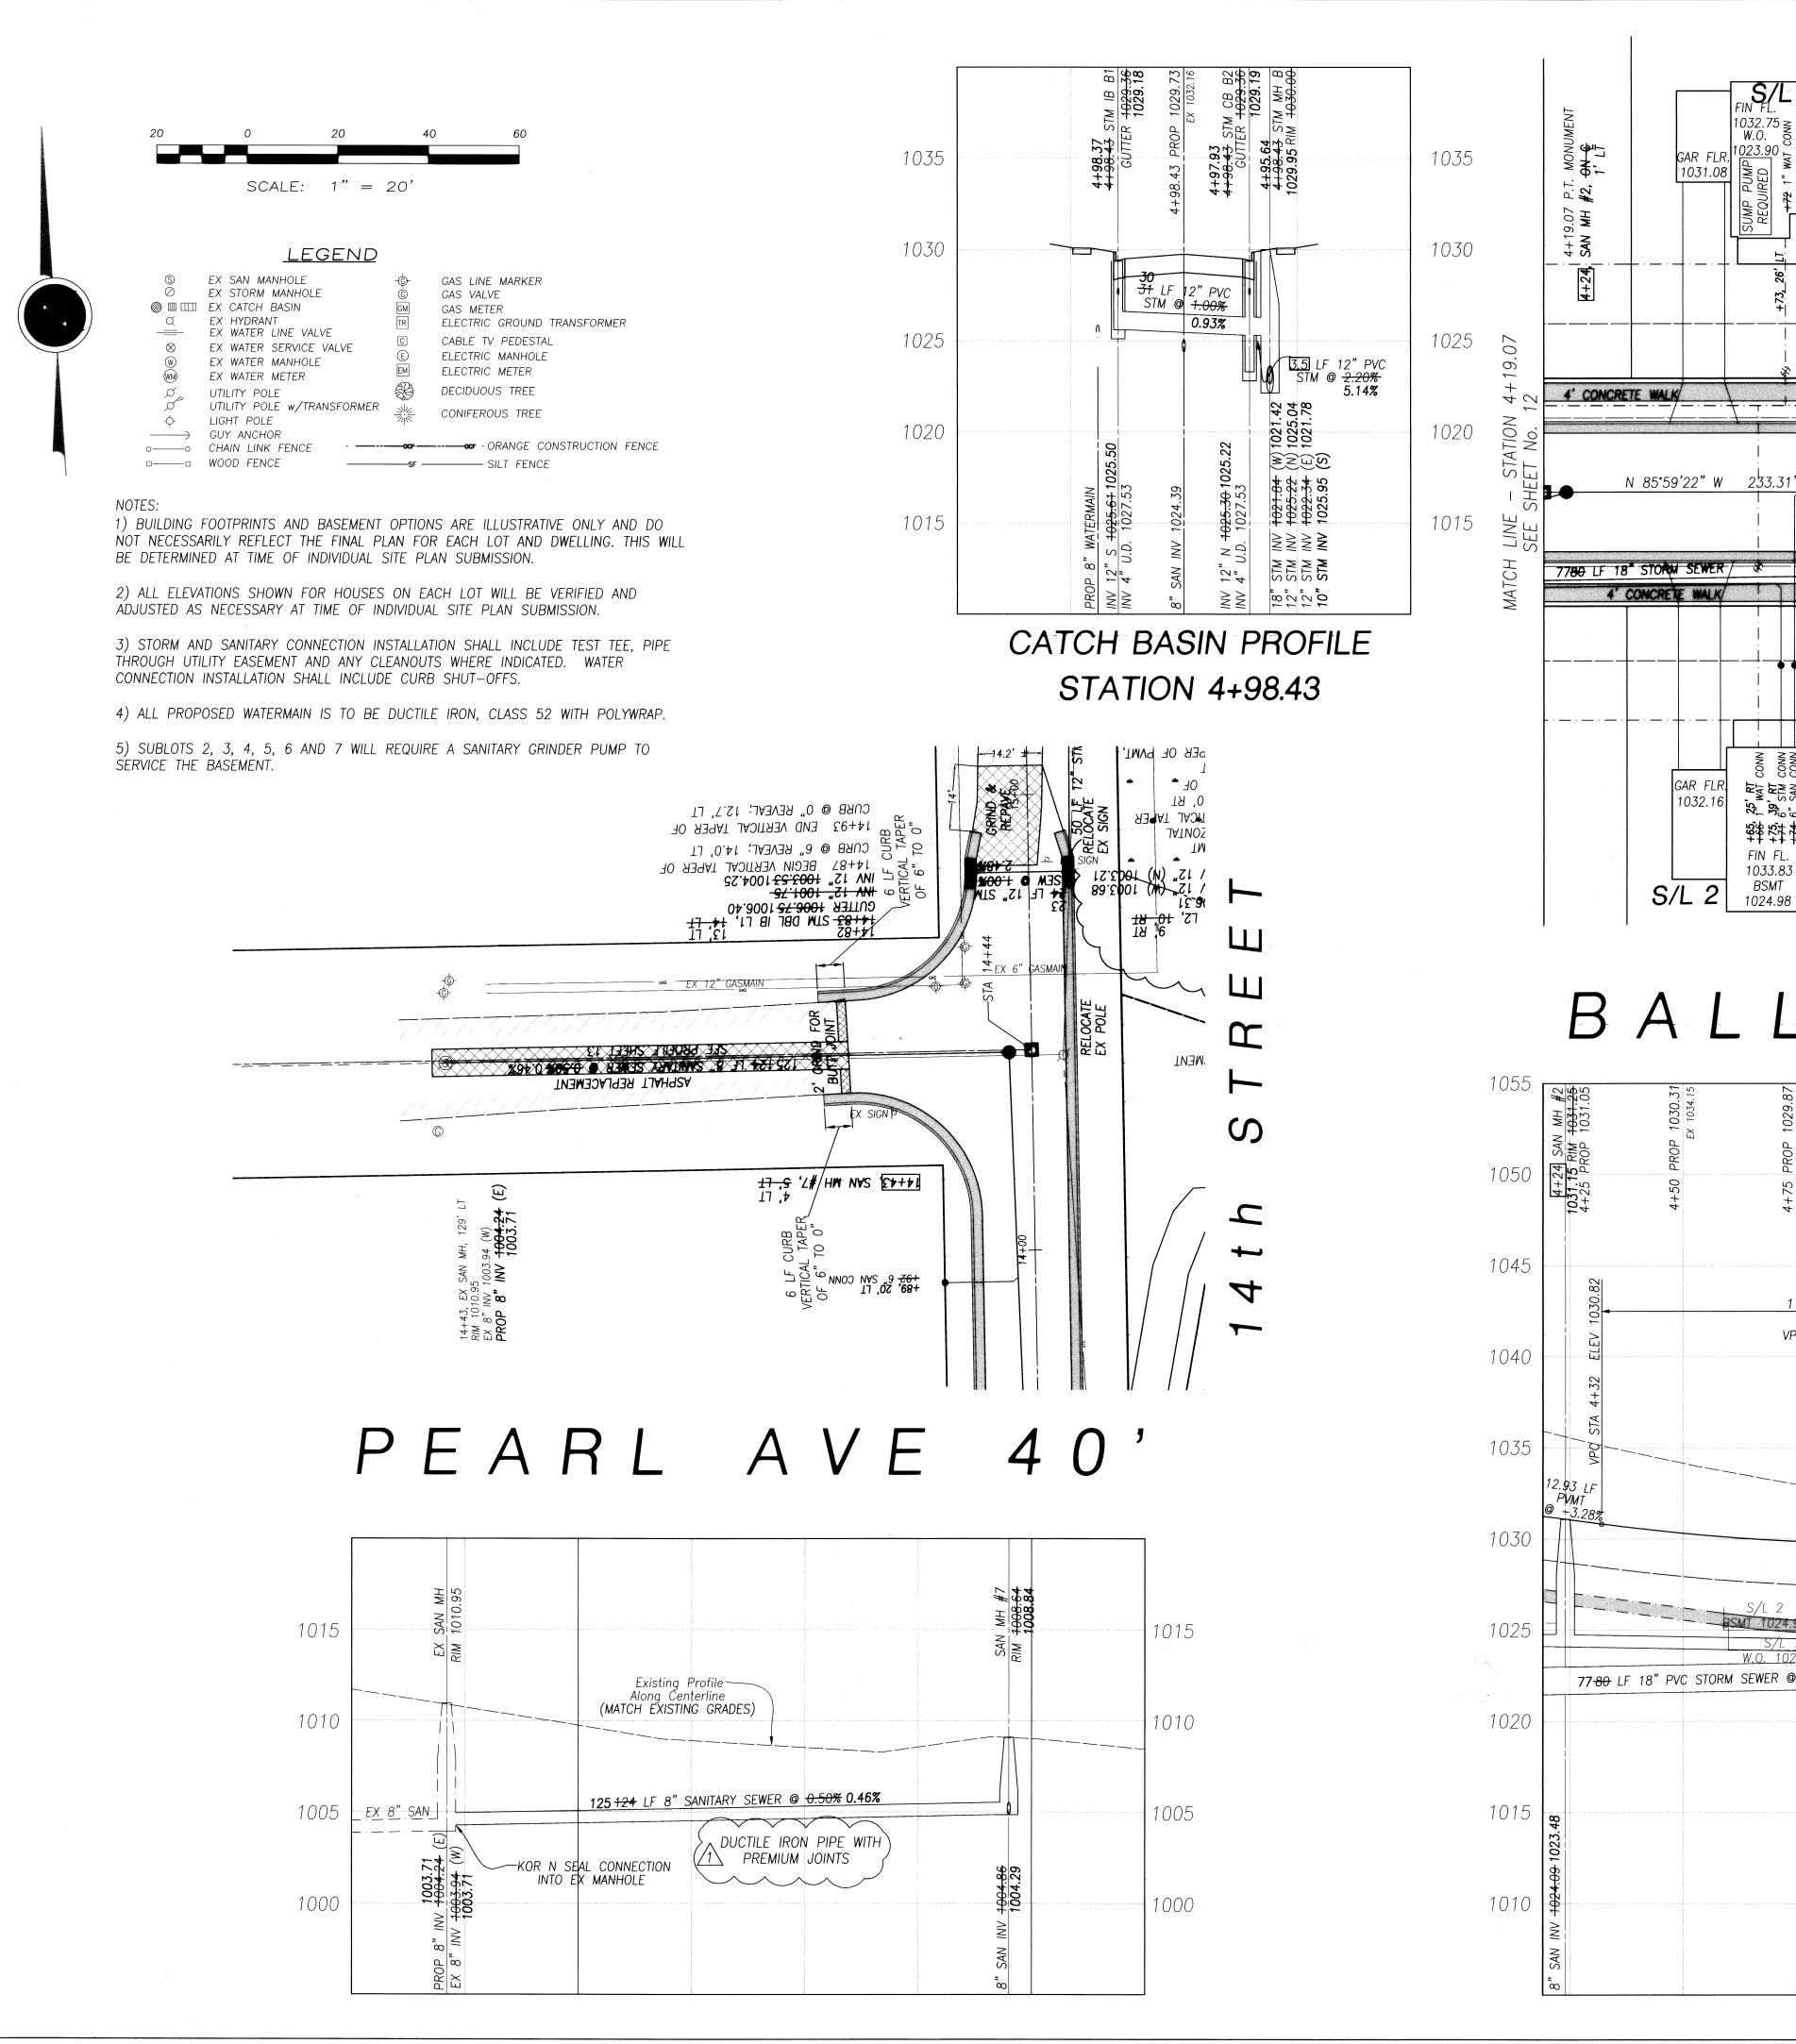

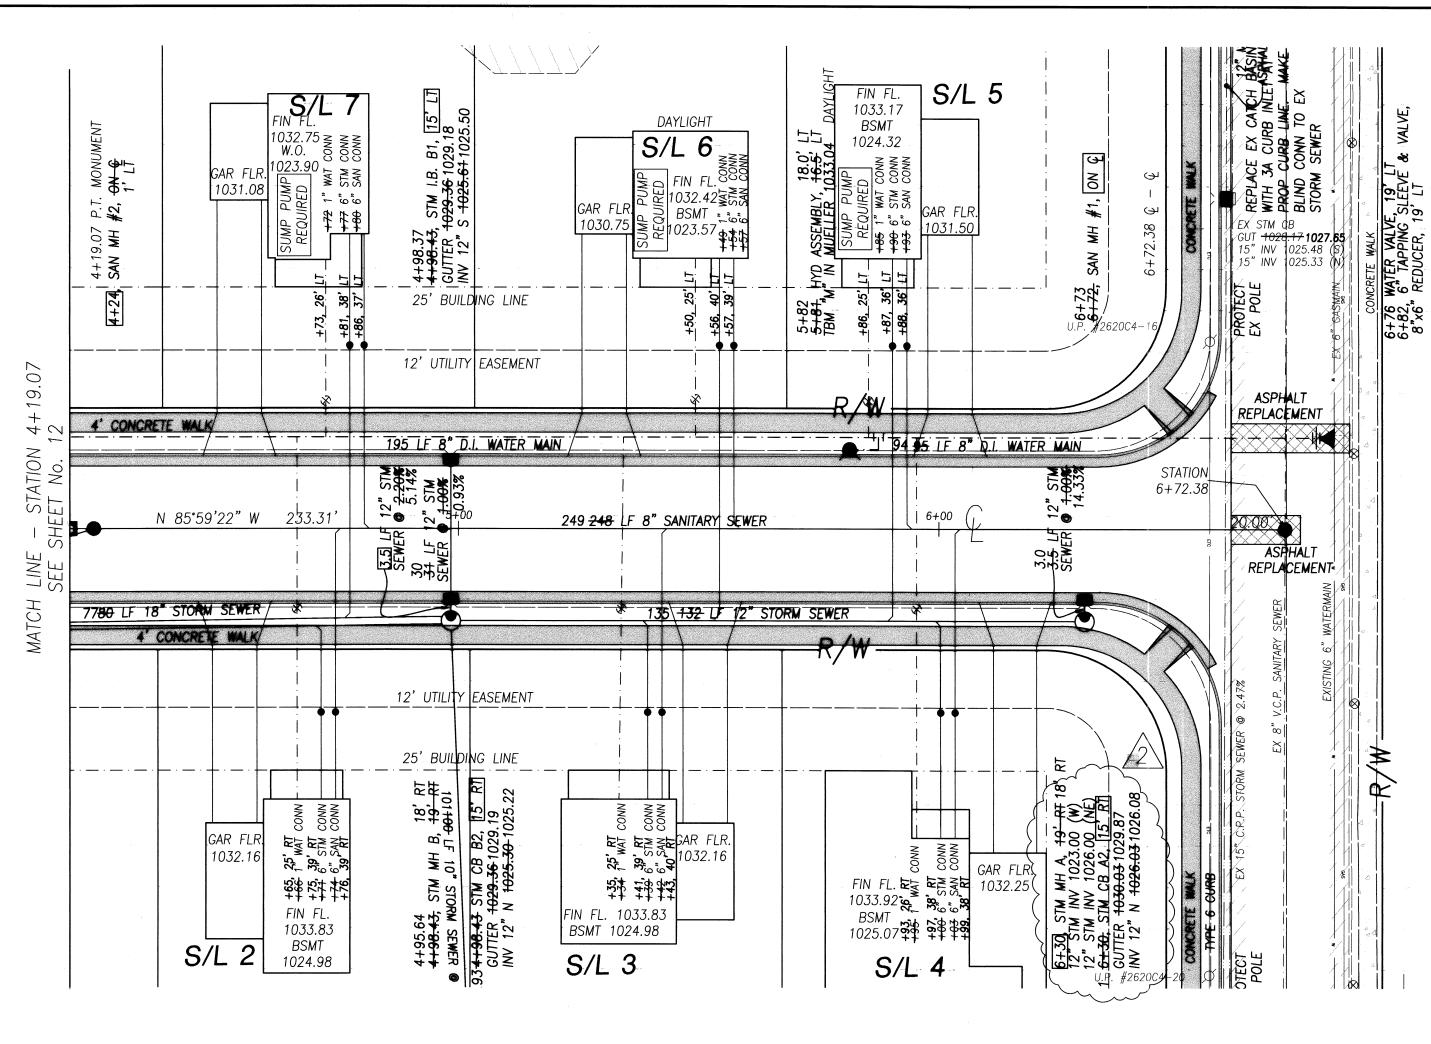

BALLINGER AVENUE 50'

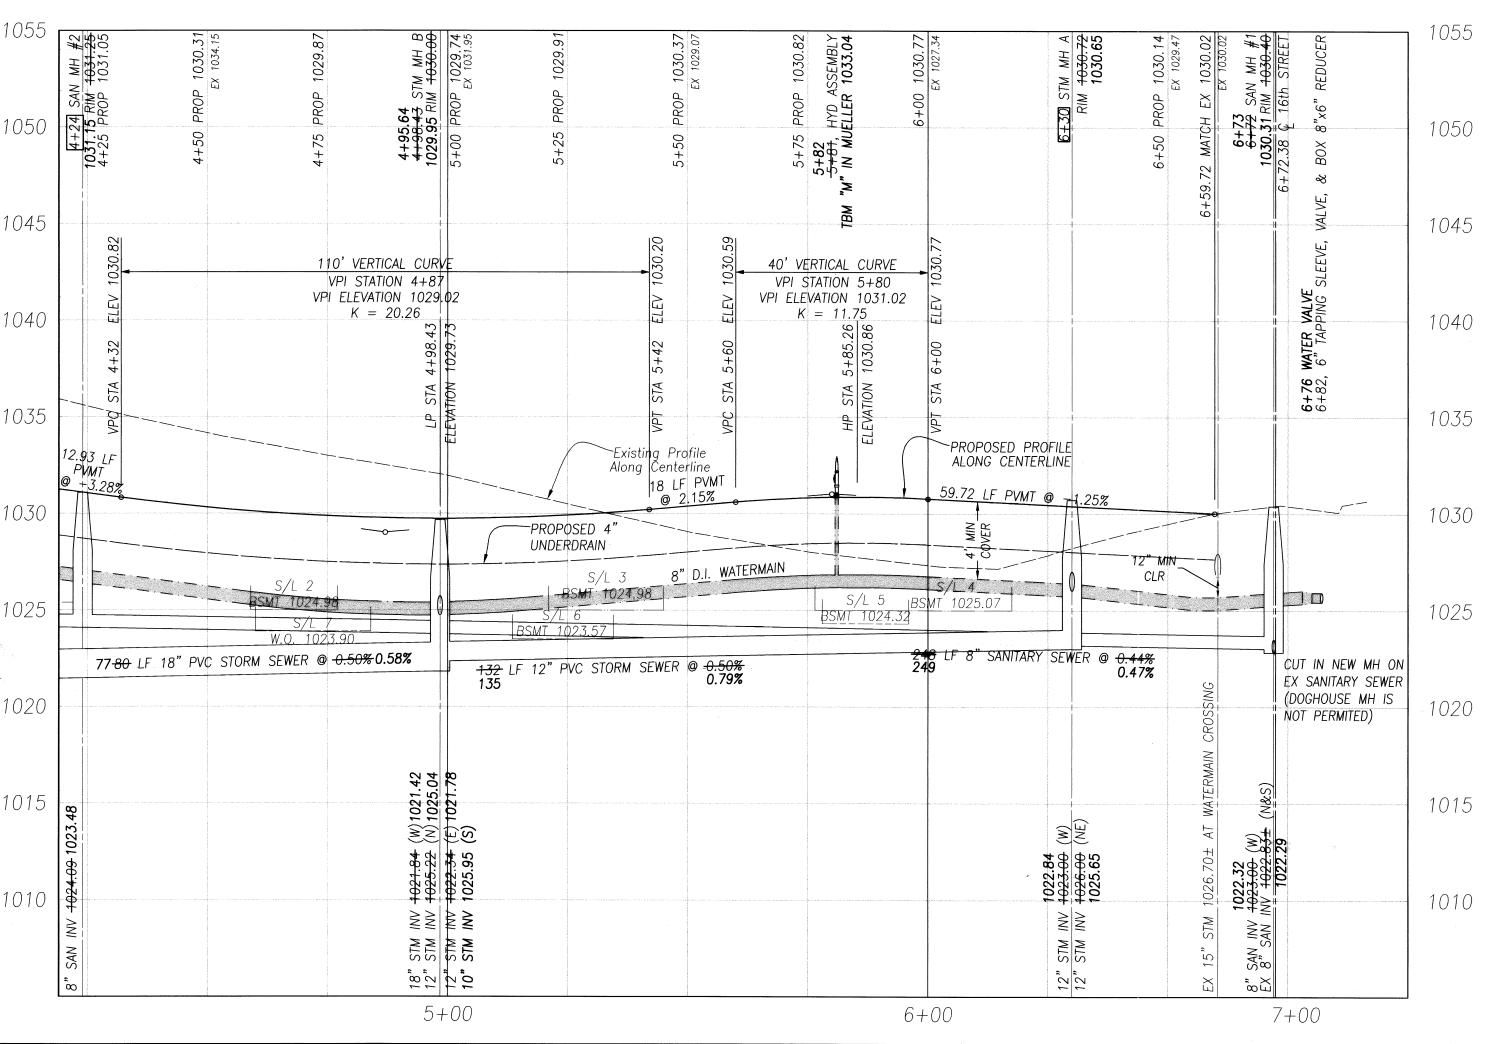

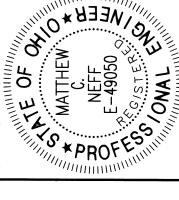

IMPROVEMENT PLANS FOR:
LINGER ESTATES PHASE
AND PROFILE -BALLINGER AVENUE; PEARL AVENU

S

+

9

PLANNERS ENGINEERS SURVEYORS

Number Date Descriptions

1 05/04/07 REV

2 05/22/07 REV

BESTGNING LAND FOR YOUR WORLD

5422 East 96th Street, Suite 120 • Cleveland OH 44125

tel: 216.663.8820 • fax: 216.663.8821

Horizontal Scale

1" = 20'

Original Submission
Feb 06, 2007

Drawn By


Checked By

Drawn By
DLN

Project Number
7323

Field Crew
FS & BH

Sheet

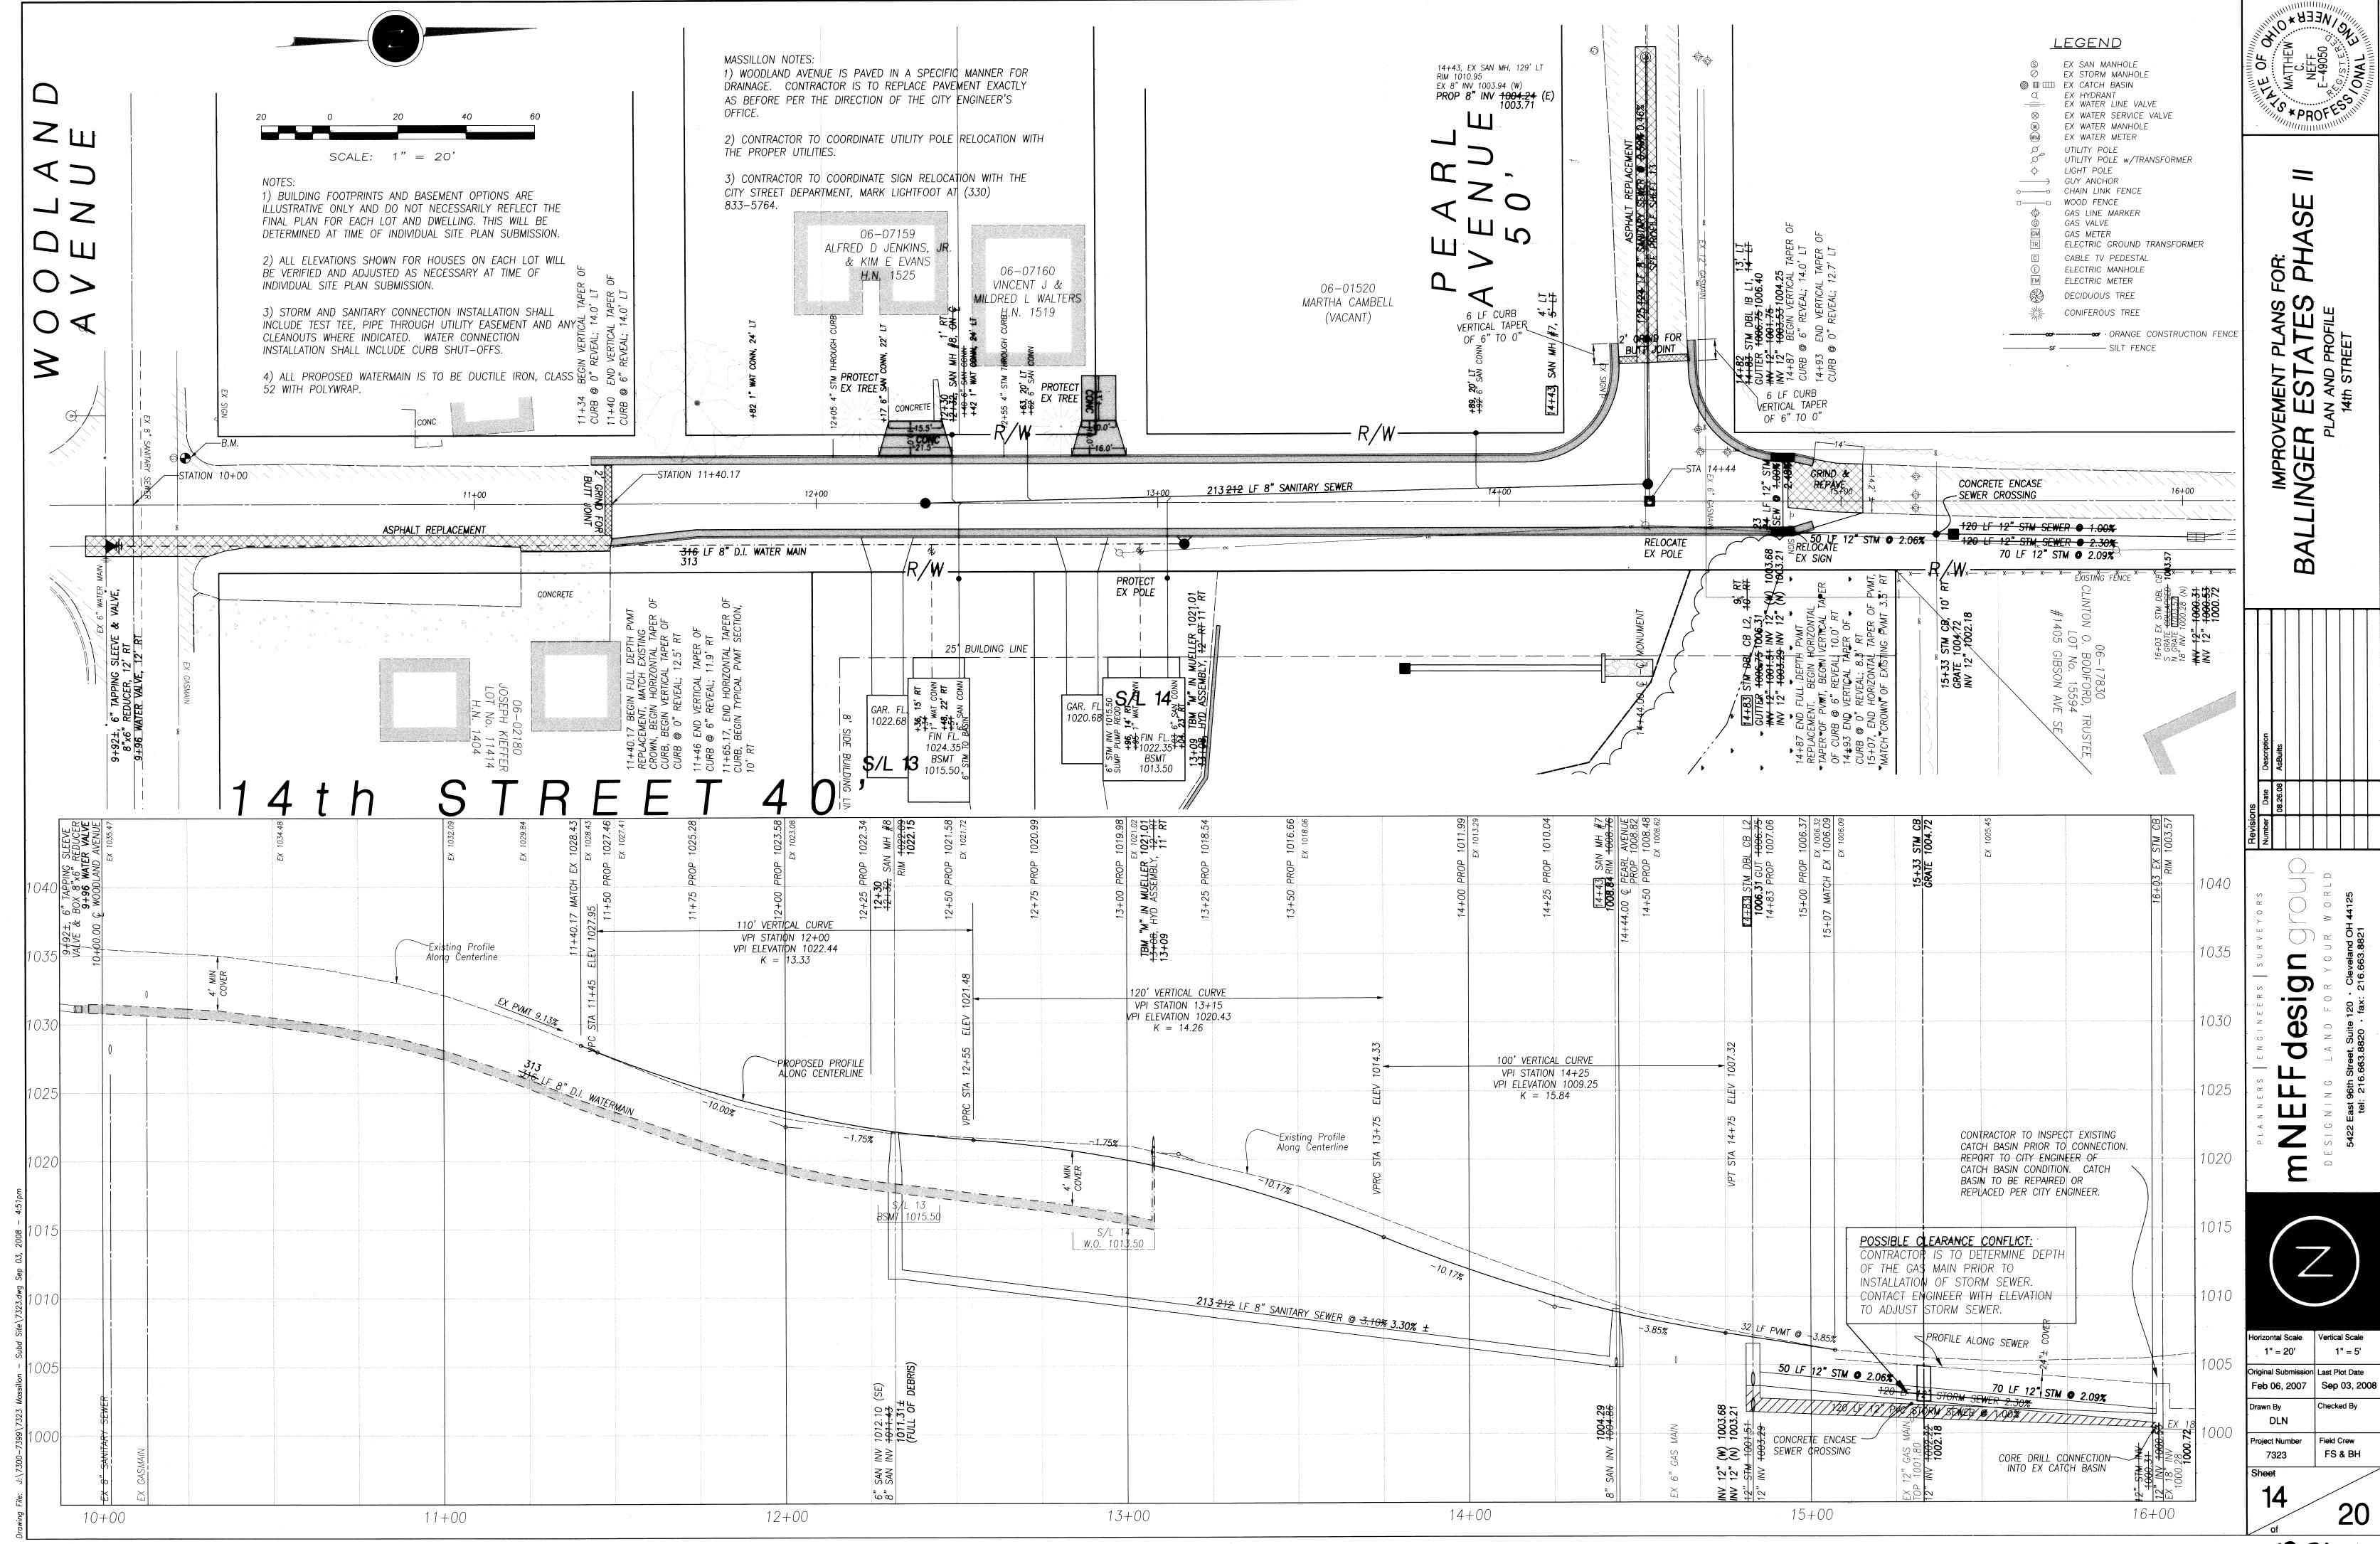

08 50 01

BALLINGER ESTATES PHASE II

SITUATED IN THE CITY OF MASSILLON, COUNTY OF STARK, STATE OF OHIO AND BEING ORIGINAL OUTLOT 303.

PROPOSED 14 LOTS

AQUA OHIO, INC.

SANITARY EFFLUENT FROM THIS PROJECT DISCHARGES TO CITY OF MASSILLON.

NUMBER OF LOTS = 14

AREA = 5.1166 ACRES TOTAL LF OF ROADWAY = 672 LF

TOTAL LF PUBLIC SANITARY = 788 LF

TOTAL LF PUBLIC STORM = 898 LF TOTAL LF PUBLIC WATER = 835 LF

UTILITY OWNERSHIP

THE LOCATION OF THE UNDERGROUND UTILITIES SHOWN ON THE PLANS ARE AS OBTAINED FROM THE OWNERS OF THE UTILITY AS REQUIRED BY SECTION 153.64 O.R.C.

WATER:

AQUA OHIO 870 THIRD STEET NW MASSILLON, OHIO 44647

(330) 832-7600

DOMINION EAST OHIO 1201 EAST 55th STREET CLEVELAND, OHIO 44103

(216) 736-6675

SANITARY: CITY OF MASSILLON 151 LINCOLN WAY EAST MASSILLON, OHIO (330) 830-1722

ELECTRIC: OHIO EDISON

TELEPHONE: AT&T

MASSILLON CABLE TV 814 CABLE CT NW MASSILLON, OHIO 44648 (330) 833-4134

1910 W MARKET BLDG #1

AKRON, OHIO 44313

229 WEST 7th STREET

AKRON, OHIO 44308


(330) 384-2237

(330) 384-4839

10th FLOOR



ONLY APPROVED SIGNED PLANS BY THE CITY ENGINEER ARE TO BE USED FOR CONSTRUCTION

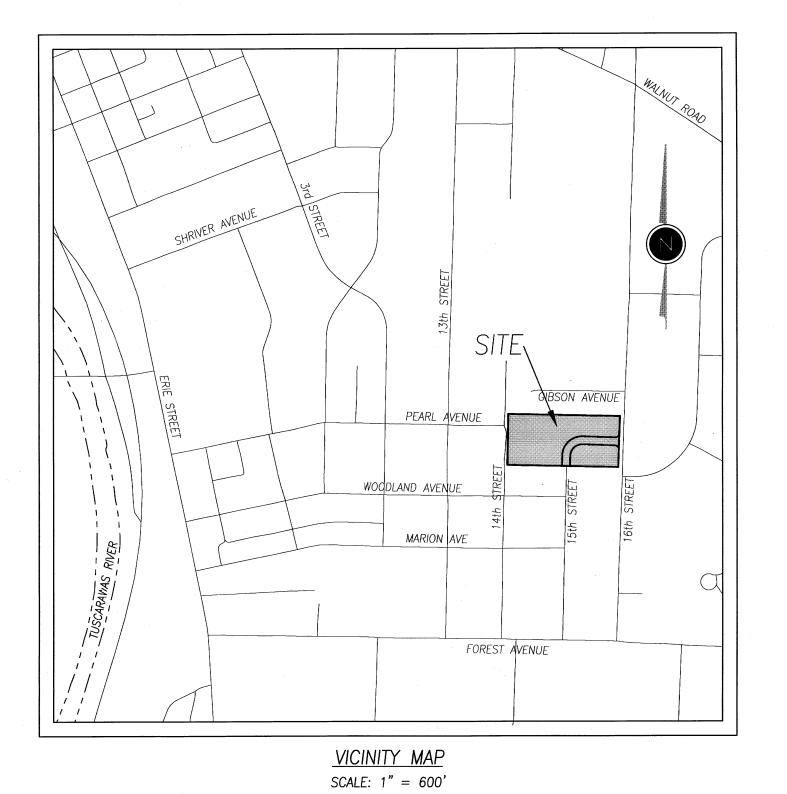

SITE BENCHMARKS:

GIN GEAR IN ASPH PVMT; NW CORNER OF WOODLAND AND 14th ST ELEVATION 1034.93

TOP %" I. PIN MONUMENT; CENTERLINE 15th ST AND SOUTH R/W MARION ELEVATION: 1043.47

INDEX OF SHEETS

TITLE SHEET	ı
CONSTRUCTION NOTES	2
CONSTRUCTION NOTES	3
STORM WATER POLLUTION PREVENTION PLAN	4
DETENTION BASIN PLAN	5
DETENTION BASIN DETAILS	6
STORM WATER POLLUTION PREVENTION DETAILS	7
TOPOGRAPHIC SURVEY AND DEMOLITION PLAN	8
GRADING PLAN	9
N15 PLAN	10
OVERALL PAVEMENT & UTILITY PLAN	11
PLAN AND PROFILES:	
15th STREET	12
BALLINGER AVENUE; PEARL AVENUE	
14th STREET	14
INTERSECTION DETAILS	
STANDARD SEWER DETAILS	
STANDARD WATERMAIN DETAILS	
TYPICAL SECTIONS & PAVEMENT DETAILS	18
CROSS SECTIONS 15TH STREET & BALLINGER AVENUE	19
CROSS SECTIONS BALLINGER AVENUE & 14TH STREET	20

QUANTITIES

PAVEMENT 472.83 LF (15TH STREET & BALLINGER AVENUE) PAVEMENT 375.79 LF (14TH STREET) PAVEMENT 318 LF (16TH STREET) 8" SANITARY 664 LF 8" WATER 800 LF 24" STORM 148 LF. 18" STORM 428 LF 15" STORM 180 LF 12" STORM 318 LF

PLANS PREPARED BY: M. NEFF DESIGN GROUP

PROFESSIONAL ENGINEER #49050 PROFESSIONAL SURVEYOR #7315


5.25.07

DATE


DEVELOPER: MASSILLON HOMES II, LLC 5309 TRANSPORTATION BLVD CLEVELAND, OHIO 44125 MARY HADA

(216) 475-9300

ENGINEER: M NEFF DESIGN GROUP 5422 EAST 96TH STREET, SUITE 120 CLEVELAND, OHIO 44125 MATTHEW NEFF, P.E., P.S. (216) 663-8820

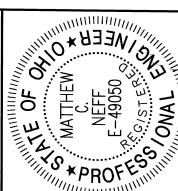

0 0

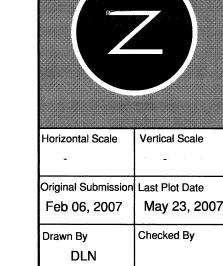

Project Number 7323 FS & BH


CONSTRUCTION AND MATERIAL SPECIFICATIONS:

Material and/or workmanship shall follow the "State of Ohio, Department of Transportation, Construction and Material Specifications", dated January 1, 2002 or any subsequent issues thereof. Throughout the plans the reference to specific ODOT item numbers are indicated. Material and workmanship shall also conform to the engineering design and construction manual of the City of Massillon and the ordinances of the City of Massillon where conflicts occur in the above. The engineer of the City of Massillon shall determine the governing authority. Any defects in the construction including materials or workmanship shall be repaired or replaced as directed by the City Engineer. Reference throughout these plans to "The Engineer" shall be the owner's engineer. "City Engineer" shall be the Engineer of the City of Massillon.

ELEVATION DATUM

All elevations shown on these plans are in feet above the U.S.G.S. datum plane.

Prior to construction, the contractor shall call Ohio Utilities Protection Service (OUPS), at 1-800-362-2764. The following is believed to be the list of utility owners within the limits of construction:

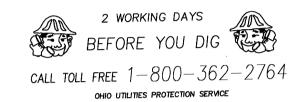

Any and all work required for removal, relocation and/or new construction facilities for private or public utilities will be done by and at the expense of the respective owners unless otherwise noted on the plans. The procedure as outlined in the Ohio revised code section 163.64. Regarding utility identification shall be followed. Namely the owner will notify the underground utility protection service and the individual utility 48 hours prior to commencing work. The underground utility owner must stake, mark or otherwise designate the location of its facility. The locations of underground utilities shown on these plans have been obtained by diligent field checks and searches of available records.

PRE-CONSTRUCTION CONFERENCES:

At least five days prior to the start of actual construction work, if required by the City, a pre—construction conference shall be held at the direction of the City of Massillon Engineer, all appropriate City officials, and the owner's engineer. The contractor or his authorized superintendant shall be present along with any and all private utility company representatives. This meeting will be for coordination and prodcedure review prior to commencing any physical work.

STATIONING AND LOCATIONS:

Stationing and location indicated on these plans are approximate. All locations and items called out by station are subject to adjustment in the field as directed by the engineer.

INSPECTION:

The cost of all inspection, permits, or tests shall be paid by the contractor and included in the unit prices bid. Unless noted otherwise the initial payment for inspection or testing by the City of Massillon or its agents shall be paid from a deposit made by the owner to the City of Massillon. But by verification of invoice from the City of Massillon these fees will be deducted from payments due the contractor. No final estimate will be issued until all fees for inspection and testing have been invoiced by the City of Massillon or its agents.

The contractor shall not commence with any form of construction without contacting the offices of the City of Massillon Engineer and Aqua Ohio to arrange for inspection. If any change in the work schedule becomes necessary, it will be to avoid unnecessary inspection costs. If no modification is made in regards to cancellation of work, the contractor will be charged for the inspection time incurred.

PRECAUTION AGAINST UTILITY DAMAGE:

The contractor shall take all necessary precautions at no expense to the owner to avoid damage to existing underground utility lines during the installation of the proposed improvements. It may be necessary to change the alignment or the flow line elevation of proposed sewers due to various existing utility lines with approval of the Engineer. The contractor shall make investigations to determine the location of existing utility lines prior to the installation of the proposed improvements. Such investigations shall be at no additional cost to the owner.

DUST CONTROL:

The contractor shall supply all labor, material and equipment necessary such as calcium chloride, water, or a motorized dust—free street sweeping device, as directed by the engineer, to maintain all roadways being used for access to the construction site. Payment for all dust control measures shall be included in the unit price bid for other various items.

SECTION 2 -

SITE CLEARING

<u> PART I: GENERAL</u>

RELATED DOCUMENTS:

Drawings and general provisions of contract, including general and supplementary conditions and specifications sections, apply to work of this section.

DESCRIPTION OF WORK:

Extent of site clearing is shown on drawings. Site clearing work includes, but is not limited to:

Removal of trees and other vegetation * Clearing and grubbing

* Removing existing walks, curbs, pavement, headwalls and utilities as indicated * Maintain positive drainage during construction

* Removal of existing dwelling

<u>Traffic</u>: Conduct site clearing operations to ensure minimum interference with roads, streets, parking, walks, and other adjacent occupied or used facilities. Do not close or obstruct streets, parking, walks, or other occupied or used facilities without permission from authorities having jurisdiction.

Protection of existing improvements: Provide protection necessary to prevent damage to existing improvements indicated to remain in place.

Protect improvements on adjoining properties and on owner's property.

Restore damaged improvements to their original condition, as acceptable to parties having jurisdiction.

PART II: EXECUTION

General: Remove trees, shrubs, grass and other vegetation, improvements, or obstructions interfering with installation of new construction. Remove such items from owner's property and dispose of off—site in a legal manner. Removal includes digging out stumps and roots.

Clearing and Grubbing: Clear site of trees, shrubs and other vegetation, except for those indicated in the plans.

Completely remove stumps, roots, and other debris protruding through ground

Fill depressions caused by clearing and grubbing operations with satisfactory soil material, unless further excavation or earthwork is indicated.

Place fill material in horizontal layers not exceeding 6" loose depth, and thoroughly compact to adjacent original ground.

Removal of Improvements: Remove existing above grade and below grade improvements necessary to permit construction and other work as indicated.

DISPOSAL OF WASTE MATERIALS:

Removal from Owner's Property: Remove waste materials from owner's property and dispose of off-site in a legal manner, as directed by the engineer.

Excess excavation is to be placed on the site as indicated by the plans. After placement of all excess excavation, the area shall be graded so that no depressions exist which will collect or pocket water. After grading is complete a mixture of 90% perennial rye grass and 10% Alsike clover shall be seeded in accordance with ODOT item 659.09.

The excess excavation pile shall be ringed with a silt fence or a straw bale barrier.

SECTION 3 - EARTHWORK

PART I: GENERAL

Drawings and general provisions of the contract including general and supplementary conditions and specifications sections, apply to work of this section.

DESCRIPTION OF WORK:

Extent of earthwork is indicated on drawings.

Preparation of subgrade and subbase material for walks and pavements is included as part of this work.

Excavation for Mechanical/Electrical Work: Excavation and backfill required in conjunction with underground mechanical and electrical utilities, and buried mechanical and electrical appurtenances is included as work of this section.

<u>Definition</u>: "Excavation" consists of removal of material encountered to subgrade elevations indicated and subsequent disposal of materials removed.

QUALITY ASSURANCE:

Codes and Standards: Perform excavation work in compliance with applicable requirements of governing authorities having jurisdiction.

Testing and Inspection Service: Owner will engage soil testing and inspection service for quality control testing during earthwork operations.

SUBMITTALS:

Test Reports Excavating: Submit following reports directly to the engineer from the testing services, with copy to contractor, if testing is performed.

Existing Utilities: Locate existing underground utilities in areas of work. If utilities are to remain in place, provide adequate means of support and protection during earthwork operations.

Should uncharted, or incorrectly charted, piping or other utilities be encountered during excavation, consult utility owner immediately for directions. Cooperate with owner and utility companies in keeping respective services and facilities in operation. Repair damaged utilities to satisfaction of utility owner.

Demolish and completely remove from site existing underground utilities indicated

to be removed. Coordinate with utility companies for shutoff of services if lines are active.

Use of Explosives: The use of explosives is not permitted.

Protection of Persons and Property: Barricade open excavations occurring as part of this work and post with warning lights.

Operate warning lights as recommended by authorities having jurisdiction.

Protect structures, utilities, sidewalks, pavements, and other facilities from damage caused by settlement, lateral movement, undermining, washout and other hazards created by earthwork operations.

PART II: PRODUCTS

DEFINITIONS:

Satisfactory soil material (available on site): Naturally deposited granular material (this is the only on site material suitable for fill and replacement fill where undercutting is required).

Unsatisfactory soil materials: Shall be as determined by the testing agency.

Subbase Material: Mixture of crushed limestone with a gradation is compliance to ODOT specification item 304.

Drainage Fill: Washed, evenly graded mixture of limestone or suitable crushed gravel, with 100% passing a 1-1/2" sieve and not more than 5% passing a number 4 sieve.

Backfill and Fill Materials: Satisfactory soil materials free of clay, rock or gravel larger than 2" in any dimension, debris, waste, frozen material, vegetable and other deleterious matter. No slag allowed.

PART III: EXECUTION

EXCAVATION:

Classifications: The following classifications of excavation will be made when rock excavation is encountered in work.

Earth excavation includes excavation of pavements and other obstructions visible on ground surface; underground structures, utilities and other items indicated to be demolished and removed; together with earth and other materials encountered that are not classified as rock or unauthorized excavation.

Unauthorized excavation consists of removal of materials beyond indicated subgrade elevations or dimensions without specific direction of the engineer. Unauthorized excavation, as well as remedial work directed by the engineer shall be at contractor's expense.

Backfill and compact unauthorized excavations as specified for authorized excavations of same classification, unless otherwise directed by the engineer.

Additional Excavation: When excavation has reached required subgrade elevations, notify the engineer who will make an inspection of conditions.

If unsuitable bearing materials are encountered at required subgrade elevations, carry excavations deeper and replace excavated materials as directed by the

Removal of unsuitable material and its replacement as directed will be paid on basis of contract conditions relative to changes in work.

Stability of Excavations: Slope sides of excavations to comply with local codes and ordinances having jurisdiction. Shore and brace where sloping is not possible because of space restrictions or stability of materials excavated.

Dewatering: Prevent surface water and subsurface or ground water from flowing into excavations and from flooding project site and surrounding area. Do not allow water to accumulate in excavations. Remove water to prevent soil

changes detrimental to stability of subgrades. Establish and maintain temporary drainage ditches and other diversions outside excavation limits to convey rain water and water removed from excavation to collecting on run-off areas. Do not use trench excavations as temporary drainage

Clean and maintain all catch basins during and at the completion of the work.

Material Storage: Stockpile satisfactory excavated materials where directed until required for backfill or fill. Place, grade and shape stockpiles for proper drainage. Locate and retain soil materials away from edge of excavations, do not store

Dispose of excess soil material and waste materials as herein specified.

within drip line of trees indicated to remain.

Excavation for Pavements: Cut surface under pavements to comply with cross—sections, elevations and grades as shown. Excavation for Trenches: Dig trenches to the uniform width required for particular

item to be installed, sufficiently wide to provide ample working room. Provide 6" to 9" clearance on both sides of pipe conduit.

Excavate trenches to depth indicated or required. Carry depth of trenches for piping to establish indicated flow lines and invert elevations.

For pipes or conduit 5" or less in nominal size and for flat bottomed multiple—duct conduit units do not excavate beyond indicated depths. Hand excavate bottom cut to accurate elevations and support pipe or conduit on undisturbed soil.

For pipes or conduit 6" or larger in nominal size, tanks and other mechanical/electrical work indicated to receive subbase, excavate to subbase depth indicated, or, if not otherwise indicated to 6" below bottom of work to be

When rock is encountered during trench excavation, the rock will be removed to a minimum depth of 6" below the establishing pipe invert. A compacted bedding of subbase material is to be placed in the trench prior to installing pipe.

Grade bottoms of trenches as indicated, nothing under pipe bells to provide solid bearing for entire body of pipe. Do not backfill trenches until test and inspections have been made and backfilling authorized by the Engineer. Use care in backfilling to avoid damage or

displacement of pipe systems. Trenches below pavement shall be as detailed on the drawings.

BACKFILL AND FILL

General: Place acceptable soil material in layers to required subgrade elevations for each area classification listed below. No slag allowed.

In excavations, use satisfactory excavated or borrow material.

Under grassed areas, use satisfactory excavated or borrow material.

Under walks and pavements, use premium backfill.

Under piping and conduit, bedding to conform with uniform standard Type I beddina.

Backfill excavations as promptly as work permits, but not until completion of the removal of concrete formwork and removal of trash and debris.

Ground Surface Preparation: Remove vegetation, debris, unsatisfactory soil materials, obstructions, and deleterious materials from ground surface prior to placement of fills. All trash and debris to be removed from site.

COMPACTION:

All Compaction, Subgrade Compaction and Concrete Cylinder Reports shall be furnished to the Engineer.

Control soil compaction during construction to provide the minimum percentage of density specified for each area as determined for a Standard Proctor Test according to ASTM D698.

Provide not less than ninety-eight percent (98%) density of soil material compacted within two percent (2%) of the optimum moisture content for the actual density of each layer of soil material in place, and as approved by the soil engineer.

STRUCTURES:

Compact the subgrade and each layer of fill material or backfill matter per ODOT

LAWN AND UNPAVED AREAS:

90% of maximum density.

Compact the subgrade and each layer of fill material or backfill material. Compact the upper 12" of filled areas, or natural soils exposed by excavating, at

<u>WALKS</u>:

Item 203.

Compact the subgrade and each layer of fill material or backfill material per ODOT Item 203.

PAVEMENTS AND RIGHT OF WAY EMBANKMENT:

Compact the subgrade and each layer of fill material or backfill material per ODOT Item 203.

General: Uniformly grade areas within limits of grading under this section, including adjacent transition areas. Smooth finished surface within specified tolerances, compact with uniform levels or slopes between points where elevations are indicated, or between such points and existing grades.

PAVEMENT SUBBASE COURSE:

General: Subbase course consists of placing subbase material, in layers of specified thickness over subgrade surface to support a pavement base course.

Grade Control: During construction, maintain lines and grades including crown and cross-slope of subbase course.

Placing: Place subbase course material on prepared subgrade in layers of uniform thickness conforming to indicated cross—section and thickness. Maintain optimum moisture content for compacting subbase material during placement operations.

When a compacted subbase course is shown to be 6" thick or less, place material in a single layer. When shown to be more than 6" thick, place material in equal layers, except no single layer more than 6" or less than 3" in thickness when compacted.

Protection of Graded Areas: Protect newly graded areas from traffic or erosion. Keep free of trash and debris. Repair and reestablish grades in settled, eroded and rutted areas to specific tolerances.

Reconditioning Compacted Areas: Where completed areas are disturbed by subsequent construction operations or adverse weather, scarify surface, reshape, and compact to required density prior to further construction.

Settling: Where settling is measurable or observable at excavated areas during general project warranty period, remove surface (pavement, lawn or other finish), add backfill material, compact, and replace surface treatment. Restore appearance, quality, and condition of surface or finish to match adjacent work, and eliminate evidence of restoration to greatest extent possible.

DISPOSAL OF EXCESS AND WASTE MATERIALS:

Removal from Owner's Property: Remove waste materials, including unacceptable excavated material, excess excavated material, trash and debris, and dispose of it off owner's property.

ROCK CHANNEL PROTECTION:

All rock channel protection shall be in accordance with ODOT Item 601.09 Type A, B, C, or D as indicated on plans and shall be installed immediately after the installation of the pertinent storm structure, material shall be limestone or natural

No concrete shall be allowed.

Comply with requirements of applicable sections for concrete work required in connection with sewer collection system work.

SECTION 4 - SEWER COLLECTION SYSTEM

PART I: GENERAL

RELATED DOCUMENTS:

All sewer work to be done in accordance with the County Uniform Standards for Sewerage Improvements and the City of Massillon requirements.

Drawings and general provisions of the contract, including general and supplementary conditions and specifications sections, apply to work of this section.

DESCRIPTION OF WORK: Extent of sewer collection system work is shown on drawings.

Sewer collection system work includes, but is not limited to, the following:

- Storm sewer conduits * Sanitary sewer conduits
- * Manholes, frames and covers Catch basins, frames and gratings

Comply with the requirements of applicable sections for excavation and backfilling required in connection with sewer collection system work.

SANITARY SEWERS: Clean Water Connections Prohibited: Roof drains, foundation drains, and other clean water connections to the sanitary sewer system are prohibited. Stark County Sanitary Engineer's inspection is required.

PART II: PRODUCTS

CONDUIT MATERIALS:

General: Furnish ells, tees, reducing tees, wyes, couplings, increasers, crosses, transitions and end caps of same type and class of material as conduit, or of material having equal or superior physical and chemical properties as acceptable to the engineer.

SANITARY SEWERS:

All sanitary sewer conduit shall be:

A. Polyvinyl chloride (PVC) ASTM D-3034 (SDR 35) with gaskets conforming to ASTM F 477 and joints per ASTM D-3212. The end of all sewer stubs shall be sealed with a plug or cap, the cost of which shall be included in the unit price bid for sanitary sewers.

**For sanitary sewers in excess of 13 feet deep, SDR 26 is required.

approximately three feet above the surface of the ground.

SANITARY WYE BRANCHES, RISERS AND CONNECTIONS (6" DIAMETER):

The material for all wye branches, risers, and connections shall conform to the following requirements: Polyvinyl chloride (PVC) ASTM D-3034 (SDR 35) with gaskets conforming to

ASTM F 477 and joints per ASTM D-3212. Wye branches shall be preformed wyes. After the wye branch, riser, and connection have been installed, the end of the connection shall be sealed with an air tight spigot cap or air tight plug and the cap or plug shall be painted yellow. The height of the riser called out in the plans is the vertical change in elevation, however, payment shall be for the actual length of risers and connection. Complete in place, measured along the length of the pipe. The end of the sanitary connection shall be marked with a 2" x 2" hardwood stake, extending vertically from the end of the connection to a point

CITY OF MASSILLON SANITARY SEWER NOTES:

Sanitary sewer and appurtenances shall be constructed according to city of Massillon Engineering Department specifications and details in effect at the time

of construction. 2. Roof drains, foundation drains and other clean water connections to the

sanitary sewer are prohibited. 3. The contractor shall notify all property owners along the route of the

sanitary sewer at least three (3) days prior to start of construction.

4. The contractor shall alert the utilities protection service at least 48 hours prior to start of construction. 5. The contractor shall be responsible for properly maintaining existing sanitary flow during the construction and testing of the proposed improvements. The

contractor's methods for maintaining flow must be approved by the City of

Massillon Engineering Department at the pre-construction meeting. 6. All rough grading to within six (6) inches of finished grade shall be completed within the right—of—way and easements prior to sanitary sewer

7. Bulkheads shall be erected in existing manholes were taps for new mainline sewers are made and shall remain in place until the new sewers are complete, tested and approved. In cases were a bulkhead would interrupt the flow from existing service connections, the bulkhead shall be placed in the first new manhole upstream of the existing manhole.

Minimum vertical clearance between sanitary sewer and waterline shall be 18

inches. Minimum horizontal separation shall be 10 feet. 9. Sanitary sewer service laterals shall be 6—inch diameter and be laid at no

less than 1.0% grade. 10. For new subdivision construction, sewer service laterals shall extend 12" into the lots or beyond furthest utility, whichever is greater, when the main sewer is in a street right—of—way, and shall terminate at the easement line when the main sewer is in an easement. For other sewer extensions, sewer service laterals shall terminate at the right-of-way line or the easement line, whichever

11. Service stacks shall be ductile iron pipe regardless of main sewer material. A cast iron tee shall be installed in the main sewer. Concrete encasement will not be required.

12. Minimum cover over sanitary sewer shall be 4 feet.

13. Acceptable sanitary sewer pipe materials are as follows: Specifications Installation Material Description ASTM D-3212 ASTM D-2321 ASTM D-3034 PVC Smooth exterior ASTM C-12 ASTM C-425 ASTM C-700 VCP Extra Strength AWWA C-110/C-111 AWWA C-151 AWWA C-151 DCIP (class 52) ASTM D-2680 ASTM D-2235 ASTM D-2680 ABS Composite ASTM D-2564 ASTM D-2680

ASTM D-2680

14. All sanitary sewers, 8—inch diameter and larger, must pass an internal television inspection. the contractor shall provide complete internal inspection videotape to the City of Massillon Engineering Department. The videotaping procedure shall be in accordance with City of Massillon Engineering Department Specifications.

15. A deflection test shall be required for all flexible pipe of 8—inch diameter

and larger. The test shall be conducted be conducted at least 30 days after completion of backfill and shall be in accordance with City of Massillon Engineering Department specifications. The allowable deflection rate shall not exceed five (5%) percent. Testing shall be in accordance with ASTM D-3034. 16. All Sanitary sewers must pass a low pressure air test, which shall be conducted in accordance with ASTM F-1417 (plastic pipe) or ASTM C-828 (clay

pipe). The maximum allowable test leakage shall be 100 Gal/inch of diameter/mile/day. 17. Manhole construction shall meet the requirements of ASTM C-478 and C-443. All manholes shall be air/vacuum tested in accordance with and meet

all the requirements of ASTM C-1244. 18. Connections to existing manholes shall be core drilled, with benches and

channels formed and repaired as necessary. 19. Any manhole drop attachments shall be "outside" type.

20. Manhole top of casting elevations may require adjustment during site grading. Manhole covers may not be buried. Upon completion of construction and restoration, all manholes, proposed and existing, shall be in conformance in all respects with City of Massillon Engineering Department specifications and

21. Pre-construction meeting is required, contact City of Massillon Engineering Department at 330-830-1722 and Stark Soil and Water District at 330-830-7700.

22. Sanitary permits are required, contact the City of Massillon Engineering department for license and permit requirements.

STORM SEWERS:

All storm sewers shall have premium joints.

PVC Composite

Storm Conduit: All storm sewer conduit shall conform to the following requirement: Reinforced concrete pipe, ASTM C-76, "B" or "C" wall, 8 foot

Unless otherwise noted on plans, all storm sewers shall be: PVC ASTM 3034, SDR 35 or Polyethylene ADSN-12, or approved equal Rear yard storm sewers maybe PVC smooth interior and corrugated exterior pipe in conformance with AASHTO M294 Type S (12"-30" diameter) and AASHTO M252,

Type S (4"-10" diameter) or ASTM F667-97 (8"-24" diameter). The end of all sewer stubs shall be bulkheaded, the cost of which shall be included in the unit price bid for storm sewers.

STORM WYE BRANCHES, RISERS AND CONNECTIONS (6" DIAMETER):

The material for all wye branches, risers, and connections shall conform to the following requirements: 1. Polyvinyl chloride (PVC) ASTM D-3034 (SDR-35) with gaskets conforming to

ASTM F 477 and joints per ASTM D-3212 appropriate wye branches, boots or saddles shall be installed in cored holes in the storm sewer conduit. The end of each connection shall be sealed with a tight fitting plug and the end of each connection shall be marked with a 2" x 2" hardwood stake, extending vertically from the end of the connection to a point approximately three feet above the surface of the ground.

UNCLASSIFIED PIPE UNDERDRAINS:

Underdrains shall be constructed in accordance with ODOT Item 605. Conduit shall be 4" or 6" diameter PSM Poly (vinyl chloride) (PVC) pipe conforming to ASTM D-3034 SDR-35, with an aggregate leveling course and cover as shown on

I WEER*

*PROFESSION

 Σ \square

[C|Z| | | | | | | | | 0

zontal Scale Vertical Scale Original Submission Last Plot Date Feb 06, 2007 | Apr 27, 2007 Checked By Drawn By DLN roject Number 7323

Sheet

ഗ Φ

0

FS & BH

Precast Concrete Manholes: ANSI/ASTM C-478, sized as indicated.

Joints between manhole sections shall be provided with "O"-ring type neopreme rubber gaskets conforming to A.S.T.M. specification C-443. Sanitary sewer pipe passing through or connecting into the manhole shall be provided with a flexible watertight gasket and stainless steel band to allow for differential in settling between the manhole itself and the sewer pipe, to conform to A.S.T.M. spec.

MASONRY MATERIAL:

Concrete Masonry Units: ANSI/ASTM C-139

Manhole Brick: ANSI/ASTM C-32, Grade MS

Sewer Brick: ANSI/ASTM C-32, Grade SS

Masonry Mortar: ANSI/ASTM C-270, Type M

For minor amounts of mortar, packaged materials complying with ANSI/ASTM C-387, Type M, will be acceptable.

METAL ACCESSORIES

Manholes Frames and Covers: Gray cast iron, ANSI/ASTM A-48, Class 30 B Comply with requirements of FS RR-F-621 for type and style indicated.

Furnish covers with cast—in legend "storm" or "sanitary" on roadway face as required.

Manhole Steps: Gray cast iron, ANSI/ASTM A-48, Class 30 B, integrally cast into manhole side walls, unless otherwise indicated.

Polypropylene manhole steps will be permitted.

Catch Basin Frames and Gratings: Gray cast iron, ANSI/ASTM A-48, Class 30 B. Comply with requirements of FS RR-F-621, for type and style required.

PART III: EXECUTION

INSTALLATION OF CONDUIT:

General: Install conduit in accordance with governing authorities having jurisdiction, except where more stringent requirements are indicated.

Inspect conduit before installation to detect apparent defects. Mark defective materials with white paint and promptly remove from site.

Lay conduit beginning at low point of a system, true to grades and alignment indicated with broken continuity of invert.

Place bell ends of clay conduit or groove end of concrete conduit facing upstream.

Install gaskets in accordance with manufacturer's recommendations for use of lubricants, cements and other special installation requirements.

<u>Vitrified Clay Pipe:</u> Install in accordance with applicable provisions of ASTM C-12, recommended practice for installing clay sewer pipe, unless otherwise indicated.

Concrete Pipe: Install in accordance with applicable provision of American Concrete Pipe Association "Concrete Pipe Field Manual", unless otherwise indicated.

Place circular concrete pipe with elliptical reinforcing so that reference lines indicating top of pipe are not more than 5 degrees from vertical plane through longitudinal axis of pipe.

<u>Cleaning Conduit</u>: Clear interior of conduit of dirt and other superfluous material as work progresses. Maintain swab or drag in line and pull past each joint as it

is completed. In large, accessible conduit, brushes and brooms may be used for cleaning.

Place plugs in ends of uncompleted conduit at end of each day or whenever work

Flush lines between manholes if required to remove collected debris.

Interior Inspection: Inspect conduit to determine whether line displacement or other damage has occurred.

Make inspections after lines between manholes or manhole locations have been installed and approximately two feet of backfill is in place and at completion of

If inspection indicates poor alignment, debris, displaced pipe, infiltration or other defects, correct such defects to satisfaction of engineer.

UNDERGROUND STRUCTURES:

Masonry Construction Manholes: At contractor's option, use either sewer brick or concrete masonry units to construct masonry manholes. Mix mortar with only enough water for workability, retempering of mortar will not be permitted. Keep mortar mixing and conveying equipment clean. Do not deposit mortar upon, or permit contact with the ground.

Lay masonry in mortar so as to form full bed with ends and side joints, not more than 5/8" wide. Protect fresh masonry from freezing and from too rapid

Apply a 1/2" thick mortar coating on both interior and exterior wall surfaces. Where manholes occur in pavements, set tops of frames and cover flush with finish surface. Elsewhere, set tops 3" above finish surface unless otherwise

Use an epoxy bonding compound where manhole steps are mortared into masonry

Precast Concrete Manholes: Place precast concrete sections as shown on drawings. Where manholes occur in pavements, set tops of frames and covers flush with finish surface. Elsewhere, set tops 2" above finish surface, unless otherwise indicated.

Use epoxy bonding compound where manhole steps are mortared into manhole

Provide rubber joint gasket complying with ASTM C-443.

Catch Basins: Construct catch basins to the sizes and shapes indicated. Precast alternates will be allowed subject to engineer approval.

Use concrete which will attain a 28 day compressive strength of not less than 3000 PSI.

Set cast iron frames and gratings to elevations indicated.

BACKFILLING:

General: Conduct backfill operations of open—cut trenches closely following laying, jointing and bedding of pipe, and after initial inspection and testing are completed. For conduit under paved areas backfill shall be done with granular material and brought to the surface of the subgrade of the pavement.

TESTING:

Color Photography or VCR Television Inspection and Testing of Storm Sewers: All inspection and testing shall be done by an experienced and qualified firm engaged in this type of work, as approved by the City of Massillon. Written reports for all inspection and testing shall be submitted to the owner for approval. All storm sewers television inspection shall be in accordance with the Massillon specifications. If the installation fails to meet the requirements of these tests and inspections, the contractor shall repair or replace all defects and re—test the

For 48" and larger pipe, visual inspection may be performed in lieu of color photography or VCR television inspection.

Color Photography or VCR Television Inspection and Testing of Sanitary Sewers: All inspection and testing shall be done by an experienced and qualified firm engaged in this type of work, as approved by the City of Massillon. Written reports for all inspection and testing shall be submitted to the owner and the City of Massillon for approval. All sanitary sewers must be flushed and pass the latest proposed low pressure air test requirements and deflection test requirements of the Ohio Environmental Protection Agency and the City of Massillon. The maximum deflection allowed is 5%. The maximum leakage allowed is 100 gallons per inch of pipe diameter per mile of sewer per day. All sanitary sewers must also have a color photography or VCR television inspection in accordance with the City of Massillon specifications. All final testing and inspections shall be performed after completion of pavement construction and seeding of disturbed areas, but prior to the issuance of building permits. If the installation fails to meet the requirements of these tests and inspections, the contractor shall repair all defects and retest the installation.

<u>Deflection Test:</u>

a. Deflection test shall be performed on all flexible pipe. The test shall be conducted after the final backfill has been in place at least 30 days to permit stabilization of the soil-pipe system. b. No pipe shall exceed a deflection of 5 percent. If deflection exceeds 5

percent, replacement or correction shall be accomplished in accordance with requirements in the approved specifications.

c. The rigid ball or mandrel used for the deflection test shall have a diameter not less that 95 percent of the base inside diameter or average inside diameter of the pipe depending on which is specified in the ASTM Specification, including the appendix, to which the pipe is manufactured. The test shall be performed without mechanical pulling devices.

The leakage exfiltration or infiltration shall not exceed 100 gallons per inch of pipe diameter per mile per day (0.02 m3/mm of pipe dia./km/day) for any section of the system. An exfiltration or infiltration test shall be performed with a minimum positive head of 2 feet (600 mm).

plastic pipe, and for other materials test procedures approved by the regulatory

The air test shall, as a minimum, conform to the test procedure described in ASTM C-828 for clay pipe. ASTM C-924 for concrete pipe, ASTM F-1417 for

<u> Manhole Test:</u> All manholes to be vacuum tested as per ASTM-C-1244.

All testing shall be witnessed by a Municipal sanitary official.

SECTION 5 - PORTLAND CEMENT CONCRETE PAVING PART I: GENERAL

RELATED DOCUMENTS:

Drawings and general provisions of contract, including general and supplementary conditions and specification sections, apply to work specified in this section.

DESCRIPTION OF WORK:

Extent of Portland cement concrete paving is shown on drawings, including curbs and gutters.

Prepared subbase is specified in Section 3, "Earthwork".

"State Specifications" as used herein refer to the State of Ohio Department of Highways Construction and Material Specifications, 2002 edition, referred to as

SUBMITTALS:

Furnish samples, manufacturer's product data, test reports, and materials certifications as required in referenced sections for concrete and joint fillers and

JOB CONDITIONS:

<u>Traffic Control</u>: Maintain access for vehicular and pedestrian traffic as required for other construction activities Utilize flagmen, barricades, warning signs and warning lights as required.

PART II: PRODUCTS

MATERIALS:

Forms: Steel of size and strength to resist movement during concrete placement and to retain horizontal and vertical alignment until removal. Use straight forms. free of distortion and defects.

Use flexible spring steel forms to form radius bends as required.

Coat forms with a non-staining form release agent that will not discolor or deface surface of concrete.

Concrete materials shall conform to "State Specifications" Item 451, Modified Class "C" unless otherwise specified.

Portland cement shall be ASTM C-175-67, 1A which will produce 6% plus or minus 1% of entrained air.

Aggregate shall meet the requirements of "State Specifications", Item 703.02. Coarse aggregate shall be crushed limestone only.

Water shall be clear and free from injurious amounts of oils, acid, alkalis, organic materials or other deleterious substance, for human consumption.

Membrane curing and sealing compound shall conform to ASTM C-309.

Reinforcing steel shall conform to ASTM A-615, Grade 60.

Poured joint filler shall be of non-extruding bituminous type meeting ASTM specifications D 1751-65 and conform to AASHTO specifications M-173.

PROPORTIONING AND MIXING CONCRETE:

All concrete shall be proportioned and mixed in accordance with the applicable requirements of "State Specifications", Item 499.

All concrete shall be tested for compliance with this specification.

PART III: EXECUTION

SURFACE PREPARATION:

Remove loose material from compacted subbase surface immediately before placing

Proof roll prepared surface to check for unstable areas and need for additional compaction. Do not begin paving work until such conditions have been corrected and are ready to receive paving.

FORM CONSTRUCTION:

Set forms to required grades and lines, rigidly braced and secured. Install sufficient quantity of forms to allow continuous progress of work and so that forms can remain in place at least 24 hours after concrete placement.

Check completed form work for grade and alignment to following tolerances:

- * Top of forms not more than 1/8" in 10'
- * Vertical face on longitudinal axis not more than 1/4" in 10'

Clean forms after each use and coat with form release agent as often as required to ensure separation from concrete without damage.

REINFORCEMENT:

Locate and place reinforcement as detailed on the drawings.

CONCRETE PLACEMENT:

Do not place concrete until subbase and forms have been checked for line and grade. Moisten subbase if required to provide a uniform dampened condition at time concrete is placed. Do not place concrete around manholes or other structures until they are at required finish elevation and alignment.

Bedding: To be No. 57 limestone or aggregate compacted to the depth indicated on the typical sections.

Place concrete using methods which prevent segregation of mix. Consolidate concrete along face of forms and adjacent to transverse joints with internal vibrator. Keep vibrator away from joint assemblies, reinforcement, or side forms. Use only square—faced shovels for hand spreading and consolidation. Consolidate with care to prevent dislocation of reinforcing, dowels, and joint devices.

Deposit and spread concrete in a continuous operation between transverse joints, as far as possible. If interrupted for more than 1/2 hour, place a construction

While being deposited the concrete shall be vigorously manipulated with spades or other suitable tools to prevent the formation of voids, or honey combed sections. Special attention shall be given to the compacting of the concrete against forms, curbs, castings and joints.

malfunction a transverse construction joint shall be formed as specified. Any concrete which has been delivered in quantities in excess of that needed to form this intermediate joint shall not be used. Unless otherwise specified, concrete when deposited shall have a temperature of

In the event of an interruption in the delivery of concrete or any mechanical

not less than 50°F, nor more than 90°F. In freezing weather, suitable means shall be provided for maintaining the concrete at a temperature of 45°F for a period of not less than seven (7) days. Construction must stop if the temperature falls to 36°F. No frozen materials shall be used in the concrete nor shall concrete be laid on frozen ground. Any concrete which may be damaged by frost action shall be replaced by the contractor at his own expense.

<u>Weakened-Plane (Contraction) Joints</u>: Provide weakened-plane (contraction) joints, sectioning concrete into areas as shown on drawings. Construct weakened-plane joints for a depth equal to at least 1/4 concrete thickness, as follows:

<u>Tooled Joints</u>: Form weakened-plane joints in fresh concrete by grooving top portion with a recommended cutting tool and finishing edges with a jointer.

Construction Joints: Place construction joints at end of placements and at locations where placement operations are stopped for a period of more than 1/2 hour, except where such placements terminate at expansion joints. Construction ioints as shown.

Expansion Joints: Provide pre molded joint filler for expansion joints abutting catch basins, manholes, inlets, structures, walks and other fixed objects unless otherwise indicated

Extend joint fillers full width of joint, and not less than 1/2" or more than 1" below finished surface where joint sealer is indicated. If no joint sealer, place top

possible. Where more than one length is required, lace or clip joint filler sections

Protect top edge of joint filler during concrete placement with a metal cap or other temporary material. Remove protection after concrete has been placed on

Furnish joint fillers in one-piece lengths for full width being placed whenever

CONCRETE FINISHING:

After striking—off and consolidating concrete, smooth surface by screeding and floating. Use hand methods only where mechanical floating is not possible. Adjust floating to compact surface and produce uniform texture.

After floating, test surface for trueness with 10' straight edge. Distribute concrete as required to remove surface irregularities, and refloat repaired areas to provide a continuous smooth finish.

Curbs and Gutters: Automatic machine may be used for curb and gutter placement at contractor's option. If machine placement is to be used submit revised mix design and laboratory test results which meet or exceed minimums specified. Machine placement must produce curbs and gutters to required cross-section, lines, grades, finish, and jointing as specified for formed concrete. If results are not acceptable, remove and replace with formed concrete as

JOINTS:

General: Construct expansion, weakened-plane (contraction), and construction joints true—to—line with face perpendicular to surface of concrete. Construct transverse joints at right angles to the centerline, unless otherwise indicated.

When joining existing structures, place transverse joints to align with previously placed joints, unless otherwise indicated.

Work edges of slabs, gutters, back top edge of curb, and formed joints with an edging tool, and round to 1/2" radius, unless otherwise indicated. Eliminate tool marks on concrete surface.

to line of traffic. Repeat operation if required to provide a fine line texture

After completion of floating and troweling when excess moisture or surface sheen has disappeared complete surface finishing, as follows. Broom finish, by drawing a fine-hair broom across concrete surface, perpendicular

acceptable to engineer Do not remove forms for 24 hours after concrete has been placed. After form removal, clean ends of joints and point—up any minor honeycombed areas. Remove and replace areas or sections with major defects, as directed by engineer.

Curing material shall be applied at the rate of one gallon per 300 square feet and in strict accordance with the manufacturer's directions. Do not use liquid membrane curing compound where anti-spalling treatment is to be applied.

REPAIRS AND PROTECTIONS:

Repair or replace broken or defective concrete, as directed by engineer.

Drill test cores where directed by engineer when necessary to determine magnitude of cracks or defective areas. Fill drilled core holes in satisfactory pavement areas with portland cement concrete bonded to pavement with epoxy resin grout.

Protect concrete from damage until acceptance of work. Exclude traffic from pavement for at least 14 days after placement. When construction traffic is permitted, maintain pavement as clean as possible by removing surface stains and spillage of materials as they occur. Sweep concrete pavement and wash free of stains, discoloration, dirt and other foreign material just prior to final inspection.

UTILITY MARKINGS:

Paving contractor shall emboss utility locations on curbs after completion of pavement.

SECTION 6 - ASPHALT CONCRETE PAVING

PART I: GENERAL

RELATED DOCUMENTS

Drawings and general provisions of contract, including general and supplementary conditions and specifications sections, apply to work of this section.

DESCRIPTION OF WORK

Extent of asphalt concrete paving work is shown on drawings.

Prepared aggregate subbase is specified in Section 3, "Earthwork".

SUBMITTALS

producer and contractor, certifying that each material item complies with or exceeds, specified requirements. No recycled asphalt is permitted on this project. JOB CONDITIONS

Material Certificates: Provide copies of materials certificates signed by material

above 50°F (10°C), and when temperature has not been below 35°F (1°C) for 12 hours immediately prior to application. Do not apply when base is wet or contains an excess of moisture

Construct asphalt concrete surface course when atmospheric temperature is above

Weather Limitations: Apply prime and tack coats when ambient temperature is

temperature is above $30^{\circ}F$ ($-1^{\circ}C$) and rising.

40°F (4°C) and when base is dry. Base course may be placed when air

Grade Control: Establish and maintain required lines and elevations.

QUALITY ASSURANCES

"State Specifications" as used herein refer to the State of Ohio Department of Highways Construction and Material Specifications, 2002 editions, referenced to as

PART II: PRODUCTS

MATERIALS

General: Use locally available materials and gradations which exhibit a satisfactory record of previous installations. Pavement materials shall meet the requirements of the following ODOT Items:

Aggregate base course: ODOT Item 304

Bituminous aggregate base: ODOT Item 301

Asphalt Concrete Surface course: ODOT Item 448 Surface Medium

Striping paint shall be white, chlorinated rubber base traffic lane marking paint, factory mixed, quick-drying and non-bleeding, if required.

PART III: EXECUTION

SUBGRADE INSPECTION

Paving contractor must examine the areas and conditions under which pavement is to be installed. Notify the engineer in writing of conditions detrimental to the proper and timely completion of the work. Do not proceed with the work until unsatisfactory conditions have been corrected in a manner acceptable to the engineer. Coordinate inspection with the engineer.

SURFACE PREPARATION

Remove loose material from compacted subbase surface.

Proof roll prepared subbase surface to check for unstable areas and areas requiring additional compaction.

Notify engineer of unsatisfactory conditions. Do not begin paving work until deficient subbase areas have been corrected and are ready to receive base course aggregate.

PAVEMENT COURSES

Aggregate base course for pavement shall be 6" in thickness after compaction, as indicated on the drawings, and placed on the prepared subbase in accordance with state specifications Item 304 "Aggregate Base". After completion of base course. it shall be checked for irregularities in grade at approximately 25 foot intervals, and all high spots or depressions shall be corrected before bituminous intermediate course is installed. The base course shall be place in two 3" thick

Bituminous aggregate base course for pavement shall be 4" in thickness after compaction, as indicated on the drawings, and placed on the prepared subbase in accordance with state specifications Item 301 "Bituminous Aggregate Base". The base course shall be placed in one 4" thick layer.

Surface course shall be 1-1/2" thickness after compaction, as indicated on the drawings, placed on the prepared aggregate base course course in accordance with state specification Item 448 Surface. Spreading and finishing of open areas shall be done with a barber green spreader, or approved equal to secure accurate surface grades which will conform in all respects to those indicated on the grading plan.

There shall be an Item 407, Tack Coat, applied prior to Item 448 surface and intermediate courses unless otherwise directed by the engineer.

FIELD QUALITY CONTROL

Test the in-place asphalt concrete courses for compliance with requirements for thickness and surface smoothness. Repair or remove and replace unacceptable paving as directed by the engineer.

3/16" ±

In-place compacted thickness will not be acceptable if exceeding following allowable variation from required thickness.

Subbase and base courses: 1/4" ±

Leveling and wearing courses:

using 10'-0" straightedge applied parallel with and at right angles to centerline of paved area. Surfaces will not be acceptable if exceeding the above tolerances for smoothness.

Test finished surface of each asphalt concrete course for smoothness,

Check surfaced areas at intervals as directed by the engineer.

MISCELLANEOUS NOTES

Contractor to verify condition of existing storm sewer pipe tying into existing sewer. The engineer shall inspect such condition and verify adequacy. Contractor shall follow engineer's request to use or replace such pipe to new catch basins.

CITY OF MASSILLON GENERAL NOTES:

1. CONTRACTOR SHALL CHECK DETAIL DRAWINGS FOR MINIMUM GRADE AND BACKFILL REQUIREMENTS.

2. ALL COMBINATION CONCRETE CURB AND GUITER TO BE MASSILLON STANDARD EXCEPT WHERE VARIATIONS ARE TO BE EXTENDED OR MET. SE SPECIFICATION BOOK AND PLANS.

3. EXCAVATION FOR CONCRETE CURB AND GUTTER SHALL BE INCLUDED IN THE COST PER LINEAL FOOT OF SAID CURB AND GUTTER.

4. ALL CATCH BASINS AND MANHOLES TO BE ADJUSTED TO GRADE WHERE NECESSARY.

5. ALL CONCRETE TO BE 1:2: 4-6 BAG MIX. 28 DAY - 3000 PSI COMPRESSIVE STRENGTH: MAX. SLUMP TO BE 4"

6. ALL MATERIALS USED WILL BE NEW - NO SALVAGED MATERIALS WILL BE ACCEPTED, EXCEPT CASINGS, AS APPROVED. 7. IF CONTRACTOR EXCAVATES DEEPER THAN NECESSARY FOR CURB AND GUTTER.

CONTRACTOR WILL FURNISH O.D.O.T. 304 AGGREGATE AND TAMP BEFORE CURB AND

GUTTER IS CONSTRUCTED. 8. IF SUBGRADE IS UNSUITABLE, CONTRACTOR WILL EXCAVATE AND REPLACE SUCH MATERIAL WITH CRUSHER RUN GRAVEL, AT THE DISCRETION OF THE INSPECTOR OR CITY ENGINEER. THIS FILL TO BE PLACED IN 6" LAYERS OR LESS. SAID FILL TO BE COMPACTED TO 95% LABORATORY DRY WEIGHT BEFORE ADDITIONAL LAYERS ARE ADDED. CONTRACTOR WILL BE PAID FOR EXTRA GRAVEL AND EXCAVATION. THIS

9. CONTRACTOR TO BACKFILL CURB IMMEDIATELY AFTER CURB HAS BEEN IN PLACE FOR 24 HOURS.

COMPACTION TO BE DONE BEFORE FORMS ARE PLACED.

MASSILLON CITY STANDARDS.

10. ALL STORM SEWER PIPES WITHIN PAVEMENT LIMITS SHALL BE REINFORCED CONCRETE PIPE (O.D.O.T. 706.02) AND SHALL BE TYPE 'B' CONDUIT IN ACCORDANCE WITH O.D.O.T. 603 WITH CLASS 'B' BEDDING AND GRANULAR BACKFILL. ALL STORM SEWER OUTSIDE PAVEMENT LIMITS SHALL BE SMOOTH LINED CORRUGATED POLYETHYLENE (O.D.O.T. 707.33) OR REINFORCED CONCRETE PIPE (O.D.O.T. 706.02) AND SHAL BE TYPE 'C' CONDUIT IN ACCORDANCE WITH O.D.O.T. 603 WITH CLASS 'C BEDDING AND SUITABLE SOIL BACKFILL.

11. DOWNSPOUT HEADERS SHALL BE 6" PVC (SDR 21) PIPE (UNLESS OTHERWISE NOTED ON THE PLANS) AND SHALL BE DIRECTLY CONNECTED TO THE STORM SFWFR WITH APPROVED TEE OR SADDLE CONNECTIONS. HEADERS SHALL EXTEND 12" INTO THE LOTS OR BEYOND THE FURTHEST UTILITY, WHICHEVER IS GREATER.

BEGUN. THE CITY OF MASSILLON IS NOT RESPONSIBLE FOR ANY LOST TIME DUE TO UTILITY RELOCATION. 13. MANHOLES AND CATCH BASINS SHALL BE CONSTRUCTED IN CONFORMANCE WITH

12. CONTRACTOR SHALL NOTIFY ALL UTILITY COMPANIES BEFORE ANY WORK IS

DEPARTMENT (GREG McCUE) AT (330) 830-1722 AT LEAST 2 DAYS PRIOR TO THE INITIATION OF CONSTRUCTION TO SCHEDULE A PRE-CONSTRUCTION MEETING. 15. STREET LIGHTING IS REQUIRED. DEVELOPER SHALL COORDINATE WITH ELECTRIC UTILITY COMPANY FOR POLE LOCATION AND TYPE. THE DEVELOPER SHALL INSTALL, AT HIS COST. STREET SIGNS REPRESENTING THE NAMES OF ALL STREETS AT ALL

14. CONTRACTOR SHALL CONTACT THE CITY OF MASSILLON ENGINEERING

MASSILLON REGULATIONS. 16. WHEN SPECIFIED ON THE PLANS OR SP[ECIFICATIONS, CONTINGENCY ITEMS ARE TO BE PERFORMED ONLY UNDER THE DIRECTION OF THE CITY ENGINEER. THE CONTRACTOR SHALL NOT ORDER ANY CONTINGENCY MATERIAL OR PERFORM ANY WORK UNTIL DIRECTED BY THE CITY ENGINEER. THE ACTUAL WORK LOCATION AND QUANTITIES FOR SUCH ITEMS SHALL BE DOCUMENTED BY THE CONTRACTOR AND THE ENGINEER. THE DEVELOPER IS RESPONSIBLE FOR THE COST OF SUCH ITEMS AND

DIRECTIONAL SIGNS AS NECESSARY. AL SIGNS SHALL CONFORM WITH THE CITY OF

SHALL NOT BE PART OF THE BID DOCUMENT. 16a. BEFORE ACCEPTANCE OF THE ROAD PAVEMENT SUBGRADES BY THE CITY OF MASSILLON ENGINEER, SUBGRADES SHALL BE TESTED IN ACCORDANCE WITH O.D.O.T. ITEM 203.13. IN LIEU OF SUBGRADE TESTING PER ITEM 203.13, PROOF ROLLING IN

ACCORDANCE WITH O.D.O.T. ITEM 203.14 MAY BE SUBSTITUTED.

PAVEMENT DETAIL SHEET FOR A HANDICAP RAMP DETAIL.


16b. WHEREVER UNSTABLE SOIL SUBGRADE CONDITIONS ARE ENCOUNTERED THAT ARE UNSUITABLE PER O.D.O.T. 203 SPECIFICATION AND / OR DETERMINED BY THE CITY OF MASSILLON ENGINEERING DEPARTMENT, ADDITIONAL EXCAVATION AND SUBSEQUENT BACKFILLING SHALL BE DONE BY THE DEVELOPER'S CPNTRACTOR AND PAID FOR BY THE DEVELOPER UNTIL SUCH COPNDITIONS ARE CORRECTED AND APPROVED BY THE CITY OF MASSILLON ENGINEER.

16c. SUBGRADE TESTING OR PROOF ROLLING MUST BE WITNESSED AND APPROVED BY THE CITY OF MASSILLON ENGINEERING DEPARTMENT PRIOR TO PLACEMENT OF THE PAVEMENT SUBBASE MATERIAL. CONTRACTOR SHALL CONTACT THE CITY ENGINEERING DEPARTMENT AT (330) 830-1722

17. AS BUILT DRAWINGS ARE REQUIRED AND SHALL BE SUBMITTED TO THE CITY OF MASSILLON ENGINEERING DEPARTMENT UPON COMPLETION OF THE PROJECT. 18. CURBS SHALL BE DROPPED FOR HANDICAP RAMPS AT ALL INTERSECTIONS.

19. THE CONTRACTOR SHALL NOTIFY THE CITY OF MASSILLON FORE DEPARTMENT. POLICE DEPARTMENT, CITY ENGINEER AND LOCAL (MASSILLON TUSLAW, JACKSON AND PERRY) SCHOOL DIRECTOR AT LEAST 48 HOURS IN ADVANCE OF ANY STREET CLOSING OR TRAFFIC CHANGE.

SEE THE INTERSECTION DETAILS FOR THE GENERAL LOCATION OF THE RAMPS AND

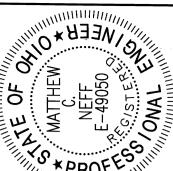

LAM ABOFESSIIII

S P.T.


S S 9

INTERSECTIONS. DEVELOPER SHALL ALSO BE RESPONSIBLE FOR STOP SIGNS AND

0 ഗ $\mathbf{\Phi}$

O

Horizontal Scale Vertical Scale Original Submission Last Plot Date Feb 06, 2007 Apr 27, 2007 Drawn By Checked By DLN Project Number Field Crew FS & BH 7323 Sheet

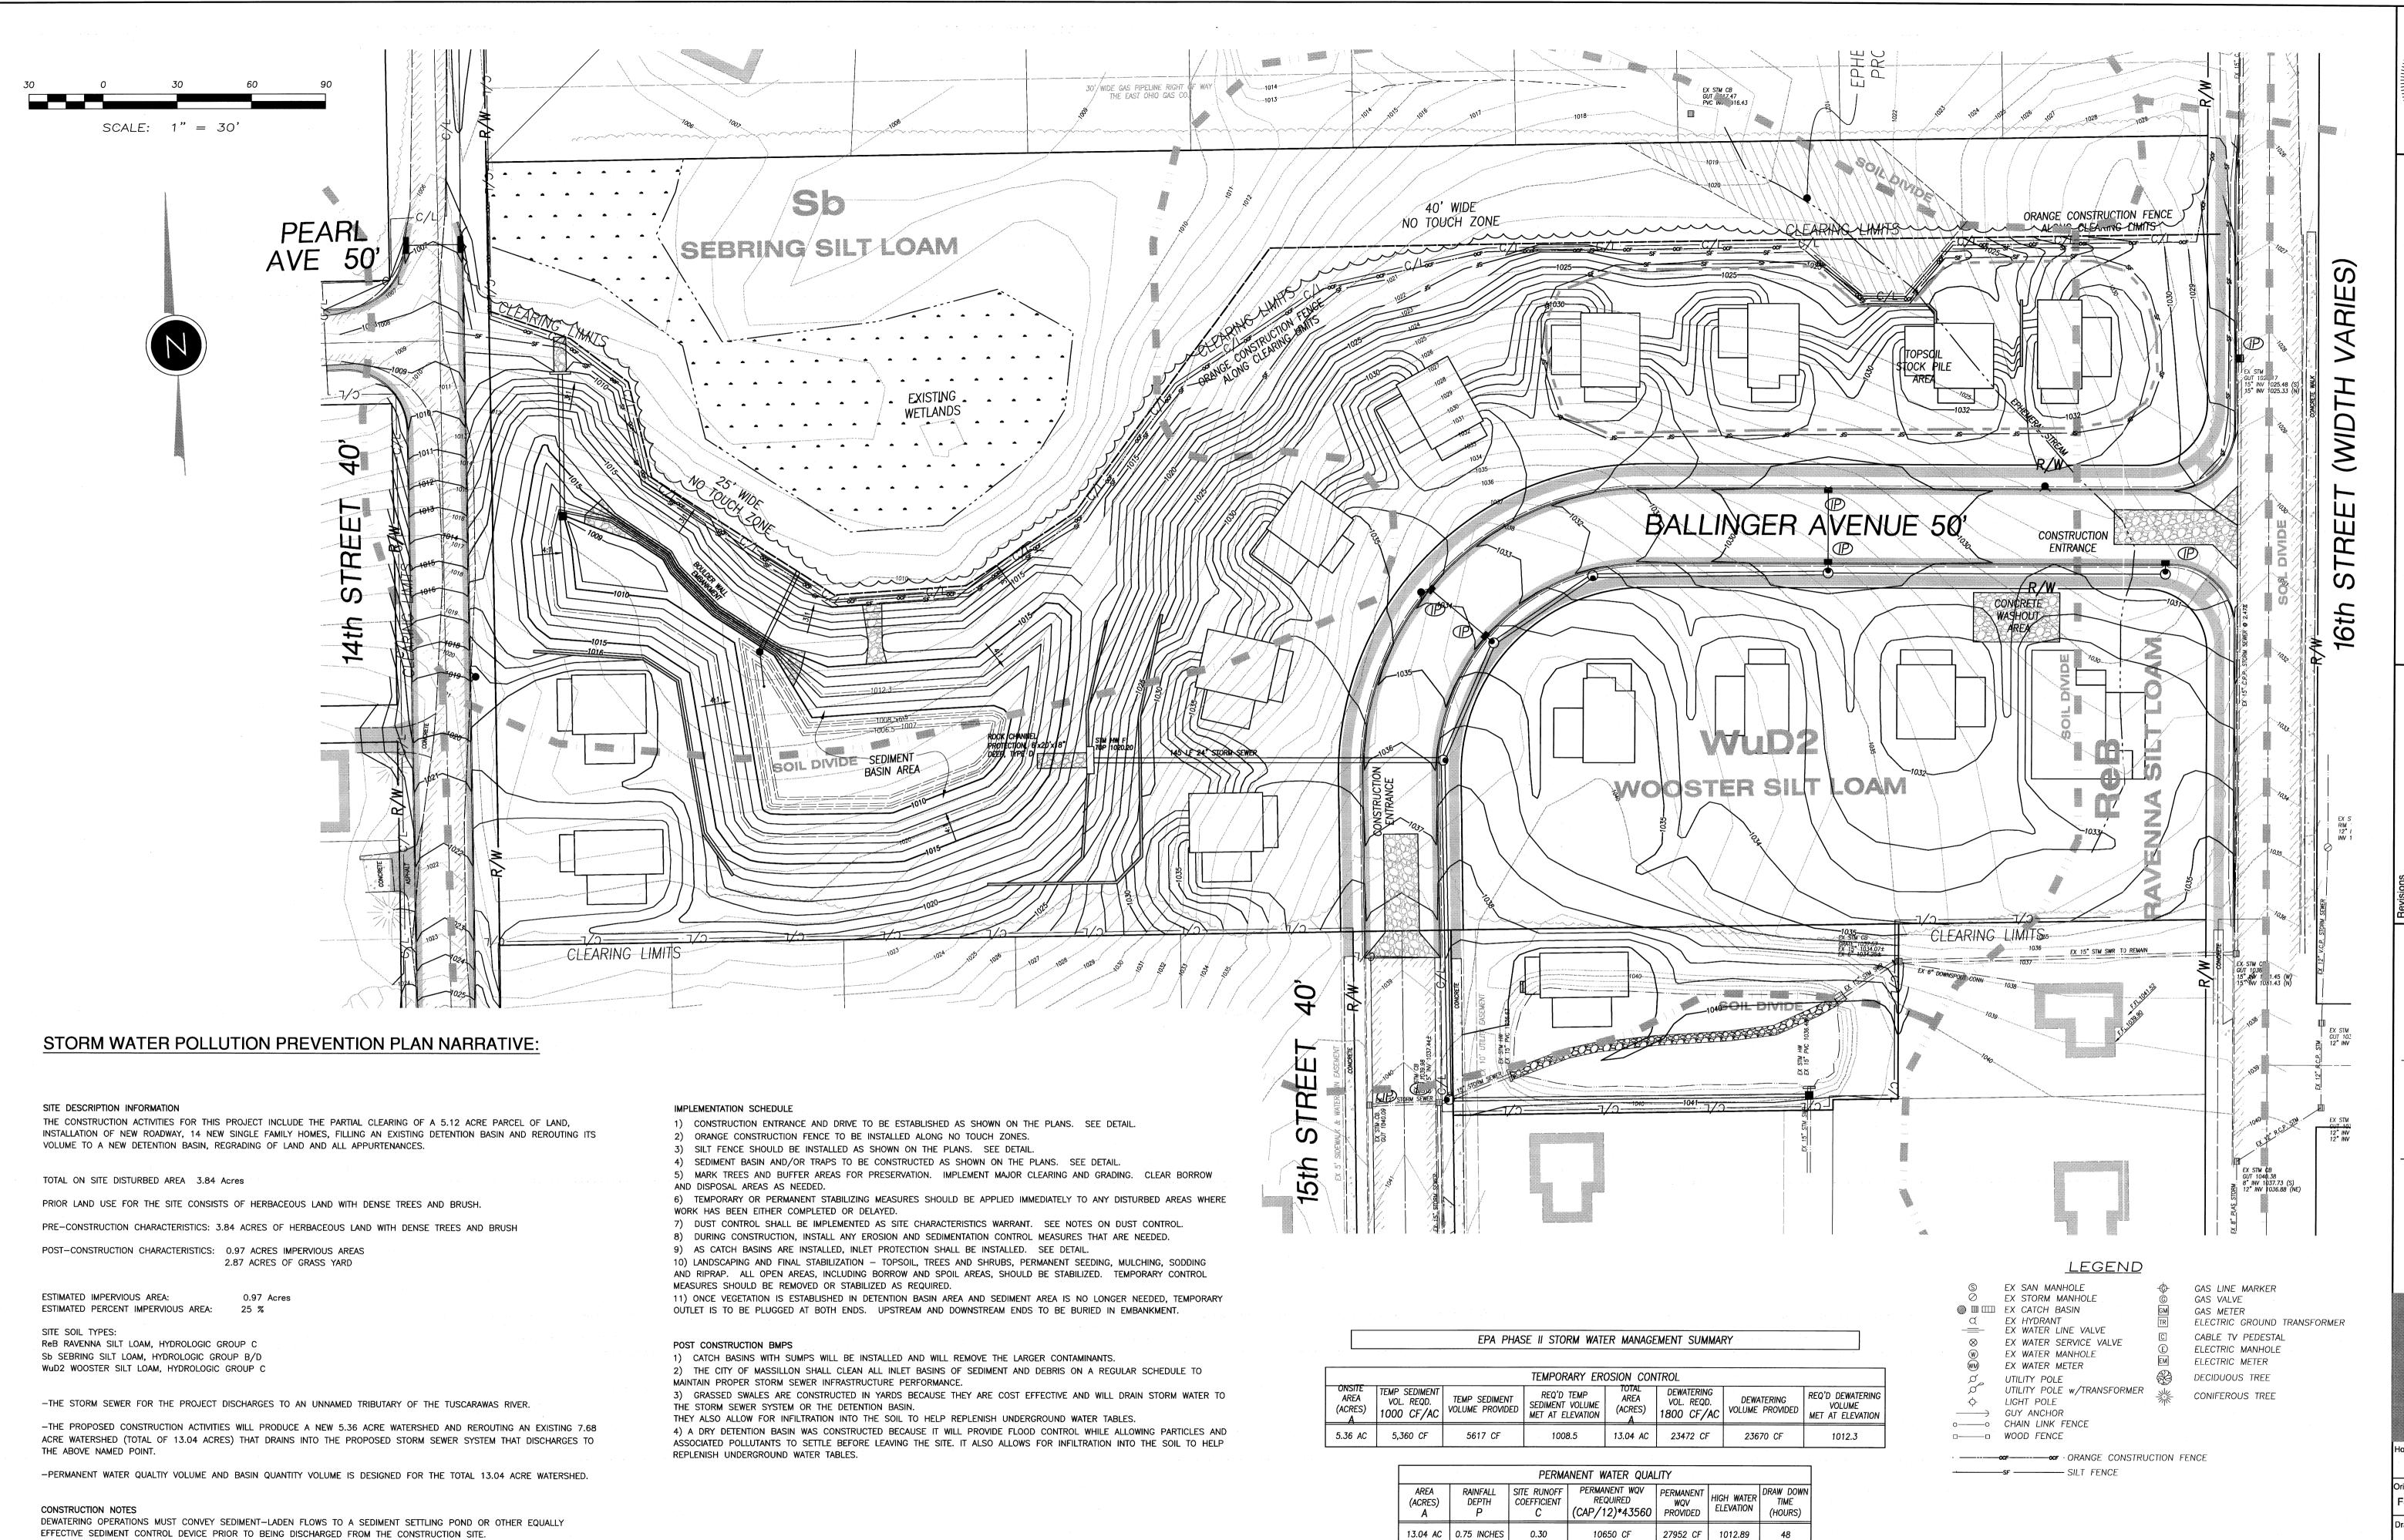

YARD INLET PROTECTION IS REQUIRED IN ALL PROPOSED TURF AREAS.

GRUBBING.

THE SEDIMENT BASIN AND SILT FENCE SHALL BE INSTALLED PRIOR TO GRADING AND WITHIN 7 DAYS FROM THE START OF

MATTHEW C. C. NEFF A050 VETER A05

IMPROVEMENT PLANS FOR: LLINGER ESTATES PHA

Number Date Description

EFF design of Colore world

Horizontal Scale

1" = 30'

Original Submission
Feb 06, 2007

Drawn By
DLN

Project Number
7323


Sheet


Vertical Scale


Checked Sy


Checked By

Field Crew
FS & BH

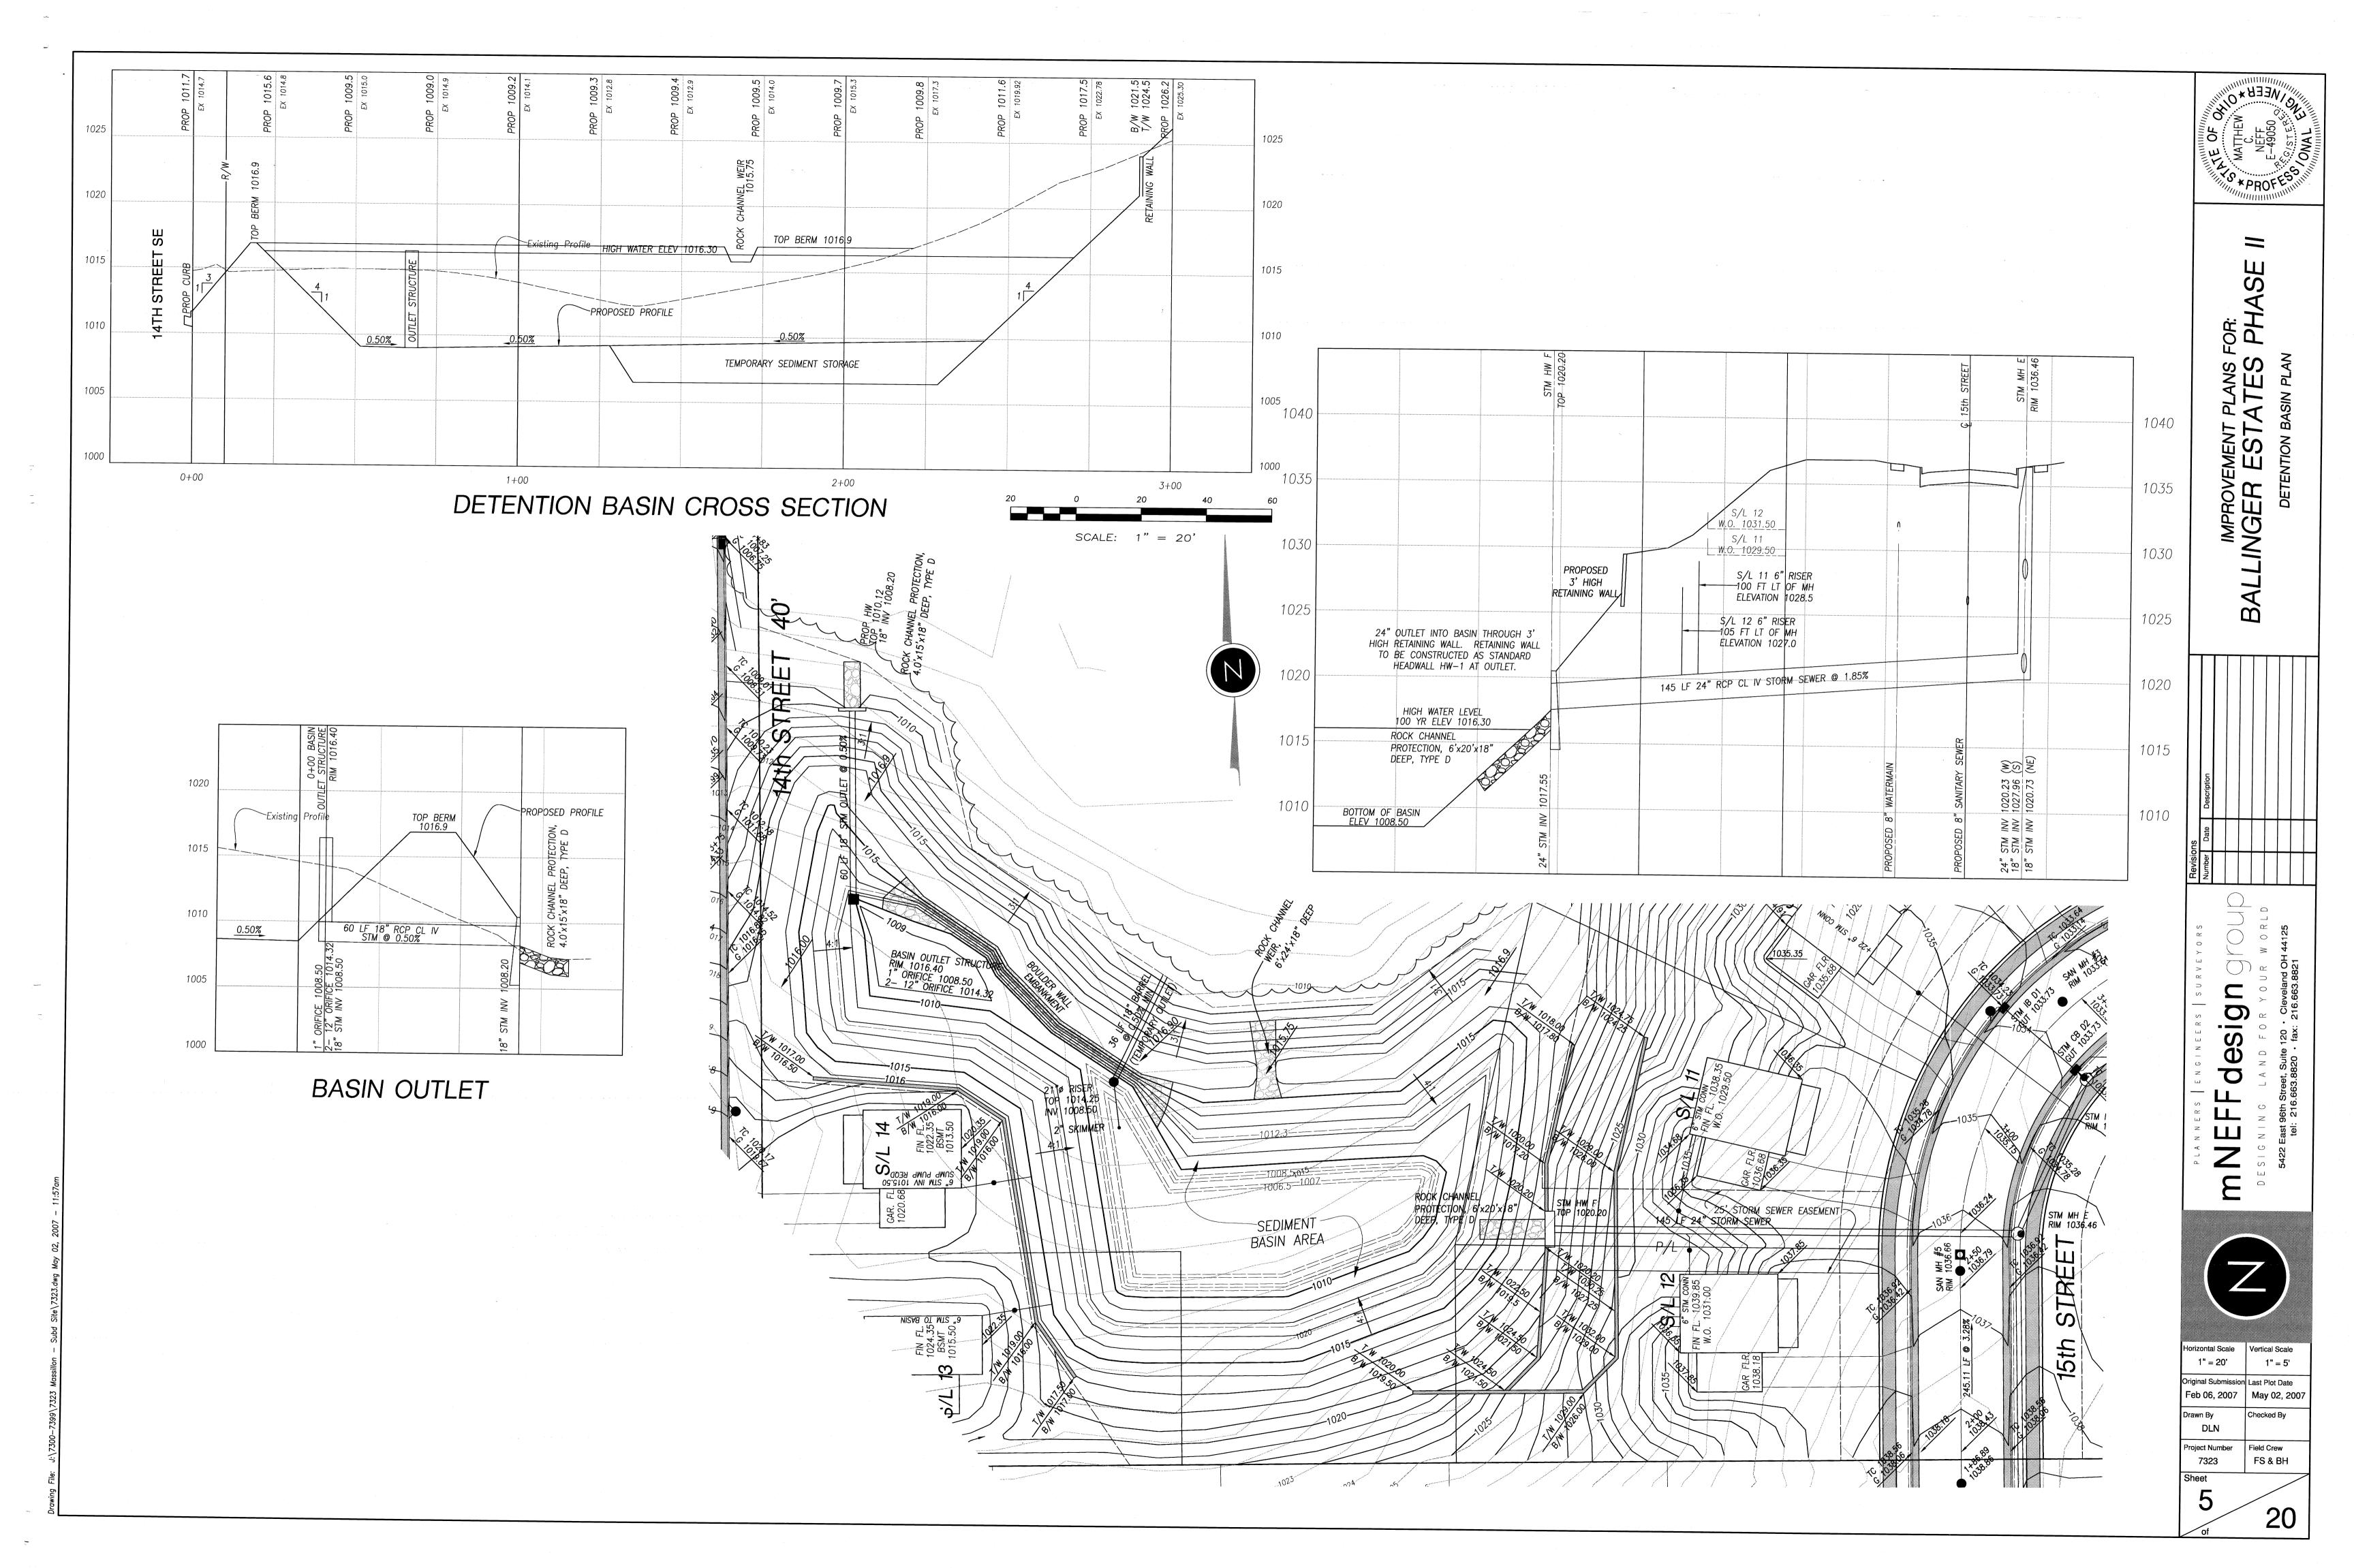


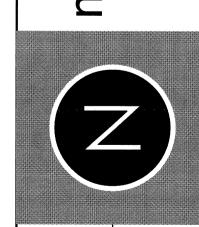

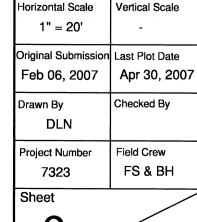


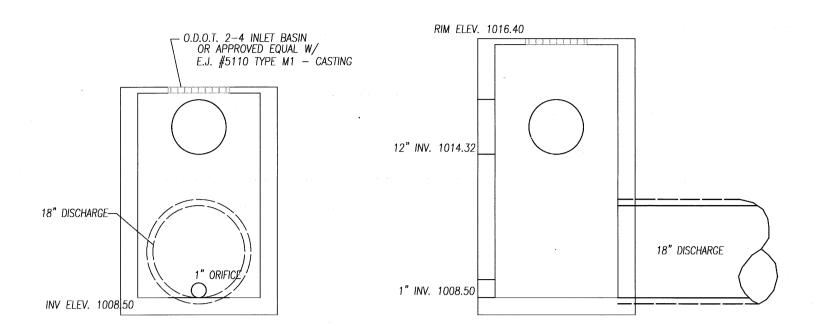

DETENTION BASIN OUTLET STRUCTURE

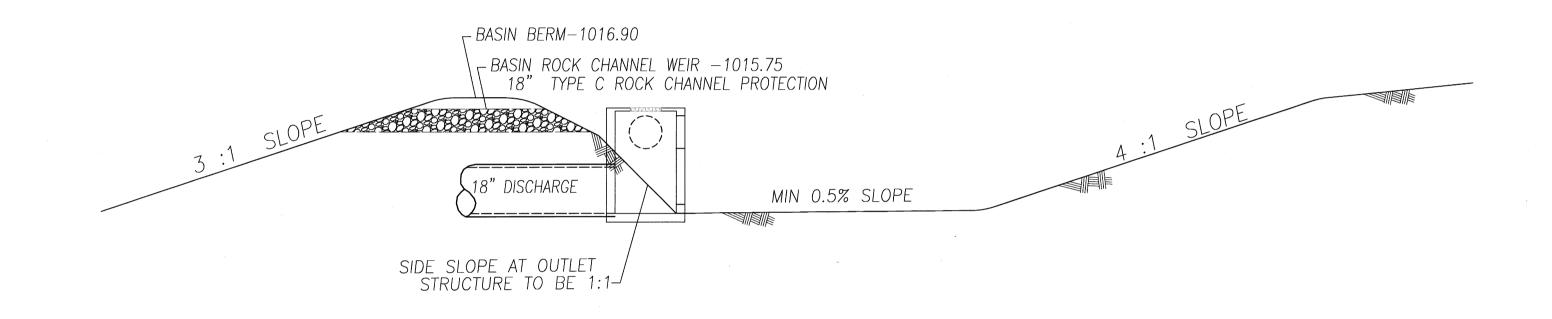


DETENTION BASIN DETAIL NOT TO SCALE

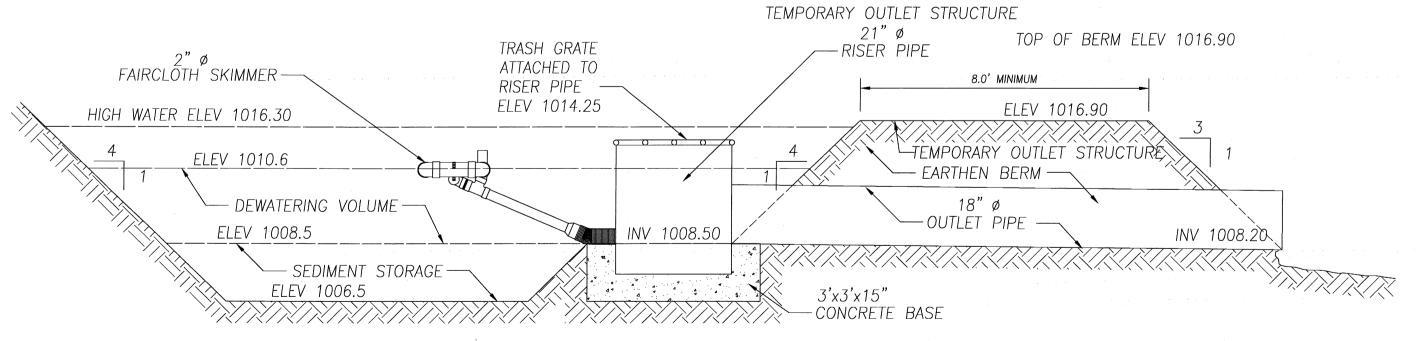


WHEN ALL IMPROVEMENTS ARE 90% COMPLETE, CONTRACTOR SHALL REMOVE 21" RISER PIPE, CONCRETE BASE AND FAIRCLOTH SKIMMER FROM BASIN. CUT 18" OUTLET PIPE INTO BERM, SEAL WITH GROUT AND GRADE OVER AT BOTH ENDS.

SEDIMENT BASIN DETAIL

NOT TO SCALE

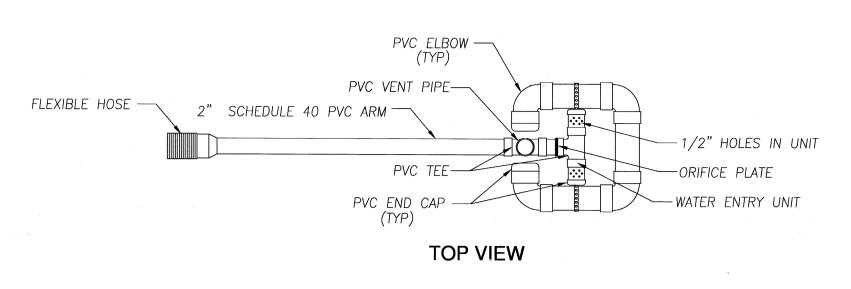

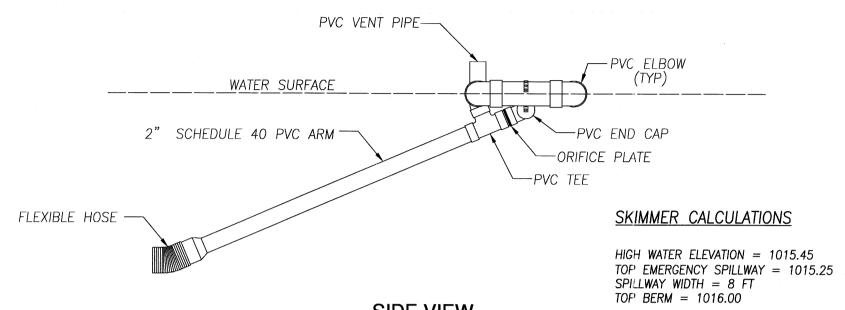


SIDE VIEW


FAIRCLOTH SKIMMER DETAIL

WWW.FAIRCLOTHSKIMMER.COM (919) 732-1244

SEDIMENT STORAGE INVERT = 1006.50 DEWATERING INVERT = 1008.50 FAIRCLOTH SKIMMER = 2" Ø $RISER = 21" \phi$ BARREL SIZE = 18" ø RISER CONCRETE BASE = 3'x3'x15"

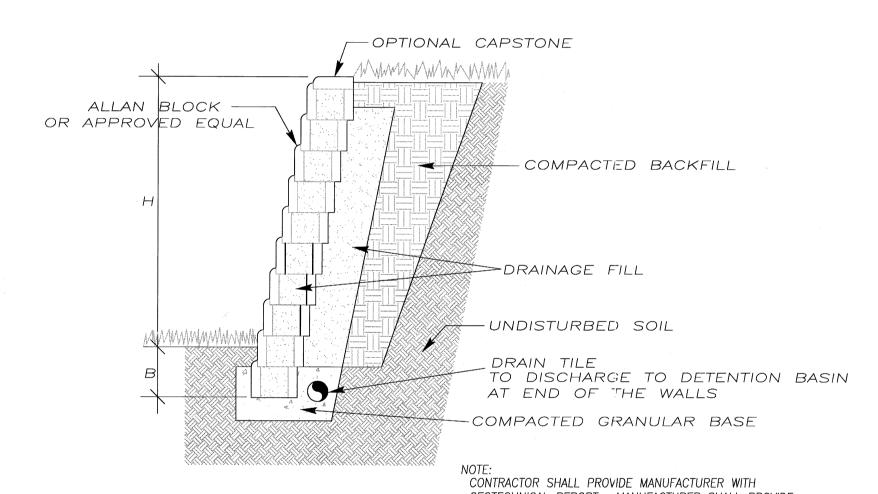

GEOTECHNICAL REPORT. MANUFACTURER WITH
GEOTECHNICAL REPORT. MANUFACTURER SHALL PROVIDE
RETAINING WALL CALCULATIONS AS PART OF SHOP DRAWING
APPROVAL TO THE CITY OF MASSILLON.

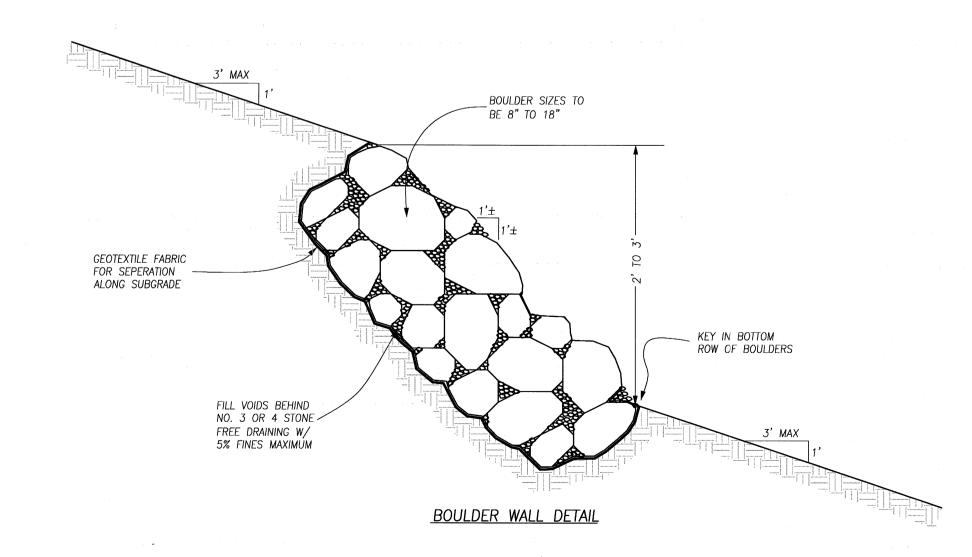

Horizontal Scale	Vertical Scale
NONE	
Original Submission	Last Plot Date
Feb 06, 2007	Apr 27, 2007
Drawn By	Checked By
-	
Project Number	Field Crew

7323

			•
	PER	MANENT SEEDING	G
	SE	EDING RATE	
SEED MIX	LB./AC.	LB./1,000 SQ FT	NO
****		GENERAL USE	
CREEPING RED FESCUE DOMESTIC RYEGRASS KENTUCKY BLUEGRASS	20-40 10-20 10-20	1/2 - 1 1/4 - 1/2 1/4 - 1/2	
TALL FESCUE	40	1	
DWARF FESCUE	40	1	
	STEEP	BANKS OR CUT SLC	PES
TALL FESCUE	40	1	
CROWN VETCH TALL FESCUE	10 20	1/4 1/2	DO NOT SEED L
FLAT PEA TALL FESCUE	20 20	1/2 1/2	DO NOT SEED L
	ROAD	DITCHES AND SWAL	ES
TALL FESCUE	40	1	
DWARF FESCUE KENTUCKY BLUEGRASS	90 5	2 1/4	
		LAWNS	
KENTUCKY BLUEGRASS	60	1 1/2	
	DOMESTIC RYEGRASS KENTUCKY BLUEGRASS TALL FESCUE DWARF FESCUE TALL FESCUE CROWN VETCH TALL FESCUE FLAT PEA TALL FESCUE TALL FESCUE DWARF FESCUE KENTUCKY BLUEGRASS	SEED MIX SEED MIX CREEPING RED FESCUE DOMESTIC RYEGRASS 10-20 KENTUCKY BLUEGRASS 10-20 TALL FESCUE 40 DWARF FESCUE 40 STEEP TALL FESCUE 40 CROWN VETCH TALL FESCUE 5LAT PEA TALL FESCUE 20 ROAD TALL FESCUE 40 ROAD TALL FESCUE 90 KENTUCKY BLUEGRASS 5	LB./AC. LB./1,000 SQ FI

PERENNIAL RYEGRASS

KENTUCKY BLUEGRASS

CREEPING RED FESCUE

TEMPORARY SEEDING

SPECIES

OATS

TALL FESCUE ANNUAL RYEGRASS

PERENNIAL RYEGRASS

TALL FESCUE

ANNUAL RYEGRASS

ANNUAL RYEGRASS

PERENNIAL RYEGRASS

CREEPING RED FESCUE

KENTUCKY BLUEGRASS OATS

TALL FESCUE

ANNUAL RYEGRASS

TALL FESCUE

ANNUAL RYEGRASS

WHEAT TALL FESCUE

ANNUAL RYEGRASS

PERENNIAL RYEGRASS

TALL FESCUE

ANNUAL RYEGRASS

ANNUAL RYEGRASS

PERENNIAL RYEGRASS

CREEPING RED FESCUE

KENTUCKY BLUEGRASS

TEMPORARY SEEDING PROVIDES EROSION CONTROL ON AREAS IN BETWEEN CONSTRUCTION OPERATIONS. GRASSES WHICH ARE QUICK GROWING ARE SEEDED AND USUALLY

TEMPORARY SEEDING SHOULD BE APPLIED ON DISTURBED AREAS WITHIN 7 DAYS IF THE AREA IS INTENDED TO BE DORMANT FOR GREATER THAN 21 DAYS OR WITHIN 2

DAYS IF THE AREA IS WITHIN 50 FEET OF JURISDICTIONAL WATER. THE TEMPORARY SEED MIX SHALL BE AN EQUAL MIXTURE OF PERENNIAL RYEGRASS, TALL FESCUE AND

TEMPORARY SEEDING

5 – 6 TONS | AIR DRY. ADD FERTILIZER N AT 12 lb / ton

1/2 - 1 TON | CONTINUOUS FIBERS OF DRAWN GLASS BOUND

TOGETHER WITH A NON-TOXIC AGENT

MULCHING IS A TEMPORARY EROSION CONTROL PRACTICE IN WHICH MATERIALS SUCH AS GRASS, HAY, WOOD CHIPS, WOOD FIBERS, STRAW, OR GRAVEL ARE PLACED ON

MULCHES MUST BE ANCHORED TO RESIST WIND DISPLACEMENT. NETTINGS SHOULD BE REMOVED WHEN PROTECTION IS NO LONGER NEEDED AND DISPOSED OF IN A

RAINSTORMS. SUCH AREAS SHOULD BE RESEEDED (IF NECESSARY) AND THE MULCH COVER REPLACED IMMEDIATELY. MULCH BINDERS SHOULD BE APPLIED AT RATES

SMALL SWALES OR DEPRESSIONS WHICH MAY CARRY SMALL CONCENTRATED FLOWS TO THE SILT FENCE ARE DISSIPATED ALONG ITS LENGTH.

RECOMMENDED BY THE MANUFACTURER. IF WASHOUT, BREAKAGE, OR EROSION OCCURS, SURFACES SHOULD BE REPAIRED, RESEEDED, AND REMULCHED, AND NEW NETTING

MULCHING

2) ALL SILT FENCE SHALL BE PLACED AS CLOSE TO THE CONTOUR AS POSSIBLE SO THAT WATER WILL NOT CONCENTRATE AT LOW POINTS IN THE FENCE AND SO THAT

3) TO PREVENT WATER PONDED BY THE SILT FENCE FROM FLOWING AROUND THE ENDS, EACH END SHALL BE CONSTRUCTED UPSLOPE SO THAT THE ENDS ARE AT A

5) WHERE POSSIBLE, VEGETATION SHALL BE PRESERVED FOR 5 FT. (OR AS MUCH AS POSSIBLE) UPSLOPE FROM THE SILT FENCE. IF VEGETATION IS REMOVED, IT SHALL

8) POSTS SHALL BE A MINIMUM OF 5 FEET LONG, 2 INCHES IN DIAMETER AND SPACED A MAXIMUM OF 10 FEET APART AT THE BARRIER LOCATION AND DRIVEN SECURELY

9) THE SILT FENCE SHALL BE PLACED IN A TRENCH CUT A MINIMUM OF 6 INCHES DEEP. THE TRENCH SHALL BE CUT WITH A TRENCHER, CABLE LAYING MACHINE, OR

11) WHEN EXTRA STRENGTH FILTER FABRIC AND CLOSER POST SPACING ARE USED, THE WIRE MESH SUPPORT FENCE MAY BE ELIMINATED. IN SUCH A CASE, THE FILTER

12) THE STANDARD STRENGTH FILTER FABRIC SHALL BE STAPLED OR WIRED TO THE FENCE, AND 8 INCHES OF THE FABRIC SHALL BE EXTENDED INTO THE TRENCH. THE

13) SEAMS BETWEEN SECTION OF SILT FENCE SHALL BE OVERLAPPED WITH THE END STAKES OF EACH SECTION WRAPPED TOGETHER BEFORE DRIVING INTO THE GROUND.

14) SILT FENCE SHALL ALLOW RUNOFF TO PASS ONLY AS DIFFUSE FLOW THROUGH THE GEOTEXTILE. IF RUNOFF OVERTOPS THE SILT FENCE, FLOWS UNDER OR AROUND THE ENDS, OR IN ANY OTHER WAY BECOMES A CONCENTRATED FLOW, ONE OF THE FOLLOWING SHALL BE PERFORMED, AS APPROPRIATE: A) THE LAYOUT OF THE SILT

SILT FENCE SHOULD BE INSPECTED REGULARLY AND FREQUENTLY AS WELL AS AFTER EACH RAINFALL EVENT TO INSURE THAT THEY ARE INTACT AND THERE ARE NO GAPS AT THE FENCE-GROUND INTERFACE OR TEARS ALONG THE LENGTH OF THE FENCE. IF GAPS OR TEARS ARE FOUND, THEY SHOULD BE REPAIRED OR THE FABRIC REPLACED

IMMEDIATELY. ACCUMULATED SEDIMENTS SHOULD BE REMOVED FROM THE FENCE BASE WHEN THE SEDIMENT REACHES ONE—THIRD TO ONE—HALF THE HEIGHT OF THE

FENCE. SEDIMENT REMOVAL SHOULD OCCUR MORE FREQUENTLY IF ACCUMULATED SEDIMENT IS CREATING NOTICEABLE STRAIN ON THE FABRIC AND THERE IS THE

POSSIBILITY OF THE FENCE FAILING FROM A SUDDEN STORM EVENT. WHEN THE SILT FENCE IS REMOVED, THE ACCUMULATED SEDIMENT SHOULD BE REMOVED.

10) THE SILT FENCE SHALL BE PLACED WITH THE STAKES ON THE DOWNSLOPE SIDE OF THE GEOTEXTILE AND SO THAT 8 IN. OF CLOTH ARE BELOW THE GROUND

FABRIC SHALL NOT EXTEND MORE THAN 36 INCHES ABOVE THE ORIGINAL GROUND SURFACE. FILTER FABRIC SHALL NOT BE STAPLED TO EXISTING TREES,

7) THE FILTER FABRIC SHALL BE PURCHASED IN A CONTINUOUS ROLL CUT TO THE LENGTH OF THE BARRIER TO AVOID THE USE OF JOINTS. WHEN JOINTS ARE

NECESSARY, FILTER CLOTH SHALL BE SPLICED TOGETHER ONLY AT A SUPPORT POST, WITH A MINIMUM 6 INCH OVERLAP, AND SECURELY SEALED.

INTO THE GROUND. WHEN EXTRA STRENGTH FABRIC IS USED WITHOUT THE WIRE SUPPORT FENCE, POST SPACING SHALL NOT EXCEED 6 FEET.

SURFACE. EXCESS MATERIAL SHALL LAY ON THE BOTTOM OF THE 6 IN. DEEP TRENCH. THE TRENCH SHALL BE BACKFILLED AND COMPACTED.

FENCE SHALL BE CHANGED, B) ACCUMULATED SEDIMENT SHALL BE REMOVED, OR C) OTHER PRACTICES SHALL BE INSTALLED.

LANDFILL OR COMPOSTED. MULCHED AREAS SHOULD BE INSPECTED FREQUENTLY TO IDENTIFY AREAS WHERE MULCH HAS LOOSENED OR BEEN REMOVED, ESPECIALLY AFTER

EXPOSED OR RECENTLY PLANTED SOIL SURFACES. MULCHING IS HIGHLY RECOMMENDED AS A STABILIZATION METHOD AND IS MOST EFFECTIVE WHEN USED IN CONJUNCTION

WITH VEGETATIVE ESTABLISHMENTS. MULCH MATTINGS ARE MATERIALS SUCH AS JUTE OR OTHER WOOD FIBERS THAT ARE FORMED INTO SHEETS AND ARE MORE STABLE THAN

UTE YARN. USED WITH ORGANIC MULCH

COVER AREA HEAVY, UNIFORM; WOVEN OF SINGLE

MULCHED TO PROVIDE PROMPT TEMPORARY SOIL STABILIZATION. IT EFFECTIVELY MINIMIZES THE AREA OF A CONSTRUCTION-SITE PRONE TO EROSION AND SHOULD BE USED

NOVEMBER 1 TO FEBRUARY 29 USE MULCH ONLY OR DORMANT SEEDING

EVERYWHERE THE SEQUENCE OF CONSTRUCTION OPERATIONS ALLOWS VEGETATION TO BE ESTABLISHED.

NOTE: OTHER APPROVED SEED SPECIES MAY BE SUBSTITUTED

ANNUAL RYEGRASS (1/3 EACH) SPREAD AT A RATE OF 3 POUNDS PER 1000 SQ. FT.

XCELSIOR (WOOD

FIBERGLASS ROVING

LOOSE MULCH. SEE TABLE BELOW FOR TYPICAL MULCHING MATERIALS AND APPLICATION RATES.

SHOULD BE INSTALLED. INSPECTIONS SHOULD BE CONTINUED UNTIL VEGETATION IS FIRMLY ESTABLISHED.

1) SILT FENCE SHALL BE CONSTRUCTED BEFORE UPSLOPE LAND DISTURBANCE BEGINS.

4) WHERE POSSIBLE, SILT FENCE SHALL BE PLACED ON THE FLATTEST AREA AVAILABLE.

OTHER SUITABLE DEVICE WHICH WILL ENSURE AN ADEQUATELY UNIFORM TRENCH DEPTH.

FABRIC IS STAPLED OR WIRED DIRECTLY TO THE POSTS.

6) THE HEIGHT OF THE SILT FENCE SHALL BE A MINIMUM OF 16 IN. ABOVE THE ORIGINAL GROUND SURFACE.

BE REESTABLISHED WITHIN 7 DAYS FROM THE INSTALLATION OF THE SILT FENCE.

FIBER) MAT

MAINTENANCE:

HIGHER ELEVATION.

SEEDING DATES

MARCH 1 TO AUGUST 15

AUGUST 16 TO OCTOBER 3

SEEDING RATE

LB./AC.

28 (4 BUSHEL

40

40

40

17

128 (3 BUSHEL)

112 (2 BUSHEL)

40

120 (2 BUSHEL)

40

40

40

40

LB./1,000 SQ FT|

1.25

3.25

0.4

0.4

1.25

3.25

0.4

0.4

USE W/ HYDROSEEDER; MAY BE USED TO TAC

STRAW. DO NOT USE IN HOT, DRY WEATHER

OR BY HAND. DON NOT USE ASPHALT TACK.

APPLY WITH COMPRESSED AIR EJECTOR. TACK

W/ EMULSIFIED ASPHALT AT 25-35 gal/1000 sf

PERMANENT SEEDING IS USED TO CONTROL RUNOFF AND EROSION ON DISTURBED AREAS BY ESTABLISHING PERENNIAL VEGETATIVE COVER FROM SEED.THIS PRACTICE IS ECONOMICAL, ADAPTABLE TO DIFFERENT SITE CONDITIONS, AND ALLOWS SELECTION OF THE MOST APPROPRIATE PLANT MATERIALS. AREAS TO BE STABILIZED WITH PERMANENT VEGETATION MUST BE SEEDED OR PLANTED 1 TO 4 MONTHS AFTER THE FINAL GRADE IS ACHIEVED UNLESS TEMPORARY STABILIZATION MEASURES ARE IN PLACE. SUCCESSFUL PLANT ESTABLISHMENT CAN BE MAXIMIZED WITH PROPER PLANNING; CONSIDERATION OF SOIL CHARACTERISTICS; SELECTION OF PLANT MATERIALS THAT ARE SUITABLE FOR THE SITE; ADEQUATE SEEDBED PREPARATION, LIMING, AND FERTILIZATION; TIMELY PLANTING; AND REGULAR MAINTENANCE.

1 1/2

1 1/2

1 1/2

GRASSES SHOULD EMERGE WITHIN 4-28 DAY AND LEGUMES 5-28 DAYS AFTER SEEDING, WITH LEGUMES FOLLOWING GRASSES. A SUCCESSFUL STAND SHOULD EXHIBIT THE

VIGOROUS DARK GREEN OR BLUISH GREEN SEEDLINGS, NOT YELLOW UNIFORM DENSITY, WITH NURSE PLANTS, LEGUMES, AND GRASSES WELL INTERMIXED GREEN LEAVES - PERENNIALS SHOULD REMAIN GREEN THROUGHOUT THE SUMMER, AT LEAST AT THE PLANT BASES.

60

60

NOTE: OTHER APPROVED SEED SPECIES MAY BE SUBSTITUTED

NOT USE NITROGEN FERTILIZER IF THE STAND CONTAINS MORE THAT 20 PERCENT LEGUMES.

SEEDED AREAS SHOULD BE INSPECTED FOR FAILURE, AND NECESSARY REPAIRS AND RESEEDING SHOULD BE MADE AS SOON AS POSSIBLE. IF A STAND HAS INADEQUATE COVER. THE CHOICE OF PLANT MATERIALS AND QUANTITIES OF LIME AND FERTILIZER SHOULD BE REEVALUATED. DEPENDING ON THE CONDITION OF THE STAND, AREAS CAN BE REPAIRED BY OVERSEEDING OR RESEEDING AFTER COMPLETE SEEDBED PREPARATION. IF TIMING IS BAD. RYE GRAIN OR GERMAN MILLET CAN BE OVERSEEDED TO THICKEN THE STAND UNTIL A SUITABLE TIME FOR SEEDING PERENNIALS. CONSIDER SEEDING TEMPORARY, ANNUAL SPECIES IF THE SEASON IS NOT APPROPRIATE FOR PERMANENT SEEDING. IF VEGETATION FAILS TO GROW, SOIL SHOULD BE TESTED TO DETERMINE IF LOW PH OR NUTRIENT IMBALANCES ARE RESPONSIBLE. ON A TYPICAL DISTURBED SITE, FULL PLANT ESTABLISHMENT USUALLY REQUIRES REFERTILIZATION IN THE SECOND GROWING SEASON. SOIL TESTS CAN BE USED TO DETERMINE IF MORE FERTILIZER NEEDS TO BE ADDED. DO NOT FERTILIZE COOL SEASON GRASSES IN LATE MAY THROUGH JULY. GRASS THAT LOOKS YELLOW MAY BE NITROGEN DEFICIENT. DO

PERMANENT SEEDING

CONSTRUCTION SEQUENCING AND DISTURBING ONLY SMALL AREAS AT A TIME CAN GREATLY REDUCE PROBLEMATIC DUST FROM THE SITE. IF LAND MUST BE DISTURBED, ADDITIONAL TEMPORARY STABILIZATION MEASURES SHOULD BE CONSIDERED PRIOR TO DISTURBANCES.

1) SPRINKLING THE GROUND SURFACE WITH WATER UNTIL IT IS MOIST IS AN EFFECTIVE DUST CONTROL MEASURE FOR HAUL ROADS AND OTHER TRAFFIC ROUTES.

2) IN AREAS NOT EXPECTED TO HANDLE VEHICULAR TRAFFIC, VEGETATIVE STABILIZATION OF THE SOIL IS OFTEN DESIRABLE. THIS CAN BE ACHIEVED THROUGH TEMPORARY OR PERMANENT SEEDING OR SODDING AS LOCAL CONDITIONS WARRANT.


3) MULCHING CAN BE A QUICK AND EFFECTIVE MEANS OF DUST CONTROL FOR A RECENTLY DISTURBED AREA.

4) WIND BREAKS CAN BE EITHER NATURAL OR CONSTRUCTED THAT WILL REDUCE WIND VELOCITY THROUGH THE SITE. THEY CAN BE TREES OR SHRUBS LEFT IN PLACE DURING SITE CLEARING, OR CONSTRUCTED BARRIERS SUCH AS WIND FENCE, SNOW FENCE, TARP CURTAIN, HAY BALE, CRATE WALL OR SEDIMENT WALL.

5) STONE MAY BE AN EFFECTIVE DUST DETERRENT FOR CONSTRUCTION ROADS AND ENTRANCES OR AS A MULCH IN AREAS WHERE VEGETATION CANNOT BE ESTABLISHED.

DUST CONTROL MEASURES INVOLVING WATER REQUIRE MORE MONITORING THAN STRUCTURAL OR VEGETATIVE CONTROLS TO REMAIN EFFECTIVE. IF STRUCTURAL CONTROLS ARE USED, THEY SHOULD BE INSPECTED FOR DETERIORATION ON A REGULAR BASIS TO ENSURE THAT THEY ARE STILL ACHIEVING THEIR INTENDED PURPOSE.

DUST CONTROL

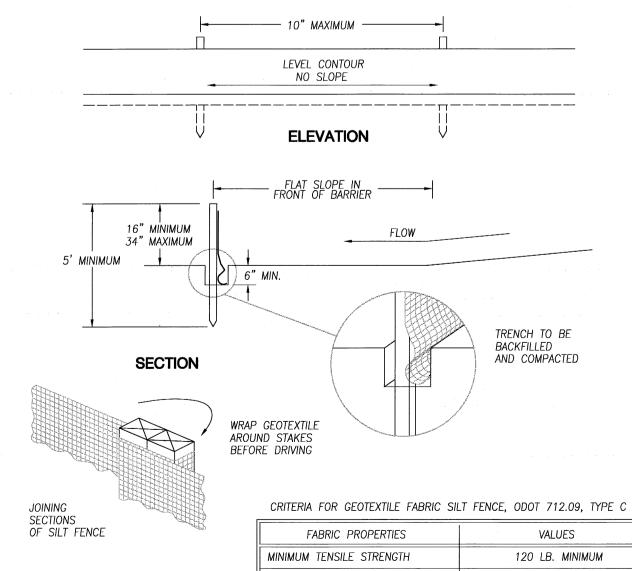

MINIMUM BURST STRENGTH

APPARENT OPENING SIZE

ULTRAVIOLET RADIATION STABILITY

SLURRY FLOW RATE

SILT FENCE

200 PSI MINIMUM 0.3 GAL./MIN./F2 MAXIMUM AOS ≤ 0.84 mm

90% MINIMUM

SITE INSPECTIONS SHALL BE DONE WEEKLY AND AFTER EVERY RAINFALL EVENT EXCEEDING 1/2" OF RAINFALL. ALL NECESSARY REPAIRS SHOULD BE IMPLEMENTED IMMEDIATELY AFTER SUCH INSPECTIONS.

CONTRACTOR SHALL BE RESPONSIBLE FOR PREPARING WEEKLY EROSION CONTROL INSPECTION REPORTS. SUCH REPORTS SHALL BE MADE AVAILABLE TO OWNER, ENGINEER AND CITY / STATE OFFICIALS UPON THEIR REQUEST.

- VELCRO CLOSURE

INSTALLATION: 1. STAND THE GRATE ON END. 2. PLACE THE SILT BAG OVER THE GRATE. 3. ROLL THE GRATE OVER SO THAT THE OPEN END IS UP. 4. PULL UP THE BAG.

5. TUCK THE FLAP IN. 6. PRESS THE VELCRO STRAPS TOGETHER.

7. BE SURE THAT THE END OF THE GRATE IS COMPLETELY COVERED BY THE FLAP OR THE SILT BAG WILL NOT WORK PROPERLY. 8. HOLDING THE HANDLES, CAREFULLY PLACE THE SILT BAG WITH THE GRATE

INSERTED INTO THE CATCH BASIN FRAME. **MAINTENANCE:**

TO INSURE PROPER OPERATION REMOVE SILT, SEDIMENT, AND DEBRIS FROM THE SURFACE AND THE VICINITY OF THE UNIT WITH A SQUARE POINT SHOVEL OR STIFF BRISTLE BROOM AWAY FROM ENVIRONMENTALLY SENSITIVE AREAS AND WATERWAYS IN MANNER SATISFACTORY TO THE ENGINEER/INSPECTOR. REMOVE FINE MATERIAL FROM INSIDE SILT BAG AS NEEDED. DISPOSE OF SILT BAG NO LONGER IN USE AT AN APPROPRIATE RECYCLING OR SOLID WASTE FACILITY.

INLET INSPECTION:

TO INSPECT INLET, REMOVE SILT BAG WITH GRATE INSIDE, INSPECT CATCH BASIN AND REPLACE SILT BAG BACK INTO GRATE FRAME.

PONDING IS LIKELY IF SEDIMENT IS NOT REMOVED REGULARLY. THE SILT BAG MUST NEVER BE USED WHERE OVERFLOW MAY ENDANGER AN EXPOSED SLOPE.

SILT BAG INLET PROTECTION

SIDE ELEVATION -EXISTING PAVEMENT * MUST EXTEND FULL WIDTH - ODOT # 1 OF INGRESS AND EGRESS COURSE AGGREGATE <u>PLAN VIEW</u>

6" MIN. ¬

GEOTEXTILE FILTER FABRIC (MIN GRAB TENSILE STRENGTH = 200 LB

MIN MULLEN BURST STRENGTH = 190 LB)

SECTION A-A

1) MAINTENANCE AS REQUIRED AND DIRECTED BY THE ENGINEERING DEPARTMENT

—FILTER CLOTH

2) CONSTRUCTION ENTRANCES SHALL NOT BE RELIED UPON TO REMOVE MUD FROM VEHICLES AND PREVENT OFF-SITE TRACKING. VEHICLES THAT ENTER AND LEAVE THE CONSTRUCTION SITE SHALL BE RESTRICTED FROM MUDDY PLACES.

SECTION A-A

MAINTENANCE:

A TOP DRESSING OF ADDITIONAL STONE SHALL BE APPLIED AS CONDITIONS DEMAND. MUD SPILLED, DROPPED, WASHED OR TRACKED ONTO PUBLIC ROADS, OR ANY OTHER SURFACE WHERE RUNOFF IS NOT CHECKED BY SEDIMENT CONTROLS, SHALL BE REMOVED IMMEDIATELY. REMOVAL SHALL BE ACCOMPLISHED BY SCRAPING OR SWEEPING.

STONE CONSTRUCTION ENTRANCE

— EXISTING PAVEMENT

-MOUNTABLE BERM

LATER THAN AUGUST

LATER THAN AUGUST

FOR SHADED AREAS

1) INLET PROTECTION SHALL BE CONSTRUCTED EITHER BEFORE UPSLOPE LAND DISTURBANCE BEGINS OR BEFORE THE STORM DRAIN BECOMES OPERATIONAL.

2) SILT FENCE SHALL BE GEOTEXTILE FABRIC, ODOT 712.09, TYPE C, AND SHOULD BE CUT FROM A CONTINUOUS ROLL TO

3) STAKES SHALL BE 1" x 2" WOOD (PREFERRED) OR EQUIVALENT METAL WITH A MINIMUM LENGTH OF 3 FEET. STAKES SHALL BE SPACED AROUND THE PERIMETER OF THE INLET A MAXIMUM OF 3 FEET APART AND SECURELY DRIVEN INTO THE GROUND (MINIMUM OF 8 INCHES). THE TOP OF THE FRAME SHALL BE AT LEAST 6 IN. BELOW ADJACENT ROADS IF PONDED WATER WOULD POSE A SAFETY HAZARD TO TRAFFIC.

SHALL BE STRETCHED TIGHTLY AROUND THE FRAME AND FASTENED SECURELY TO THE FRAME.

4) WIRE MESH SHALL BE OF SUFFICIENT STRENGTH TO SUPPORT FABRIC WITH WATER FULLY IMPOUNDED AGAINST IT. IT

5) THE SILT FENCE SHALL BE STAPLED WITH HEAVY DUTY WIRE STAPLES AT LEAST 1/2 INCH LONG, TO THE WOODEN STAKES, AND 8 INCHES OF THE FABRIC SHALL BE EXTENDED INTO THE TRENCH. THE HEIGHT OF THE FILTER BARRIER SHALL BE A MINIMUM OF 15 INCHES AND SHALL NOT EXCEED 18 INCHES (PLATE 1.08B)

6) THE GEOTEXTILE SHALL OVERLAP ACROSS ONE SIDE OF THE INLET SO THE ENDS OF THE CLOTH ARE NOT FASTENED TO


7) A TRENCH SHALL BE EXCAVATED APPROXIMATELY 4 INCHES WIDE AND 4 INCHES DEEP AROUND THE OUTSIDE PERIMETER

8) BACKFILL SHALL BE PLACED AROUND THE INLET IN COMPACTED 6 IN. LAYERS UNTIL THE EARTH IS EVEN WITH NOTCH ELEVATION ON ENDS AND TOP ELEVATION ON SIDES.

9) A COMPACTED EARTH DIKE OR A CHECK DAM SHALL BE CONSTRUCTED IN THE DITCH LINE BELOW THE INLET IF THE INLET IS NOT IN A DEPRESSION AND IF RUNOFF BYPASSING THE INLET WILL NOT FLOW TO A SETTLING POND. THE TOP OF EARTH DIKES SHALL BE AT LEAST 6 IN. HIGHER THAN THE TOP OF THE FRAME.

MAINTENANCE: SILT FENCE SHOULD BE INSPECTED REGULARLY AND FREQUENTLY AS WELL AS AFTER EACH RAINFALL EVENT TO INSURE THAT THEY ARE INTACT AND THERE ARE NO GAPS AT THE FENCE-GROUND INTERFACE OR TEARS ALONG THE LENGTH OF THE FENCE. IF GAPS OR TEARS ARE FOUND, THEY SHOULD BE REPAIRED OR THE FABRIC REPLACED IMMEDIATELY. ACCUMULATED SEDIMENTS SHOULD BE REMOVED FROM THE FENCE BASE WHEN THE SEDIMENT REACHES ONE—THIRD TO ONE-HALF THE HEIGHT OF THE FENCE. SEDIMENT REMOVAL SHOULD OCCUR MORE FREQUENTLY IF ACCUMULATED SEDIMENT IS CREATING NOTICEABLE STRAIN ON THE FABRIC AND THERE IS THE POSSIBILITY OF THE FENCE FAILING FROM A SUDDEN STORM EVENT. WHEN THE SILT FENCE IS REMOVED, THE ACCUMULATED SEDIMENT SHOULD BE REMOVED.

REINFORCED WITH LAYER

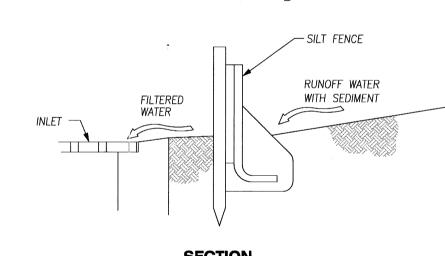


YARD INLET PROTECTION

FLAP FOLDS OVER TO ENCLOSE GRATE LIFTING STRAPS WOVEN MONOFILAMENT FABRIC BAG


SILT BAG-

⊨ CONCRETE CATCH BASIN

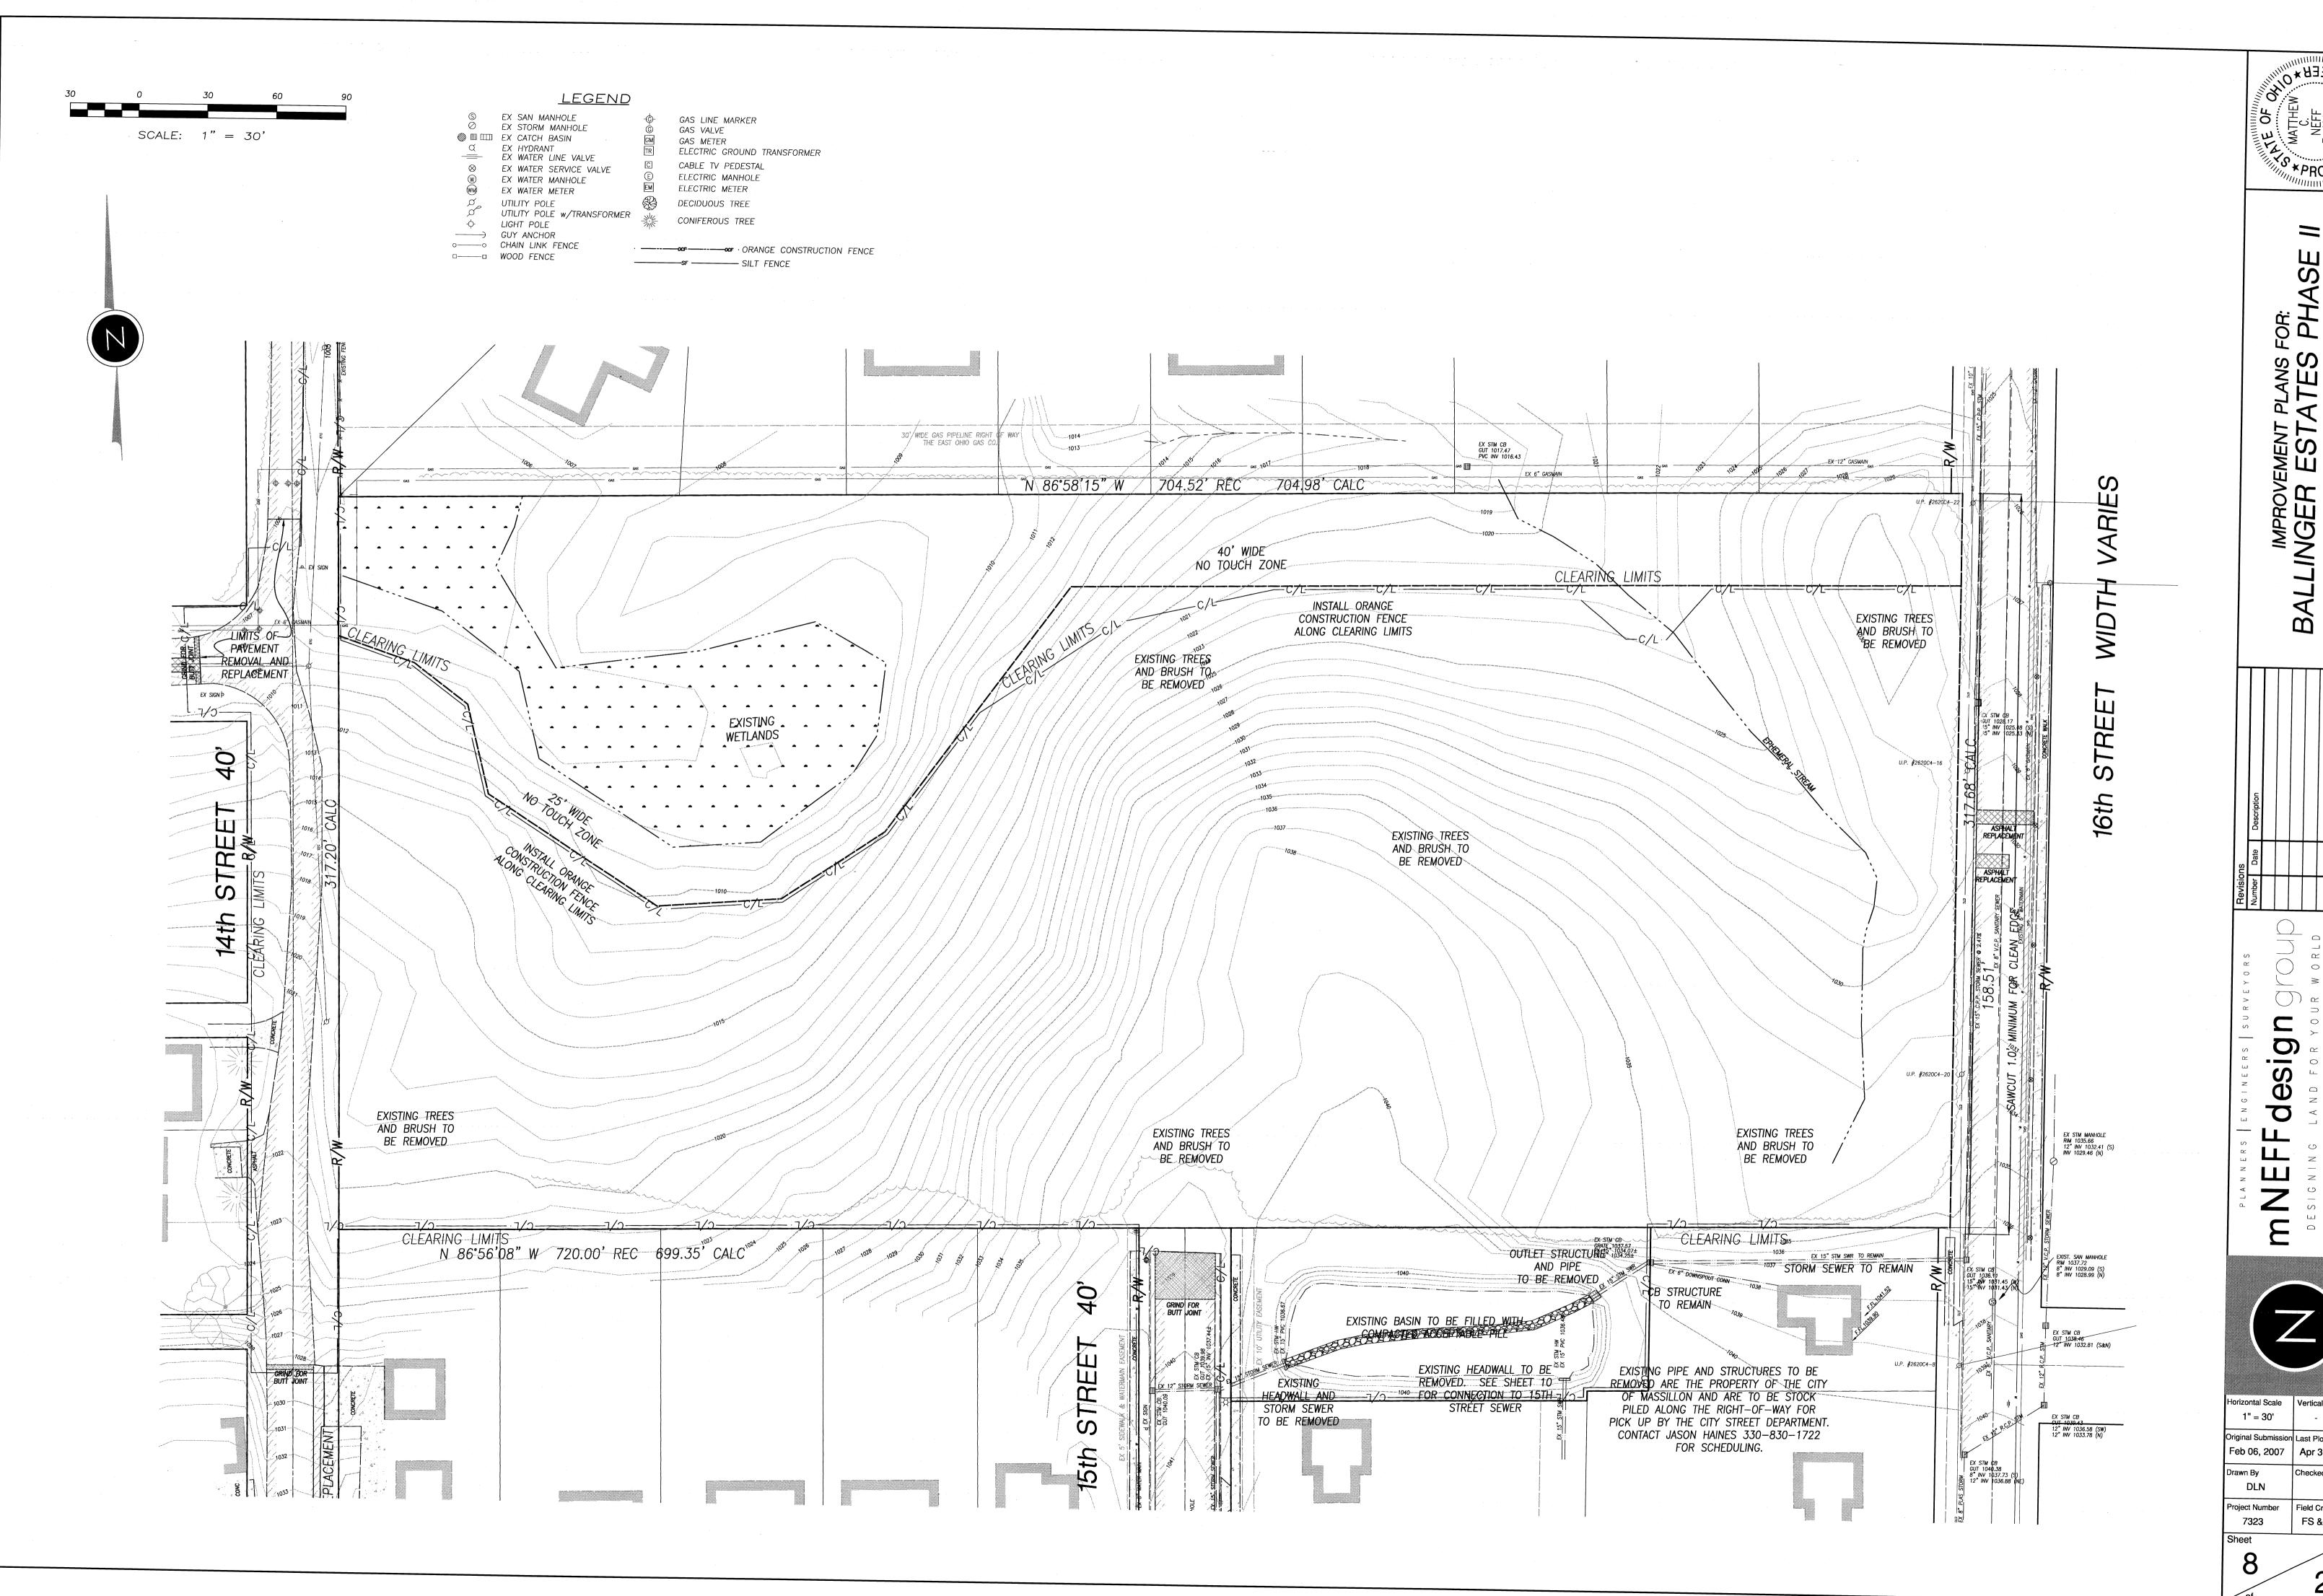

Horizontal Scale Vertical Scale Original Submission Last Plot Date Feb 06, 2007 | Apr 30, 2007 Checked By

FS & BH

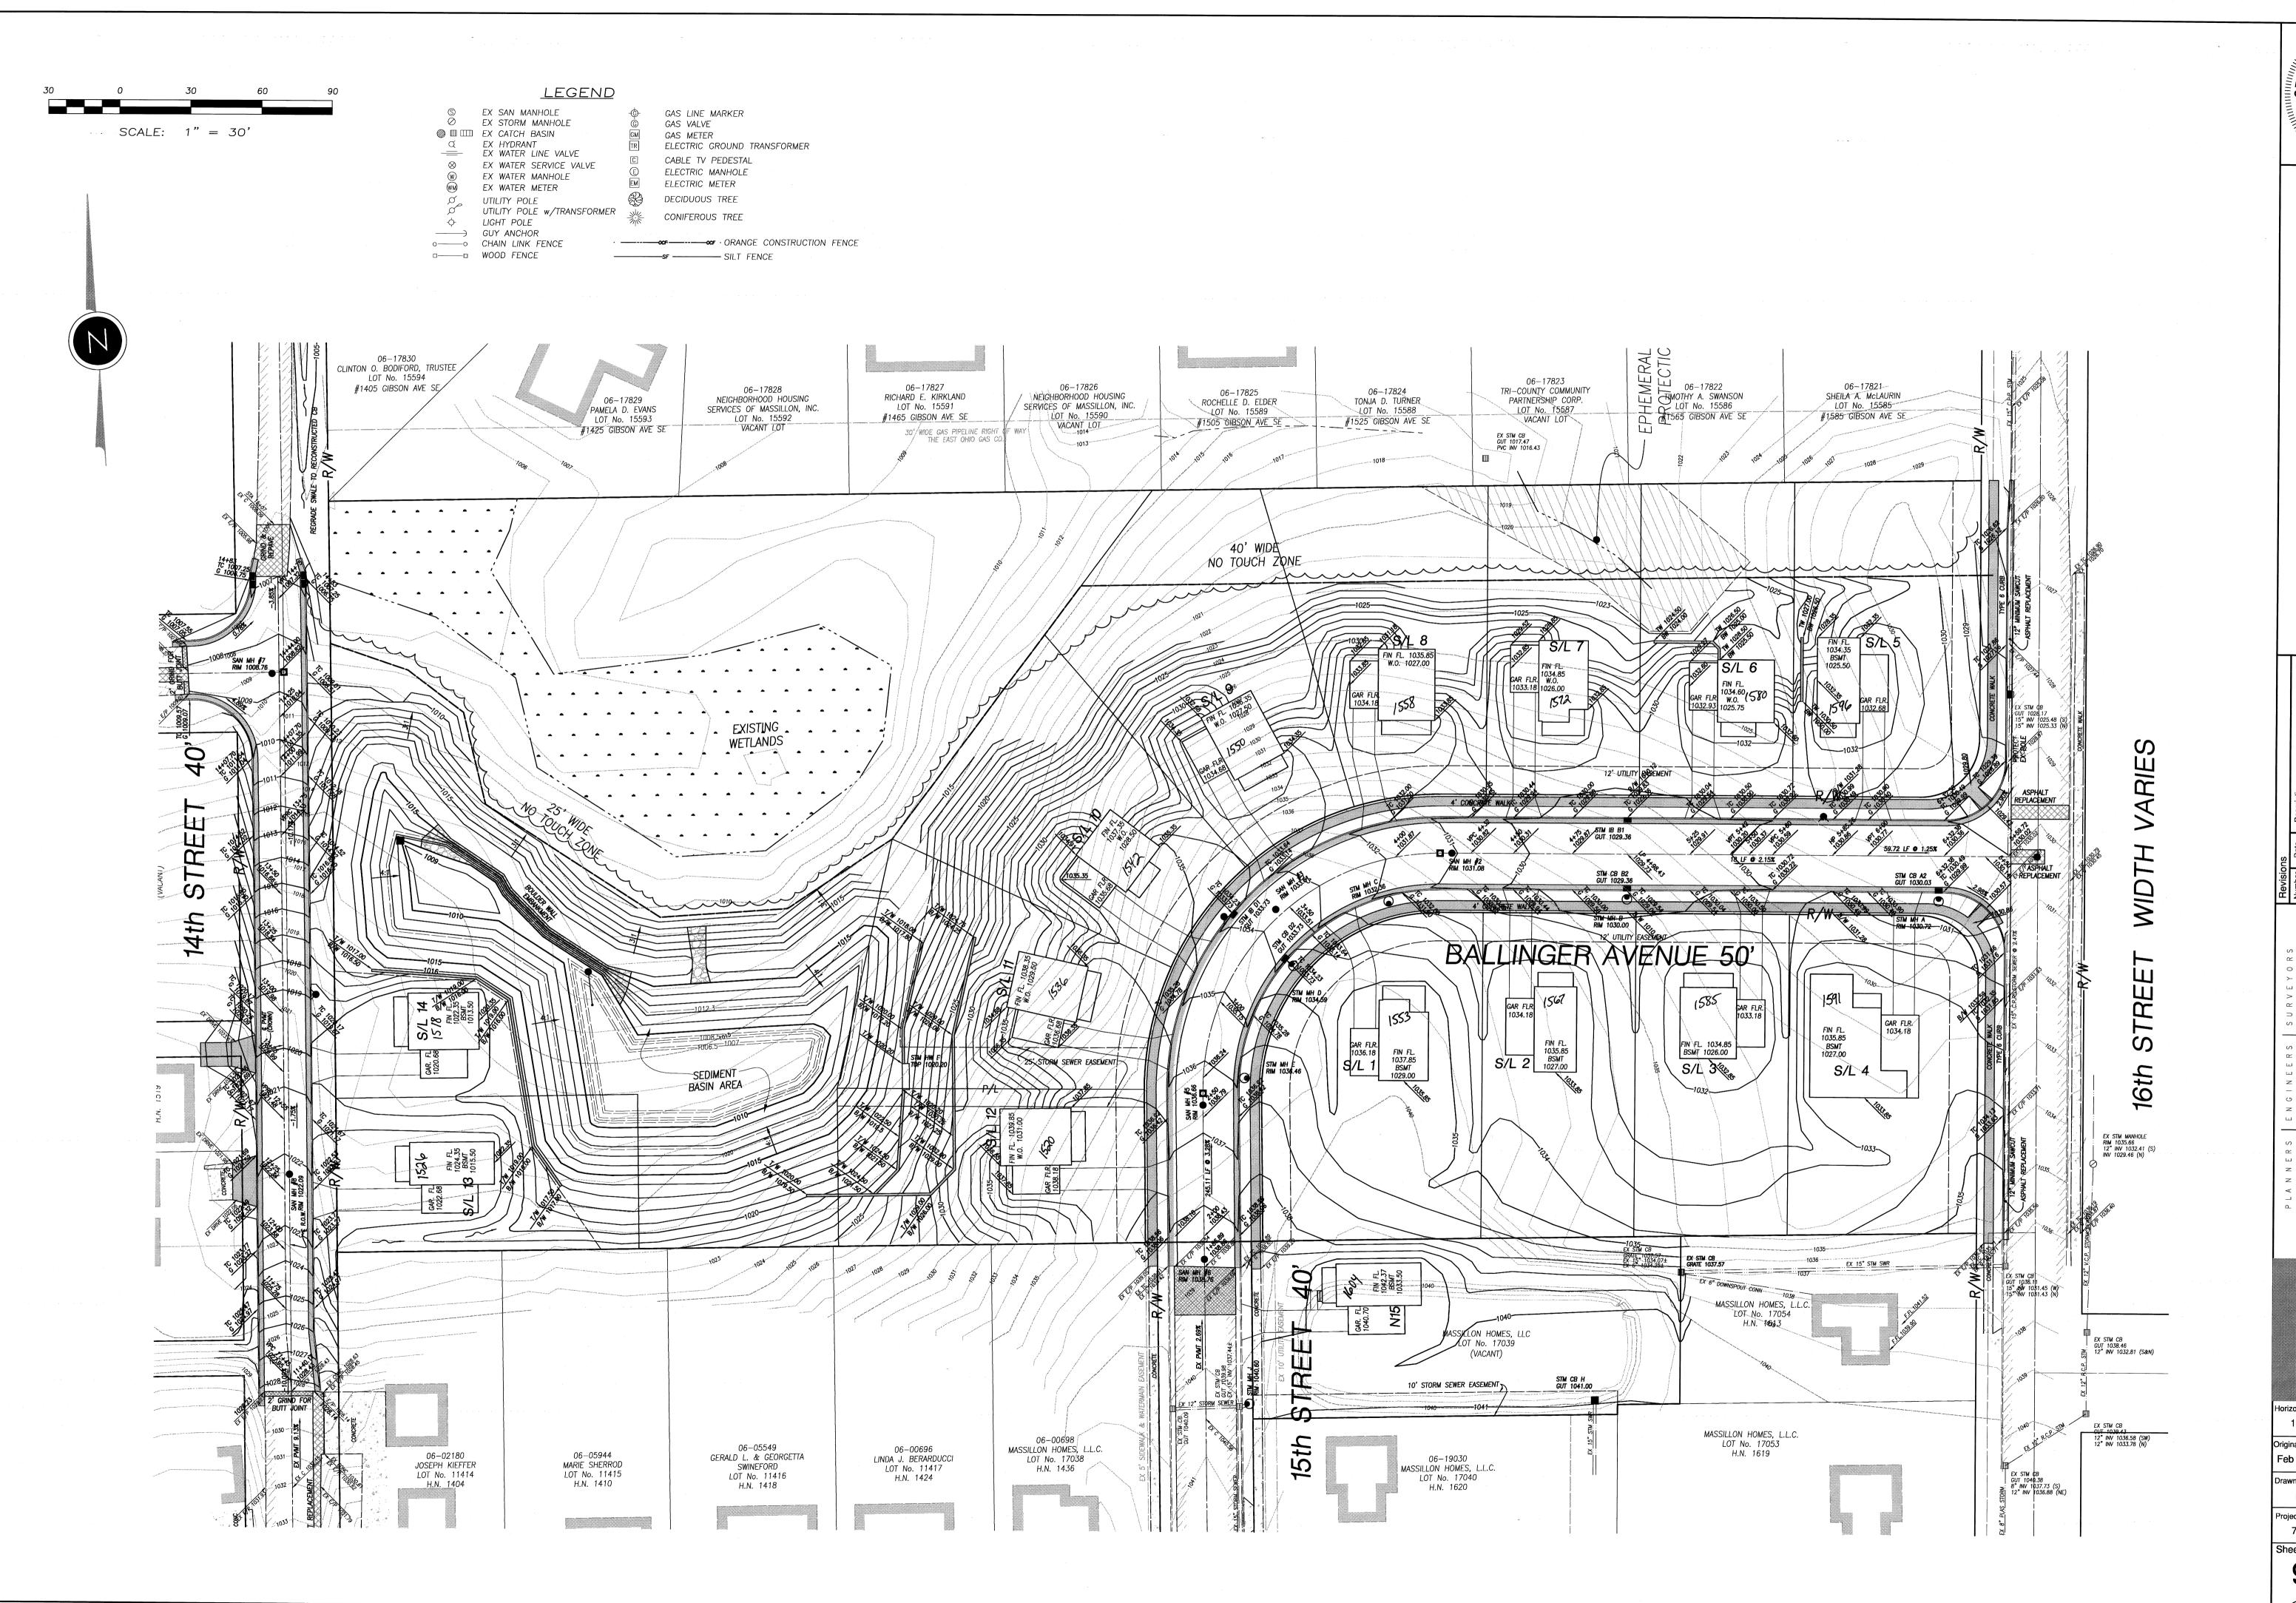

LANS


ENT ST,

IMPROVEMI ALLINGER E

B

design E


Horizontal Scale Vertical Scale 1" = 30' Original Submission Last Plot Date Feb 06, 2007 | May 01, 2007 rawn By Checked By DLN Field Crew roject Number FS & BH 7323

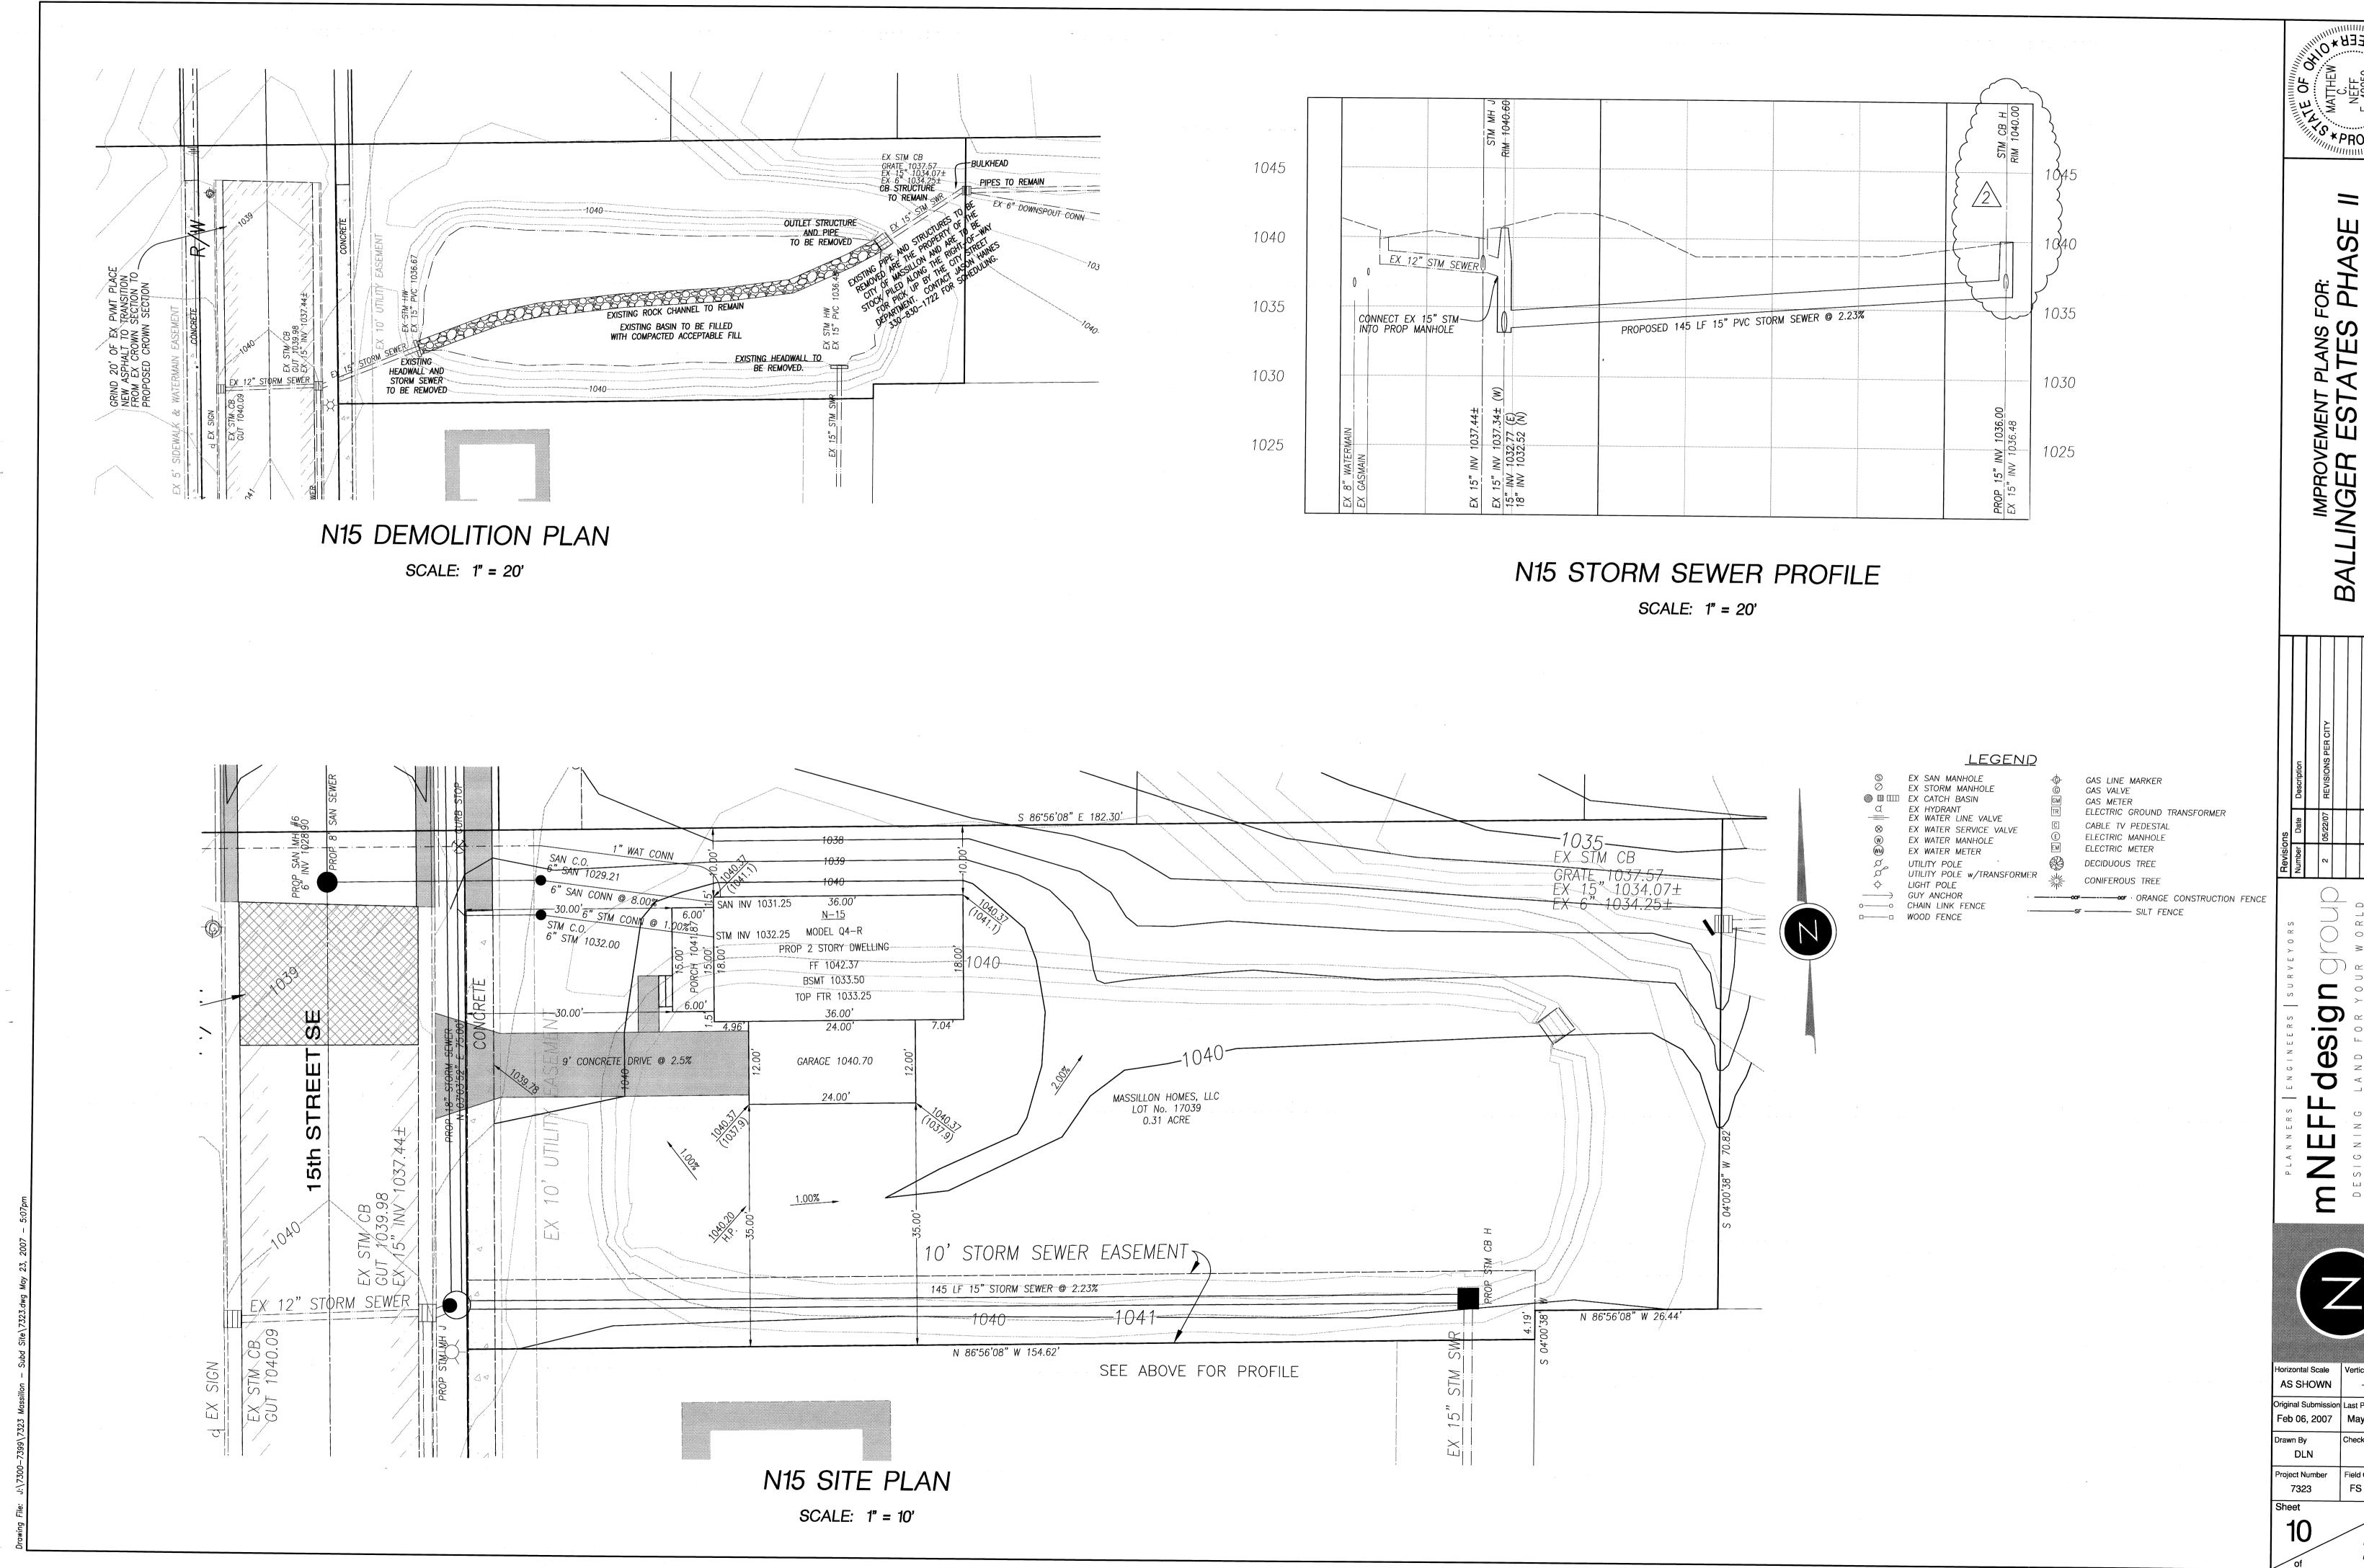



FOR: PHASE



Horizontal Scale Vertical Scale Original Submission Last Plot Date Feb 06, 2007 | May 23, 2007 Checked By FS & BH

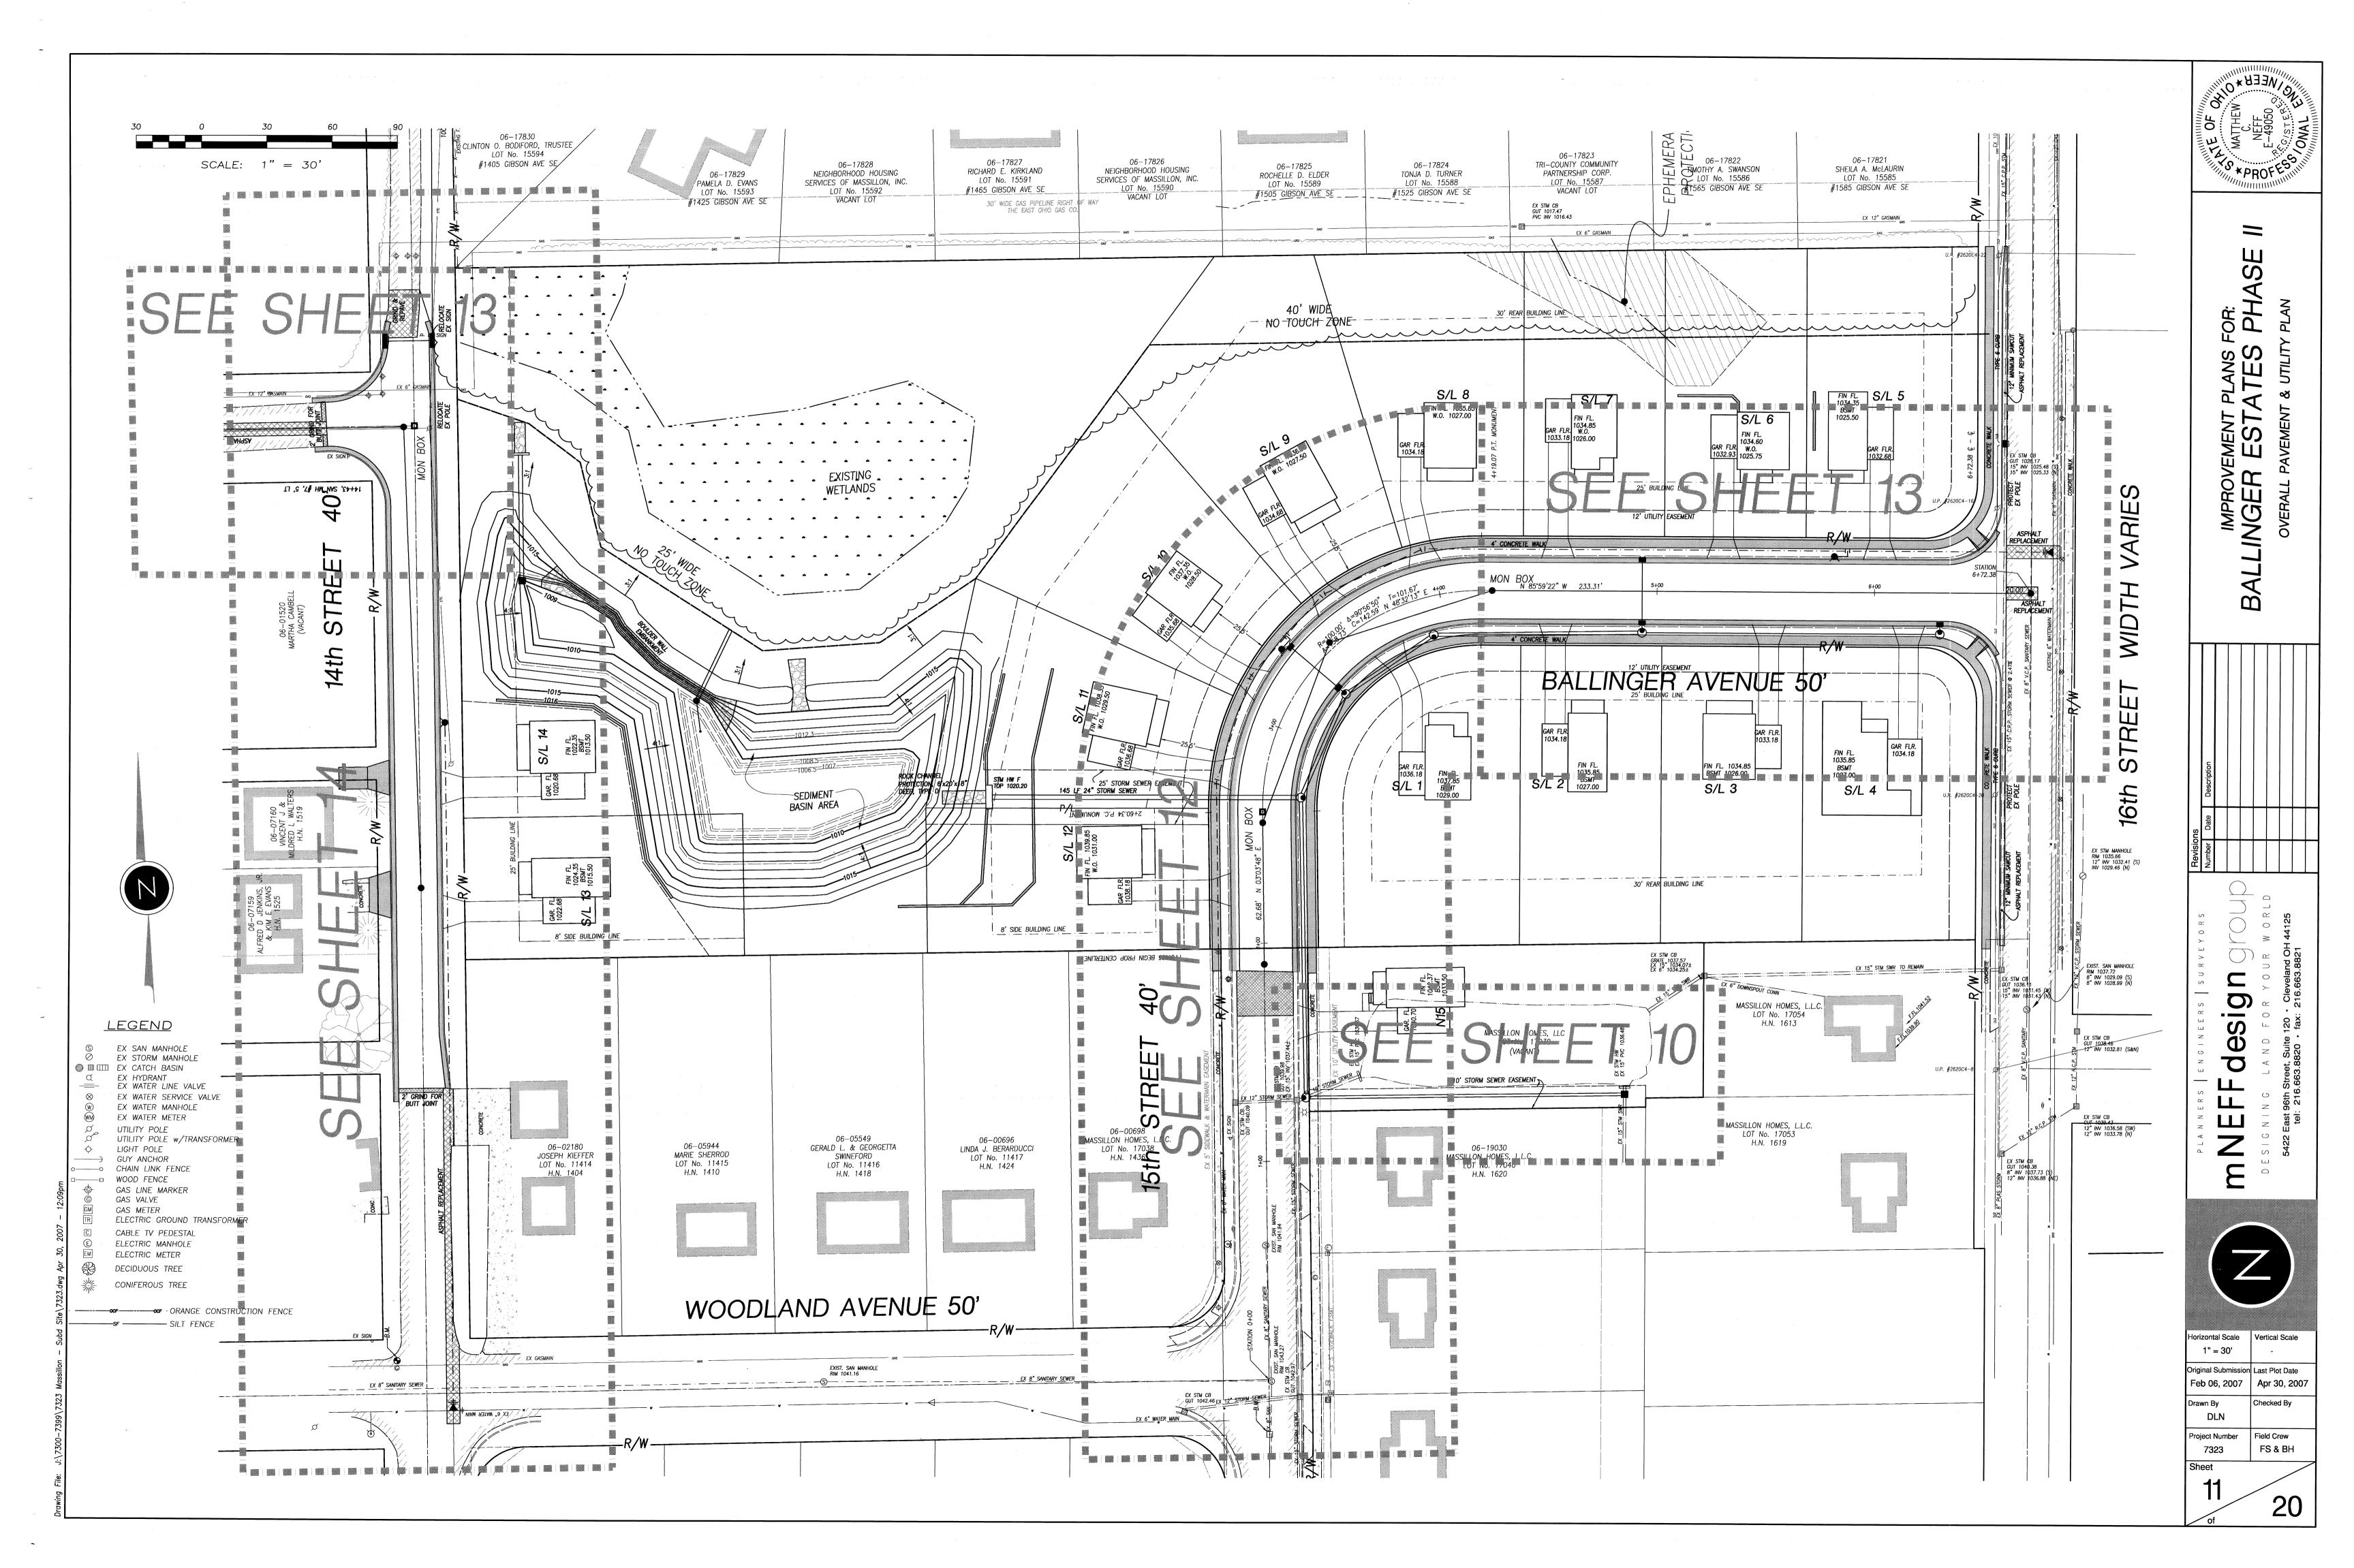

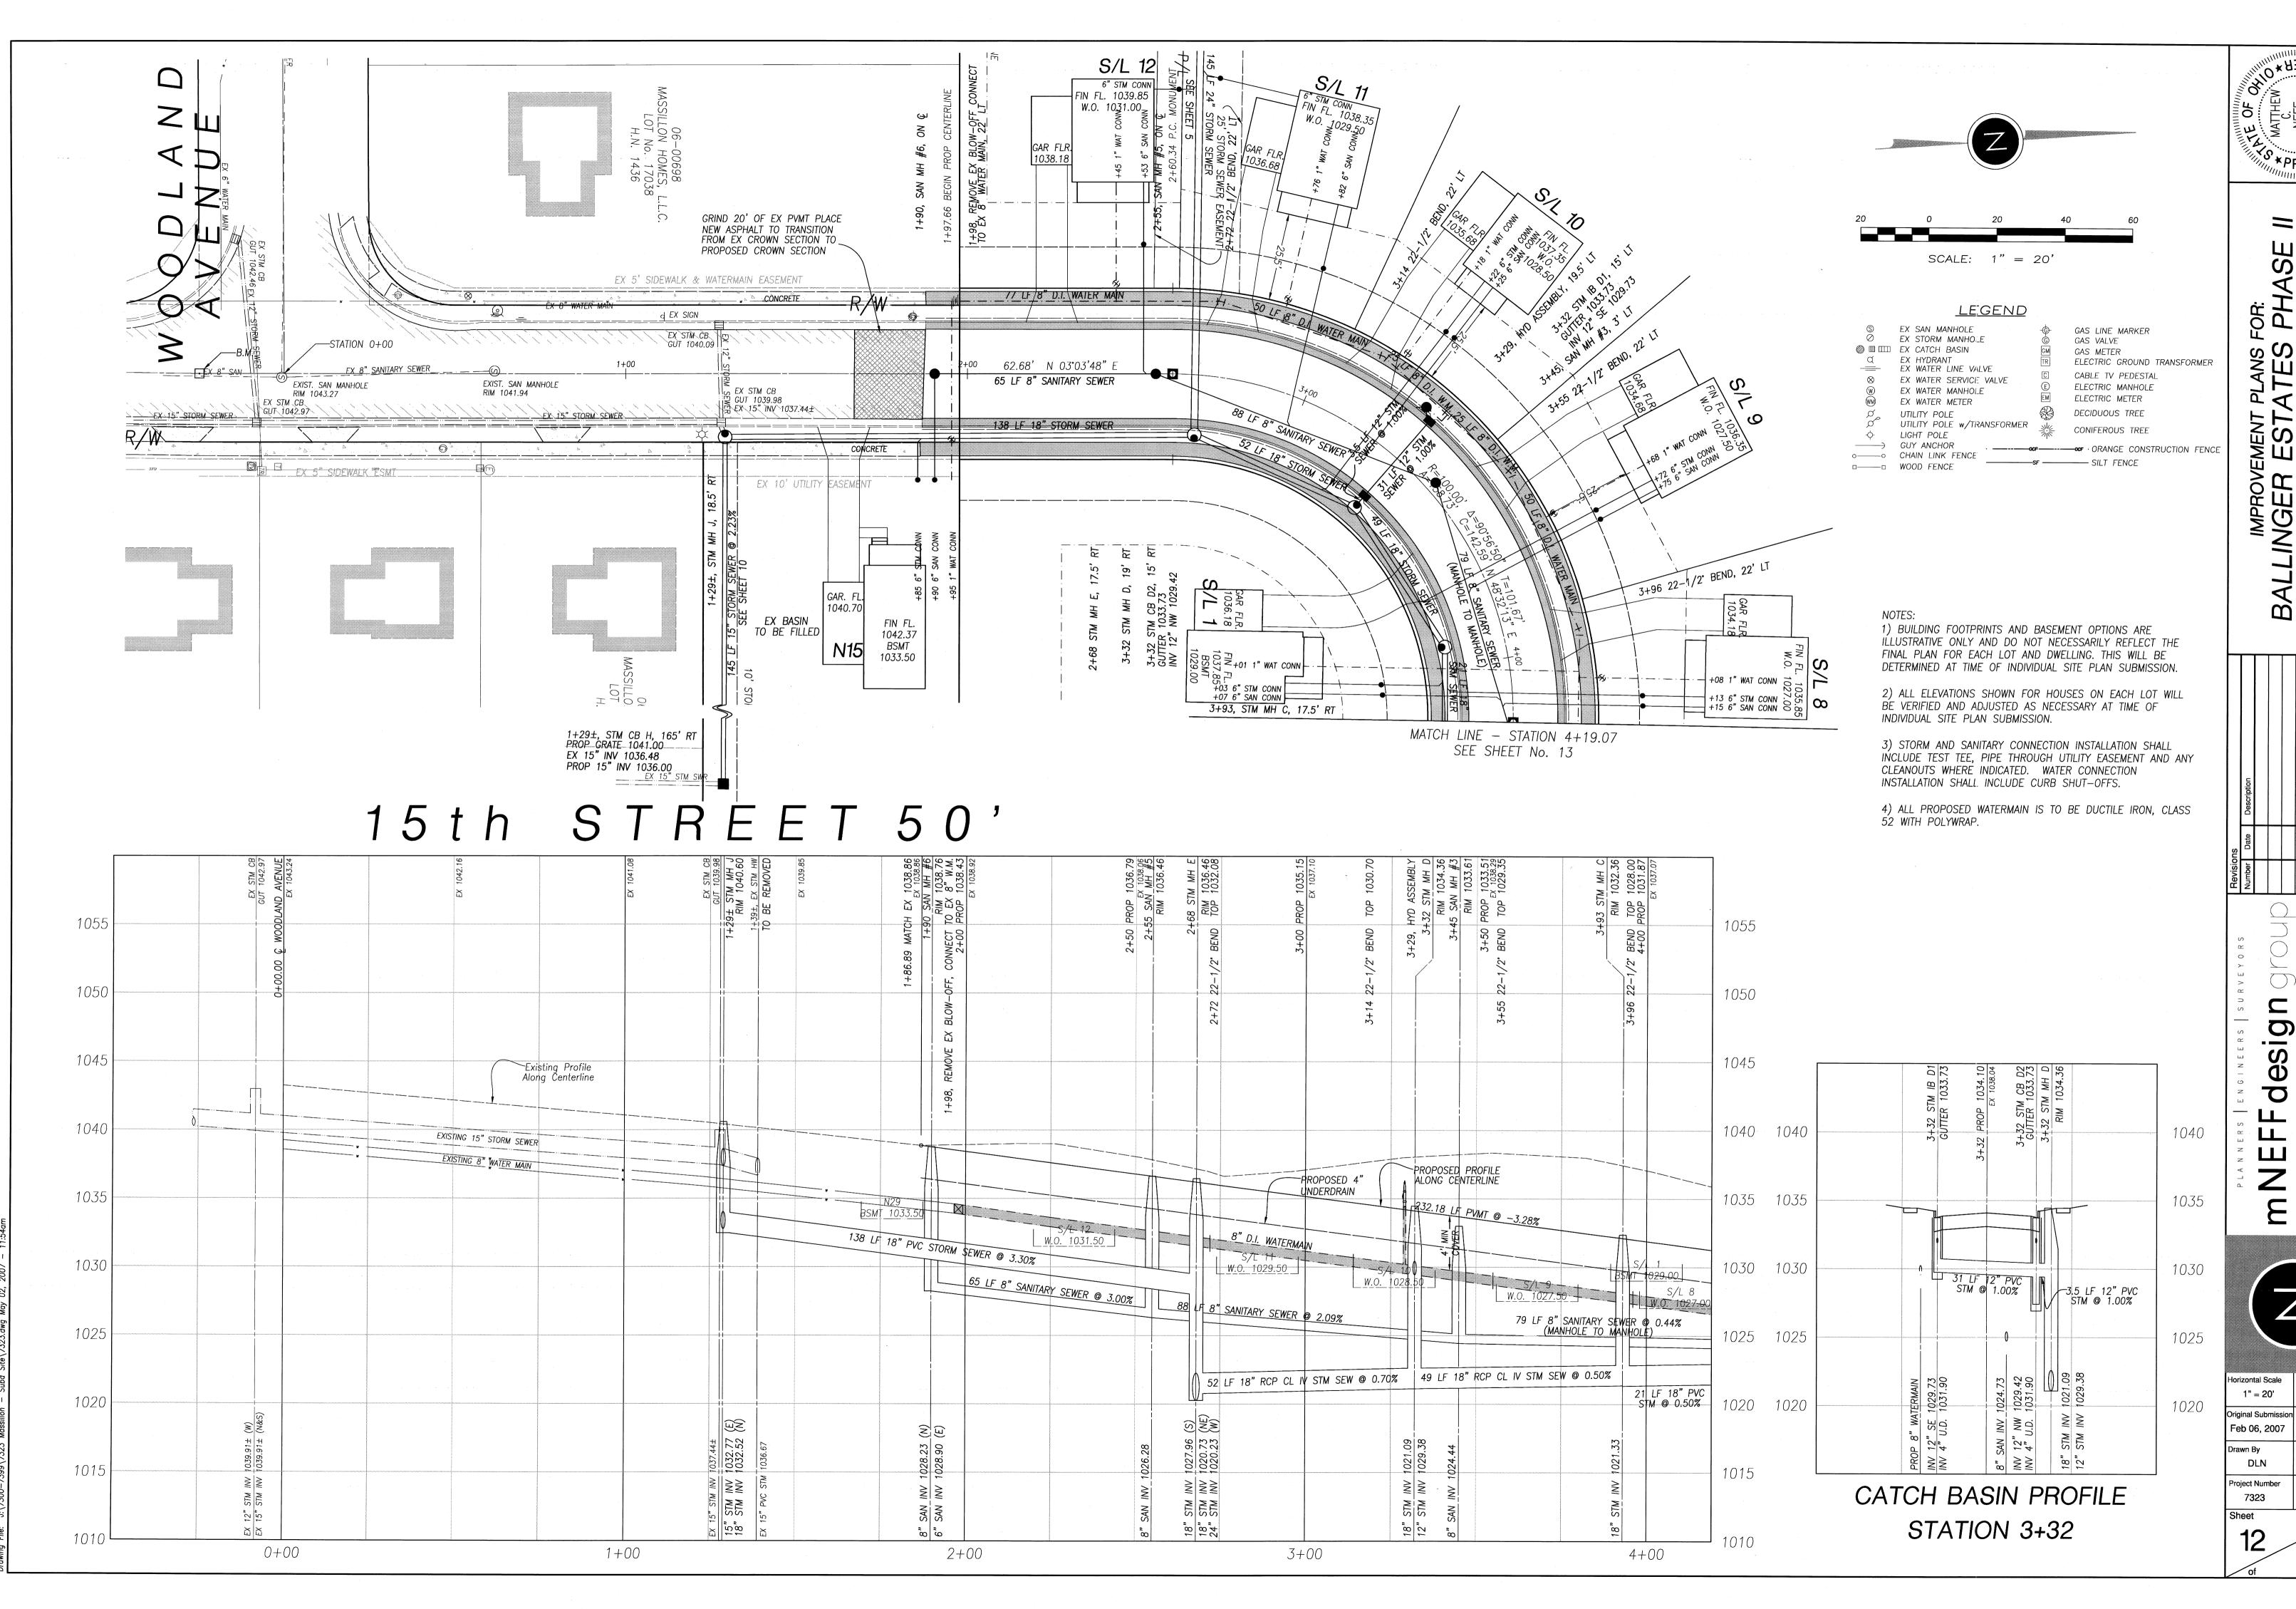

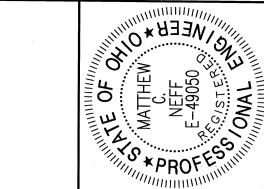



VEMENT R EST

D S Û 0





orizontal Scale Vertical Scale May 02, 200 FS & BH

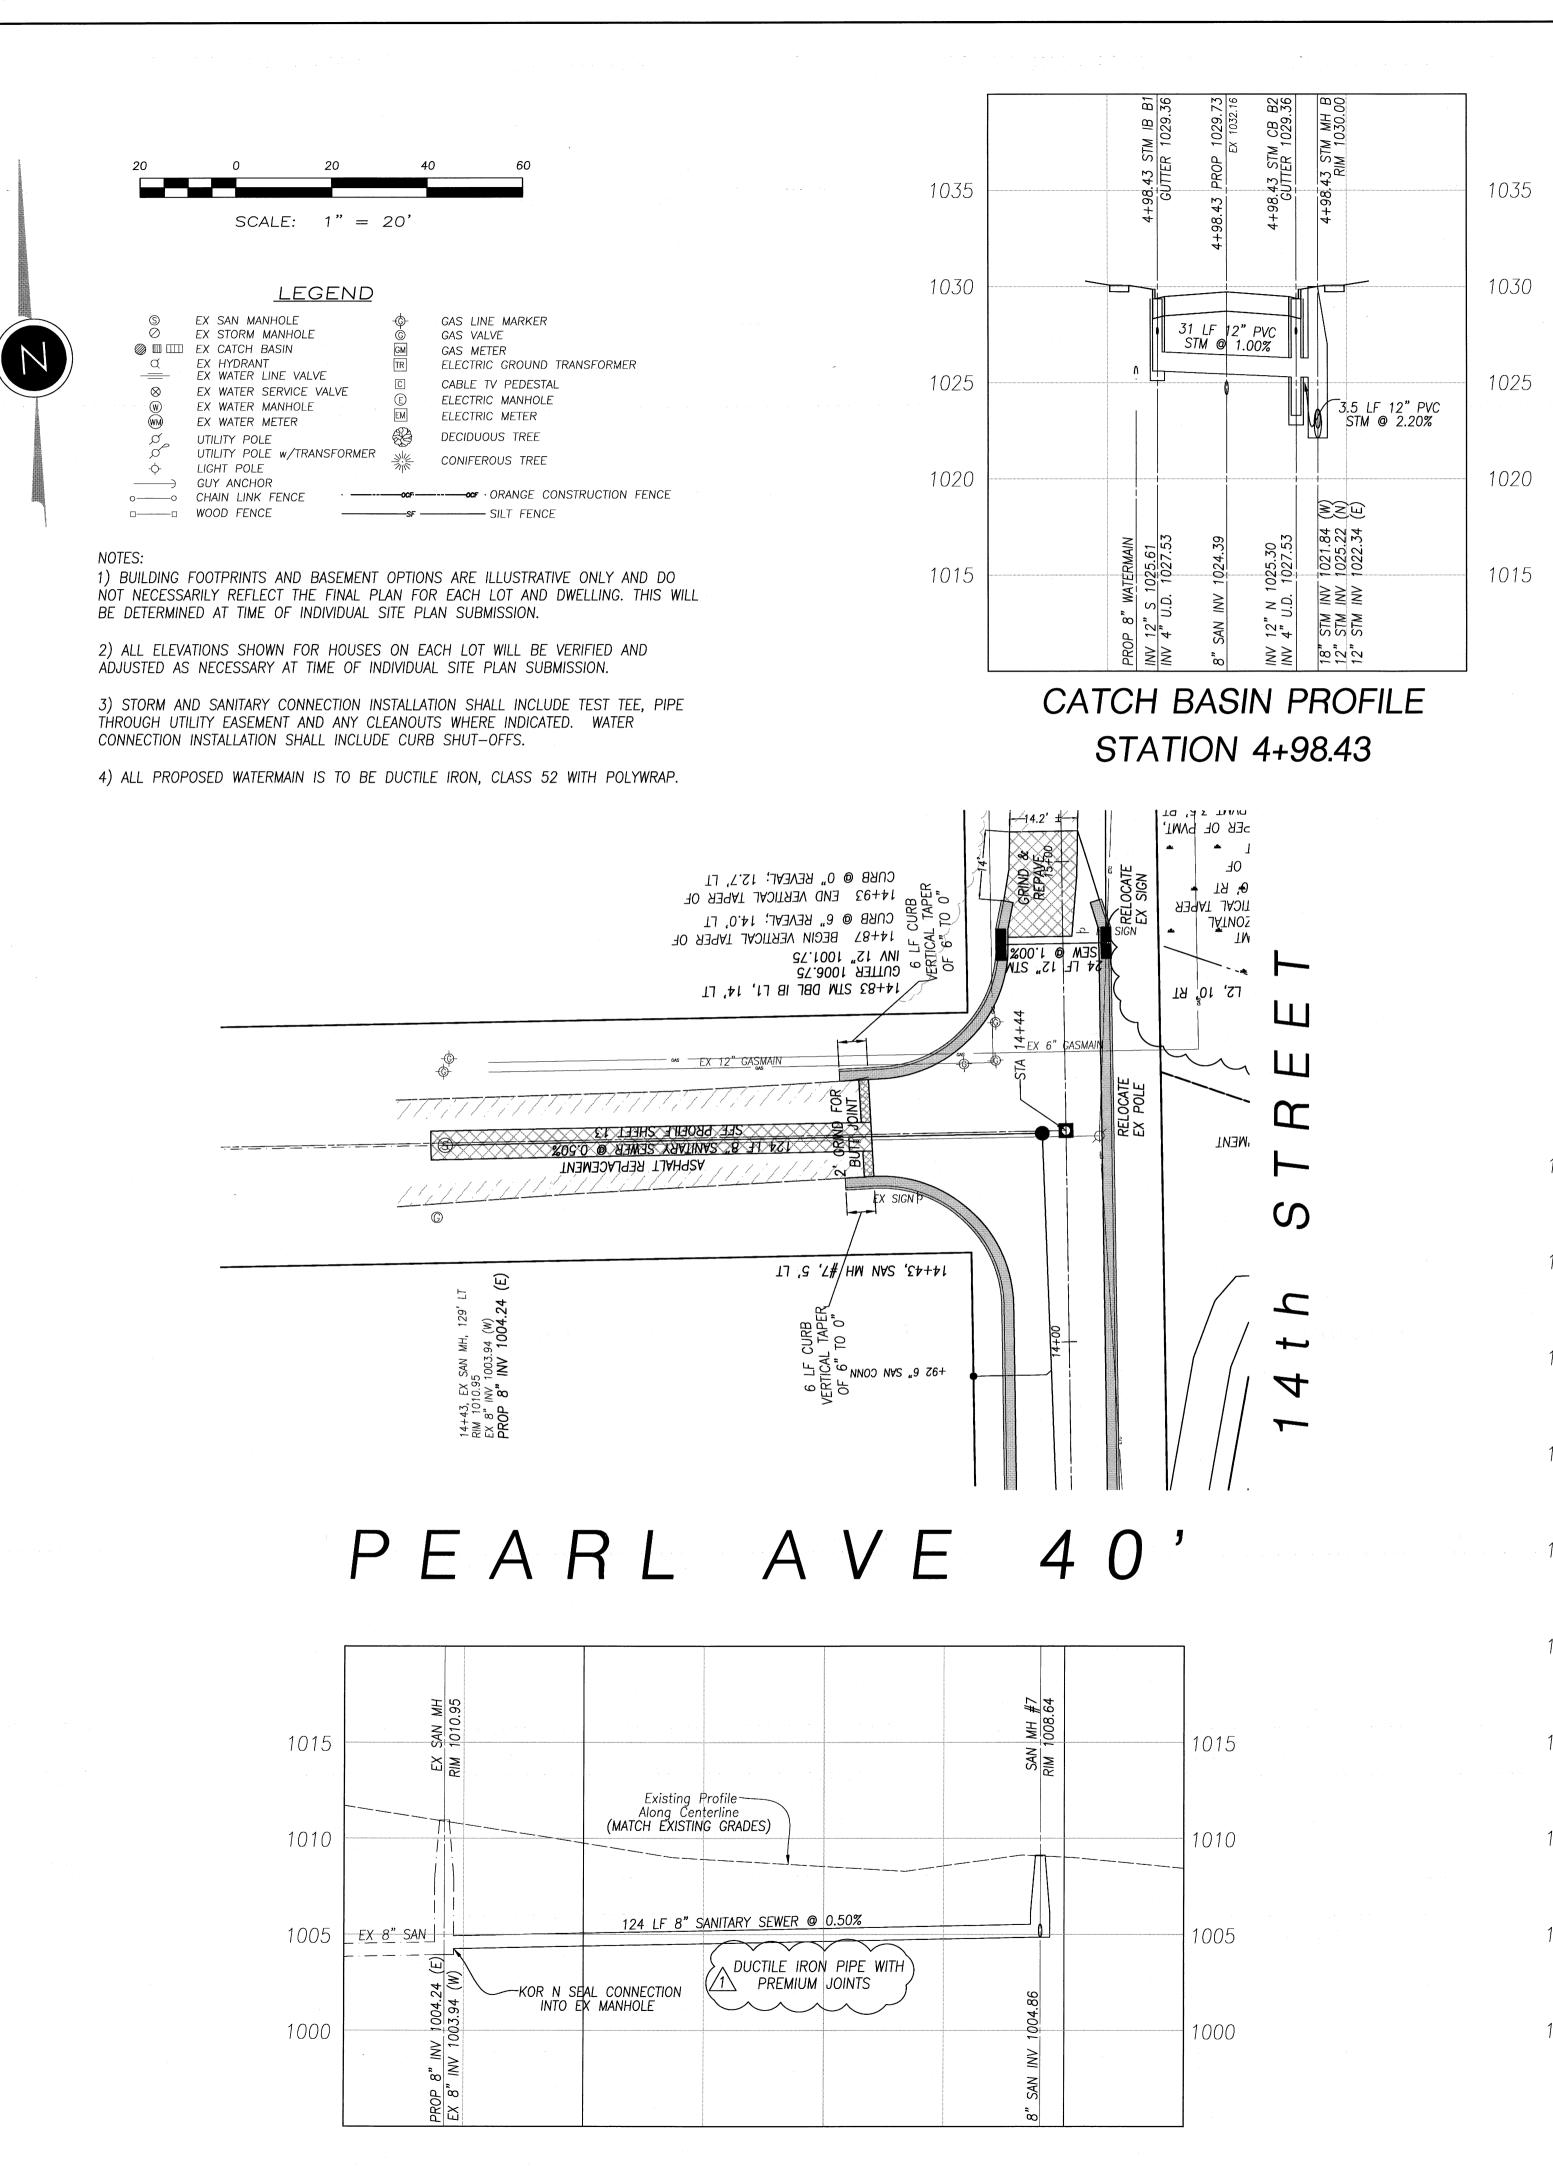

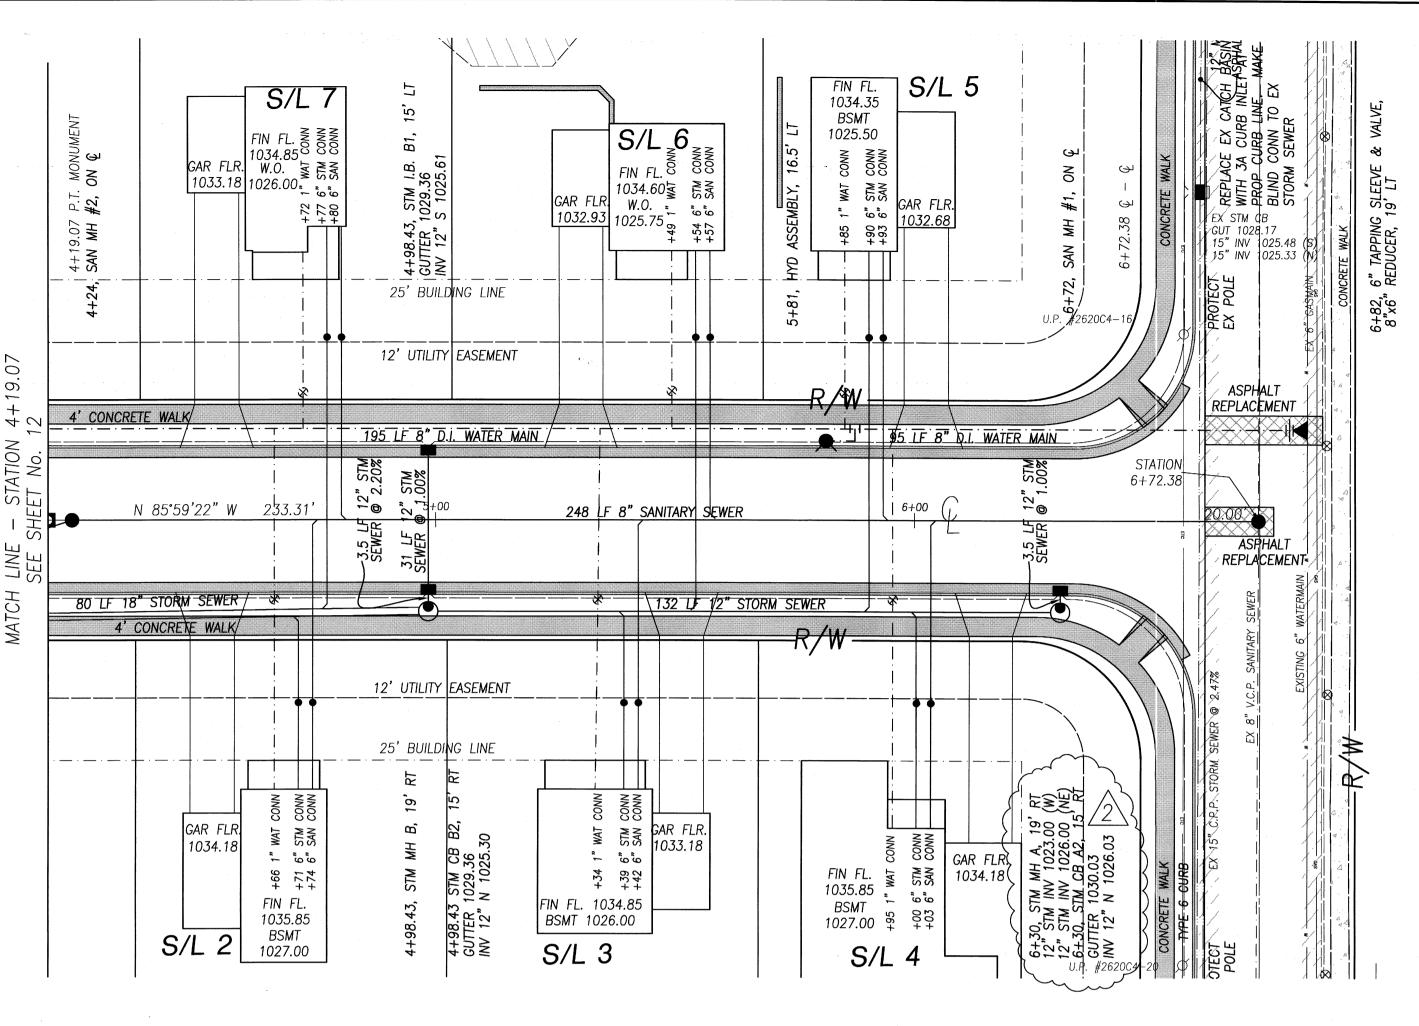

BALLINGER AVENUE 50'

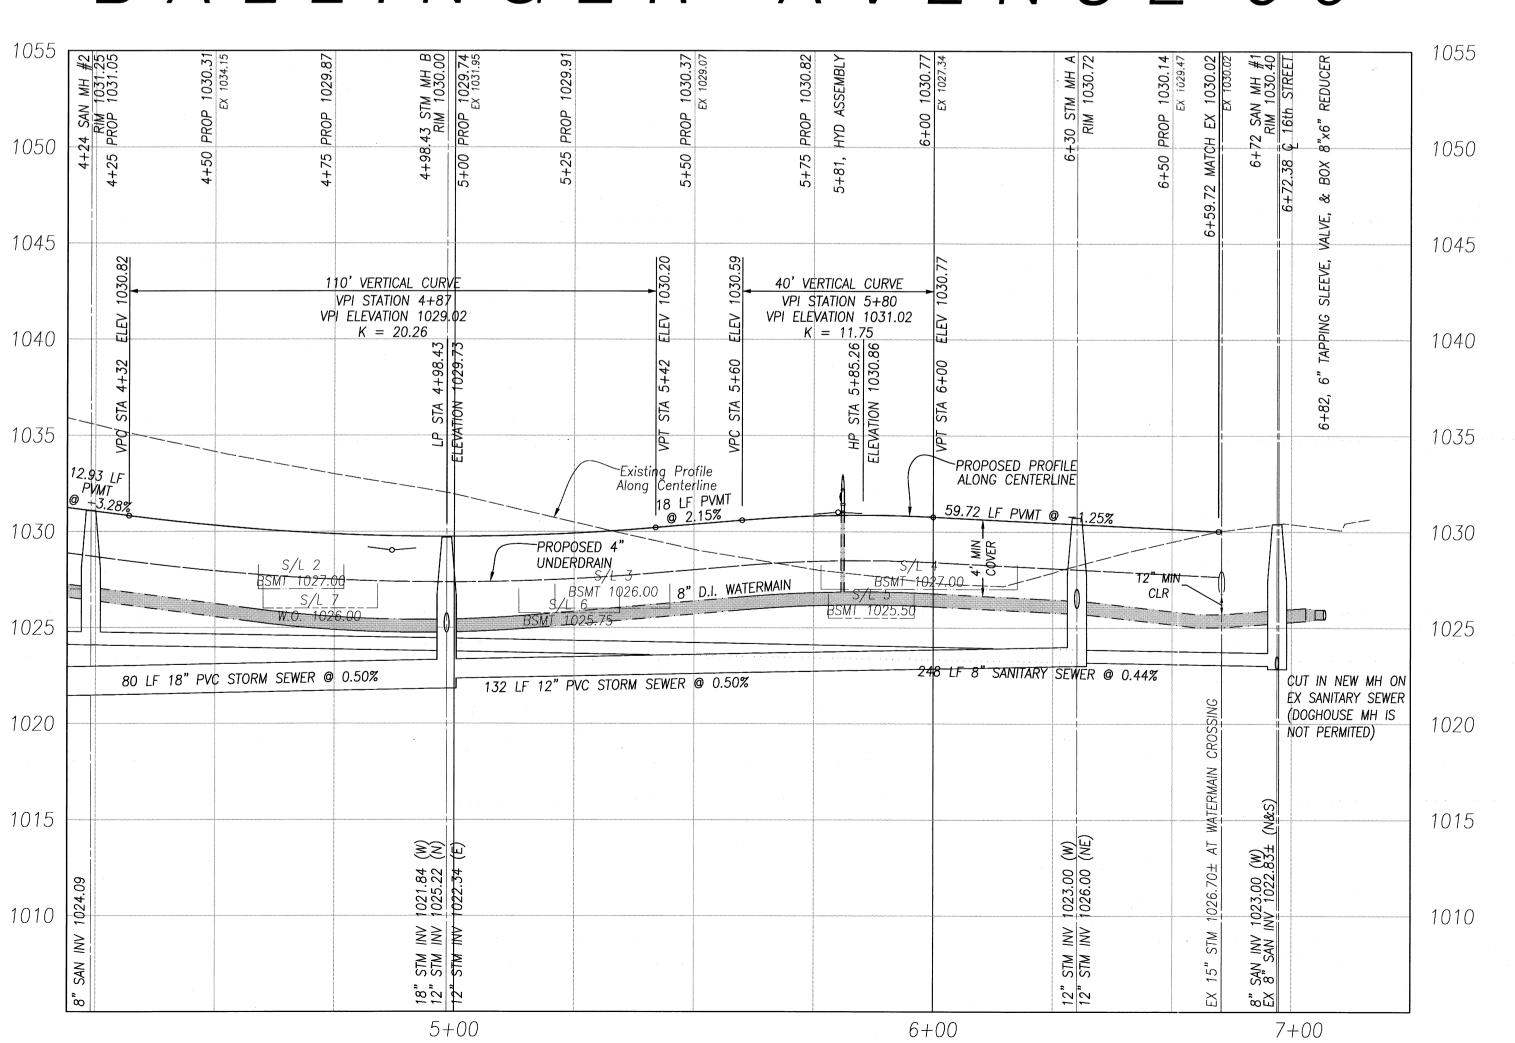

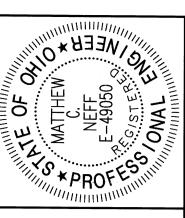

SE

 \square

S

9


D D 0


orizontal Scale


1" = 20' riginal Submission Last Plot Date Feb 06, 2007 | May 23, 200 Drawn By DLN Field Crew roject Number


FS & BH 7323

Sheet

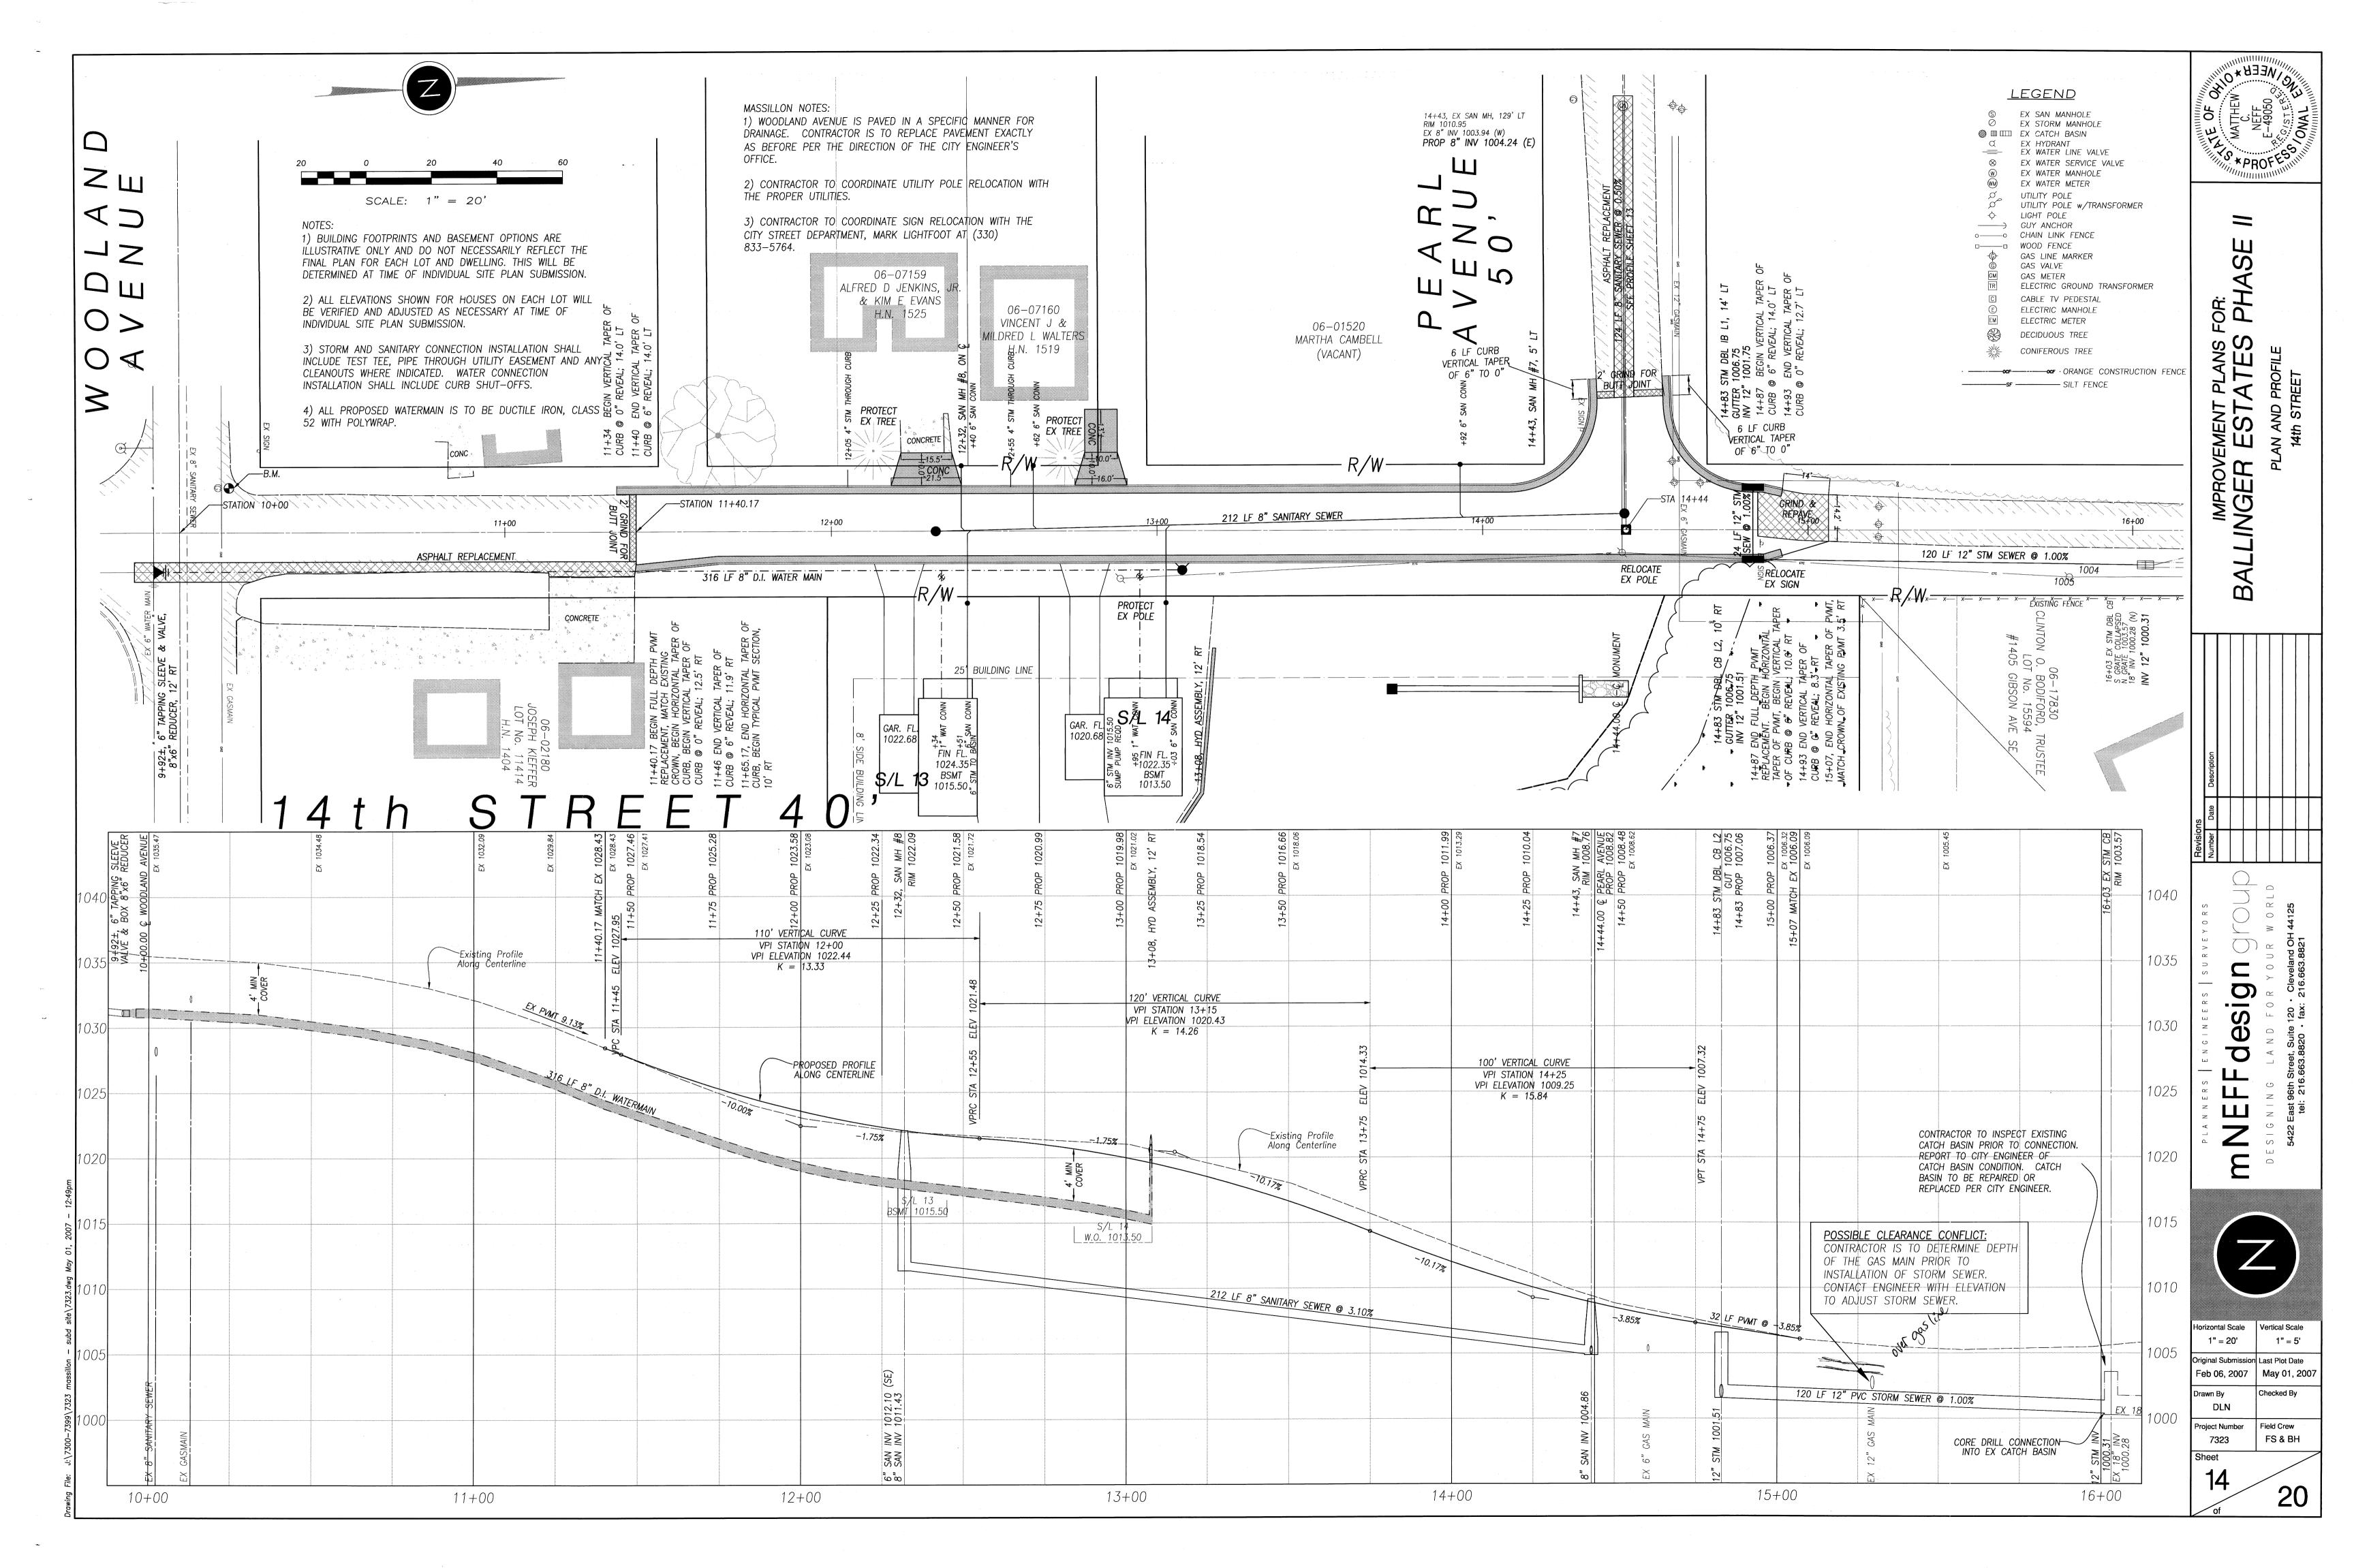

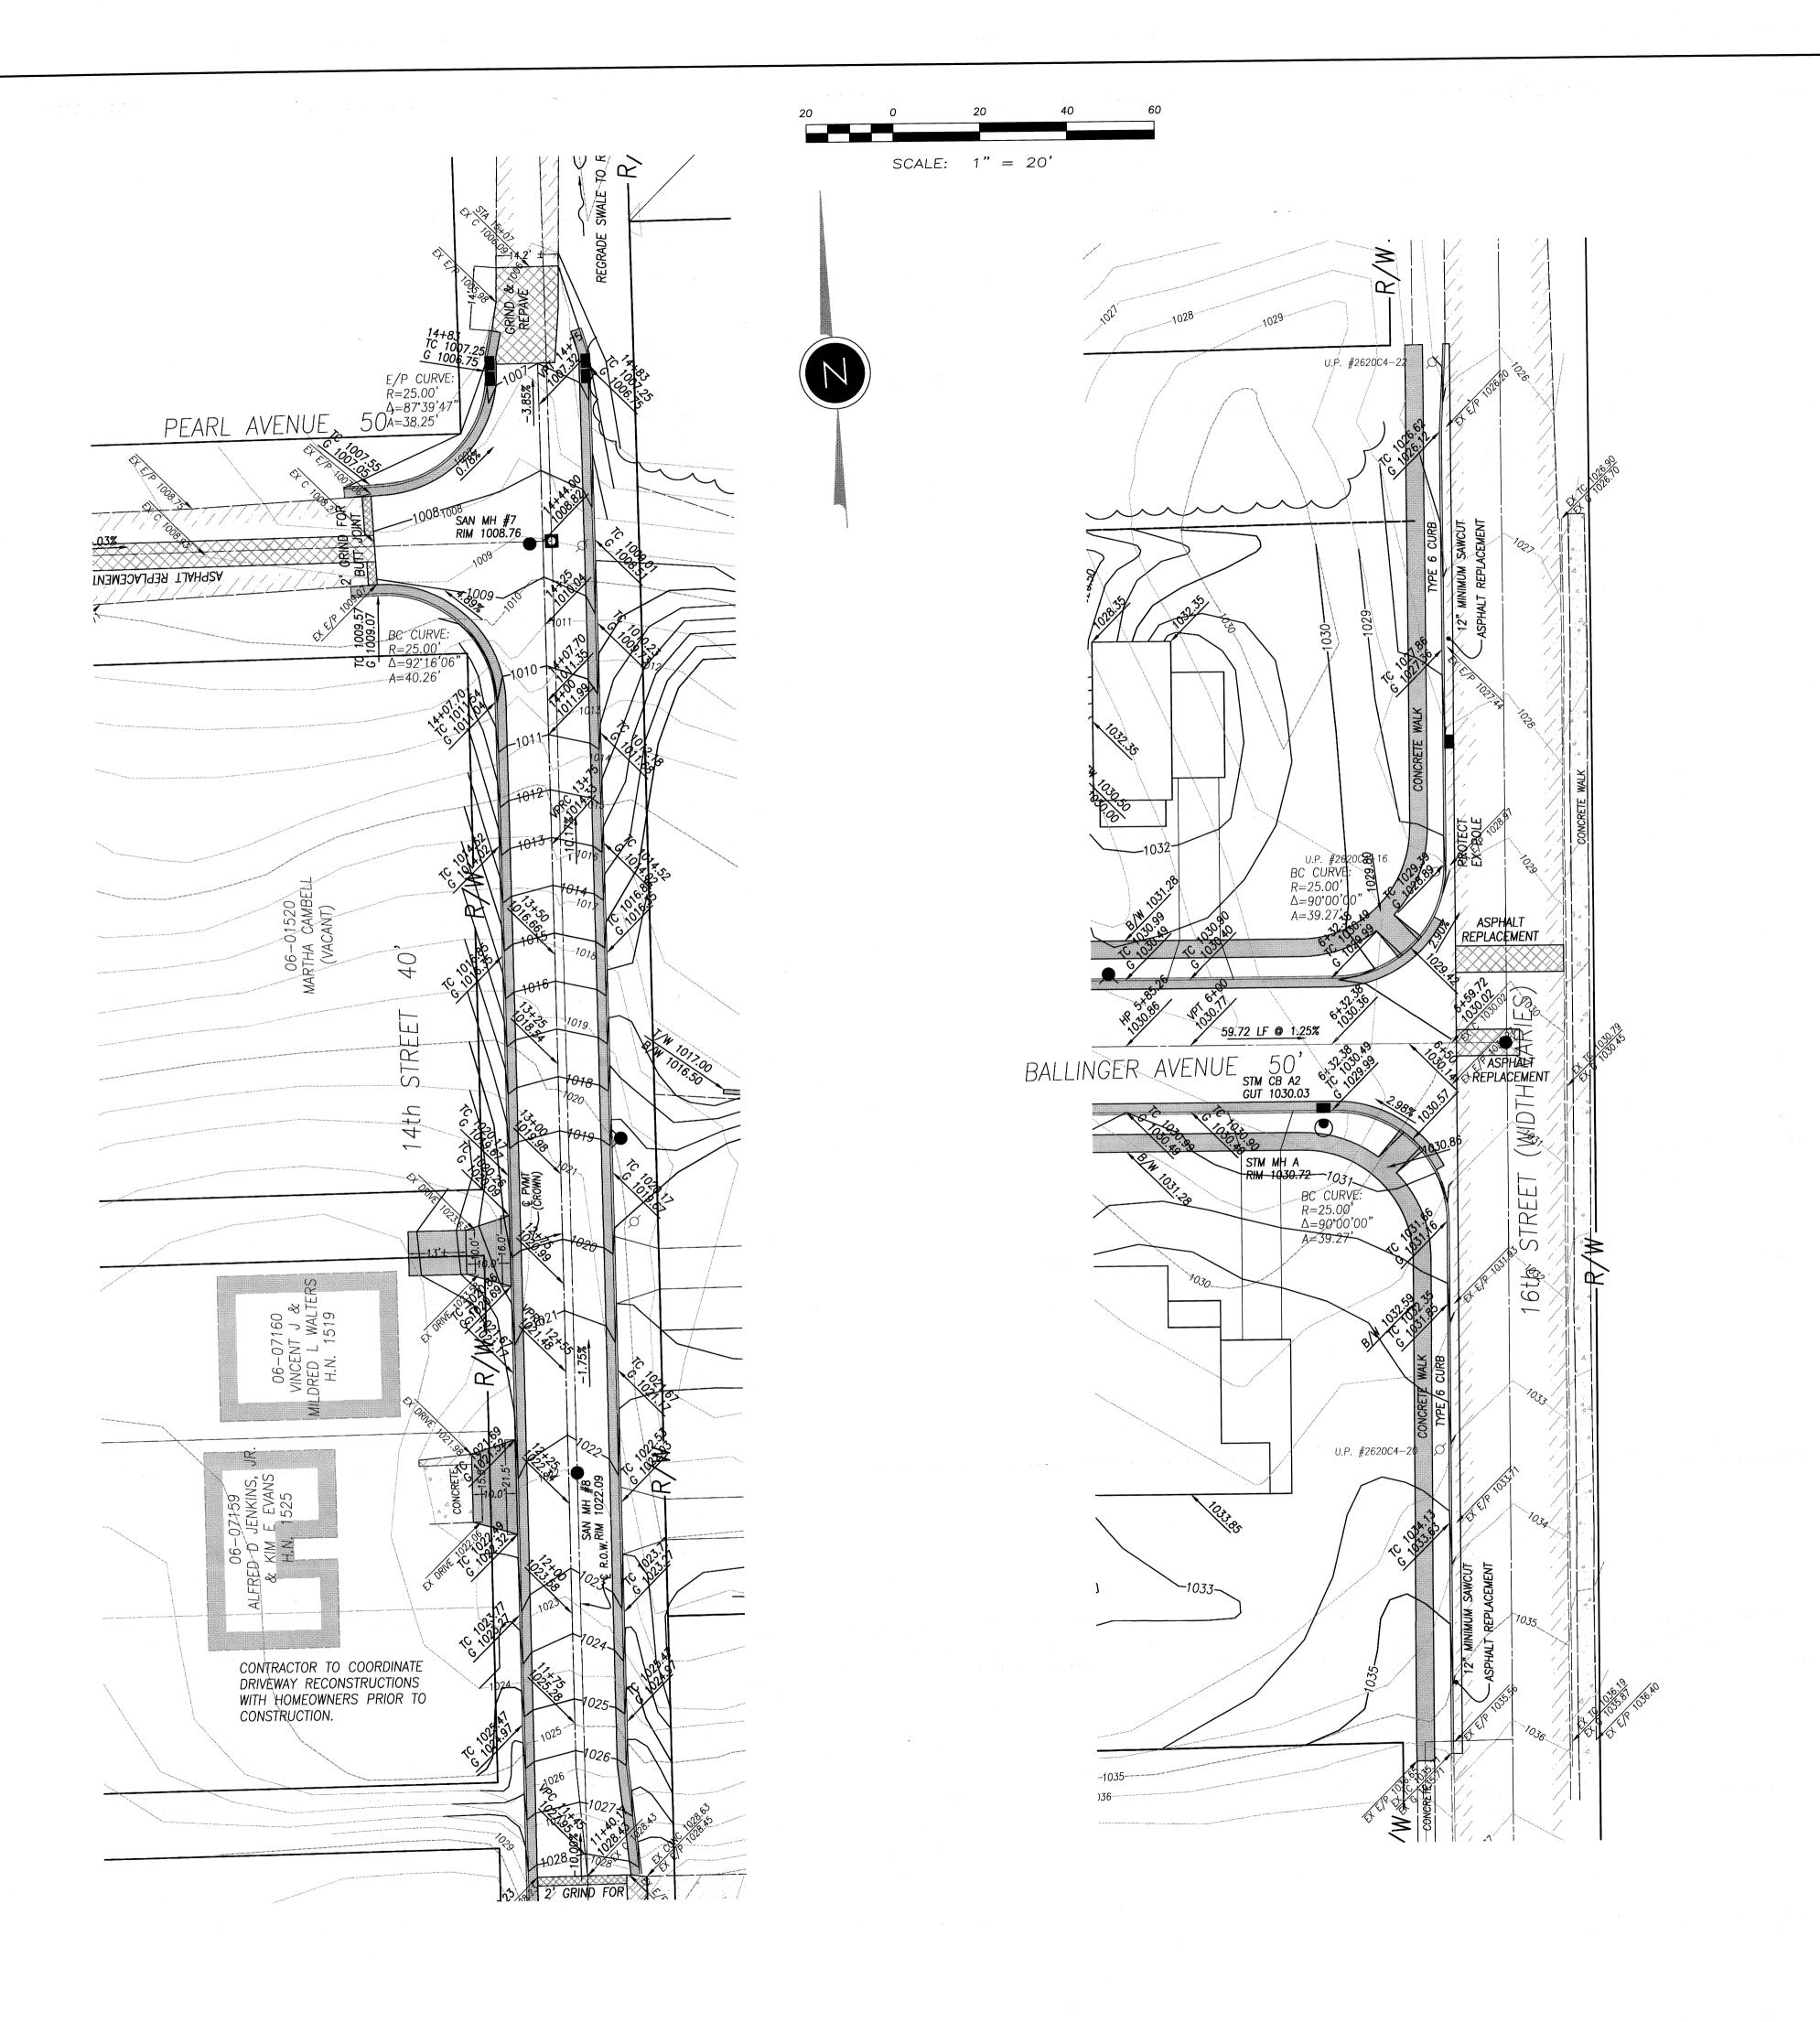

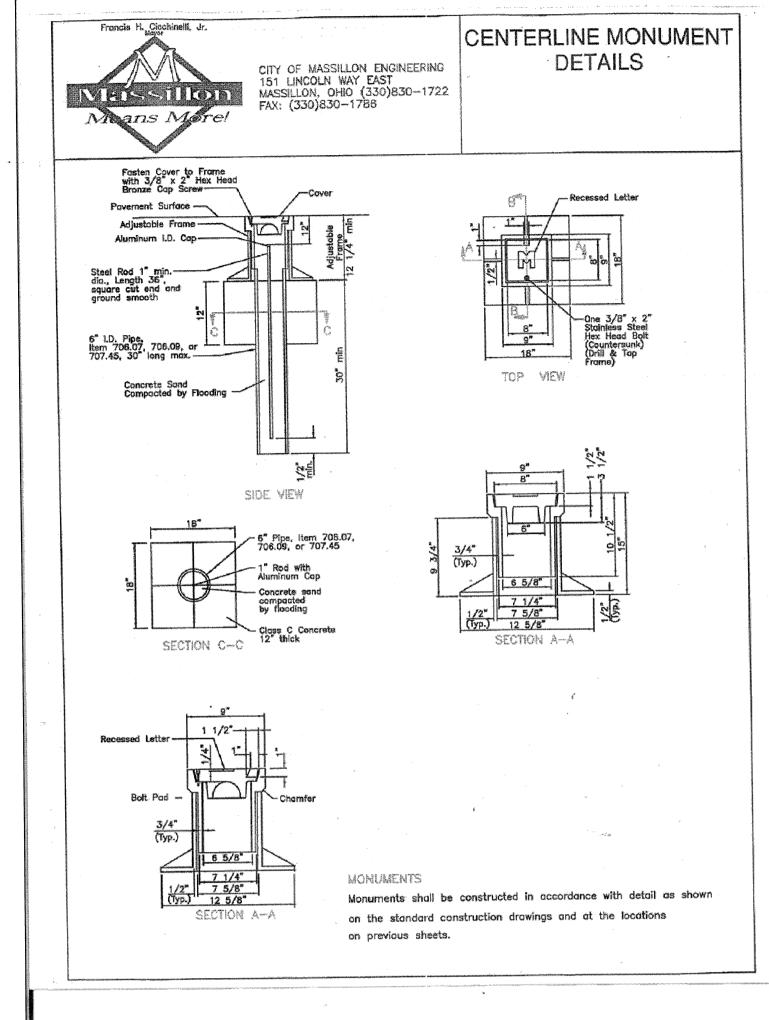

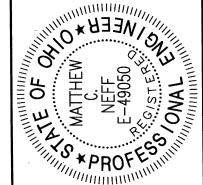


FOR: PHASE


EST.

lesign 0

forizontal Scale Vertical Scale 1" = 20' Original Submission Last Plot Date Feb 06, 2007 May 01, 2007 Drawn By Project Number FS & BH 7323 Sheet

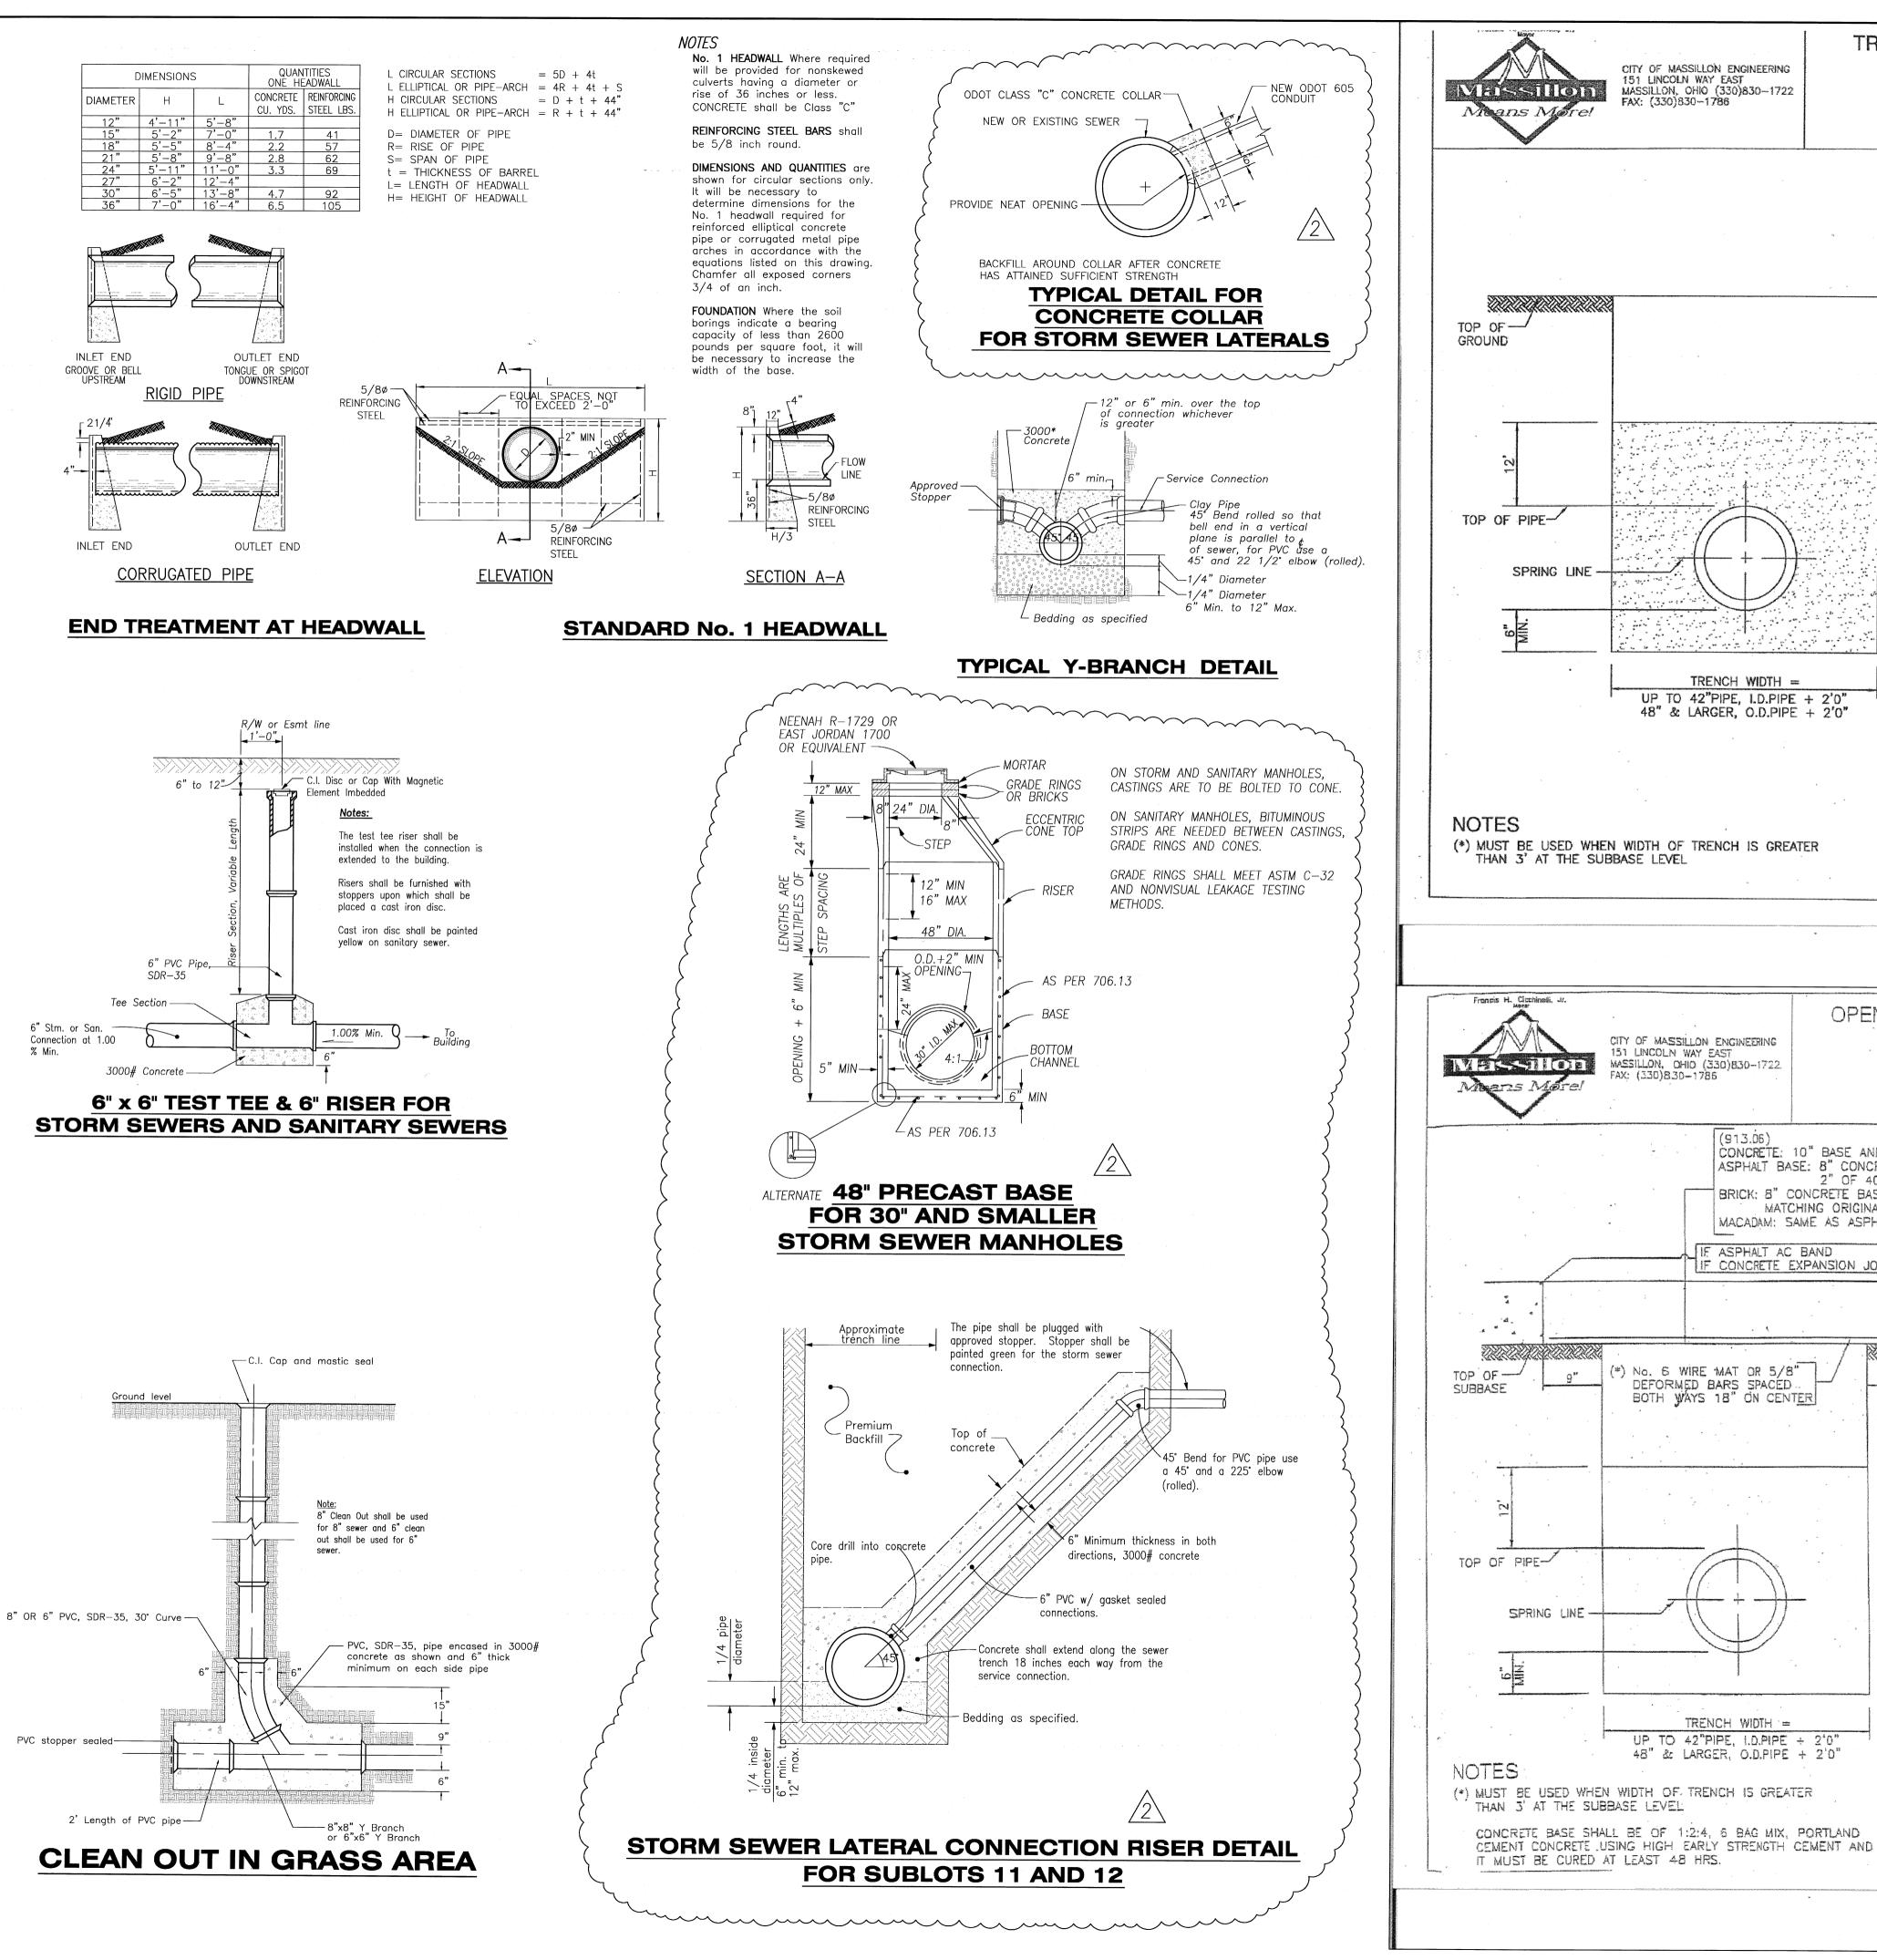

% Min.

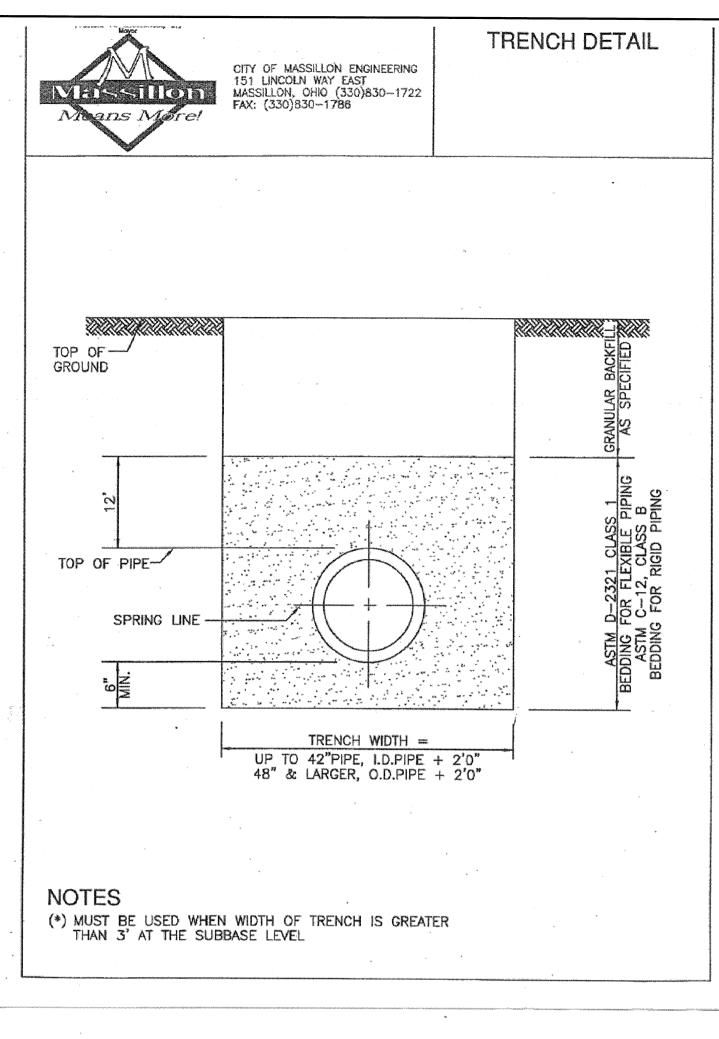

CITY OF MASSILLON ENGINEERING

MASSILLON, OHIO (330)830-1722 FAX: (330)830-1786

(*) No. 6 WIRE MAT OR 5/8"

DEFORMED BARS SPACED BOTH WAYS 18" ON CENTER

TRENCH WIDTH =

UP TO 42"PIPE, I.D.PIPE + 2"0"

48" & LARGER, O.D.PIPE + 2'0"

151 LINCOLN WAY EAST

OPEN CUT DETAIL

2" OF 404 ASPHALT CONCRETE

ASTM D-2321 CLASS 1
DDING FOR FLEXIBLE PIPII
ASTM C-12, CLASS B
REDDING FOR RIGID PIPING

CONCRETE: 10" BASE AND SURFACE MONOLITHIC ASPHALT BASE: 8" CONCRETE BASE WITH


BRICK: 8" CONCRETE BASE W/ BRICK SURFACE


MATCHING ORIGINAL

MACADAM: SAME AS ASPHALT

IF CONCRETE EXPANSION JOIN


ASPHALT AC BAND

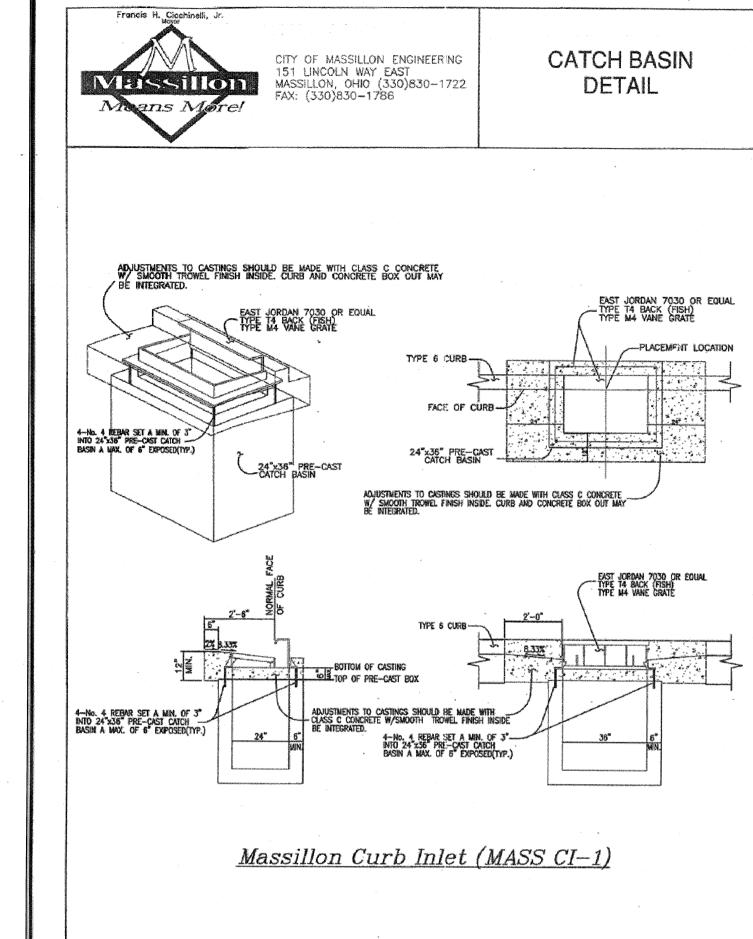

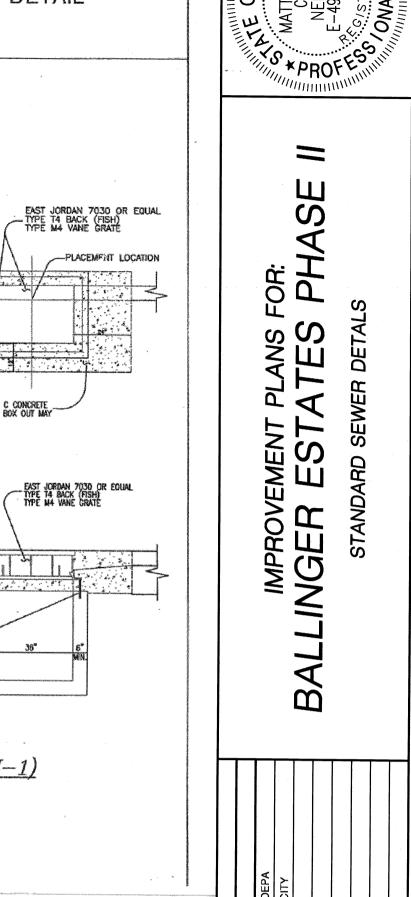

S

 $\mathbf{\Omega}$

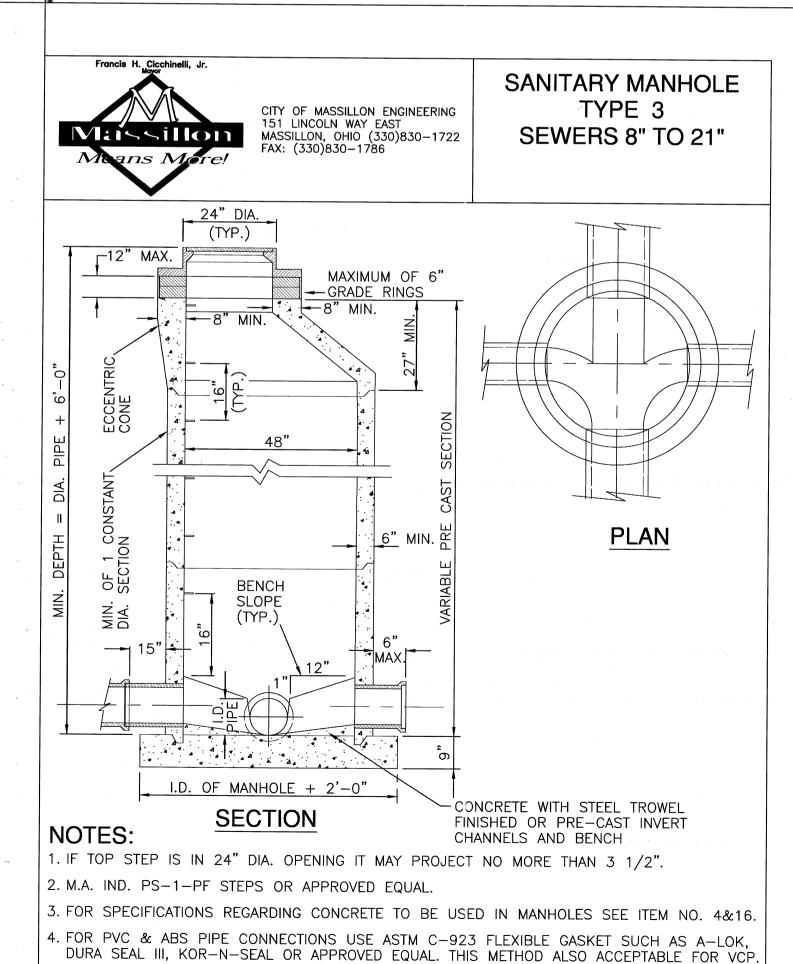


5. PRE CAST MANHOLES SECTIONS SHALL MEET ASTM C-478.

7. MANHOLE ADJUSTMENTS TO GRADE WILL BE NO GREATER THAN 12", USING PRECAST

6. MANHOLE JOINTS SHALL MEET ASTM C-443

COLLARS MEETING ASTM C-478

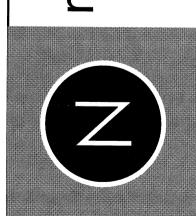

Q

S

Ø

0


Horizontal Scale	Vertical Scale
NONE	-
Original Submissior	Last Plot Date
Feb 06, 2007	May 23, 2007
Drawn By	Checked By
· -	
Project Number	Field Crew
7323	-
Sheet	
40	

PLAN VIEW - SEE STD-018 FOR PROFILE VIEW

	and the second second second	<u> </u>		
	HORIZONTAL CLEARANCE	STORM SEWER	SANITARY SEWER	GAS, DUCTBANK OTHER UTILITY, E
WHEN BOTTOM OF UTILITY PIPE IS AT	"A"	4'-0"	10-0" MIN.	3'-0"
OR ABOVE BOTTOM OF WATER MAIN	"B"	4'-0"	7'-0" MIN.	3'-0"
WHEN BOTTOM OF UTILITY PIPE IS	"A"	5'-0"	10'-0" MIN.	5'-0"
BELOW BOTTOM OF WATER MAIN	"B"	5'-0"	7'-0" MIN.	5'-0"

CLEARANCE FOR UTILITIES

NOT TO SCALE

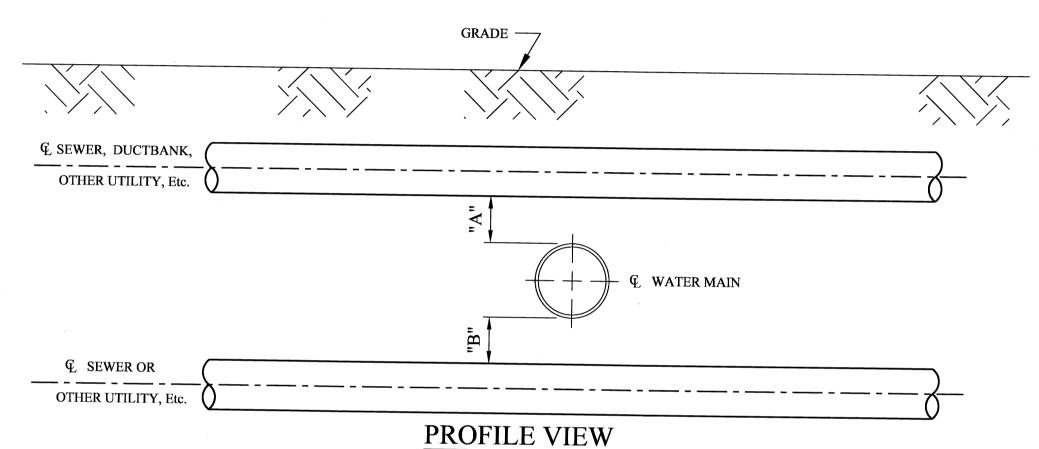

			- SEE SID-01/ FOR	PLAN VIEW -	
VERTICAL CLEARANCE	SANITARY SEWER LESS THAN 24"	SANITARY SEWER 24" & LARGER	STORM SEWER, DUCTBANK, GAS, OTHER UTILITY LESS THAN 24"	STORM SEWER, DUCTBANK, GAS, OTHER UTILITY 24" & LARGER	REMARKS
"A"	18" Min.	*18" Min.	***12"	*12"	*WATER MAIN IN CASING: CLEARANCE TO TOP OF CASING
"B"	18" Min.	**18" Min.	12"	**12"	**CLEARANCE TO TOP OF UTILITY OR TOP OF CASING; WHEN UTILITY IS IN CASING
		CLEARAN	ICE FOR UT	FILITIES	***INCREASE TO 18" WHEN WIDTH OR DIAMETER OF UTILITY IS GREATER THAN

DIAMETER OF UTILITY IS GREATER THAN

DIAMETER OF WATER MAIN

NOT TO SCALE

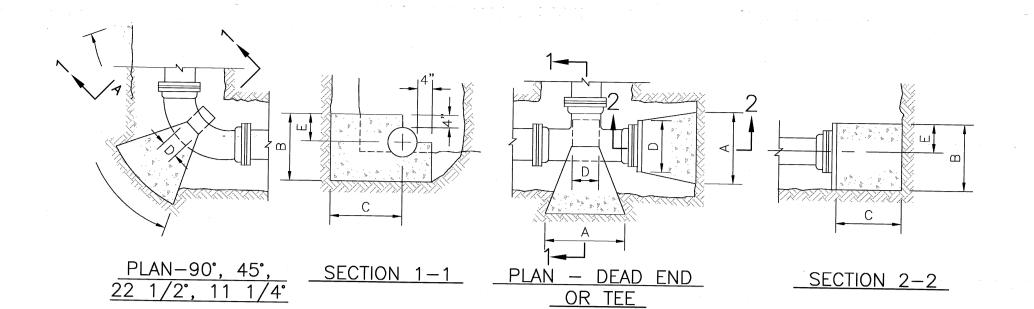


TABLE OF DIMENSION 45° BEND 90° BEND TEE-DEAD END

DIMENSION C
4"-10" DIA.= 2'-0"
12"-16" DIA.= 3'-0"
18"-20" DIA.= 4'-0"
24" DIA.= 5'-0"

4"-10" DIA.= 1'-0" 12"-24"DIA.= 2'-0"

NOTE: BLOCKING DESIGN BASED ON WORKING PRESSURE 150psi+ 100psi WATER HAMMER AND SOIL BEARING 3000psf.


THRUST BLOCKING DETAILS FOR BENDS IN HORIZONTAL PLANE

DIMENSION E

E=D/2 + 4"


FOR ALL DIAMETERS

WORKING PRESSURE UP TO 150psi

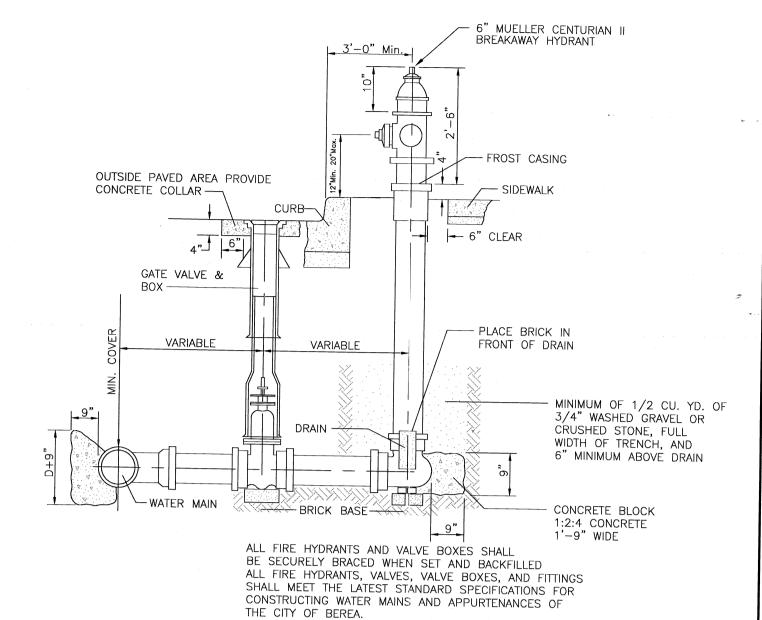


TYPICAL 6" FIRE HYDRANT ASSEMBLY INSTALLATION


N.T.S.

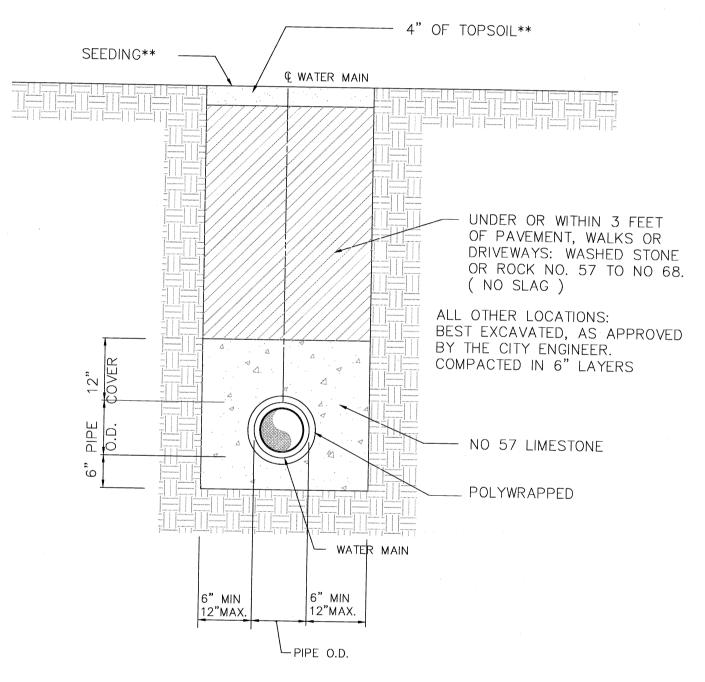

TRENCH DETAIL

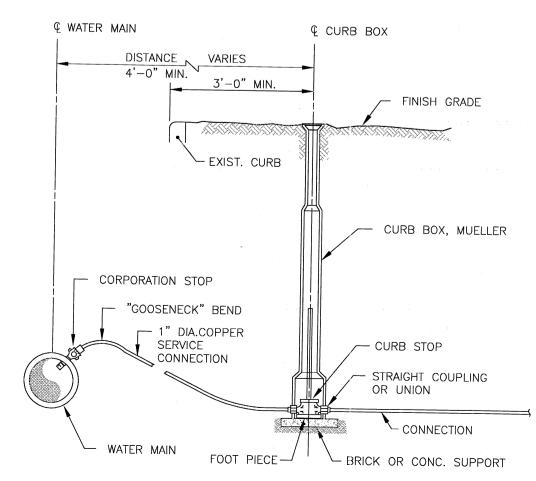

SERVICE CONNECTION

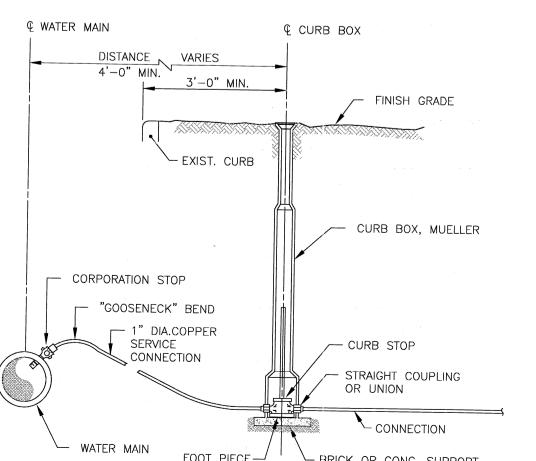

O

Ш


FOR: P.T.


Horizontal Scale Vertical Scale NONE Original Submission Last Plot Date Feb 06, 2007 | Apr 27, 2007 Drawn By Checked By Project Number Field Crew 7323 Sheet


EPA NOTES:

1) BOOSTER PUMPS ARE NOT PERMITTED ON SERVICE CONNECTIONS.

2) THE PROPOSED IMPROVEMENTS WILL PROVIDE A MINIMUM 35 PSI PRESSURE AT THE CURB STOP DURING NORMAL OPERATING CONDITIONS.

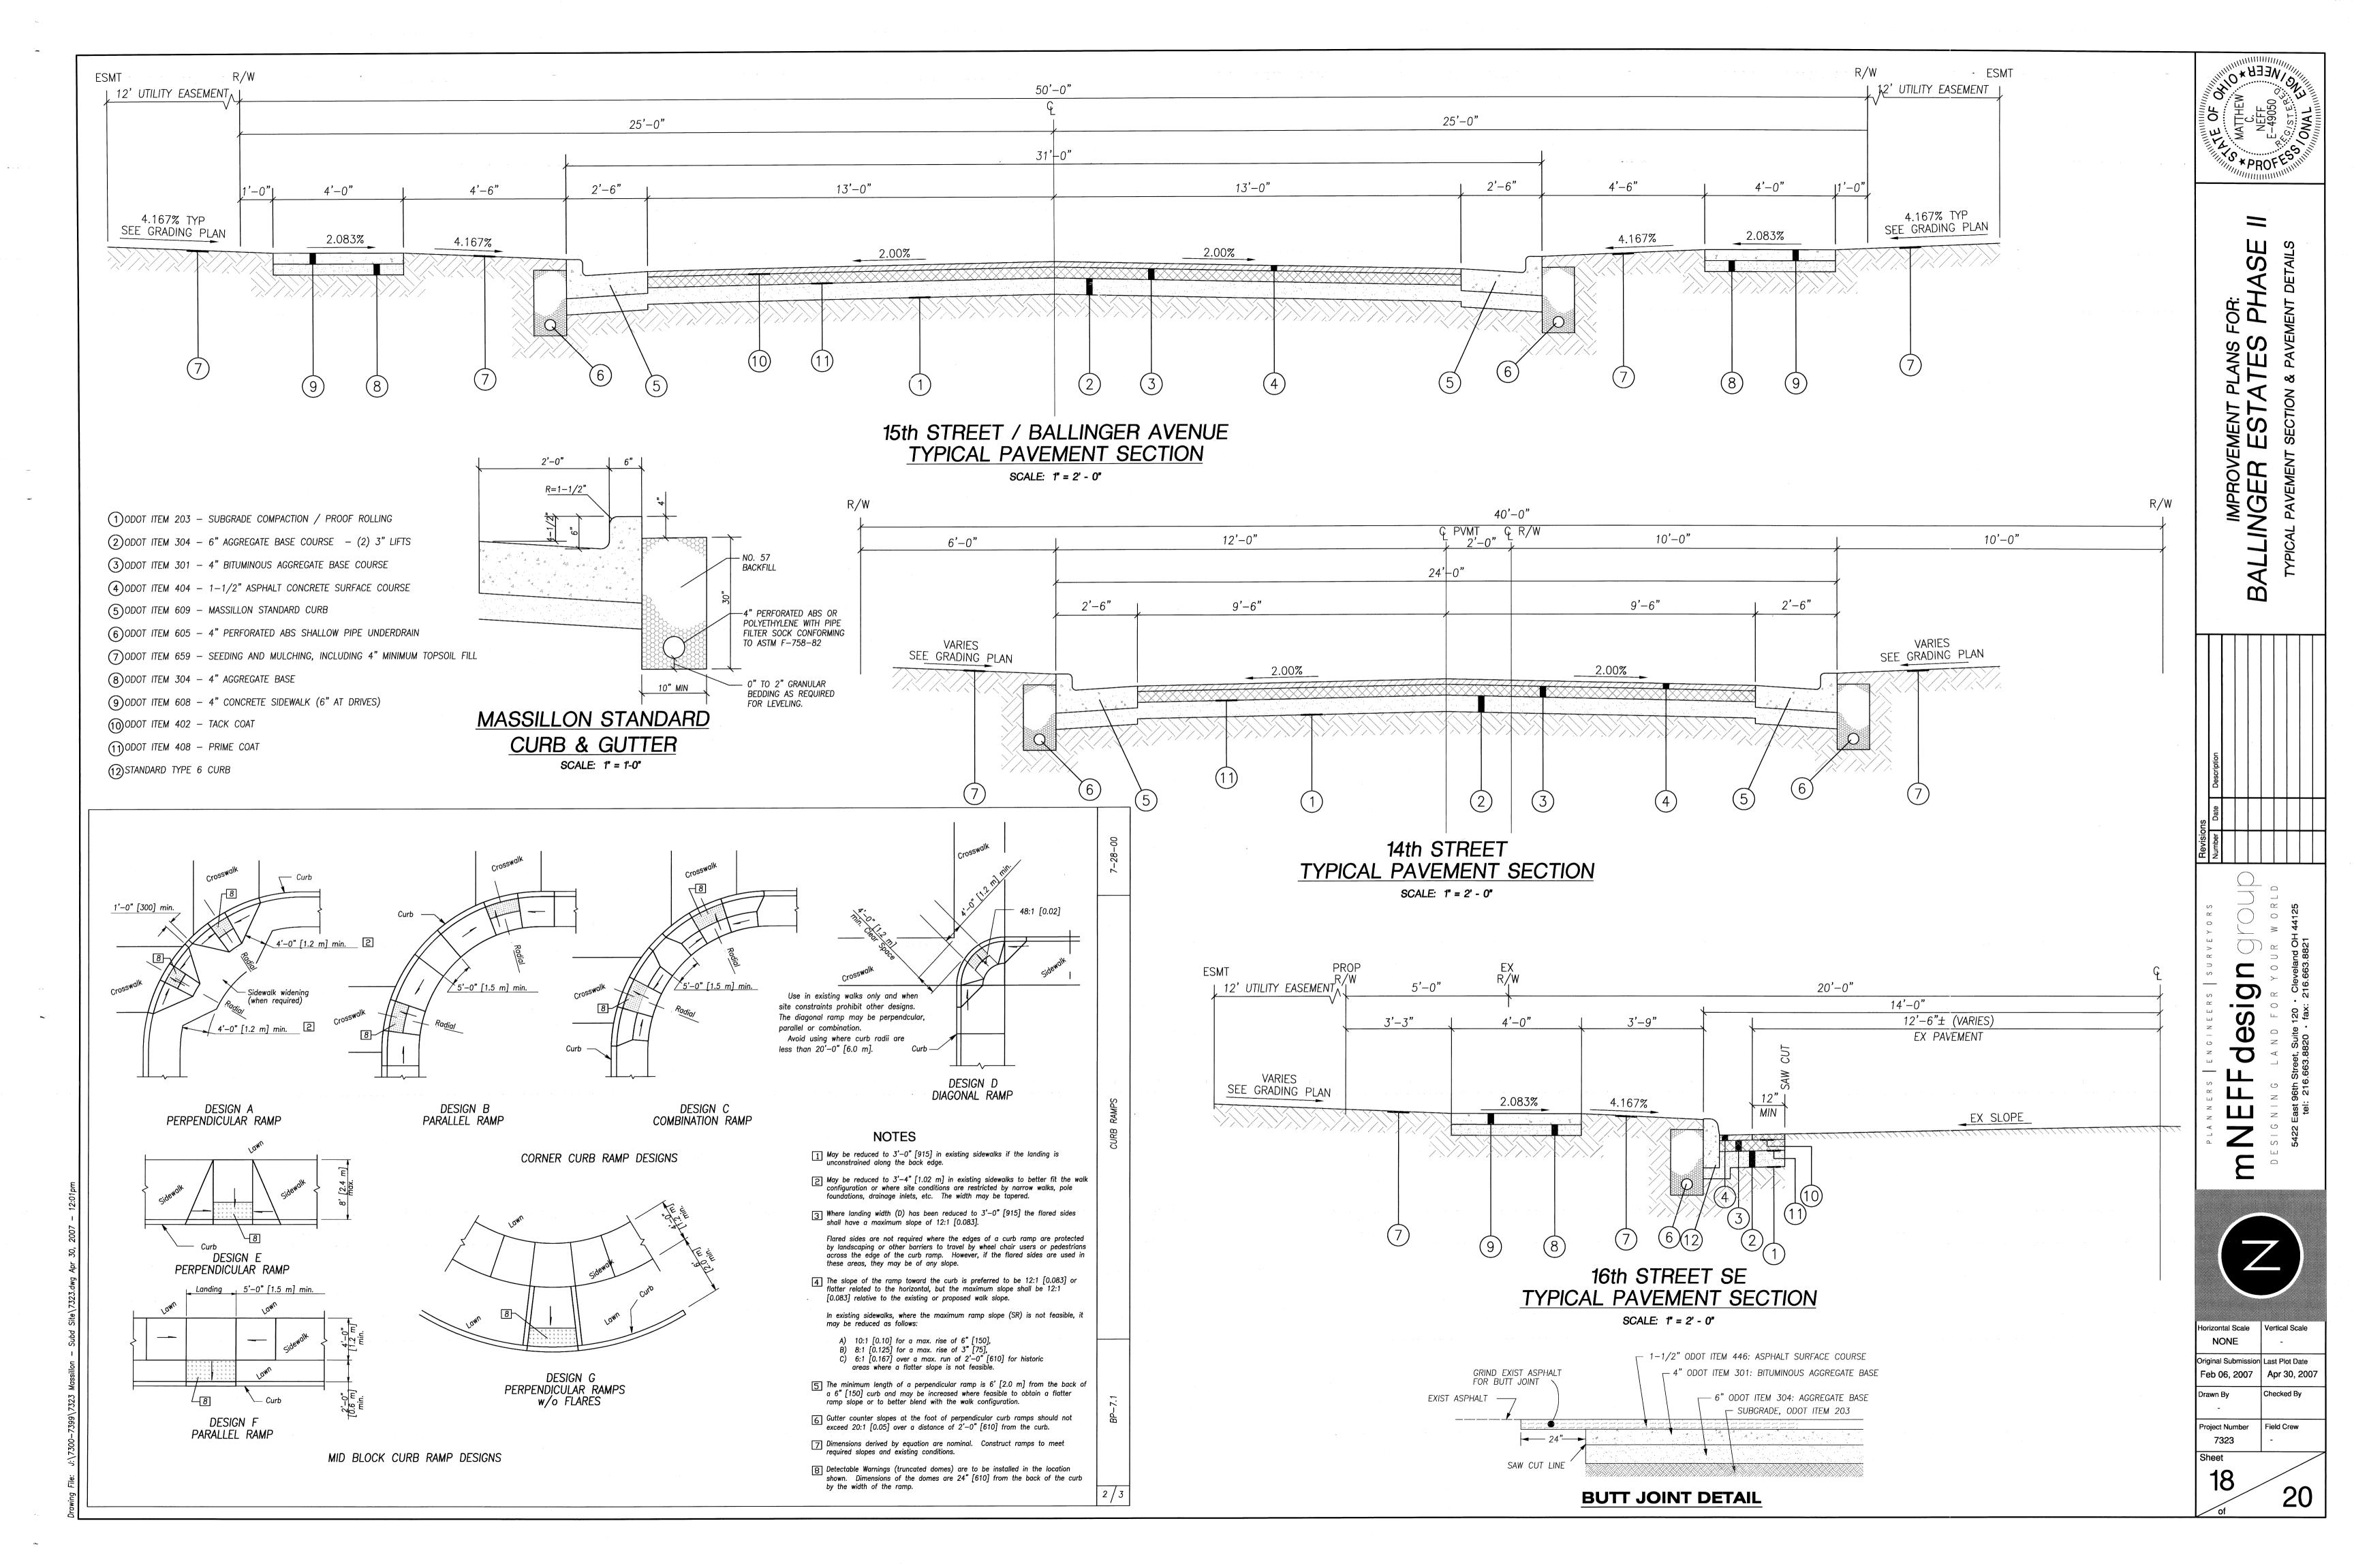

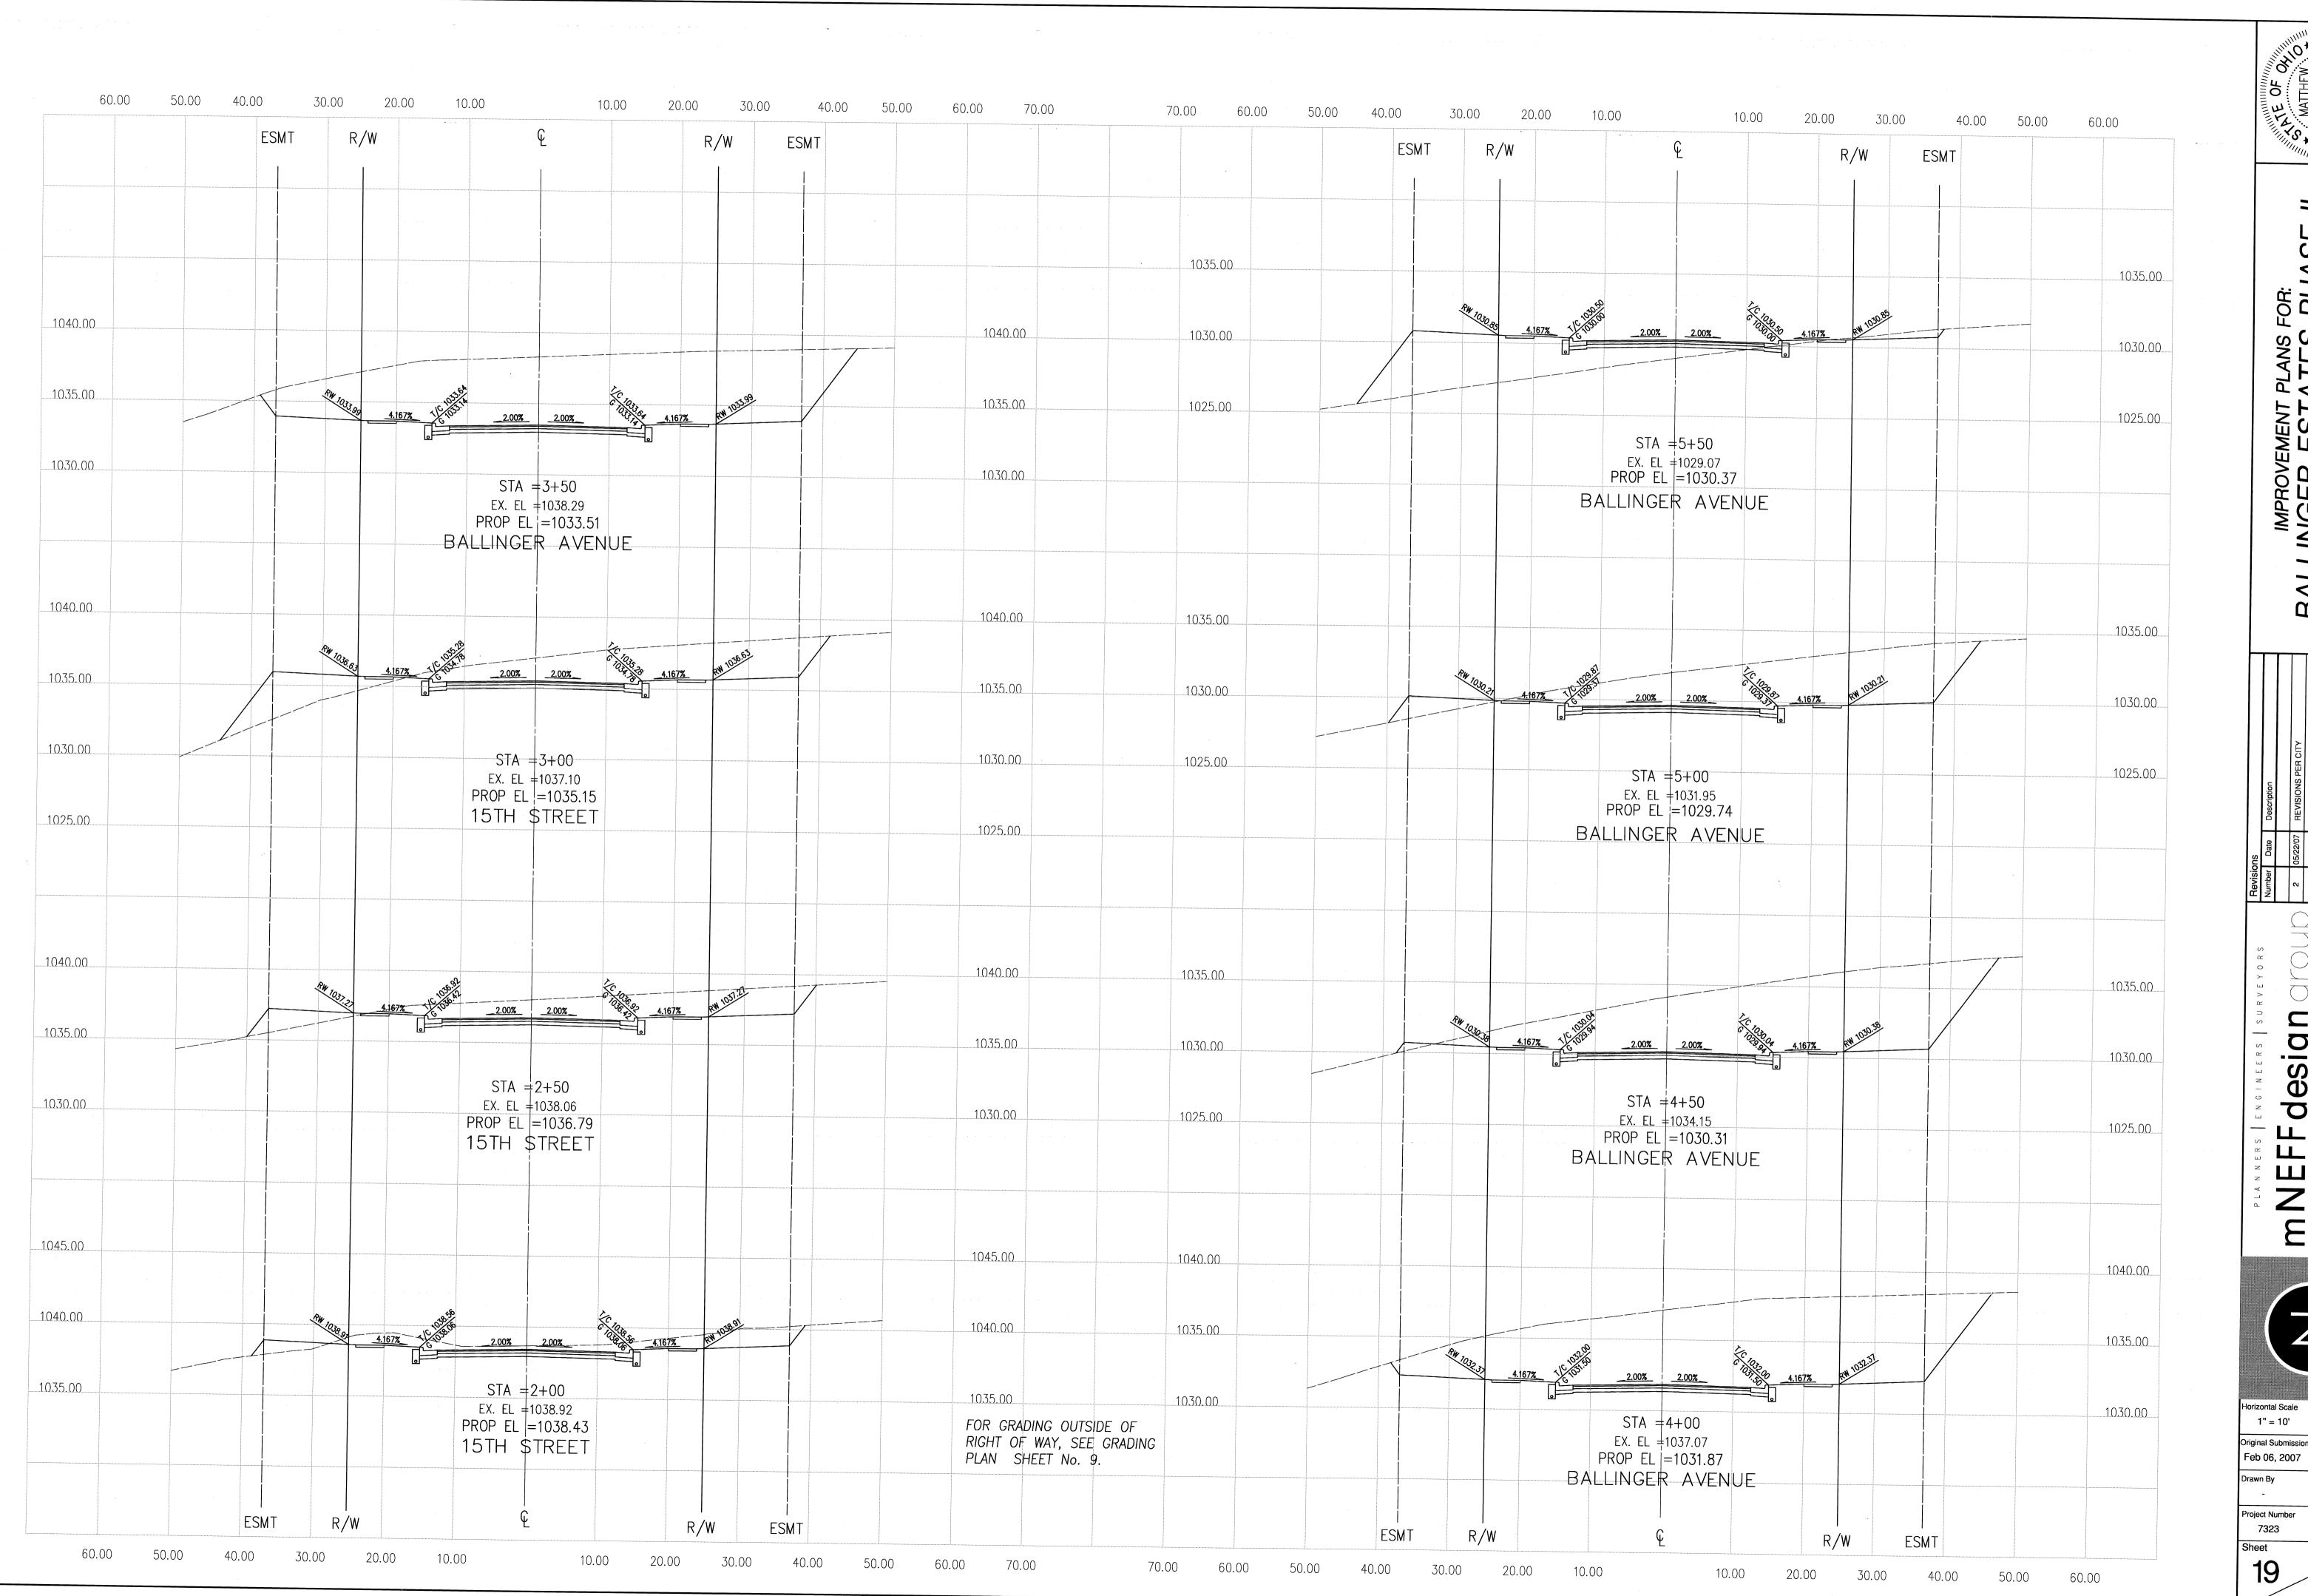


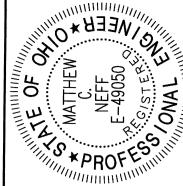

SE FOR: PHA IMPROVEMENT BALLINGER EST,

esig

Horizontal Scale	Vertical Scale
1" = 10'	1" = 5'
Original Submission	Last Plot Date
Feb 06, 2007	May 23, 2007
Drawn By	Checked By
-	
Project Number	Field Crew
7323	-
Sheet	

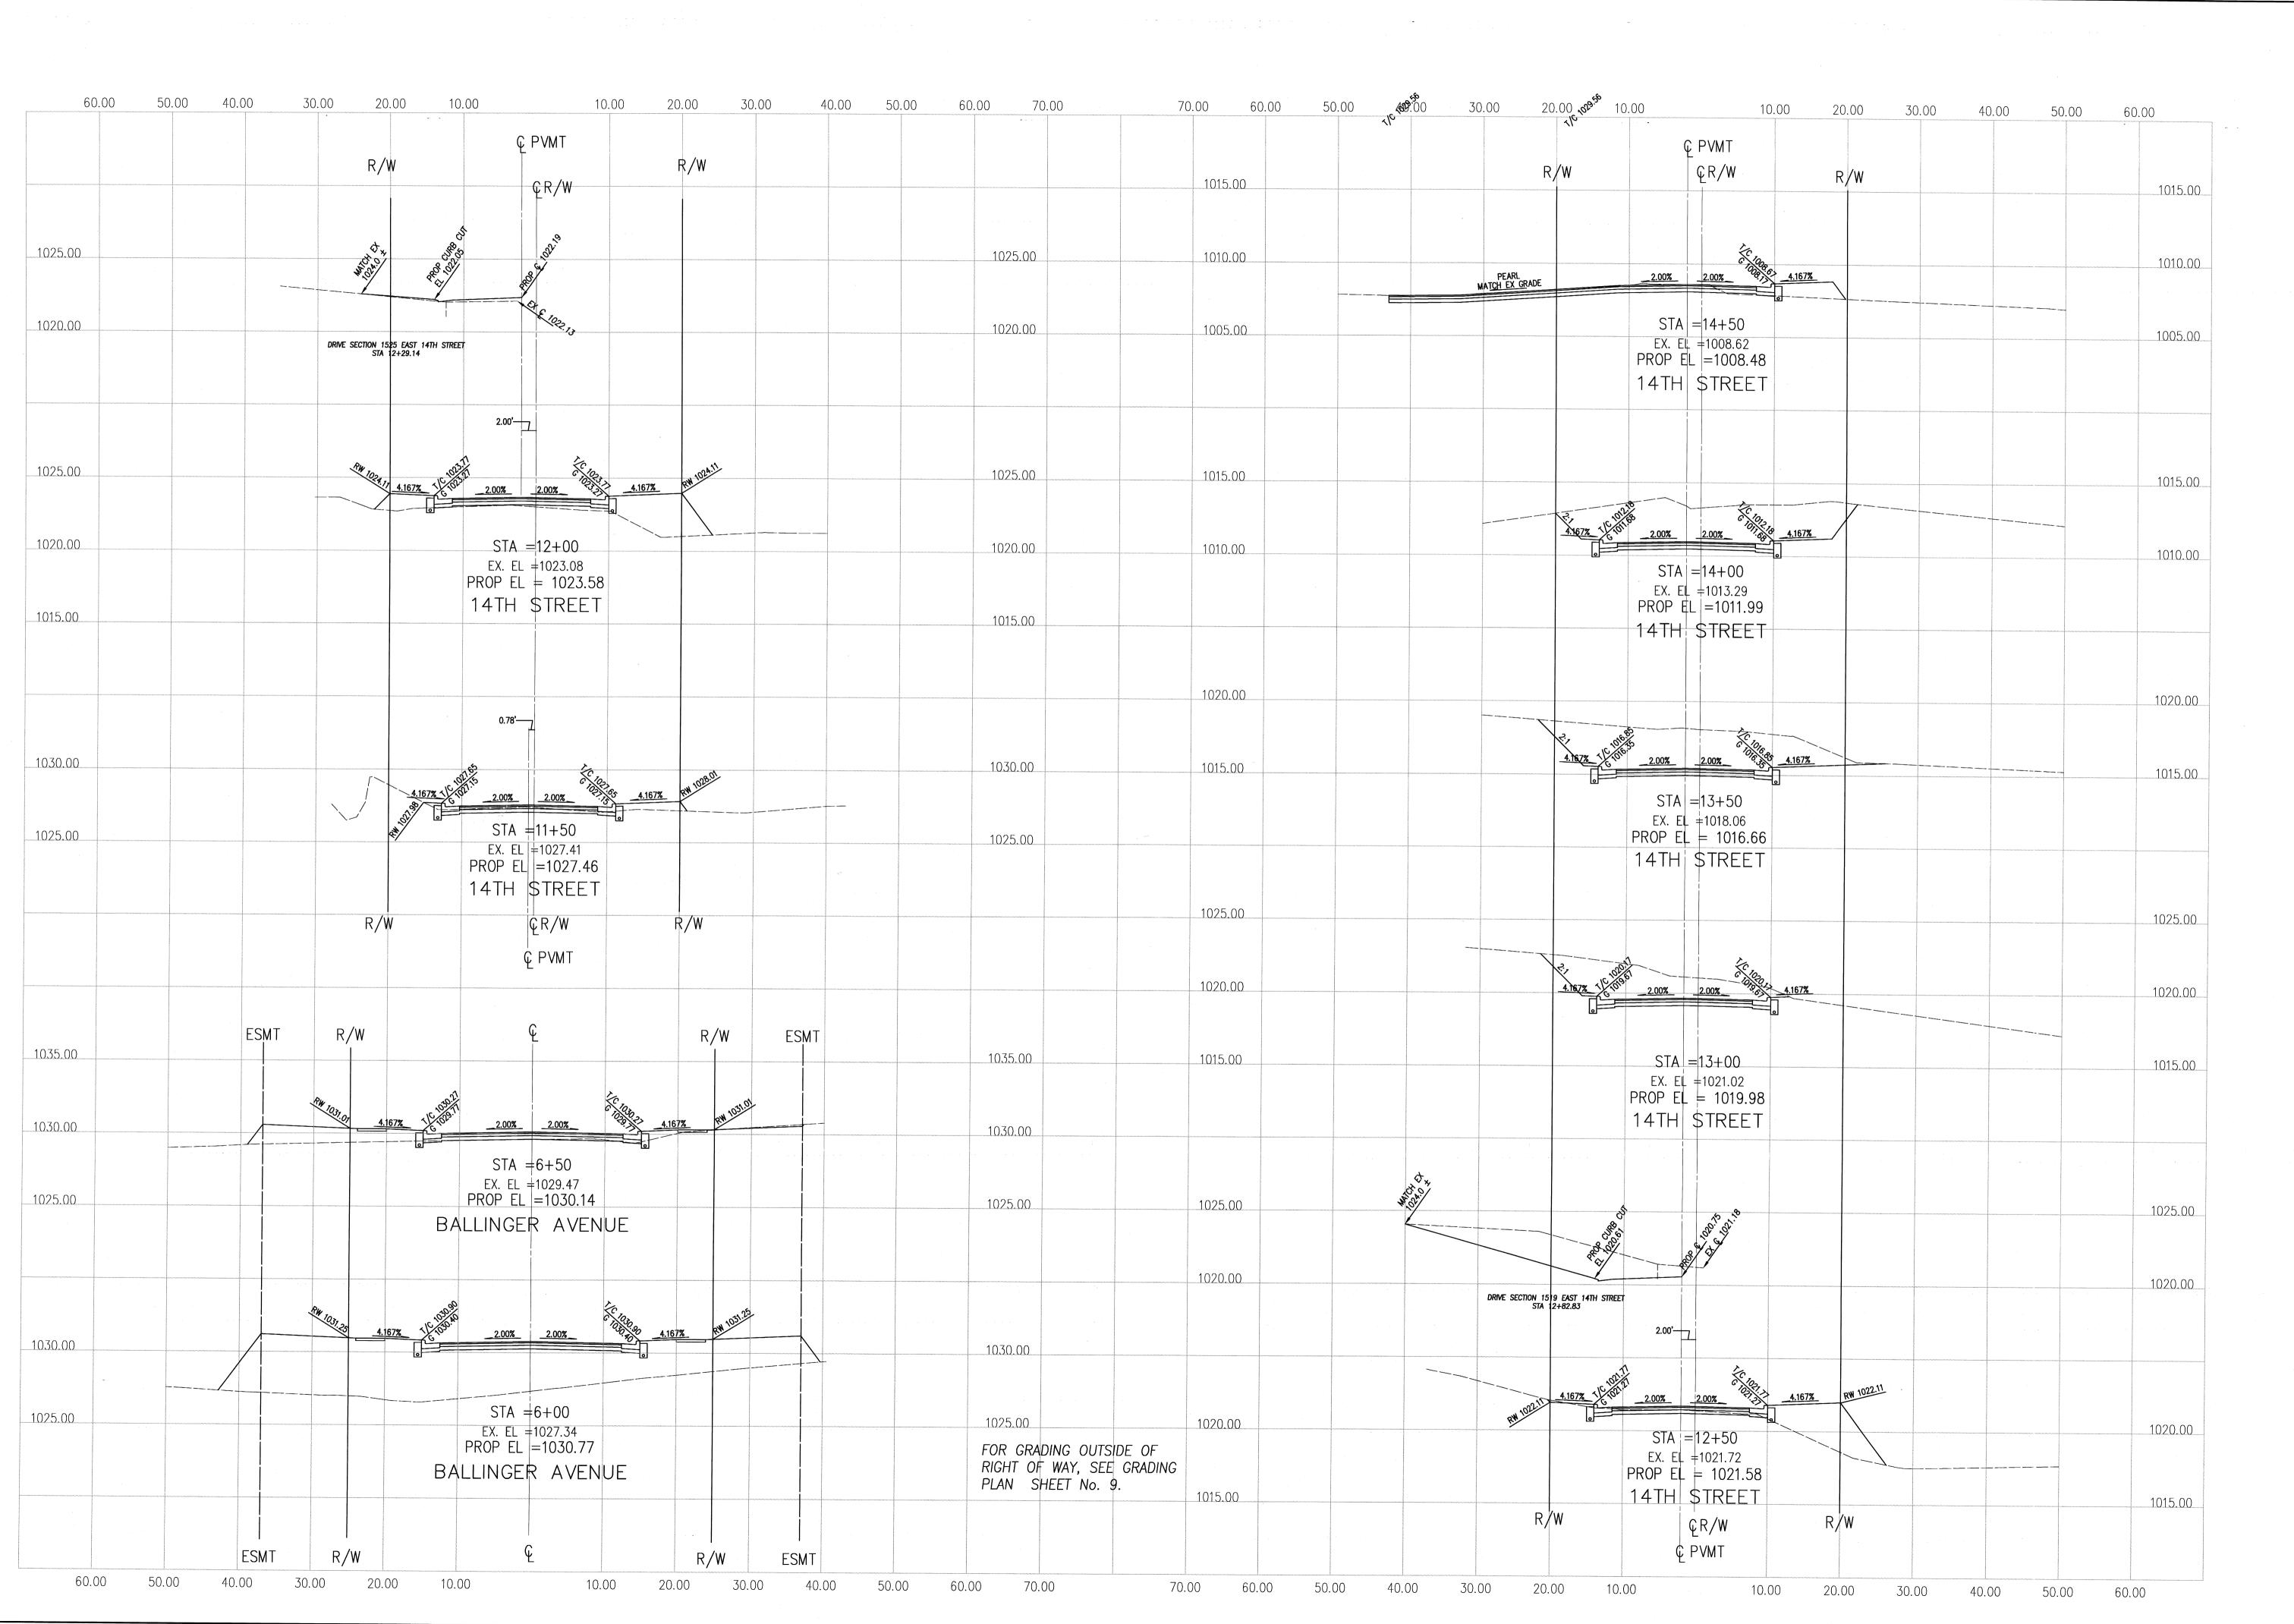



IMPROVEMENT PLANS FOR:

BALLINGER ESTATES PHASE I

CROSS SECTIONS

BALLINGER AVENUE & 14TH STREET

Bevisions

Number Date Description

BOSCIPTION

BOSCIPTION

C 05/22/07 REVISIONS PER CITY

N D F O R Y O U R W O R L D

Suite 120 • Cleveland OH 44125

20 • fax: 216.663.8821

Q

Horizontal Scale

1" = 10'

Original Submission
Feb 06, 2007

Drawn By

Checked By

Project Number
7323

Sheet

Sheet 20