


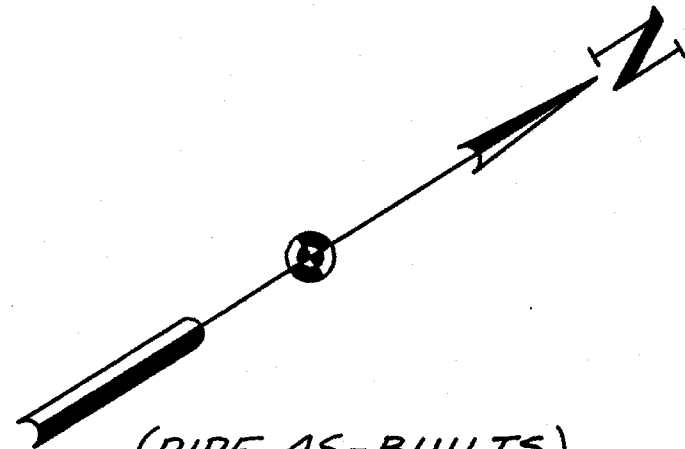

(PIPE AS-BUILTS)

PIPE	(LENGTH)	(E IN)	(E OUT)
1	10.0'	1010.79	1010.76
2	11.0'	1010.57	1009.95
3	39.0'	1010.76	1009.95
4	249.6'	1009.95	1005.88
5	10.0'	1005.45	1005.33
6	10.0'	1006.04	1004.95
7	39.5'	1005.33	1005.00
8	249.0'	1004.85	992.03
9	39.0'	994.00	993.67
10	104.1'	993.67	992.41
11			
12	250.6'	1006.06	1004.61
13	70.0'	1005.93	1004.61
14	249.5'	1004.61	1003.69
15	10.5'	1004.59	1004.06
16	39.5'	1004.06	1003.69
17			
18	249.5'	1003.69	1001.82
19	249.8'	1001.82	999.75
20	19.5'	1002.38	1001.43
21	19.5'	1001.76	1001.43
22	183.4'	996.28	994.00
23	253.7'	999.75	998.37
24	251.7'	998.37	996.68
25	254.7'	996.68	995.57

BENCHMARK:

16d NAIL SET 1'± S. SIDE OF WOOD POLE #865747
● STA. 38+00, STERILITE AVE., 222' RT.

ELEV. = 1029.75

NOTE:

ROOF DRAINS, FOUNDATION DRAINS & OTHER CLEAN WATER
CONNECTIONS TO THE SANITARY SEWER ARE PROHIBITED.

T/C DENOTES TOP OF COVER
T/CU DENOTES TOP OF CURB

PIPE CHART

PIPE	SIZE	TYPE	LENGTH	GRADE	E IN	E OUT
P 25	42"	B	258'	0.5%	997.70	996.41

SMOOTH LINED CORRUGATED POLYETHYLENE PIPE OR
APPROVED EQUAL MAY BE USED IN PLACE OF R.C.P.

CURVE DATA

① A=237.66'
R=225.00'
Δ=60°31'11"
Bch=N 37°30'20" E
C=225.77'
T=131.27'

STERILITE AVE. S.W.-60'
N 07°14'45" E
13+00


11' L.x7' W.x1.5' D. ROCK
CHANNEL PROTECTION, TYPE
"C"/FILTER.

HEADWALL HW-4
STA. 19+70.65, 141.64' RT.
E OUT 996.41 (995.57)

STM. M.H. #4
STA. 21+85.83
T/C 1013.04 (1011.08)
E 997.70 (996.68)

APPROVED MARCEL S. ARMSTRONG BY Franklin Thomas DATE 7/3/96
STARK COUNTY SANITARY ENGINEER

APPROVED Franklin Thomas DATE 7-3-96
STARK COUNTY SUBDIVISION ENGINEER

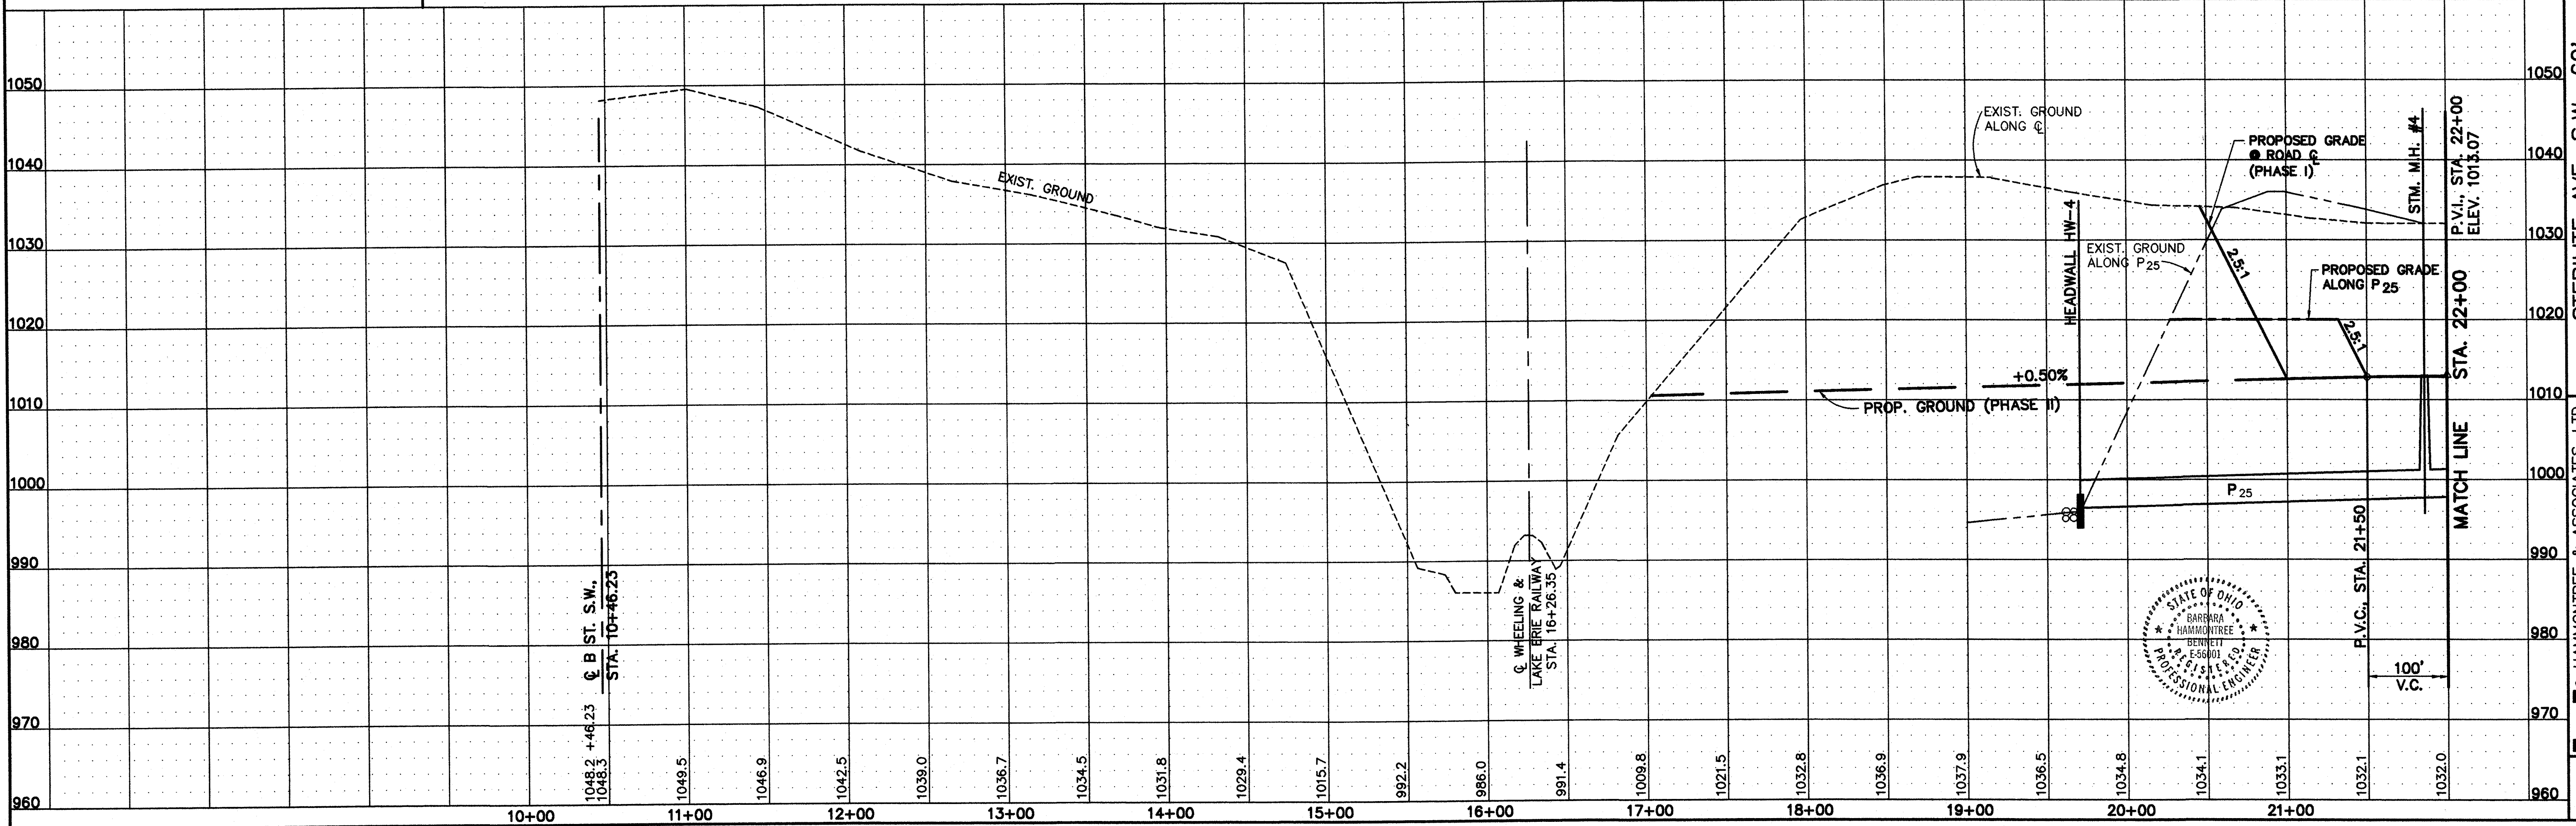

HAMMONTREE & ASSOCIATES, LTD.
ENGINEERS, PLANNERS, SURVEYORS

CANTON, OHIO 44720
5233 STONEHAM ROAD, NORTH CANTON, OHIO 44720
PHONE: (330) 488-8817 FAX: (330) 488-0149
TOLL FREE: 1-800-384-8817

STERILITE AVE. S.W.-60'
PLAN & PROFILE-STA. 10+46.23 TO 22+00
LOCATED IN THE N.W. & S.W. QUARTERS, SEC. 33,
(1-10-R-9), PERRY TWP., STARK COUNTY, OHIO.


SCALES:
HORIZ: 1"=50'
VERT: 1"=10'



DESIGNED BY: _____ CHECKED BY: _____
DRAWN BY: _____ REVIEWED BY: _____
F.B. PAGE: _____
COPYRIGHT: 1996 DATE: MARCH 1996
REVISION BY: BHB DATE: 5/1/96 DESCRIPTION: PER GIS CONSTRUCTION

REVISION BY: _____ DATE: _____ DESCRIPTION: _____
REVISION BY: _____ DATE: _____ DESCRIPTION: _____
REVISION BY: MLD DATE: 11/25/96 DESCRIPTION: STORM AS-BUILTS
REVISION BY: DTW DATE: 6/28/96 DESCRIPTION: 10' UTILITY EASMT ADDED
REVISION BY: BHB DATE: 5/1/96 DESCRIPTION: PER GIS CONSTRUCTION

AS-BUILTS - STERILITE STREET - NEOCOM

98 SD 03

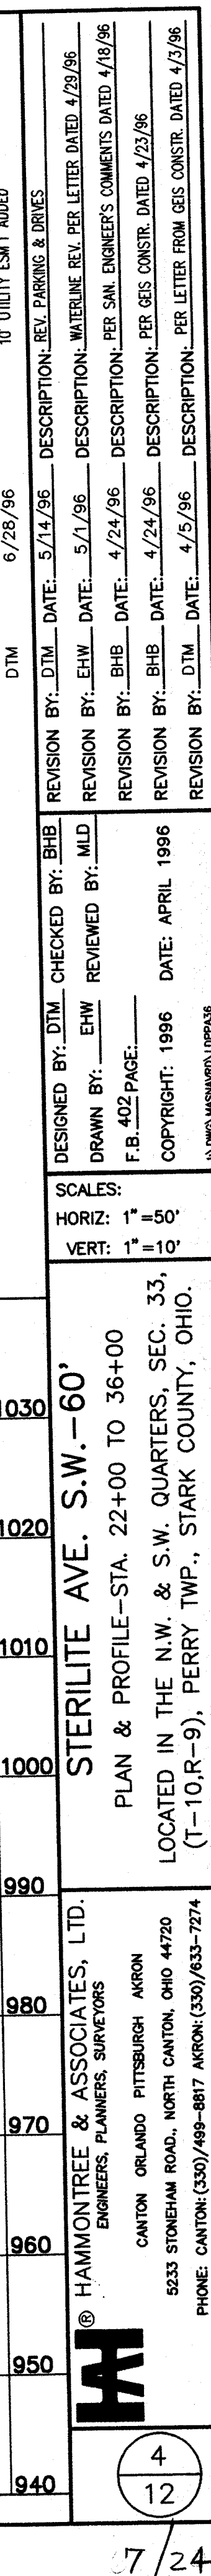

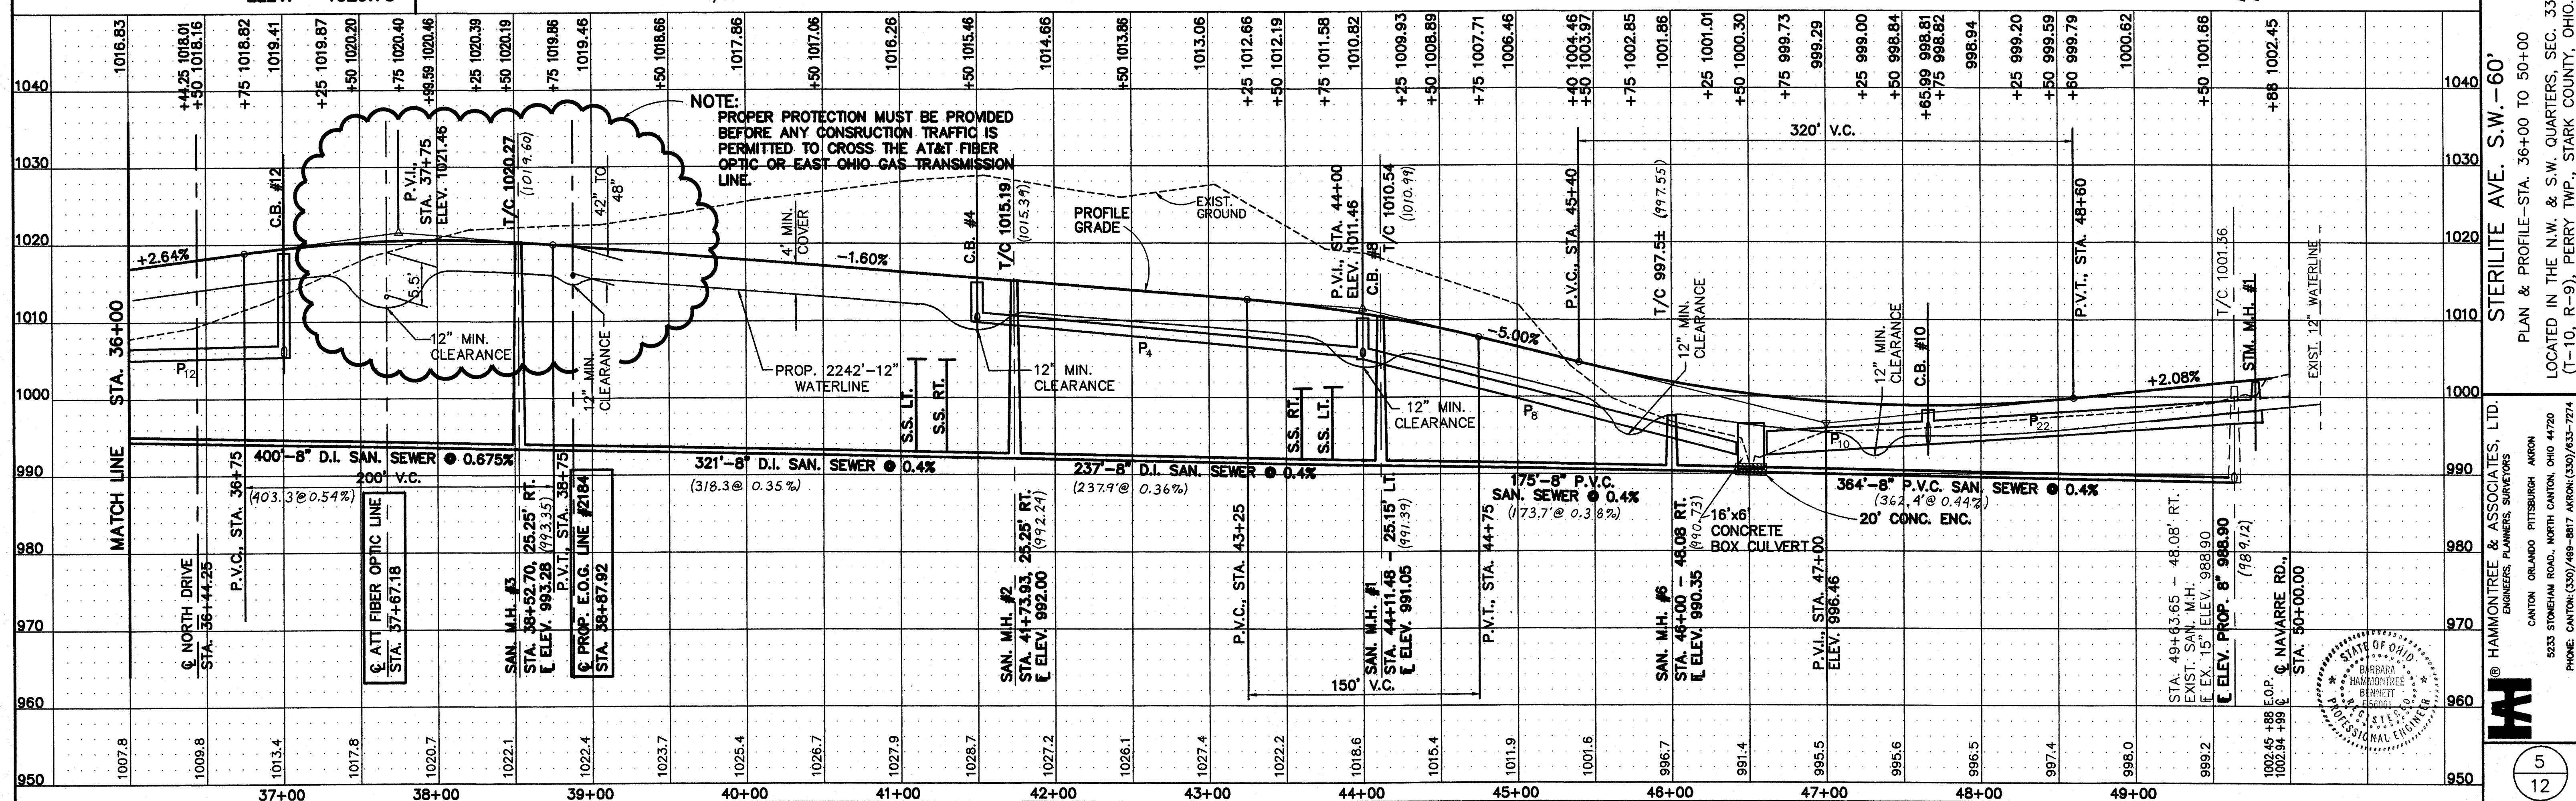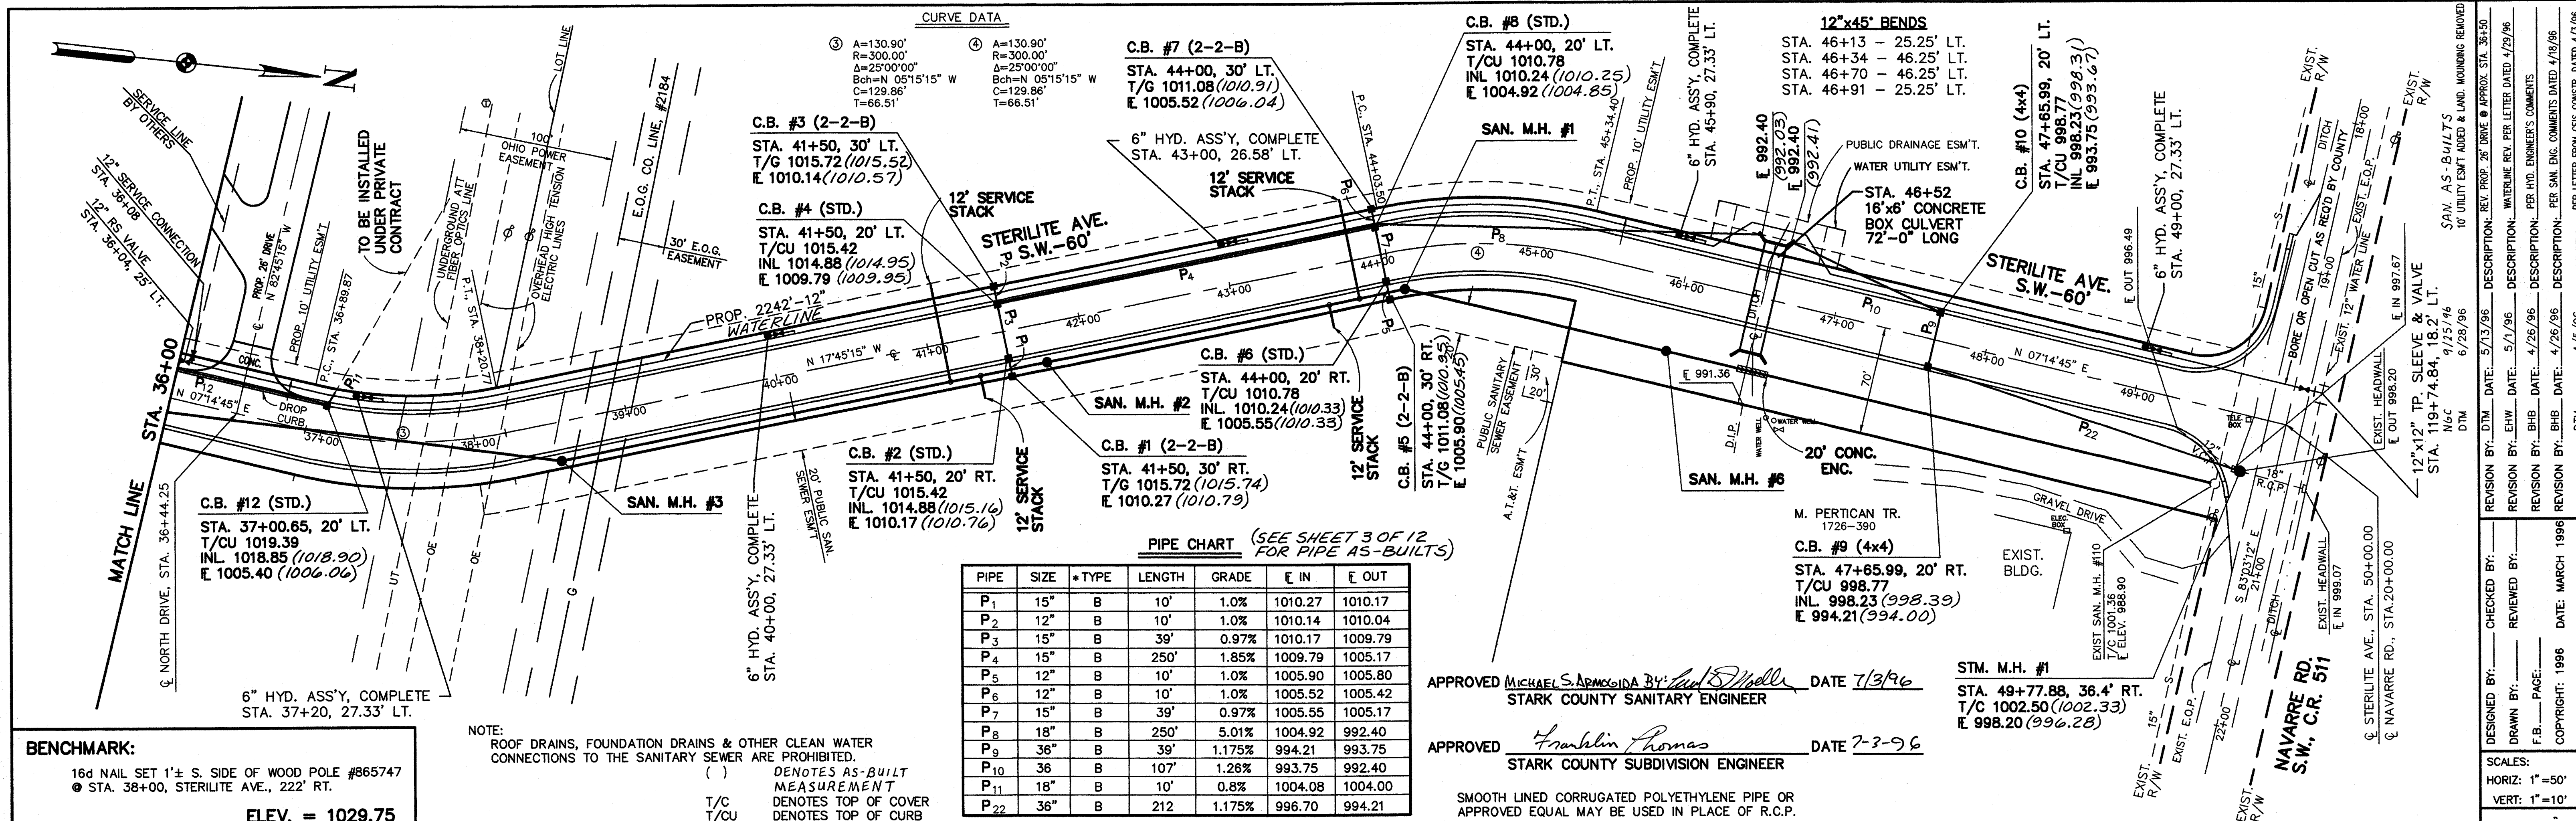

BENCHMARK:
16d NAIL SET 1"± S. SIDE OF WOOD POLE #865747
● STA. 38+00, STERILITE AVE., 222' RT.
ELEV. = 1029.75

NOTE:
ROOF DRAINS, FOUNDATION DRAINS & OTHER CLEAN WATER CONNECTIONS TO THE SANITARY SEWER ARE PROHIBITED.
() DENOTES AS-BUILT MEASUREMENT
T/C DENOTES TOP OF COVER
T/CU DENOTES TOP OF CURB

PIPE CHART (SEE SHEET 3 OF 12 FOR PIPE AS-BUILTS)

PIPE	SIZE	*TYPE	LENGTH	GRADE	E IN	E OUT
P ₁	15"	B	10'	1.0%	1010.27	1010.17
P ₂	12"	B	10'	1.0%	1010.14	1010.04
P ₃	15"	B	39'	0.97%	1010.17	1009.79
P ₄	15"	B	250'	1.85%	1009.79	1005.17
P ₅	12"	B	10'	1.0%	1005.90	1005.80
P ₆	12"	B	10'	1.0%	1005.52	1005.42
P ₇	15"	B	39'	0.97%	1005.55	1005.17
P ₈	18"	B	250'	5.01%	1004.92	992.40
P ₉	36"	B	39'	1.175%	994.21	993.75
P ₁₀	36"	B	107'	1.26%	993.75	992.40
P ₁₁	18"	B	10'	0.8%	1004.08	1004.00
P ₁₂	36"	B	212'	1.175%	996.70	994.21

APPROVED *Michael S. Arpogida* BY: *Franklin Thomas* DATE 7/3/96
STARK COUNTY SANITARY ENGINEER STARK COUNTY SUBDIVISION ENGINEER

APPROVED *Franklin Thomas* DATE 7-3-96
STARK COUNTY SUBDIVISION ENGINEER

SMOOTH LINED CORRUGATED POLYETHYLENE PIPE OR APPROVED EQUAL MAY BE USED IN PLACE OF R.C.P.

DESIGNED BY: _____ **CHECKED BY:** _____
DRAWN BY: _____ **REVIEWED BY:** _____
F.B.: _____ **PAGE:** _____
COPYRIGHT: 1996 **DATE:** MARCH 1996
SCALE: _____
HORIZ: 1" = 50'
VERT: 1" = 10'

STERILITE AVE. S.W. - 60'
PLAN & PROFILE - STA. 36+00 TO 50+00
LOCATED IN THE N.W. & S.W. QUARTERS, SEC. 33, (T-10, R-9), PERRY TWP., STARK COUNTY, OHIO.

© HAMMONTREE & ASSOCIATES, LTD.
ENGINEERS, PLANNERS, SURVEYORS
CANTON OHIO 44720
5333 STONEHAM ROAD, NORTH CANTON, OHIO 44720
PHONE: CANTON (330) 499-8817 ARKON (330) 633-7274
TOLL FREE: 1-800-394-8817 FAX: (330) 499-0149