

PROPERTY LINE, STA. 30+00.00

PROPERTY LINE

SEE SHEET #
DEBBIE CIR. S.W.-50'

Q EILEEN AVE., STA. 31+70.00
Q DEBBIE ST., STA. 65+50.90

67+00

64+00

65+00

66+00

3" GAS LINE #3754

SEE SHEET #
LOU ST. S.W.-50'

Q EILEEN AVE., STA. 35+44.96
Q LOU ST., STA. 53+32.09

52+00

53+00

54+00

EILEEN AVE.
S.W.-50'

BASELINE "A"

S 86°45'00" E

36+00

37+00

38+00

GRADE EILEEN AVE. TO
WEST LINE OF LOT 15
END STORM SEWER INSTALLATION
STA. 38+49.83, 17'40" LT.

ALLOT. LINE

Q KELLY ST., STA. 15+80.90
Q EILEEN AVE., STA. 39+19.96

C.B. #B7

C.B. #B4

C.B. #B1

C.B. #B2

C.B. #B3

C.B. #B5

C.B. #B6

C.B. #B8

C.B. #B9

C.B. #B10

C.B. #B11

C.B. #B12

C.B. #B13

C.B. #B14

C.B. #B15

C.B. #B16

C.B. #B17

C.B. #B18

C.B. #B19

SEE SHEET #3
KELLY ST.
S.W.-50'

SEE SHEET #4
KELLY ST.
S.W.-50'

SEE SHEET #5
KELLY ST.
S.W.-50'

SEE SHEET #6
KELLY ST.
S.W.-50'

SEE SHEET #7
KELLY ST.
S.W.-50'

SEE SHEET #8
KELLY ST.
S.W.-50'

SEE SHEET #9
KELLY ST.
S.W.-50'

SEE SHEET #10
KELLY ST.
S.W.-50'

SEE SHEET #11
KELLY ST.
S.W.-50'

SEE SHEET #12
KELLY ST.
S.W.-50'

SEE SHEET #13
KELLY ST.
S.W.-50'

SEE SHEET #14
KELLY ST.
S.W.-50'

SEE SHEET #15
KELLY ST.
S.W.-50'

SEE SHEET #16
KELLY ST.
S.W.-50'

SEE SHEET #17
KELLY ST.
S.W.-50'

SEE SHEET #18
KELLY ST.
S.W.-50'

SEE SHEET #19
KELLY ST.
S.W.-50'

SEE SHEET #20
KELLY ST.
S.W.-50'

SEE SHEET #21
KELLY ST.
S.W.-50'

SEE SHEET #22
KELLY ST.
S.W.-50'

SEE SHEET #23
KELLY ST.
S.W.-50'

SEE SHEET #24
KELLY ST.
S.W.-50'

SEE SHEET #25
KELLY ST.
S.W.-50'

SEE SHEET #26
KELLY ST.
S.W.-50'

SEE SHEET #27
KELLY ST.
S.W.-50'

SEE SHEET #28
KELLY ST.
S.W.-50'

SEE SHEET #29
KELLY ST.
S.W.-50'

SEE SHEET #30
KELLY ST.
S.W.-50'

PROPERTY LINE, STA. 40+86.96

CITY TO EXTEND SAN.
SEWER TO ALLOT. LINE
FROM EXIST. M.H.

EXIST. SAN. SEWER

EXIST. SAN. SEWER

PIPE CHART

PIPE	SIZE	*TYPE	LENGTH	GRADE	E IN	E OUT
20	18"	B-RCP	34'	1.1%	1019.56	1019.19
21	18"	B-RCP	69'	1.3%	1019.19	1018.29
22	12"	B-RCP	12'	15.5%	1019.65	1017.79
23	36"	B-RCP	100'	0.65%	1018.13	1017.48
24	36"	C-RCP	10'	0.70%	1017.48	1017.41

(AS-BUILTS)

20	(66')	1.71%	(1019.99)	(1018.86)
21	(13')	5%	(1019.91)	(1019.26)
22	(99')	0.53%	(1018.46)	(1017.94)
24	(18')	3.0%	(1017.94)	(1017.40)

EXIST SAN. M.H.
STA. 42+43.23, 13.41' RT.
T/C 1020.50
E 1010.41 (1020.48)

STM. M.H. #B9
STA. 40+47, 20.25' RT.
T/C 1023.68
E 1017.48 (1017.94)

6" ROCK CHANNEL PROTECTION,
TYPE "C", 18" D. x 6' W. x 10' L.

HEADWALL HALF
STA. 40+50.94, 29.44' RT.
E 1017.41 (1017.40)

NORTH-SOUTH DITCH
CROSS SECTIONS WILL BE
SHOWN ON FUTURE PLANS

TYPICAL DITCH
FROM P.24 TO
NORTH-SOUTH DITCH


BENCHMARK:

RAILROAD SPIKE 1' UP N. SIDE OF 12" ASH
AT STA. 41+00, 100±' RT. OF EILEEN AVE.

ELEV. = 1020.27

NOTE:
T/C DENOTES TOP OF COVER
T/OU DENOTES TOP OF CURB
() DENOTES AS-BUILT MEASUREMENTS
ROOF DRAINS, FOUNDATION DRAINS & OTHER CLEAN WATER
CONNECTIONS TO THE SANITARY SEWER ARE PROHIBITED.

APPROVED _____ DATE 8-2-93
MASSILLON CITY ENGINEER

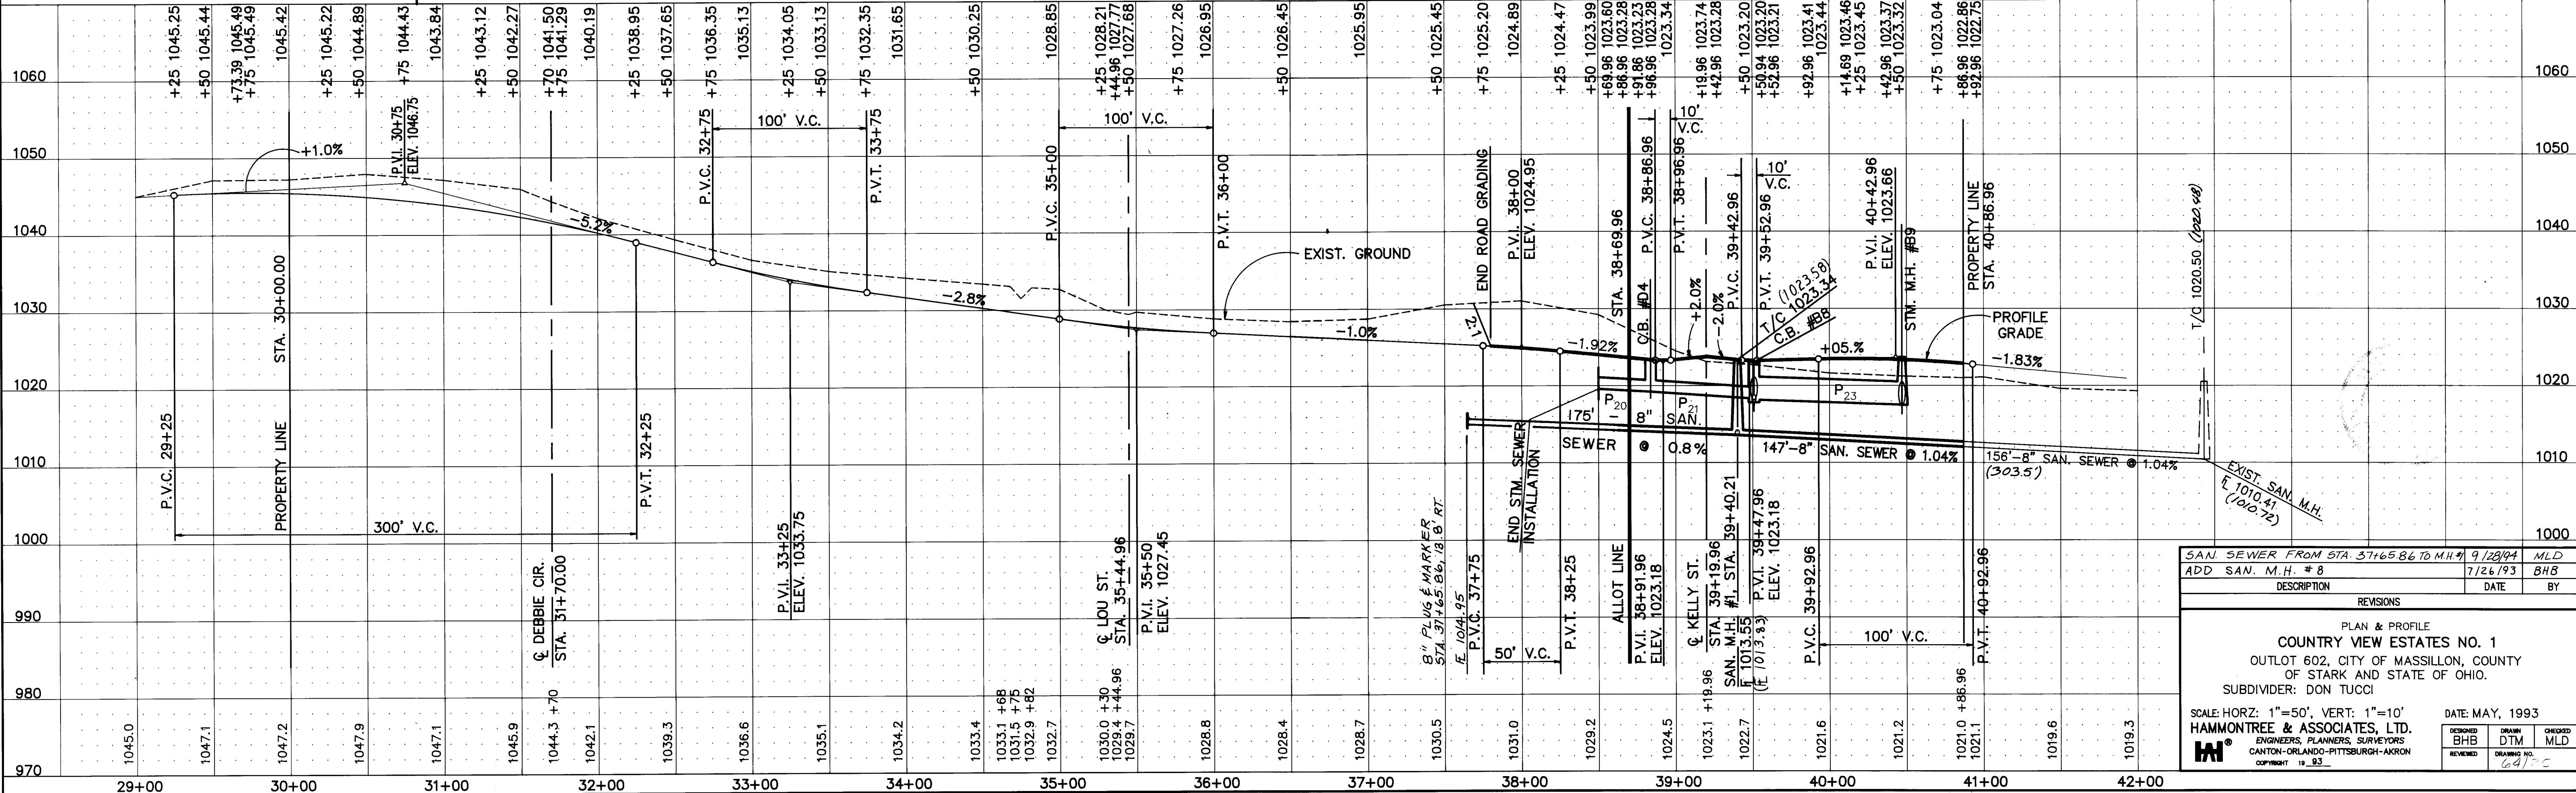



COUNTRY VIEW ESTATES NO. 1
OUTLOT 602, CITY OF MASSILLON, COUNTY
OF STARK AND STATE OF OHIO.
SUBDIVIDER: DON TUCCI

SCALE: HORIZ: 1"=50', VERT: 1"=10'
HAMMONTREE & ASSOCIATES, LTD.
ENGINEERS, PLANNERS, SURVEYORS
CANTON, OHIO
COPYRIGHT 1993

DATE: MAY, 1993
DESIGNED: BHB
DRAWN: DTM
CHECKED: MLD
REVIEWED: BHB



EILEEN AVE., STA. 38+69.96 TO 40+86.96
SHEET 5 OF 13

SD 527
AccNo 3369

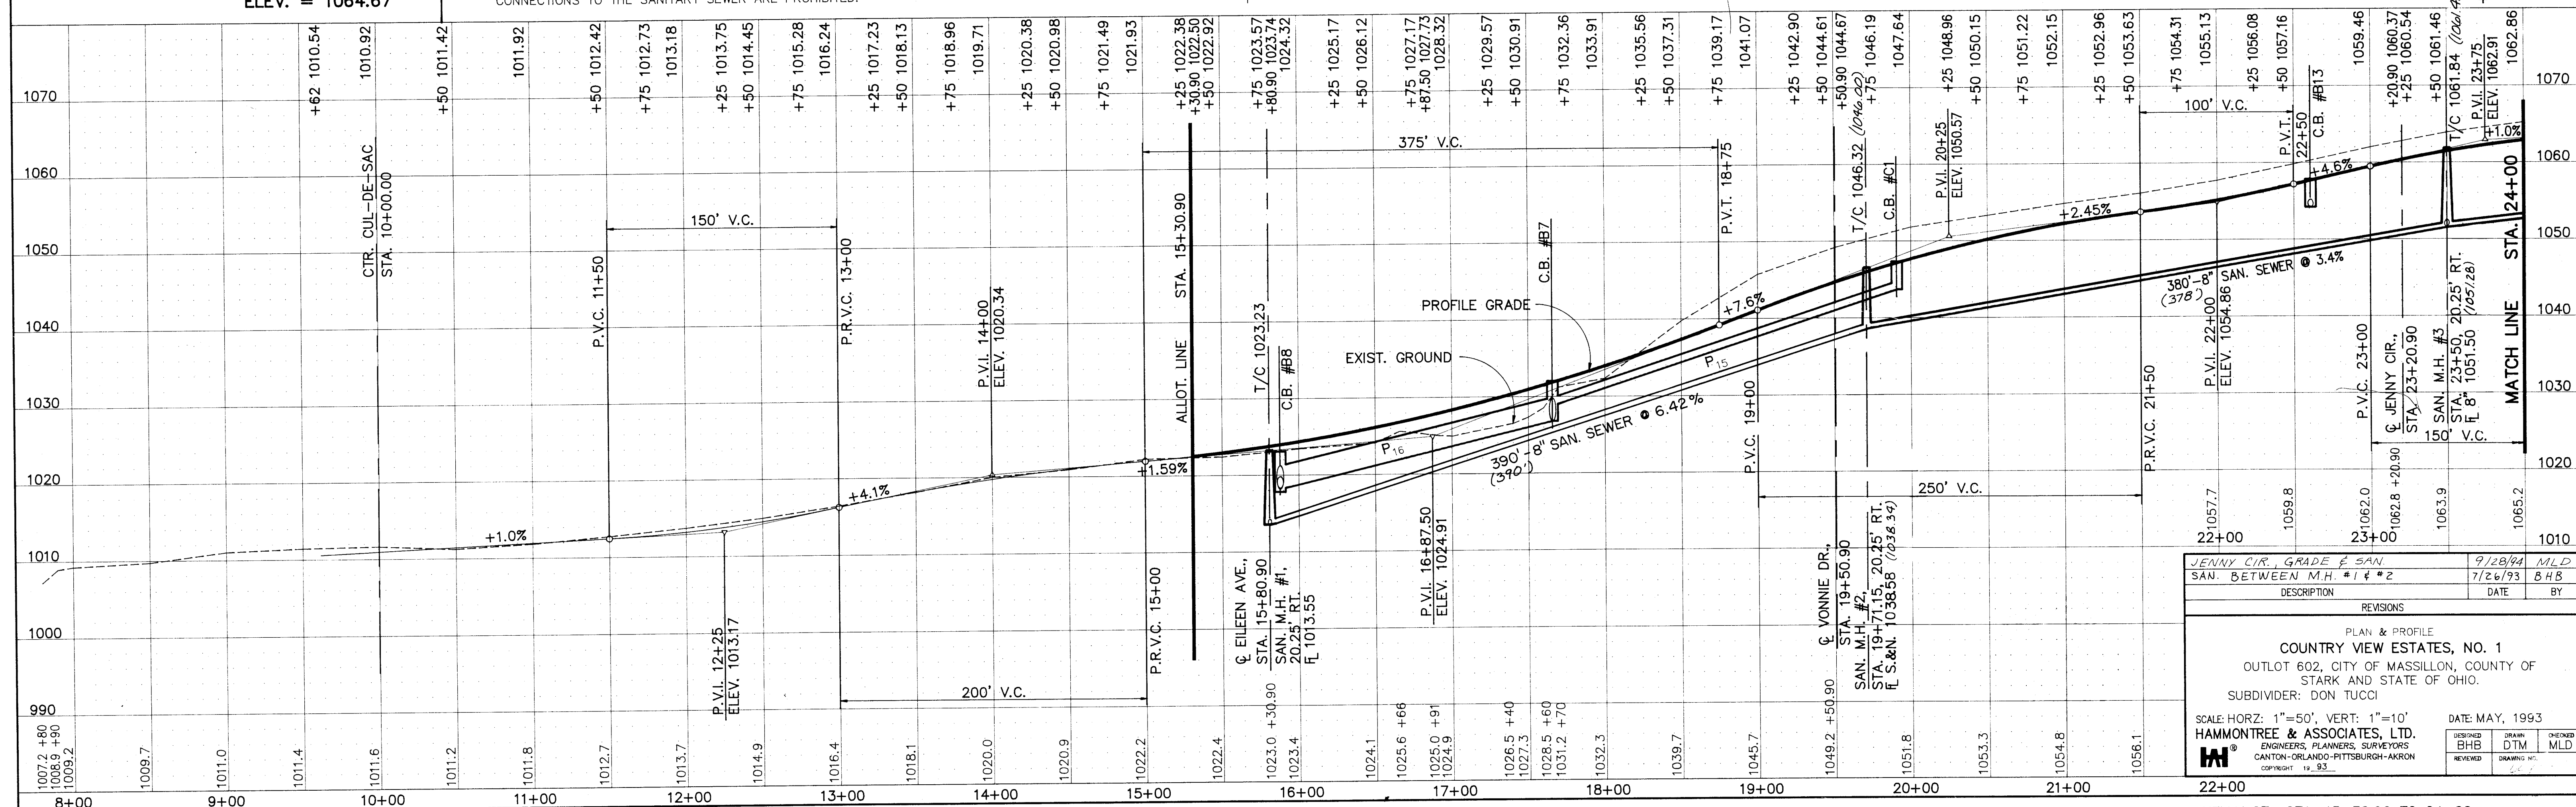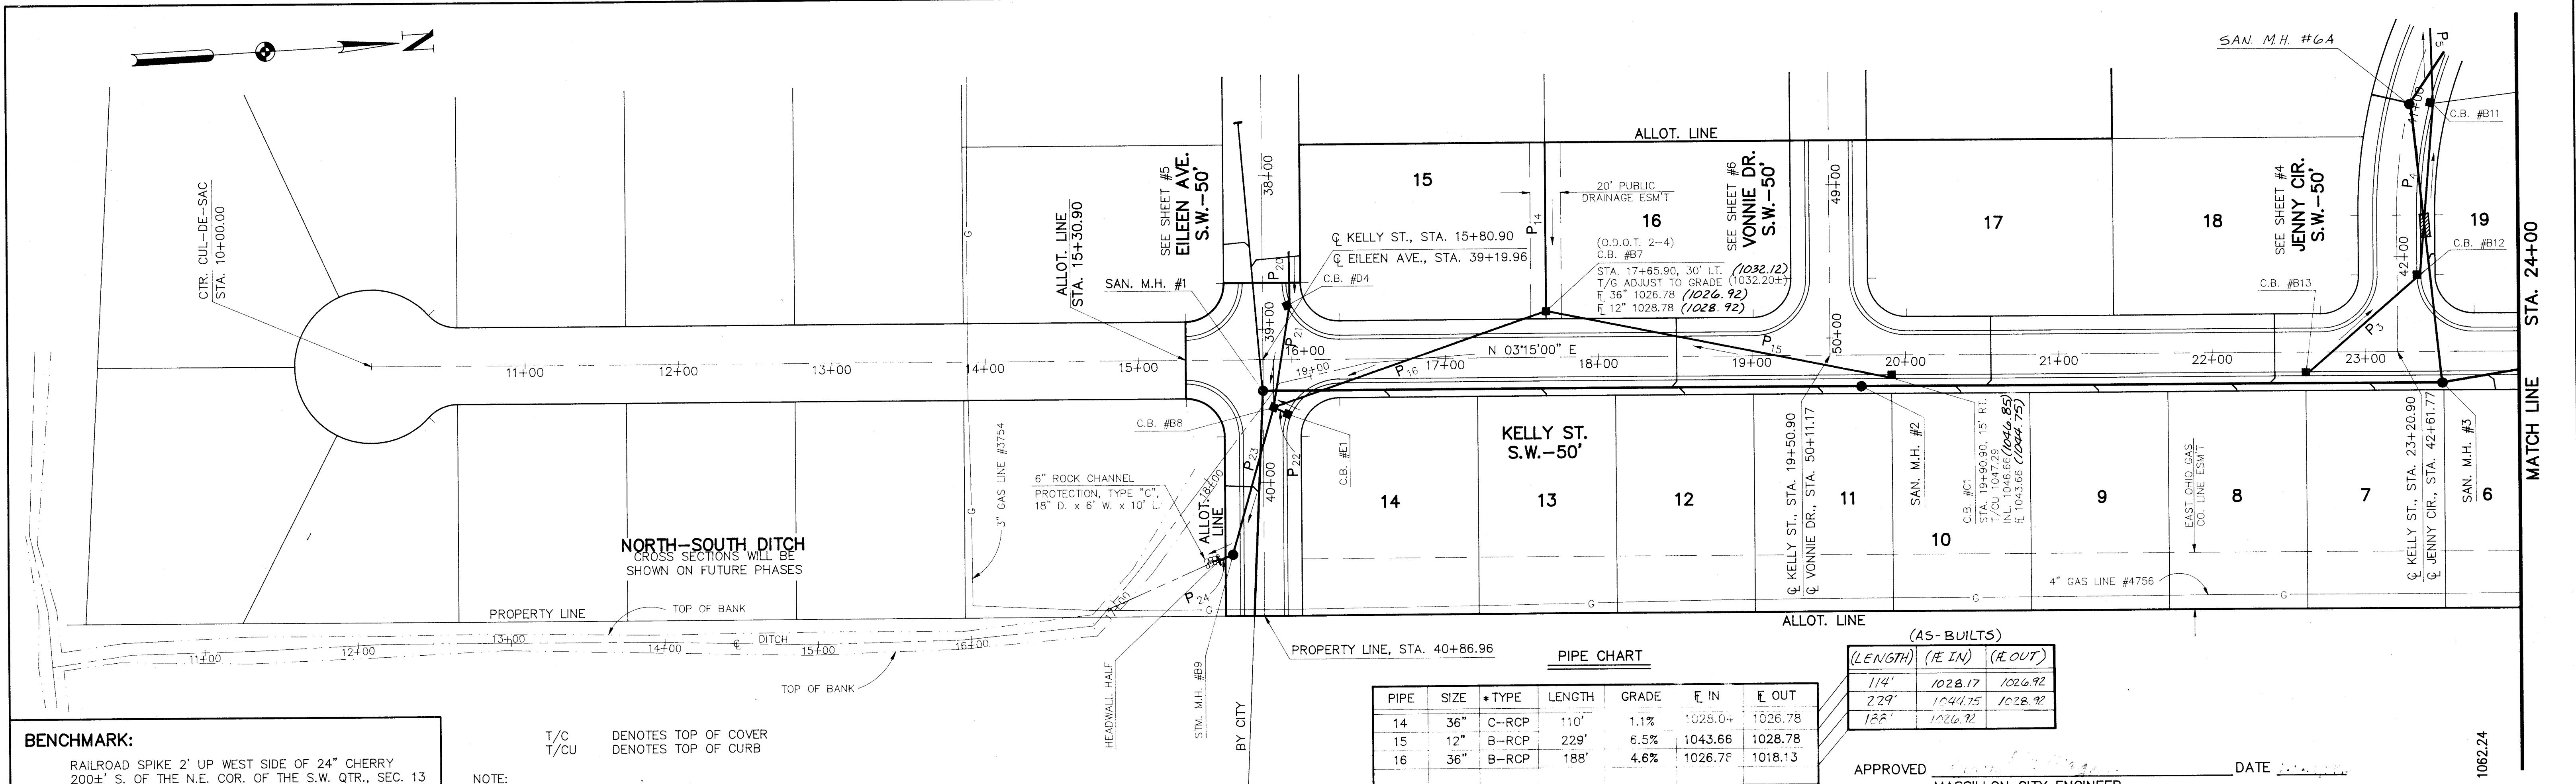

KELLY ST., STA. 15+30.90 TO 24+00
NORTH-SOUTH DITCH, STA. 10+00 TO 18+75
SHEET 3 OF 13

SD527 Acc No 3369

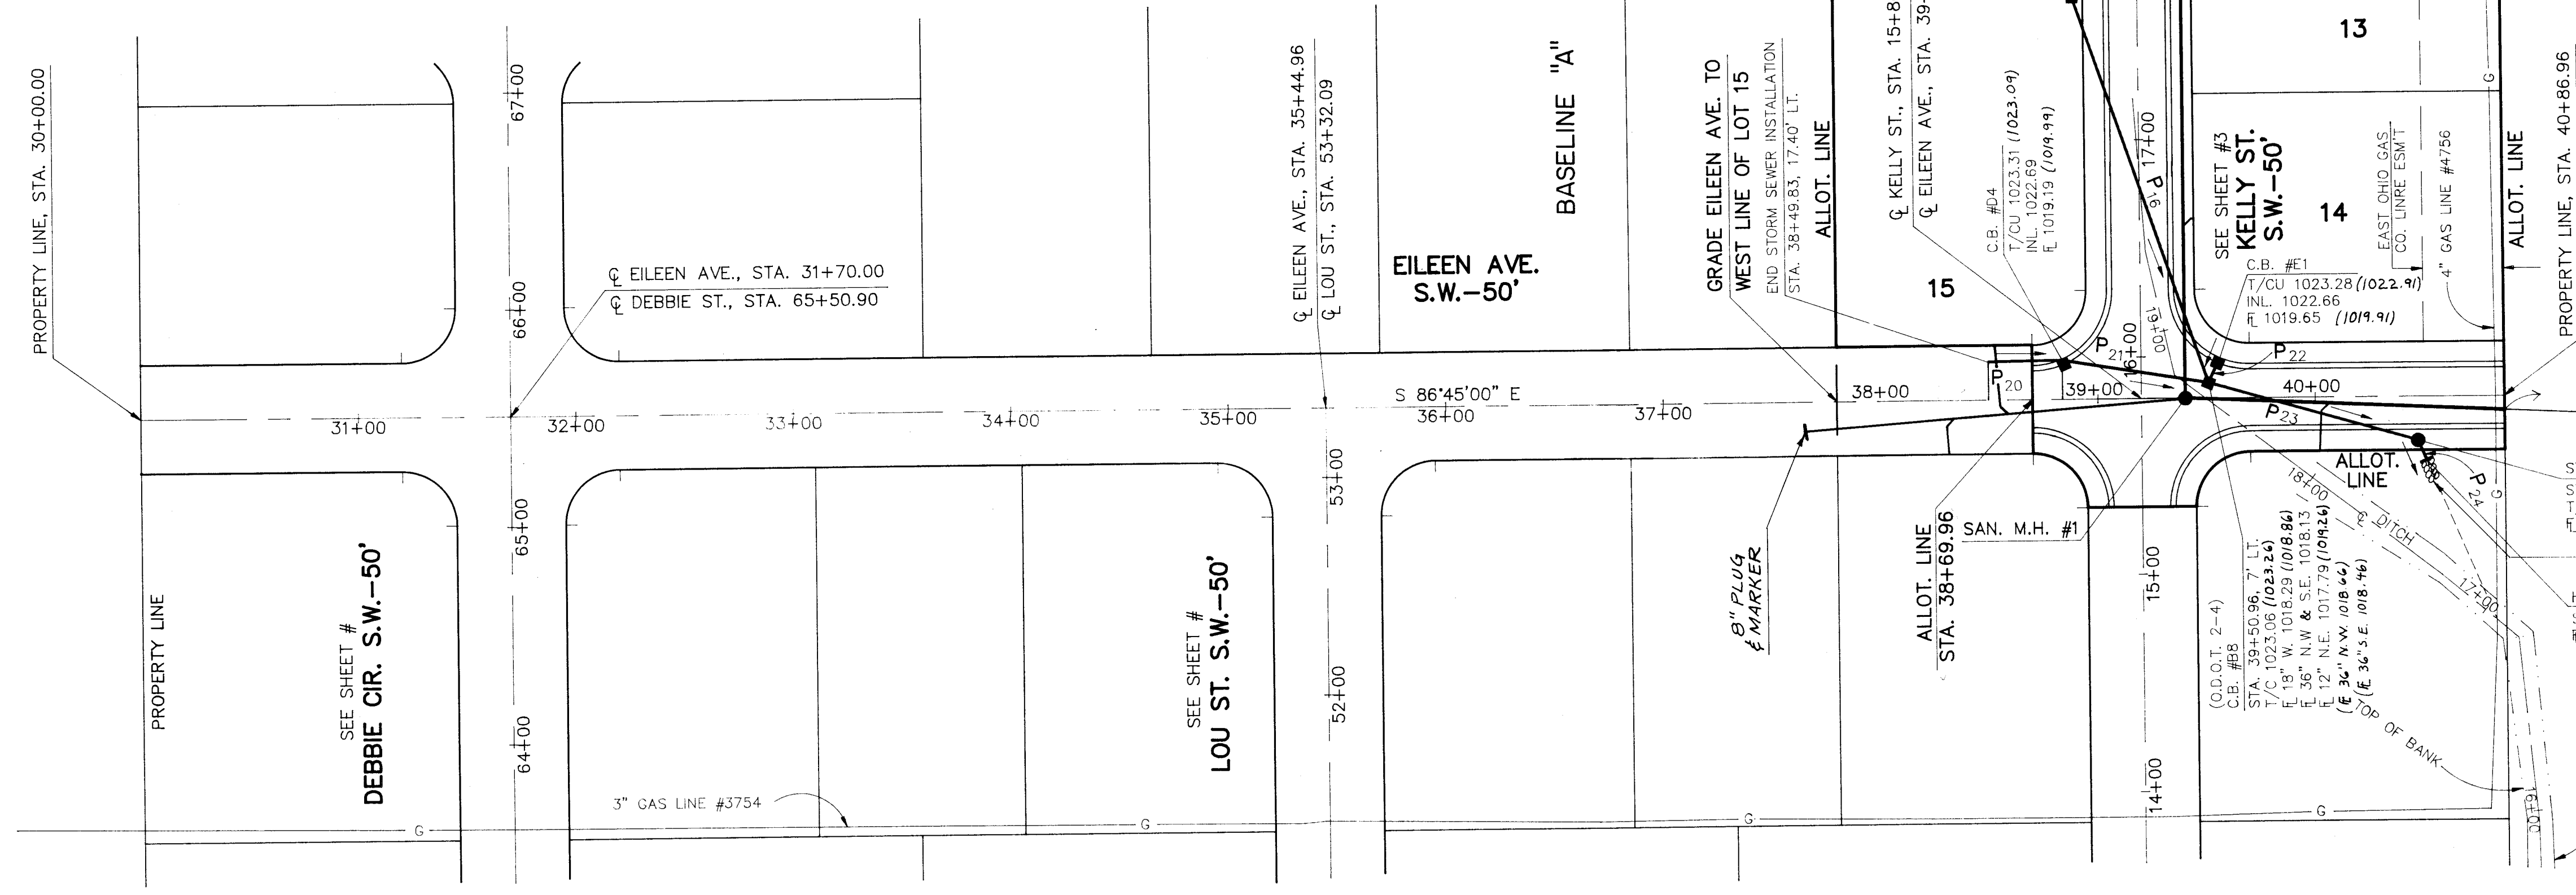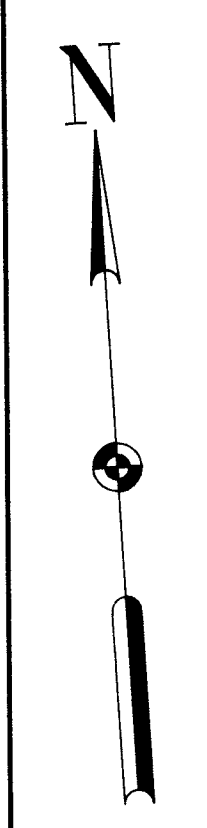


PIPE CHART						
PIPE	SIZE	*TYPE	LENGTH	GRADE	IN	OUT
20	18"	B-RCP	34'	1.1%	1019.56	1019.19
21	18"	B-RCP	69'	1.3%	1019.19	1018.29
22	12"	B-RCP	12'	15.5%	1019.65	1017.79
23	36"	B-RCP	100'	0.65%	1018.13	1017.48
24	36"	C-RCP	10'	0.70%	1017.48	1017.41

(AS-BUILTS)				
20				
21	(66')	1.71%	(1019.99)	(1018.86)
22	(13')	5%	(1019.91)	(1019.26)
23	(99')	0.53%	(1018.46)	(1017.94)
24	(18')	3.0%	(1017.94)	(1017.40)

CITY TO EXTEND SAN. SEWER TO ALLOT. LINE FROM EXIST. M.H.

EXIST. SAN. M.H. STA. 42+43.23, 13.41' RT. T/C 1020.50 (1020.48) E 1010.41 (1010.72)

STM. M.H. #89 STA. 40+47, 20.25' RT. T/C 1023.68 E 1017.48 (1017.94)
6" ROCK CHANNEL PROTECTION, TYPE "C", 18" D. x 6" W. x 10' L.
HEADWALL HALF STA. 40+50.94, 29.44' RT. E 1017.41 (1017.90)

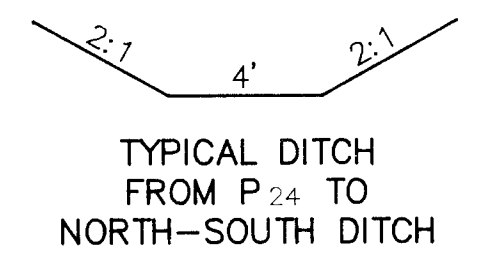


NORTH-SOUTH DITCH
CROSS SECTIONS WILL BE SHOWN ON FUTURE PHASES

BENCHMARK:
RAILROAD SPIKE 1' UP N. SIDE OF 12" ASH
AT STA. 41+00, 100±' RT. OF EILEEN AVE.
ELEV. = 1020.27


NOTE:
T/C DENOTES TOP OF COVER
T/CU DENOTES TOP OF CURB
() DENOTES AS-BUILT MEASUREMENTS
ROOF DRAINS, FOUNDATION DRAINS & OTHER CLEAN WATER CONNECTIONS TO THE SANITARY SEWER ARE PROHIBITED.

APPROVED _____ DATE 5-1-93
MASSILLON CITY ENGINEER

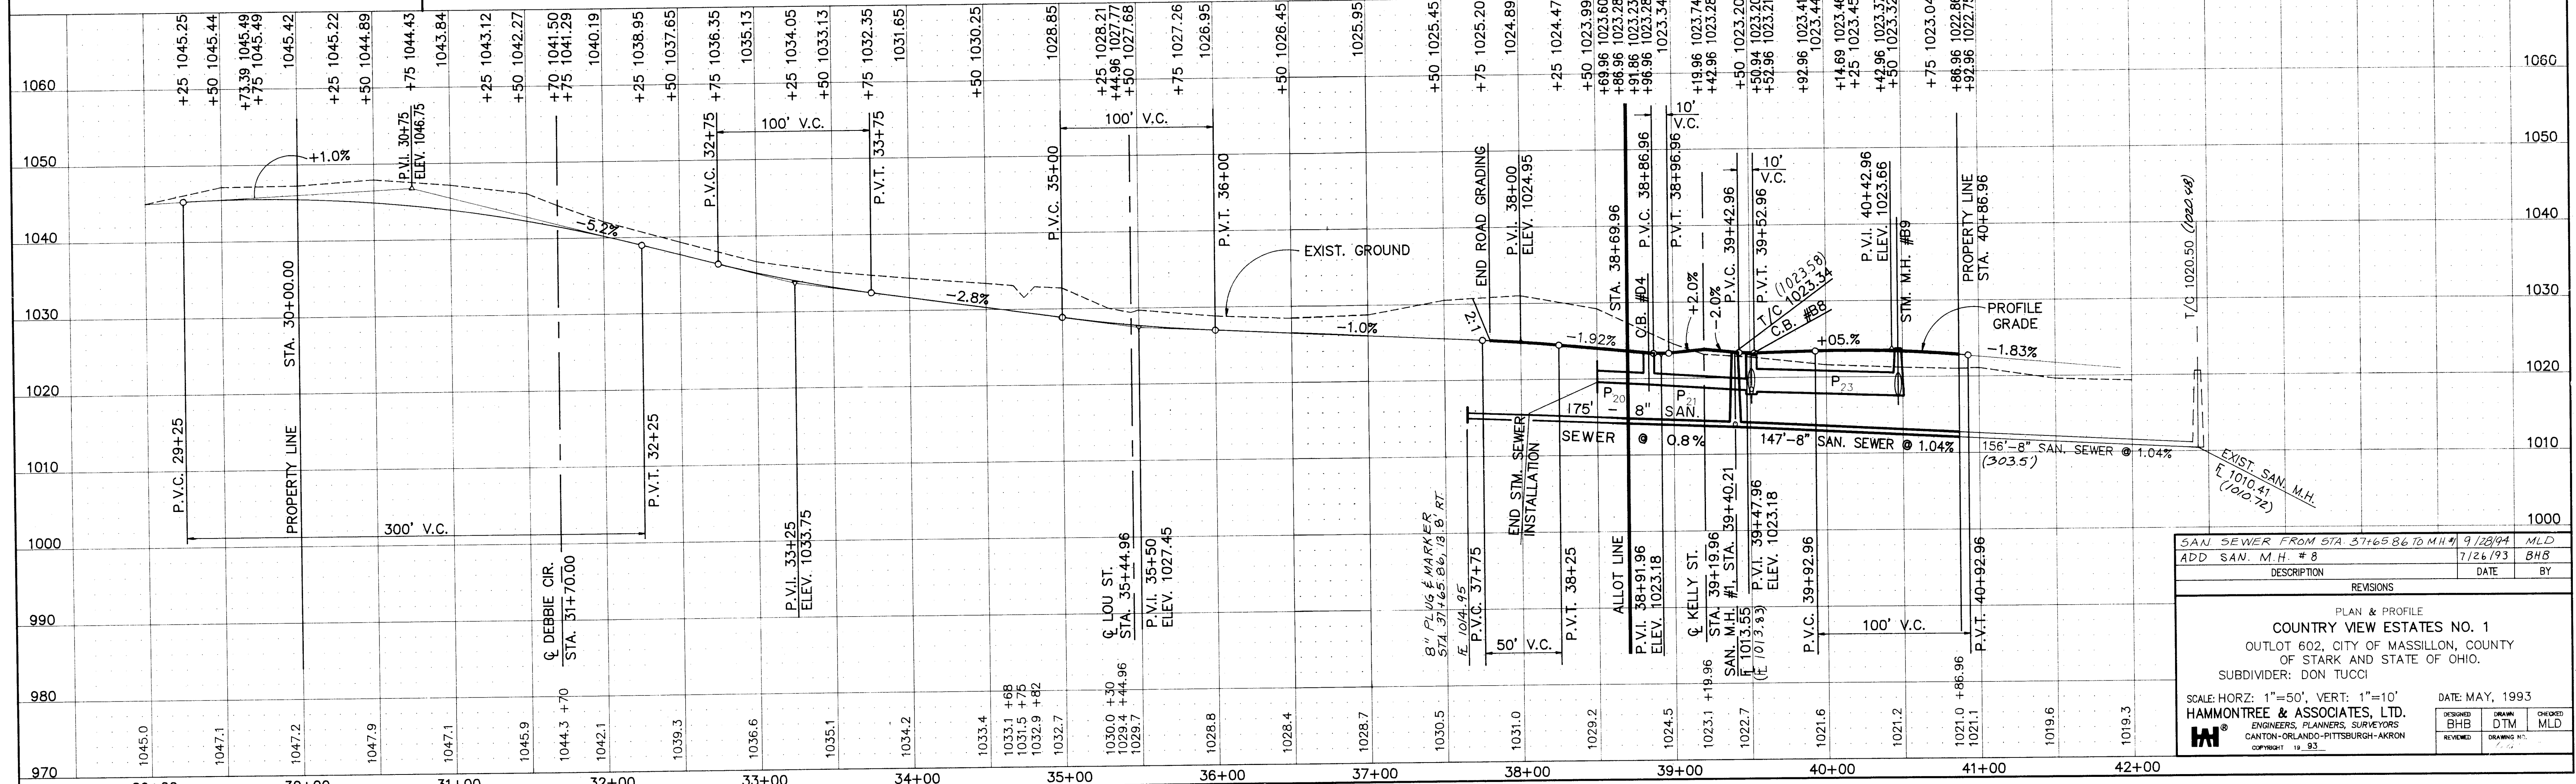

SAN. SEWER FROM STA. 37+65.86 TO M.H. #8			9/28/94	MLD		
ADD SAN. M.H. #8			7/26/93	BHB		
DESCRIPTION		DATE	BY			
REVISIONS						
PLAN & PROFILE						
COUNTRY VIEW ESTATES NO. 1						
OUTLOT 602, CITY OF MASSILLON, COUNTY OF STARK AND STATE OF OHIO.						
SUBDIVIDER: DON TUCCI						
SCALE: HORIZ: 1"=50', VERT: 1"=10'			DATE: MAY, 1993			
HAMMONTREE & ASSOCIATES, LTD.			DESIGNED: BHB	CHECKED: MLD		
ENGINEERS, PLANNERS, SURVEYORS			DRAWN: BHB	MLD		
CANTON-ORLANDO-PITTSBURGH-AKRON			REVIEWED: BHB	MLD		
COPYRIGHT 1993			DRAWING NO.			

REV. 8/8/97 AS-BUILTS
REV. 10/13/97 AS-BUILTS

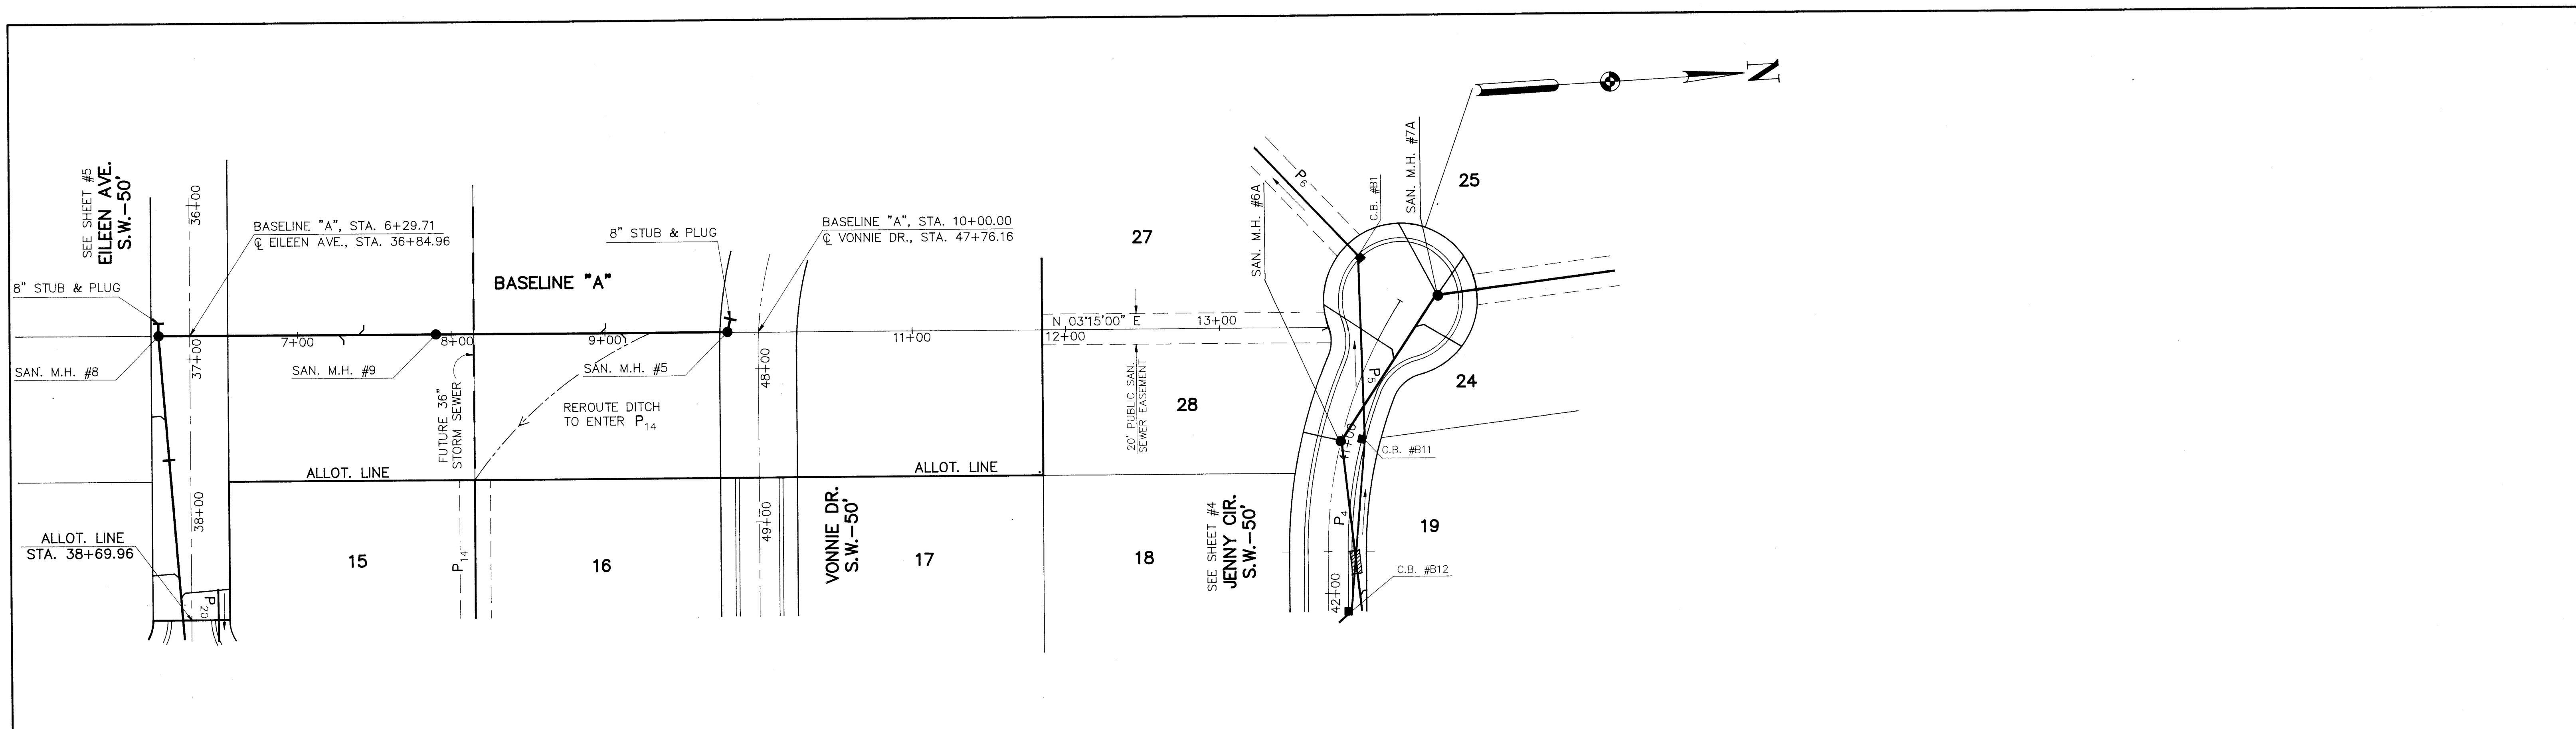


BENCHMARK:
RAILROAD SPIKE 2' UP WEST SIDE OF TRIPLE 15"
CHERRY AT STA. 19+90, 160± RT. OF KELLY ST.
ELEV. = 1051.24

T/C DENOTES TOP OF COVER
T/CU DENOTES TOP OF CURB

NOTE:
ROOF DRAINS, FOUNDATION DRAINS & OTHER CLEAN WATER
CONNECTIONS TO THE SANITARY SEWER ARE PROHIBITED.

APPROVED *[Signature]* DATE *5/6/93*
MASSILLON CITY ENGINEER

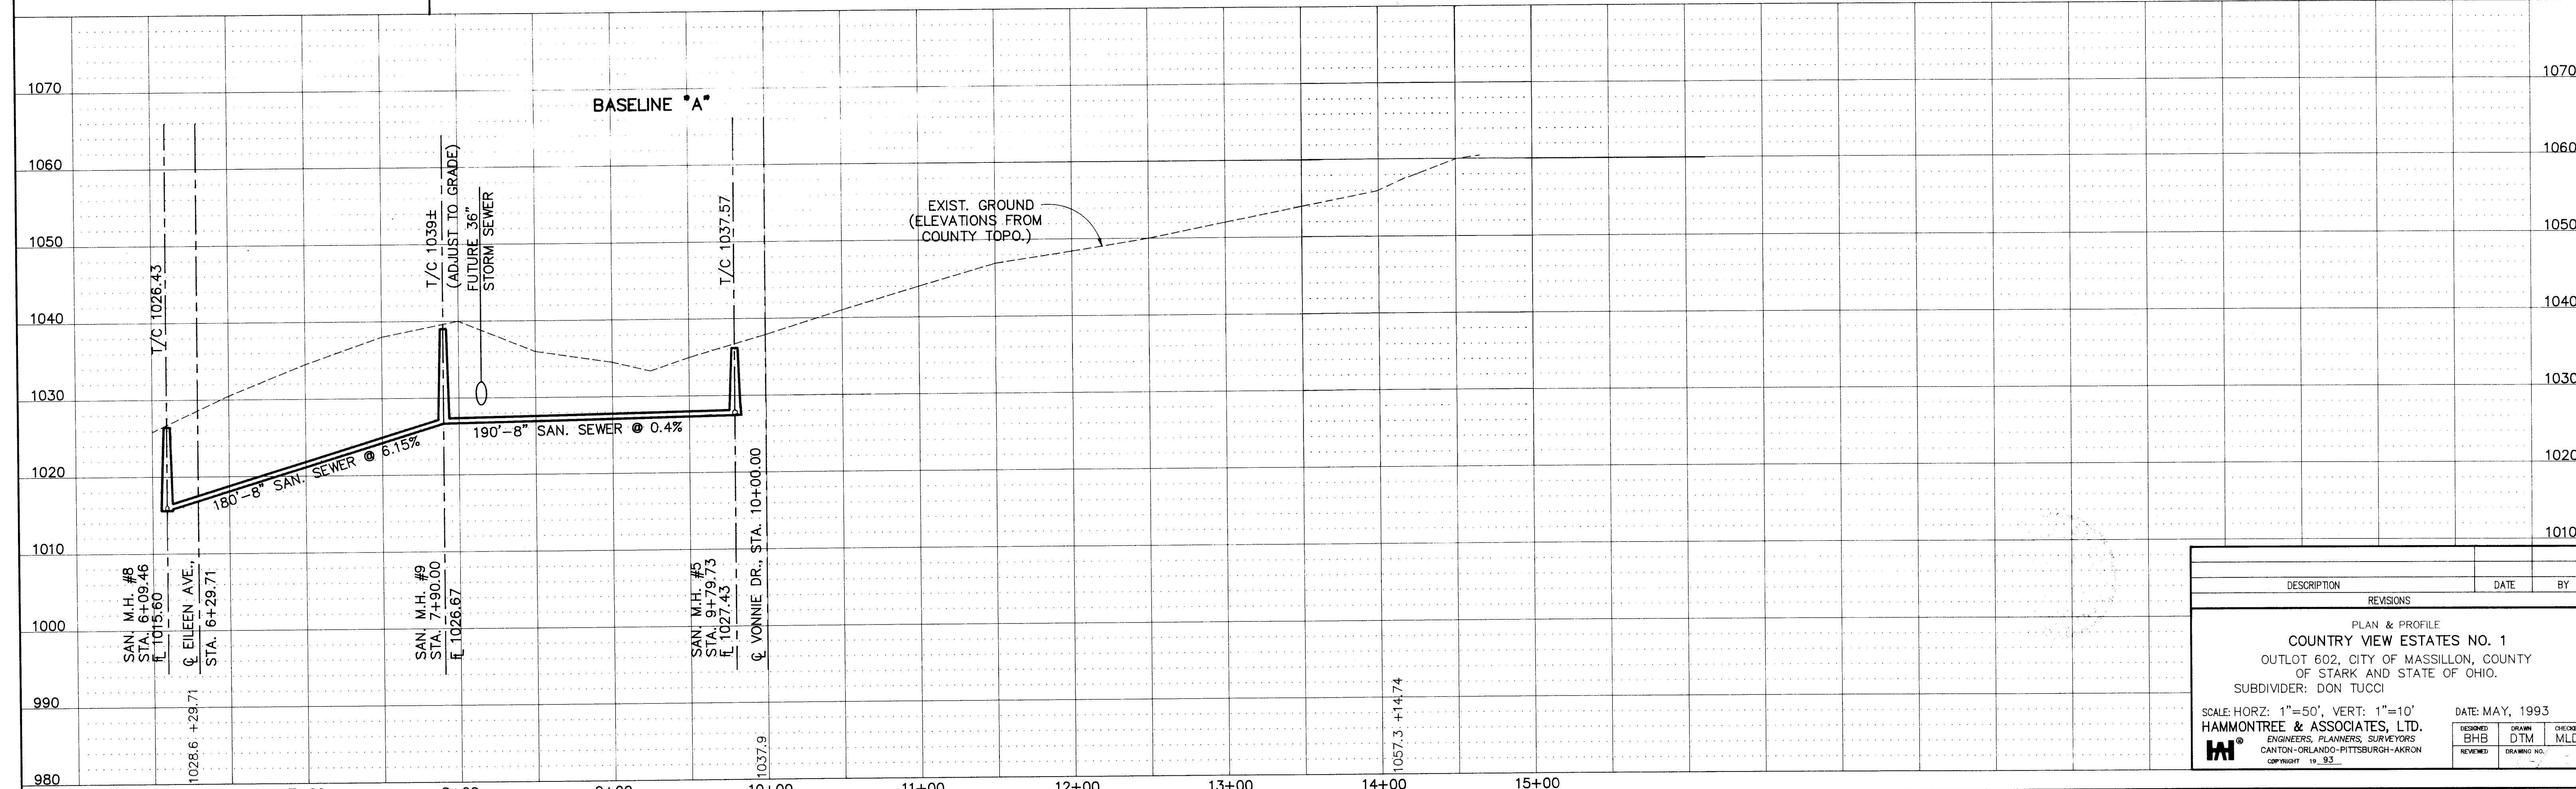

REVISIONS		DATE	BY
PLAN & PROFILE COUNTRY VIEW ESTATES NO. 1 OUTLOT 602, CITY OF MASSILLON, COUNTY OF STARK AND STATE OF OHIO. SUBDIVIDER: DON TUCCI			
SCALE: HORZ: 1"=50', VERT: 1"=10' HAMMONTREE & ASSOCIATES, LTD. ENGINEERS, PLANNERS, SURVEYORS CANTON-ORLANDO-PITTSBURGH-AKRON COPYRIGHT 1993		DATE: MAY, 1993	
DESIGNED BHB	DRAWN DTM	CHECKED MLD	
REVIEWED	DRAWING NO.		