


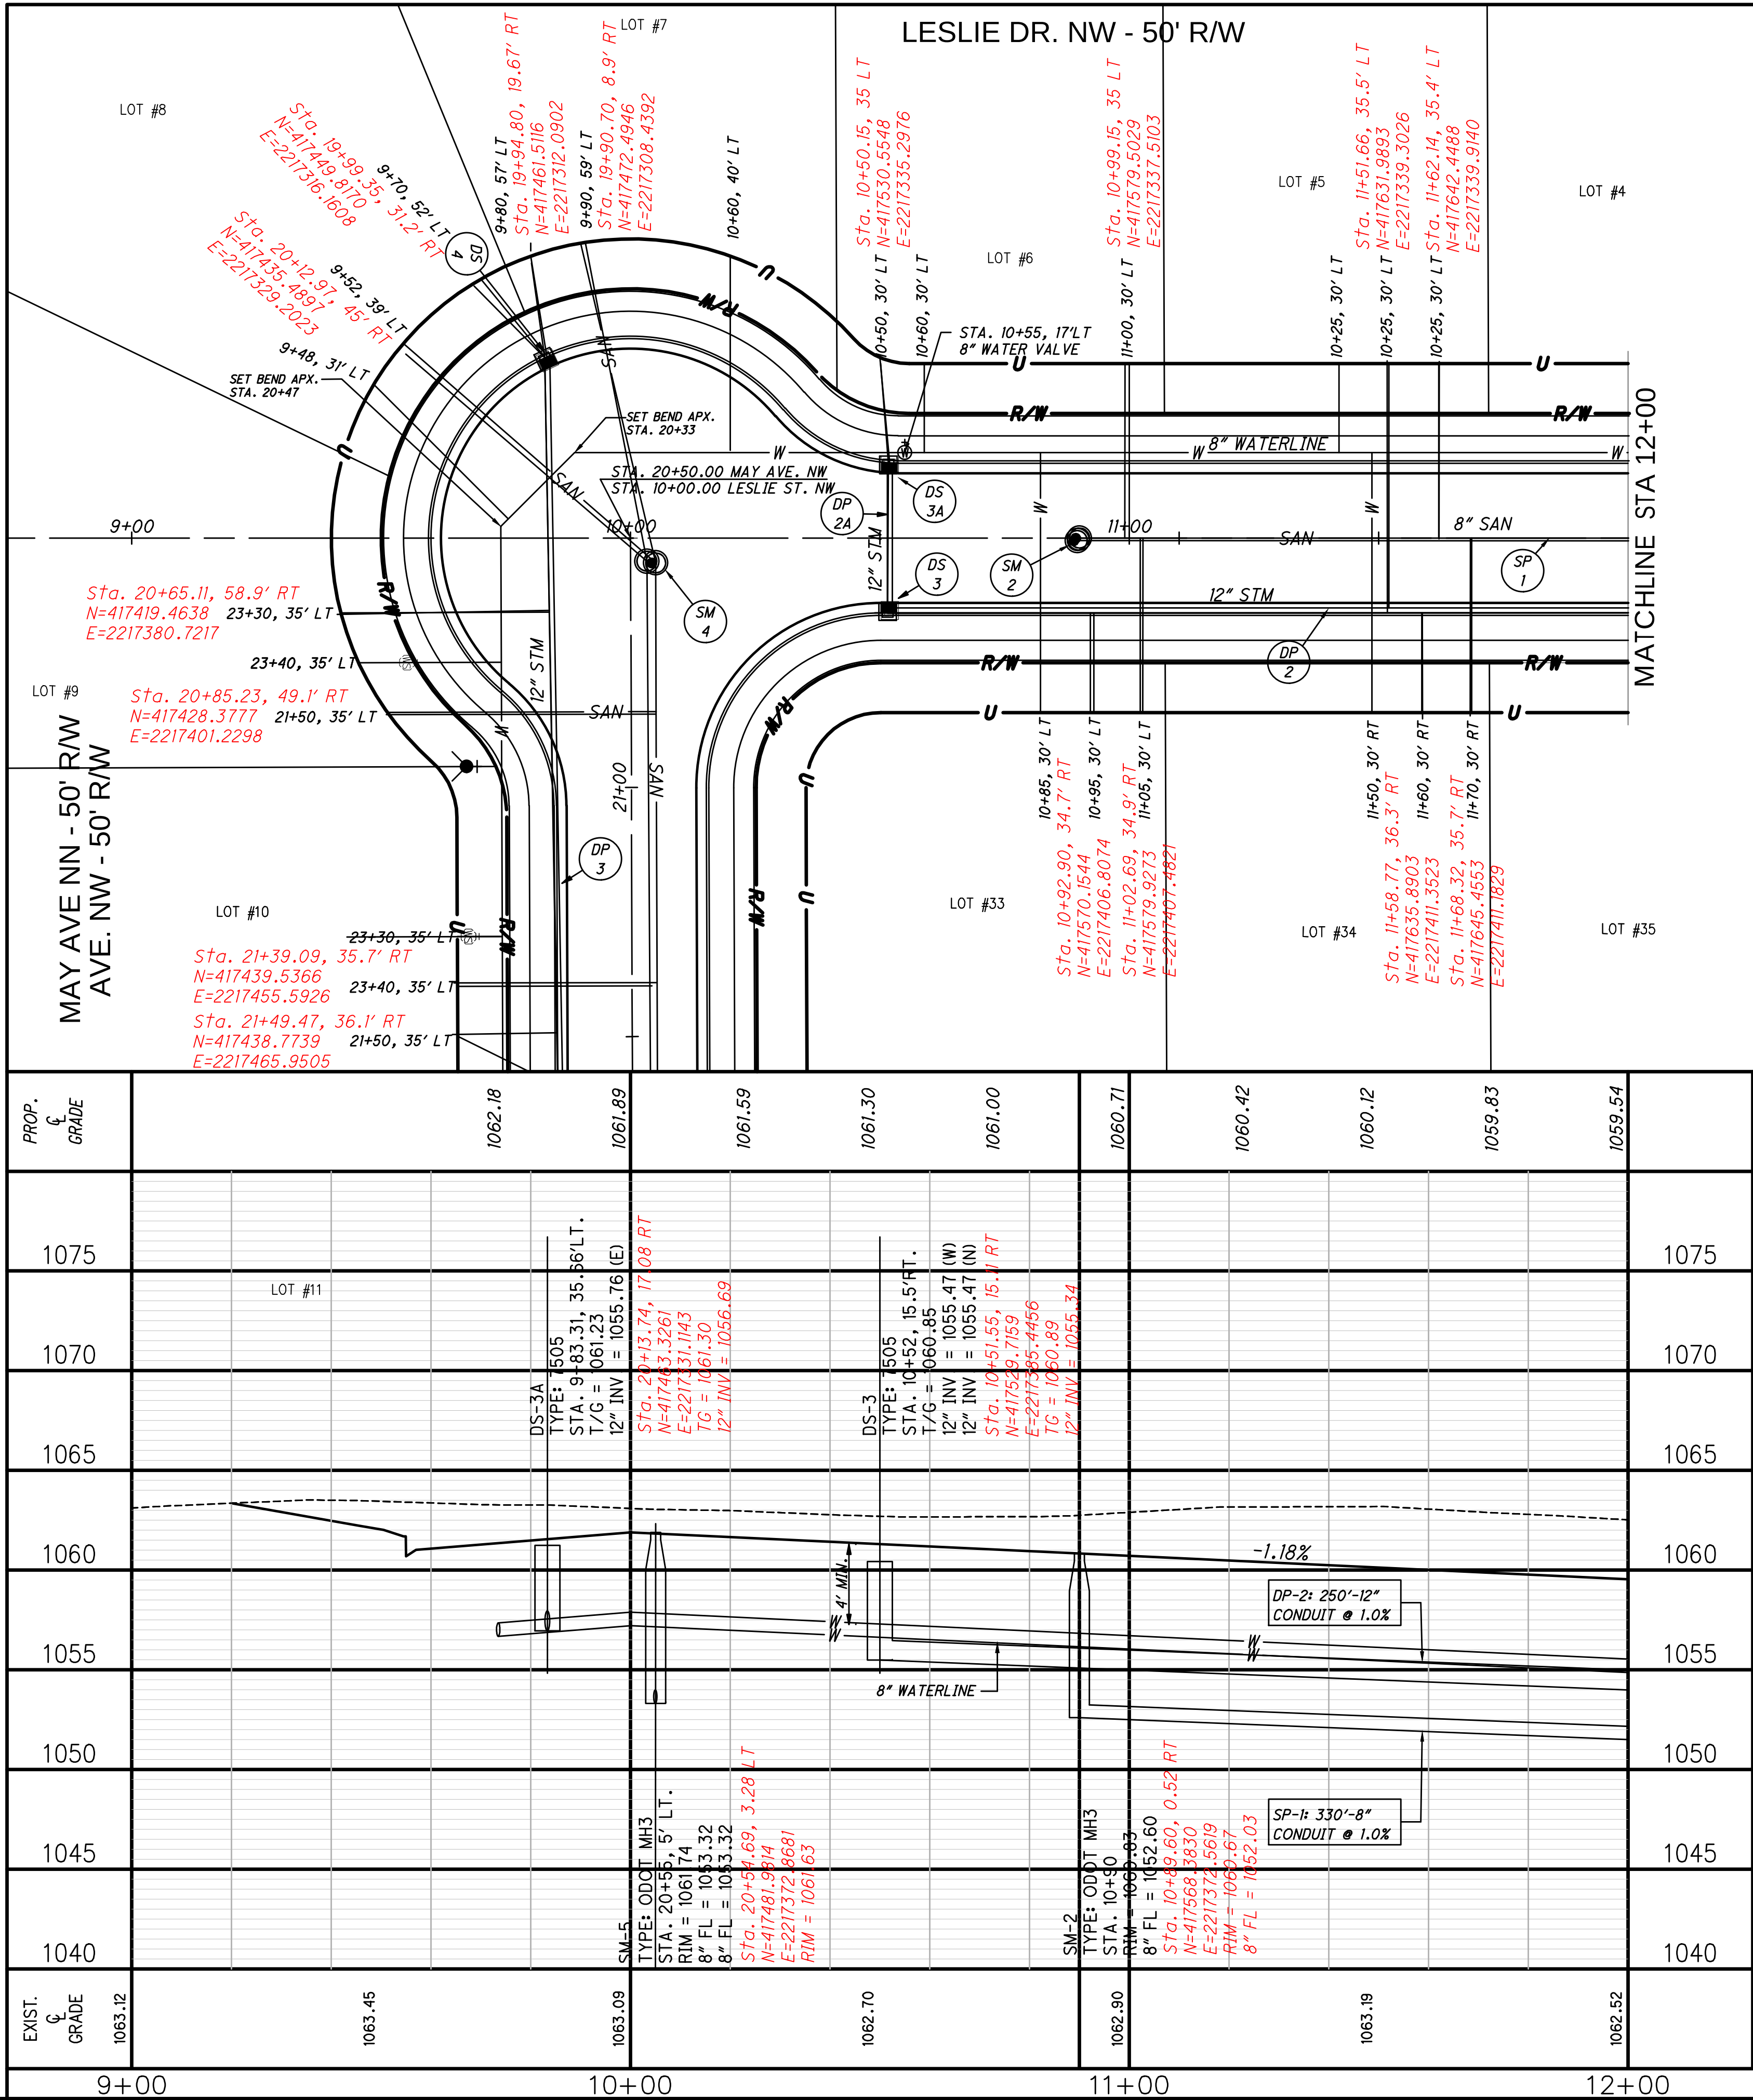

A: SANITARY = DISTANCE FROM DOWNSTREAM MANHOLE
STORM = DISTANCE FROM DOWNSTREAM DRAINAGE STRUCTURE
WATER = STATION LOCATION
B: SANITARY = DISTANCE FROM MAIN
STORM = DISTANCE FROM MAIN
WATER = DISTANCE FROM MAIN

- NOTES
1. WATER MAINS MUST BE INSTALLED A MINIMUM OF 4' UNDERGROUND AND IF NECESSARY, MUST BE DEFLECTED TO PROVIDE AN 18" MINIMUM CLEARANCE FROM ALL STORM AND SANITARY MAINS AT CROSSING POINTS.
 2. WYES SHALL BE INSTALLED FOR ALL SANITARY LATERALS.

WS

NW

SE

NE

A

B

0

5

0

2.5

5

0

10

20

HORIZONTAL
SCALE IN FEET

CHECKED BY:
KAD

DATE:
Mar, 2023

DRAWN BY:
JTD

DATE:
Mar, 2023

REVISIONS:

DATE	DESCRIPTION	COMMENTS
9/12/23		
10/24/23		

ENGINEERING

ENGINEERS-SURVEYORS-CONSTRUCTION MANAGERS

4450 BELDEN AVE. SUITE 100 CANTON, OH 44705


PHONE: (224) 410-3913 EMAIL: KAD@CIVIPROENGINEERING.COM

WWW.CIVIPROENGINEERING.COM

Leslie Ave PP1

REF NUMBER:

9 / 39

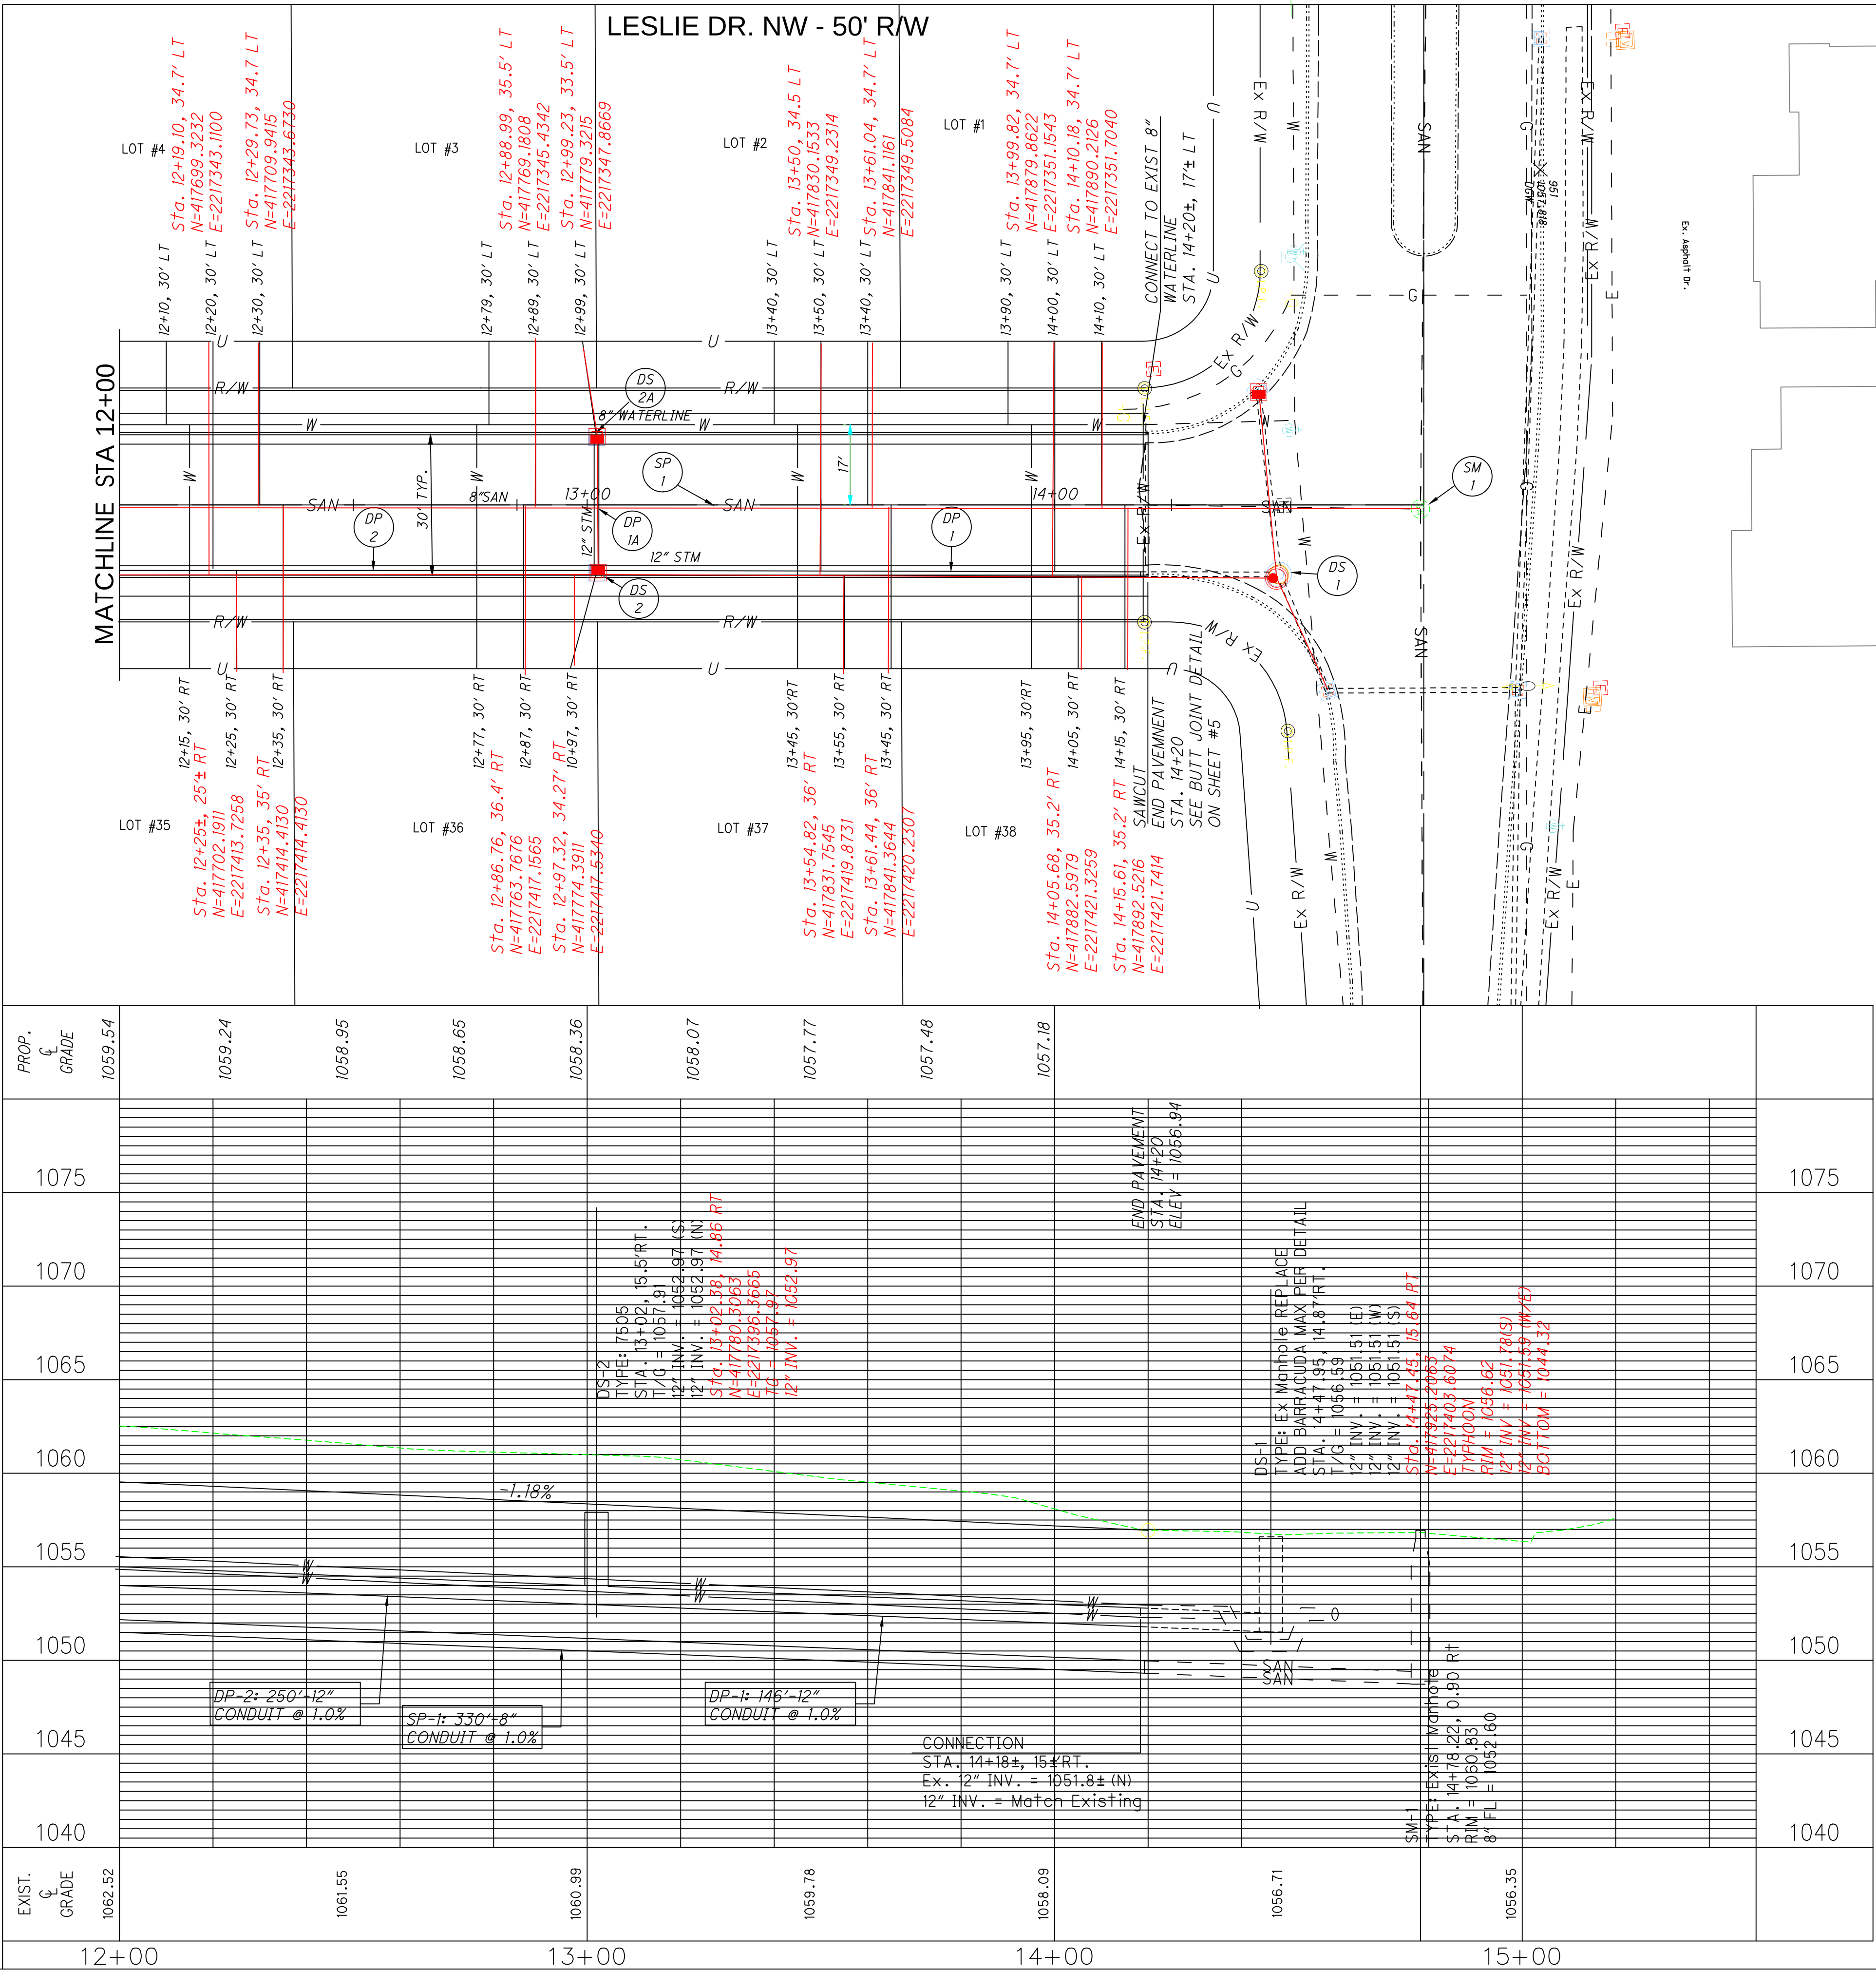

A: SANITARY = DISTANCE FROM DOWNSTREAM MANHOLE
STORM = DISTANCE FROM DOWNSTREAM DRAINAGE STRUCTURE
WATER = STATION LOCATION
B: SANITARY = DISTANCE FROM MAIN
STORM = DISTANCE FROM MAIN
WATER = DISTANCE FROM MAIN

- NOTES
1. WATER MAINS MUST BE INSTALLED A MINIMUM OF 4' UNDERGROUND AND IF NECESSARY, MUST BE DEFLECTED TO PROVIDE AN 18" MINIMUM CLEARANCE FROM ALL STORM AND SANITARY MAINS AT CROSSING POINTS.
 2. WYES SHALL BE INSTALLED FOR ALL SANITARY LATERALS.
 3. CONTRACTOR SHALL REPAIR ALL PAVEMENT DISTURBED AT DS-1 FOR THE INSTALLATION OF THE BARRACUDA MAX.

MS

NE

SE

SW

0

5

10

0

10

20

HORIZONTAL
SCALE IN FEET

CHECKED BY:
KAD

DATE:
Mar, 2023

DRAWN BY:
JTD

DATE:
Mar, 2023

REVISIONS:

DATE	DESCRIPTION	COMMENTS
9/12/23		

10

39

Sippo Reserves Phase 3 & 4

Leslie Ave NW 12+00 to Sta. 15+00 Plan and Profile

City of Massillon
Stark County, Ohio

CIVIPRO

ENGINEERING

ENGINEERS-SURVEYORS-CONSTRUCTION MANAGERS


4450 BELDEN VILLAGE STREET, NW, SUITE 800 CANTON, OH 44718

PHONE: (234) 410-3913 EMAIL: KAD@CIVIPROENGINEERING.COM

WWW.CIVIPROENGINEERING.COM

DRAWING NAME:
Leslie Dr. PP2

REF NUMBER:

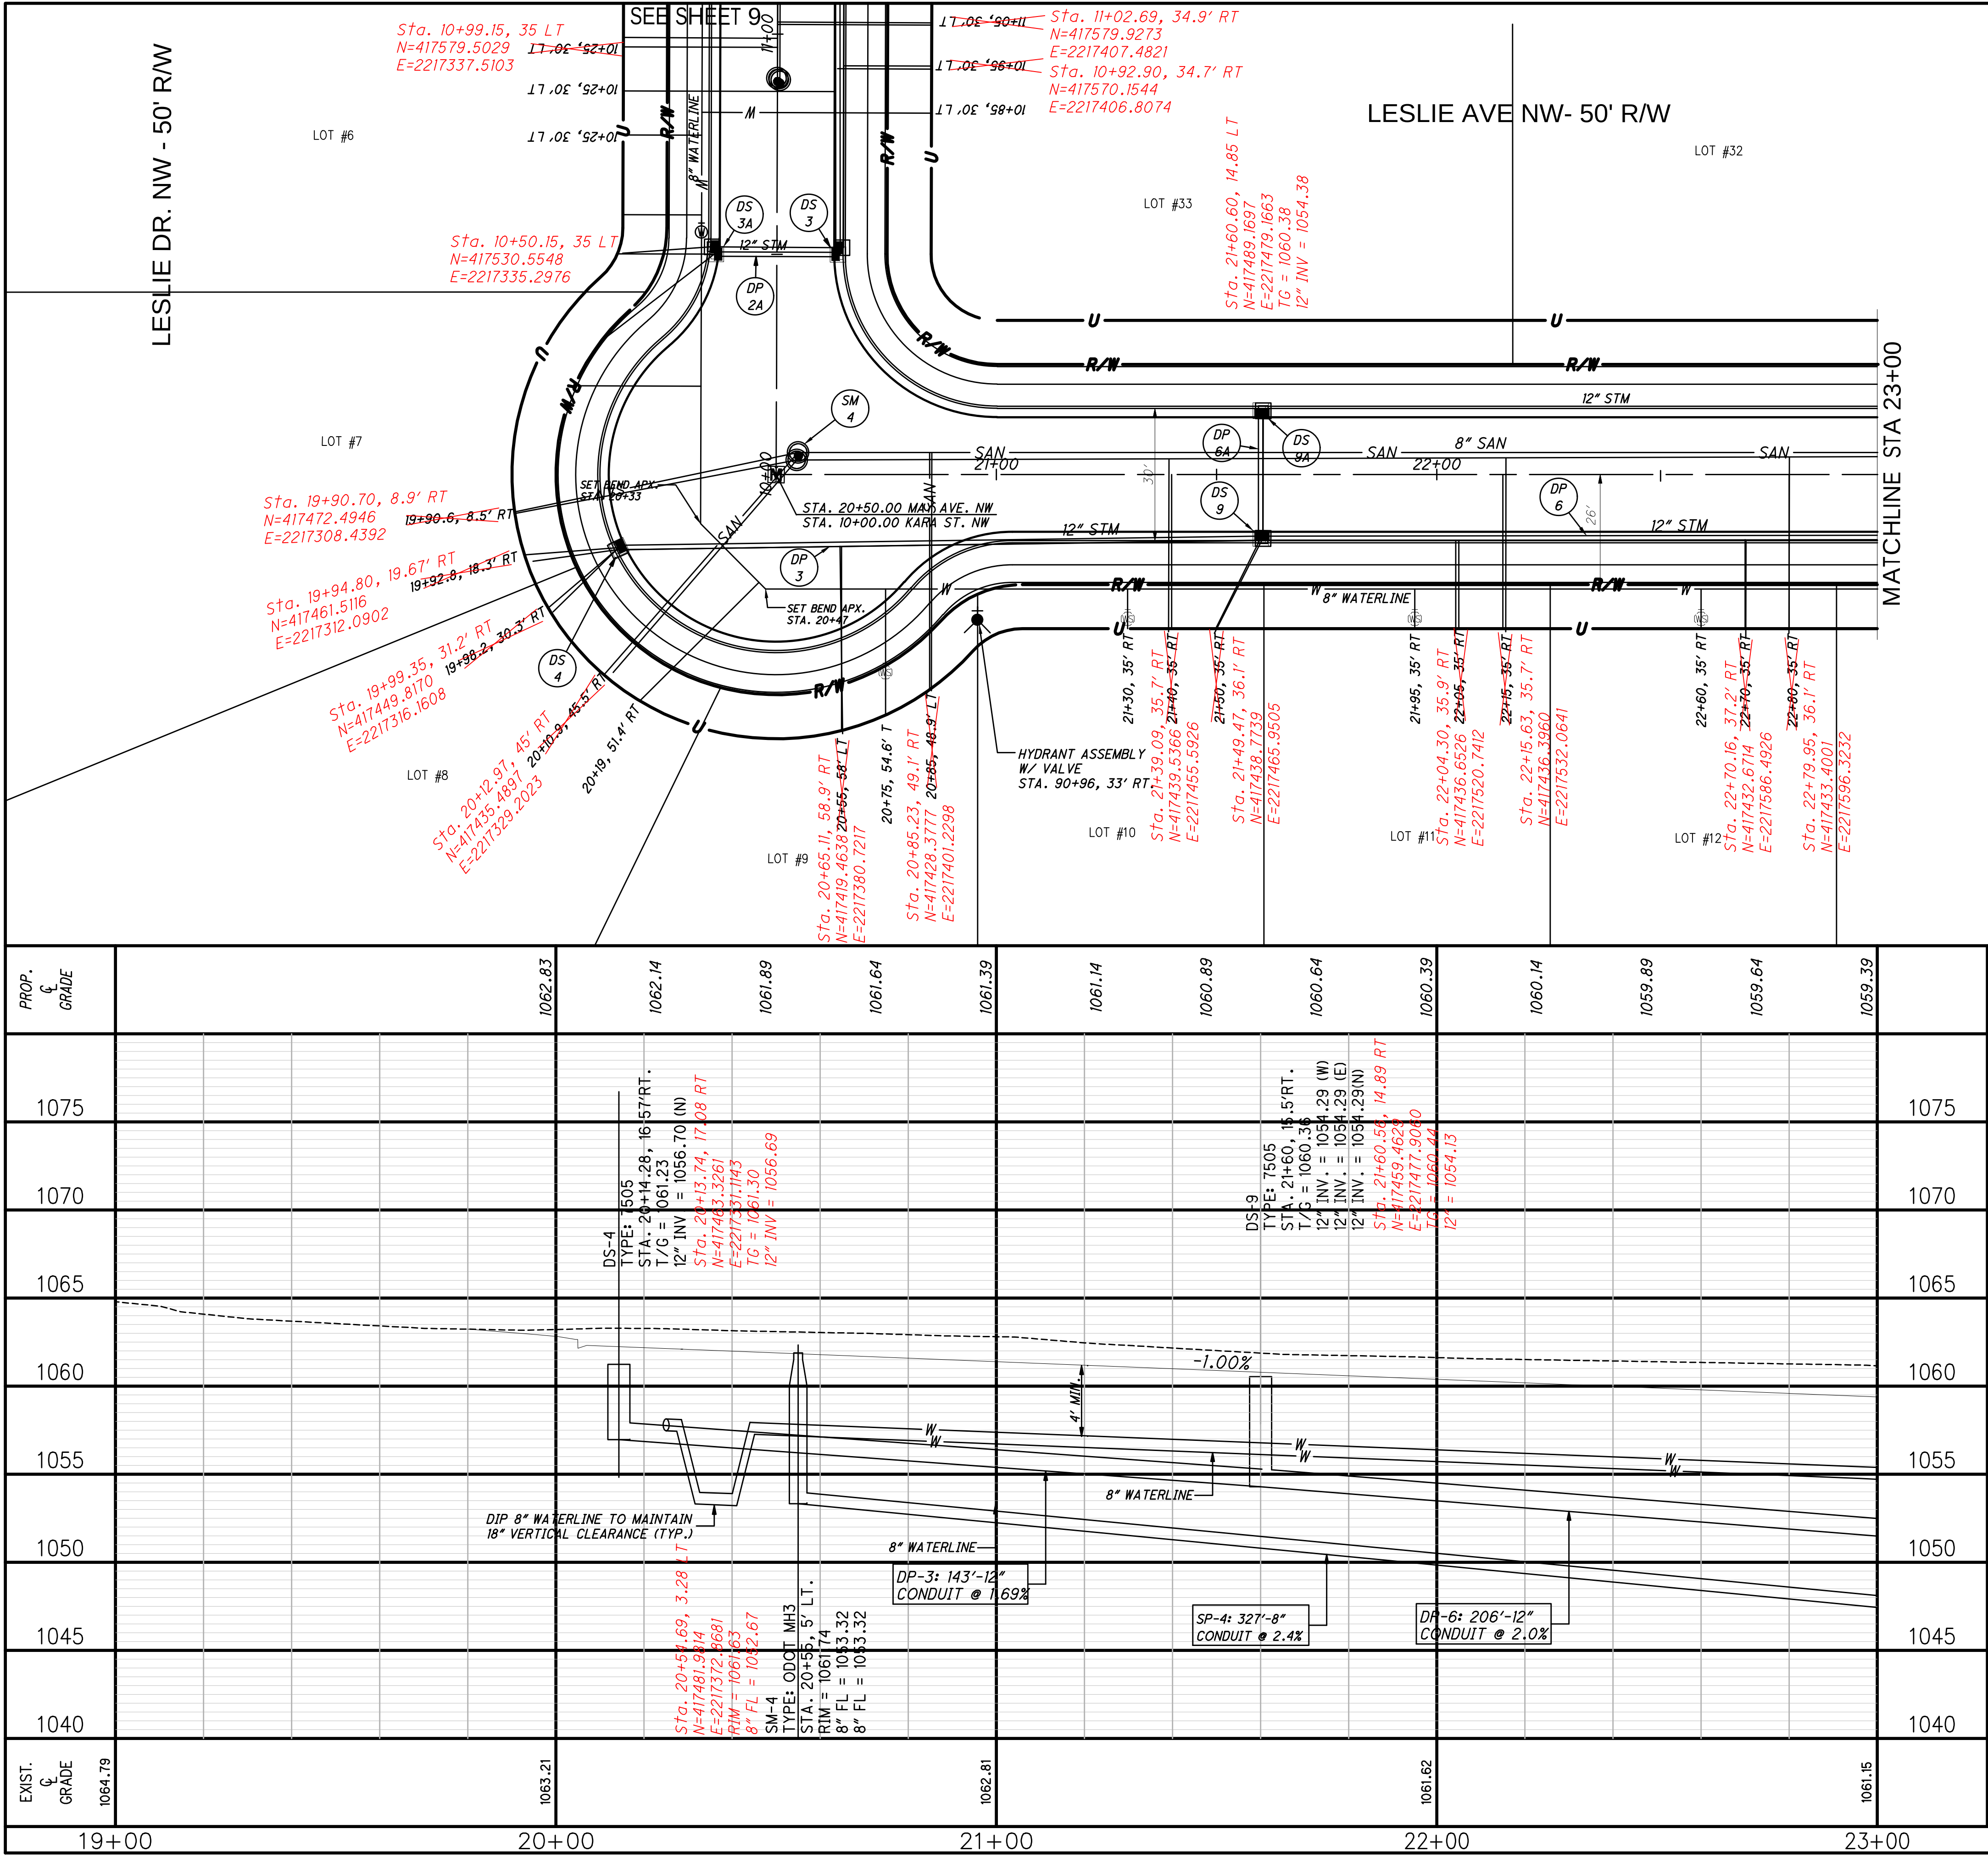

- A: SANITARY = DISTANCE FROM DOWNSTREAM MANHOLE
STORM = DISTANCE FROM DOWNSTREAM DRAINAGE STRUCTURE
WATER = STATION LOCATION
B: SANITARY = DISTANCE FROM MAIN
STORM = DISTANCE FROM MAIN
WATER = DISTANCE FROM MAIN

NOTES

1. WATER MAINS MUST BE INSTALLED A MINIMUM OF 4' UNDERGROUND AND IF NECESSARY, MUST BE DEFLECTED TO PROVIDE AN 18" MINIMUM CLEARANCE FROM ALL STORM AND SANITARY MAINS AT CROSSING POINTS.

2. WYES SHALL BE INSTALLED FOR ALL SANITARY LATERALS.

NW

NE

SW

SE

N

VERTICAL SCALE

0 10 20

HORIZONTAL SCALE IN FEET

0 10 20

CHECKED BY:

KAD

DATE:

Mar, 2023

DRAWN BY:

JTD

DATE:

Mar, 2023

REVISIONS:

DATE	DESCRIPTION

Sippo Reserves Phase 3 & 4

Leslie Ave NW 19+00 to Sta. 23+00 Plan and Profile

City of Massillon

Stark County, Ohio

CIVIPRO

ENGINEERING

DESIGNERS-SUPPLIERS-CONSTRUCTION MANAGERS

4469 E. LAMAR AVE. SUITE 100

MASSILLON, OHIO 44862

PHONE (224) 410-3913 FAX (224) 410-3914



WWW.CIVIPROENGINEERING.COM

DRAWING NAME:

May Ave West PP1

REF NUMBER:

13 / 39

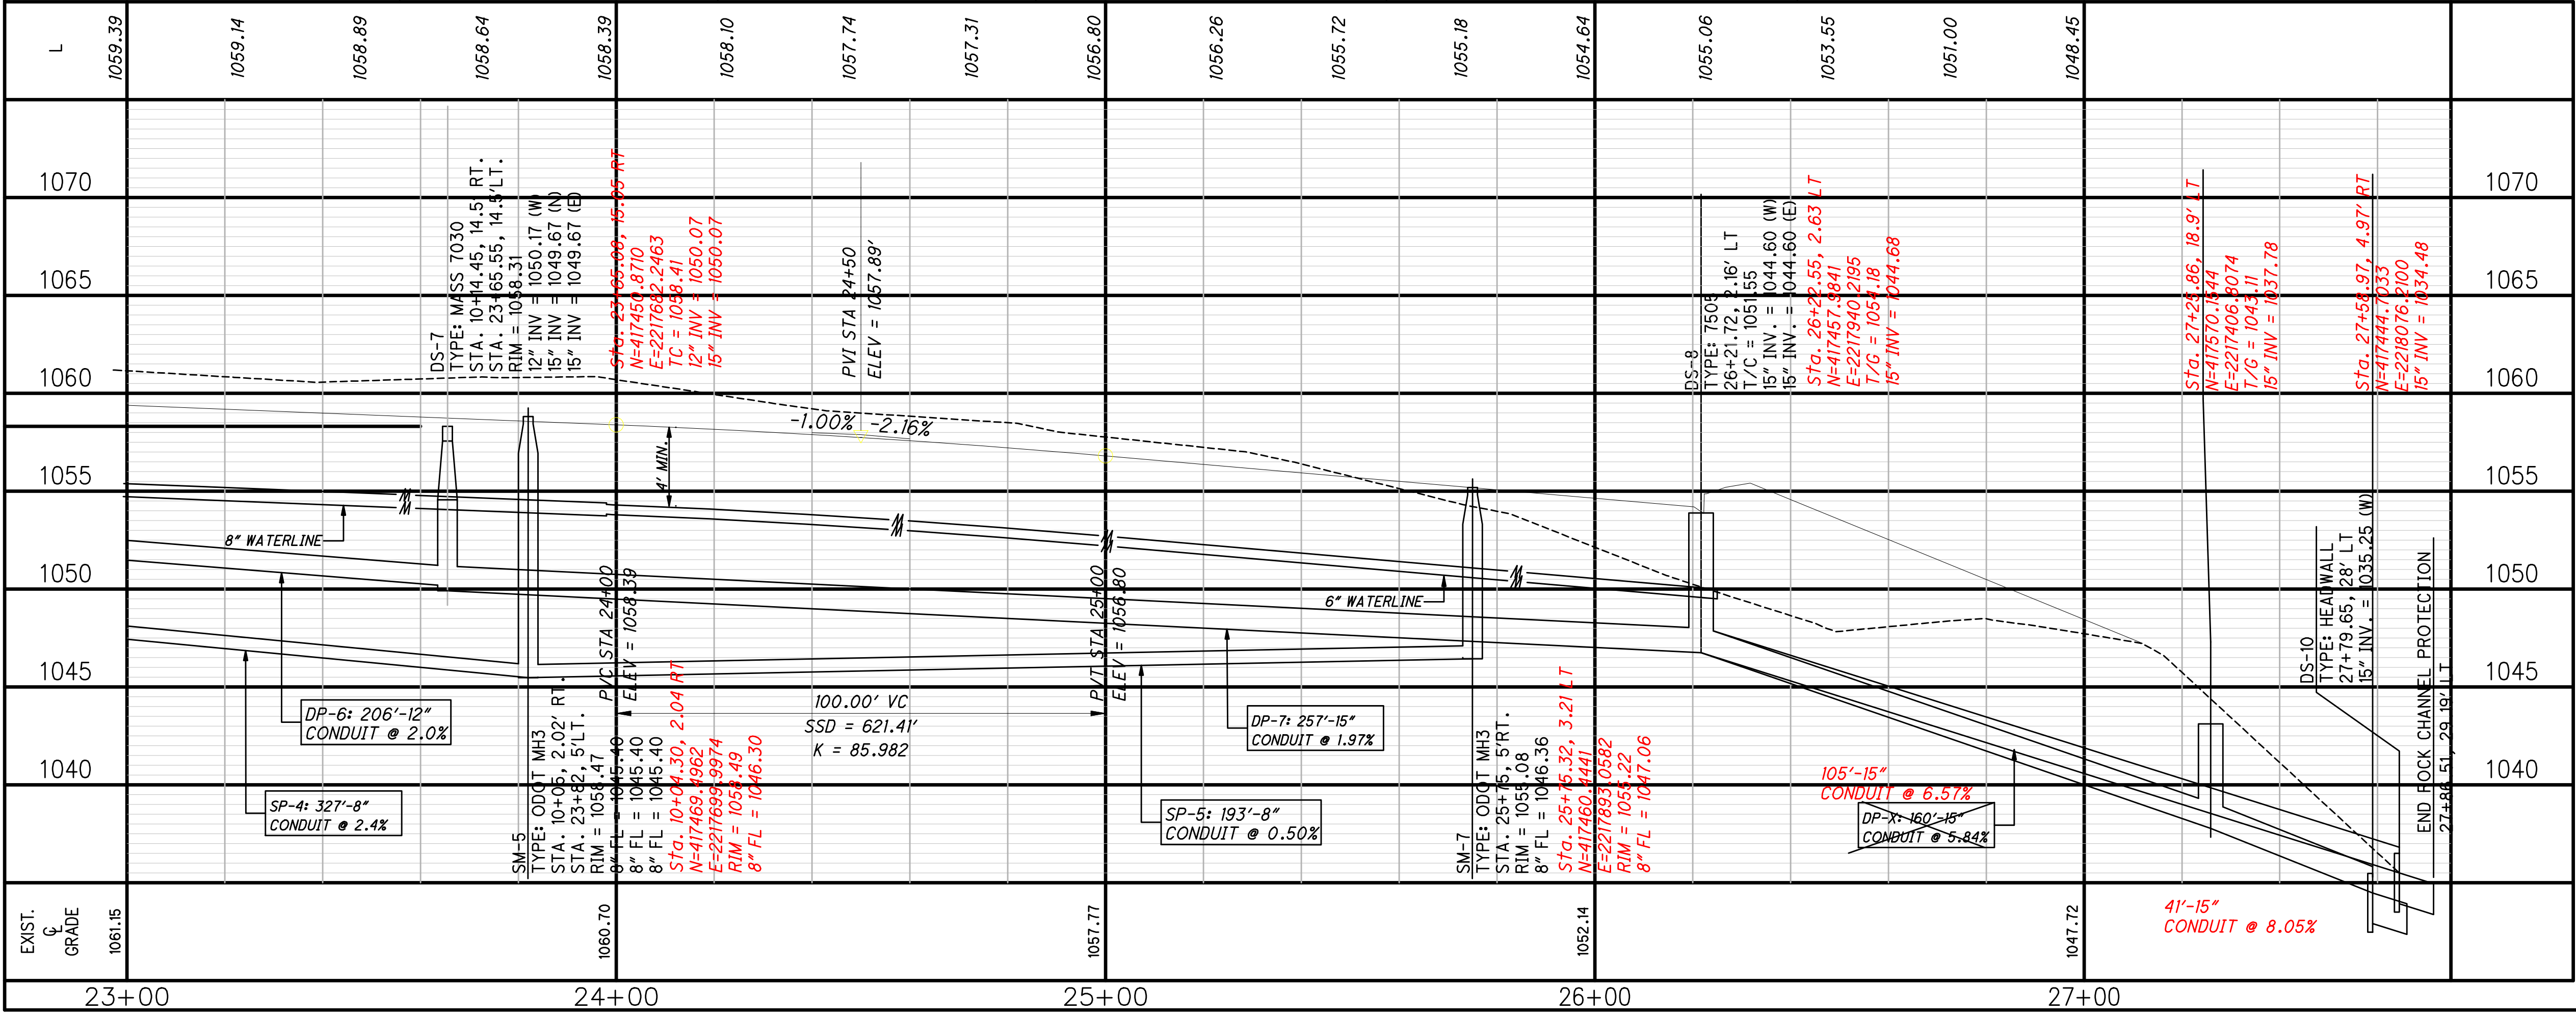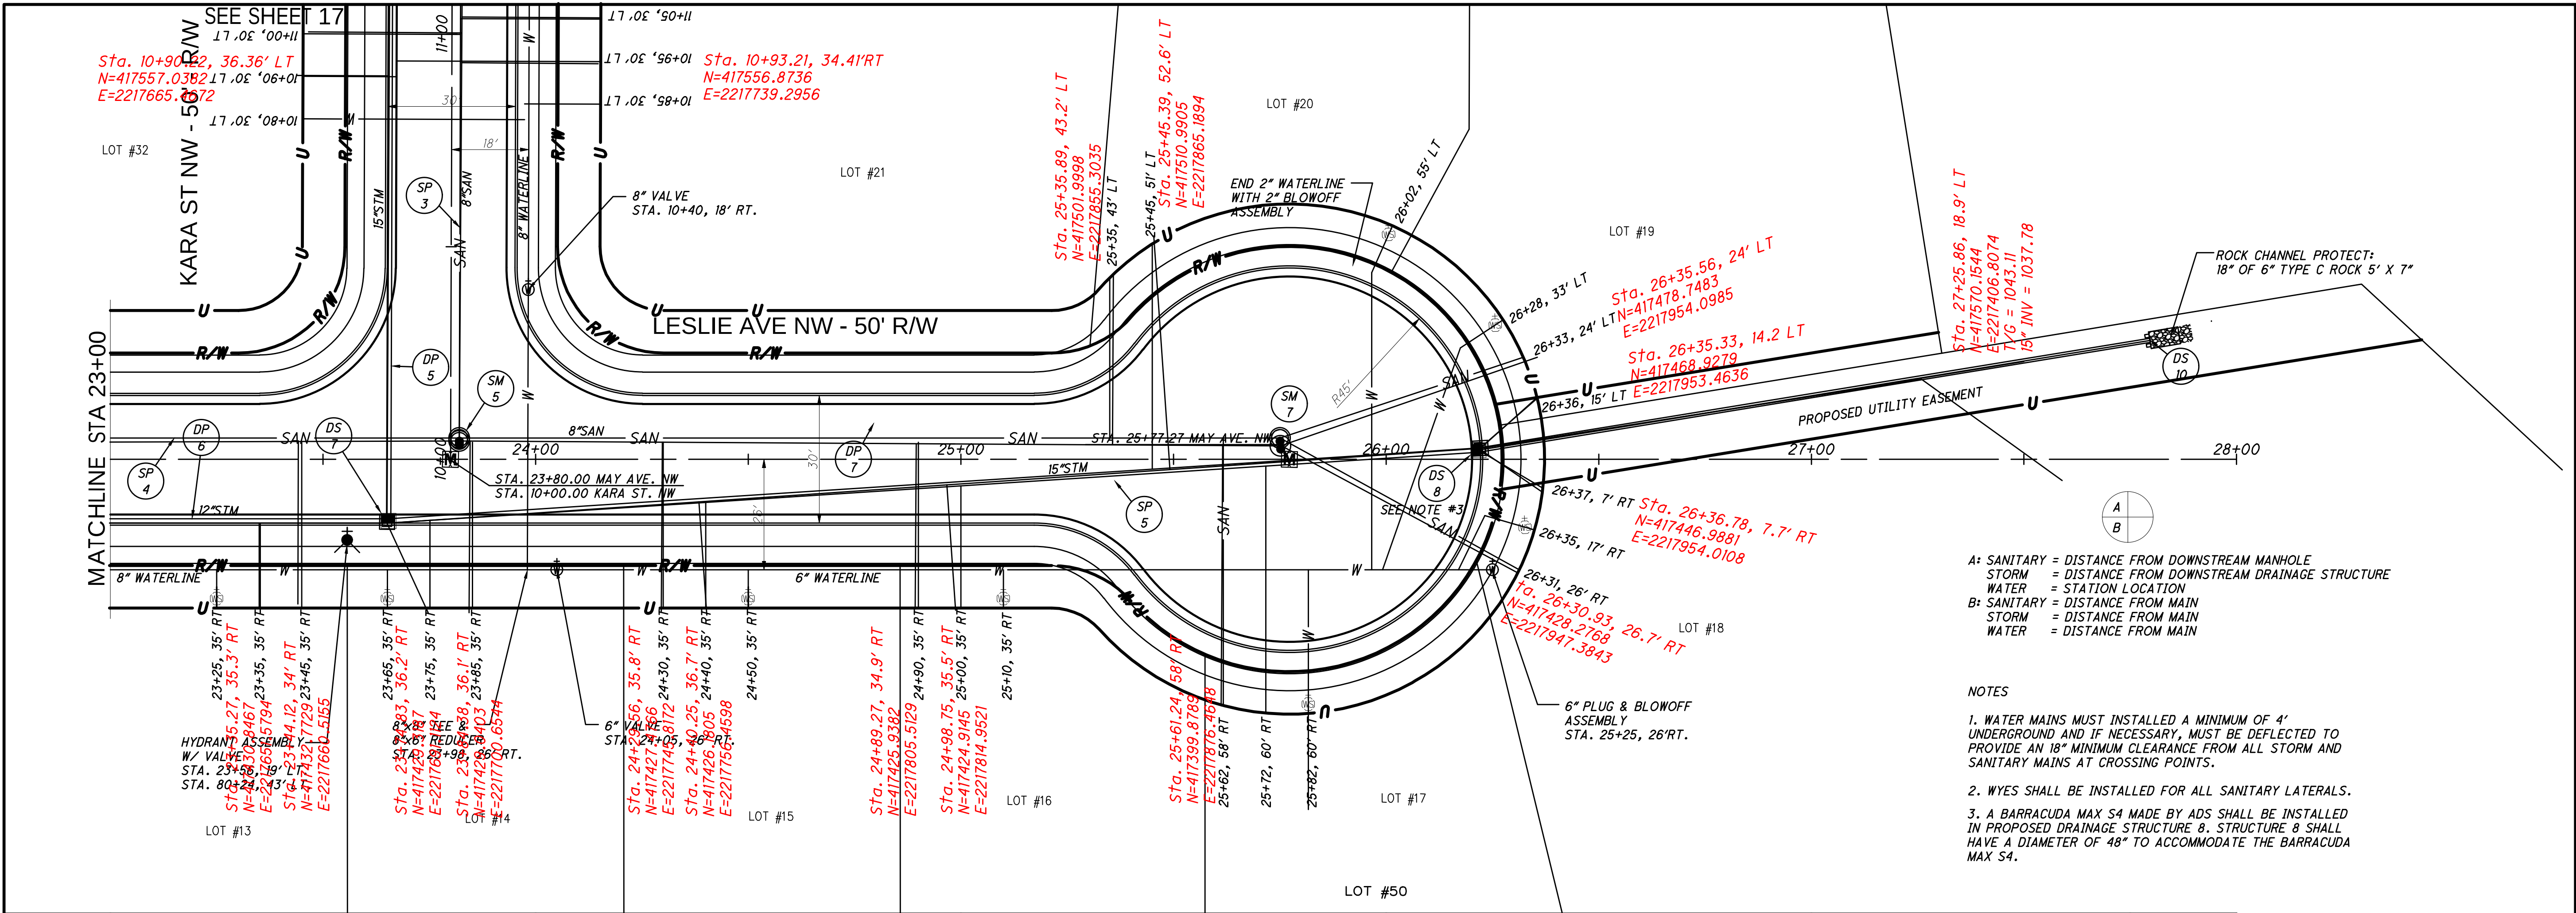

0

10

20

HORIZONTAL

SCALE IN FEET

CHECKED BY:

KAD

DATE:

Mar, 2023

DRAWN BY:

JTD

DATE:

Mar, 2023

REVISIONS:

DATE

DESCRIPTION

1

2

3


1448

1449

1450

1451

14

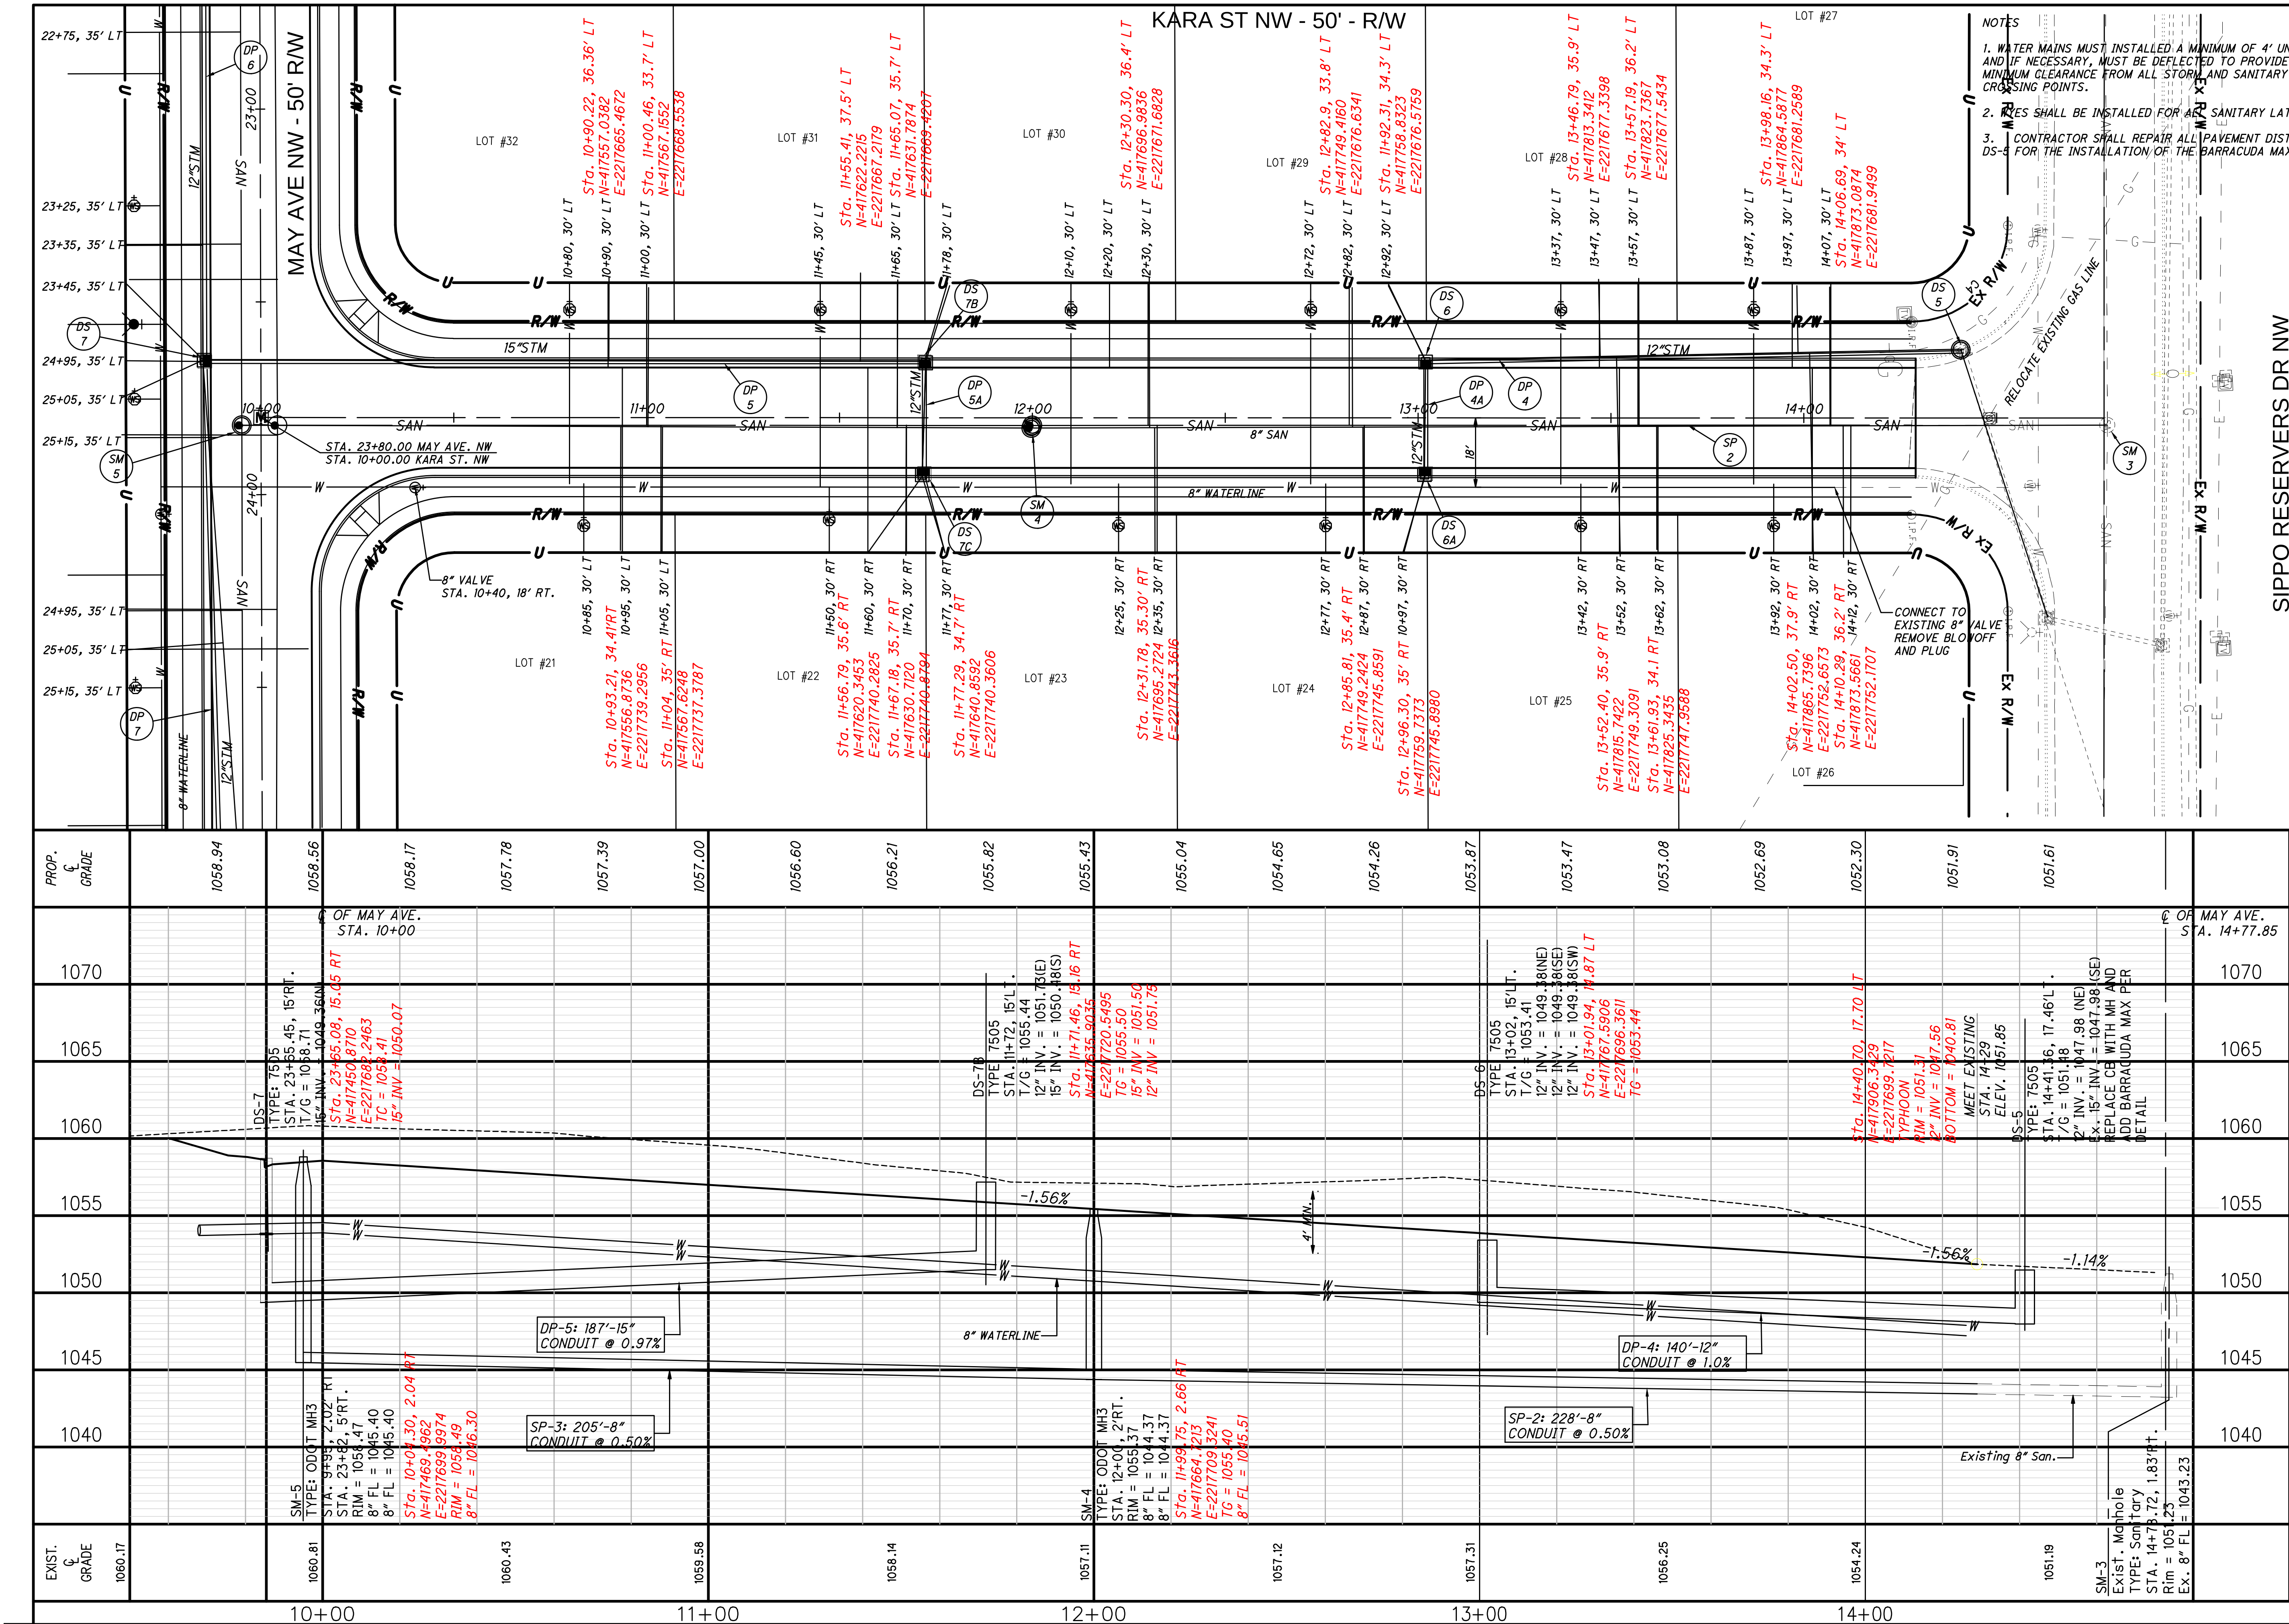

WS

NS

NE

EW

0

5

10

20

HORIZONTAL

SCALE IN FEET

CHECKED BY:

KAD

DATE:

Mar, 2023

DRAWN BY:

BMH

DATE:

Mar, 2023

REVISIONS:

DATE	DESCRIPTION	COMMENTS
9/12/23		

Sippo Reserves Allotment Phase 3 & 4

Kara St NW 9+50 to Sta. 15+00 Plan and Profile

City of Massillon

Stark County, Ohio

CIVIPRO

ENGINEERING

ENGINEERS-SURVEYORS-CONSTRUCTION MANAGERS

4459 BELDEN VILLAGE STREET NW, SUITE 800 CANTON, OH 44708

PHONE (224) 440-3970 EMAIL: KAD@CIVIPROENGINEERING.COM

WWW.CIVIPROENGINEERING.COM

DRAWING NAME:

Kara St PPI

REF. NUMBER:

17

39

