


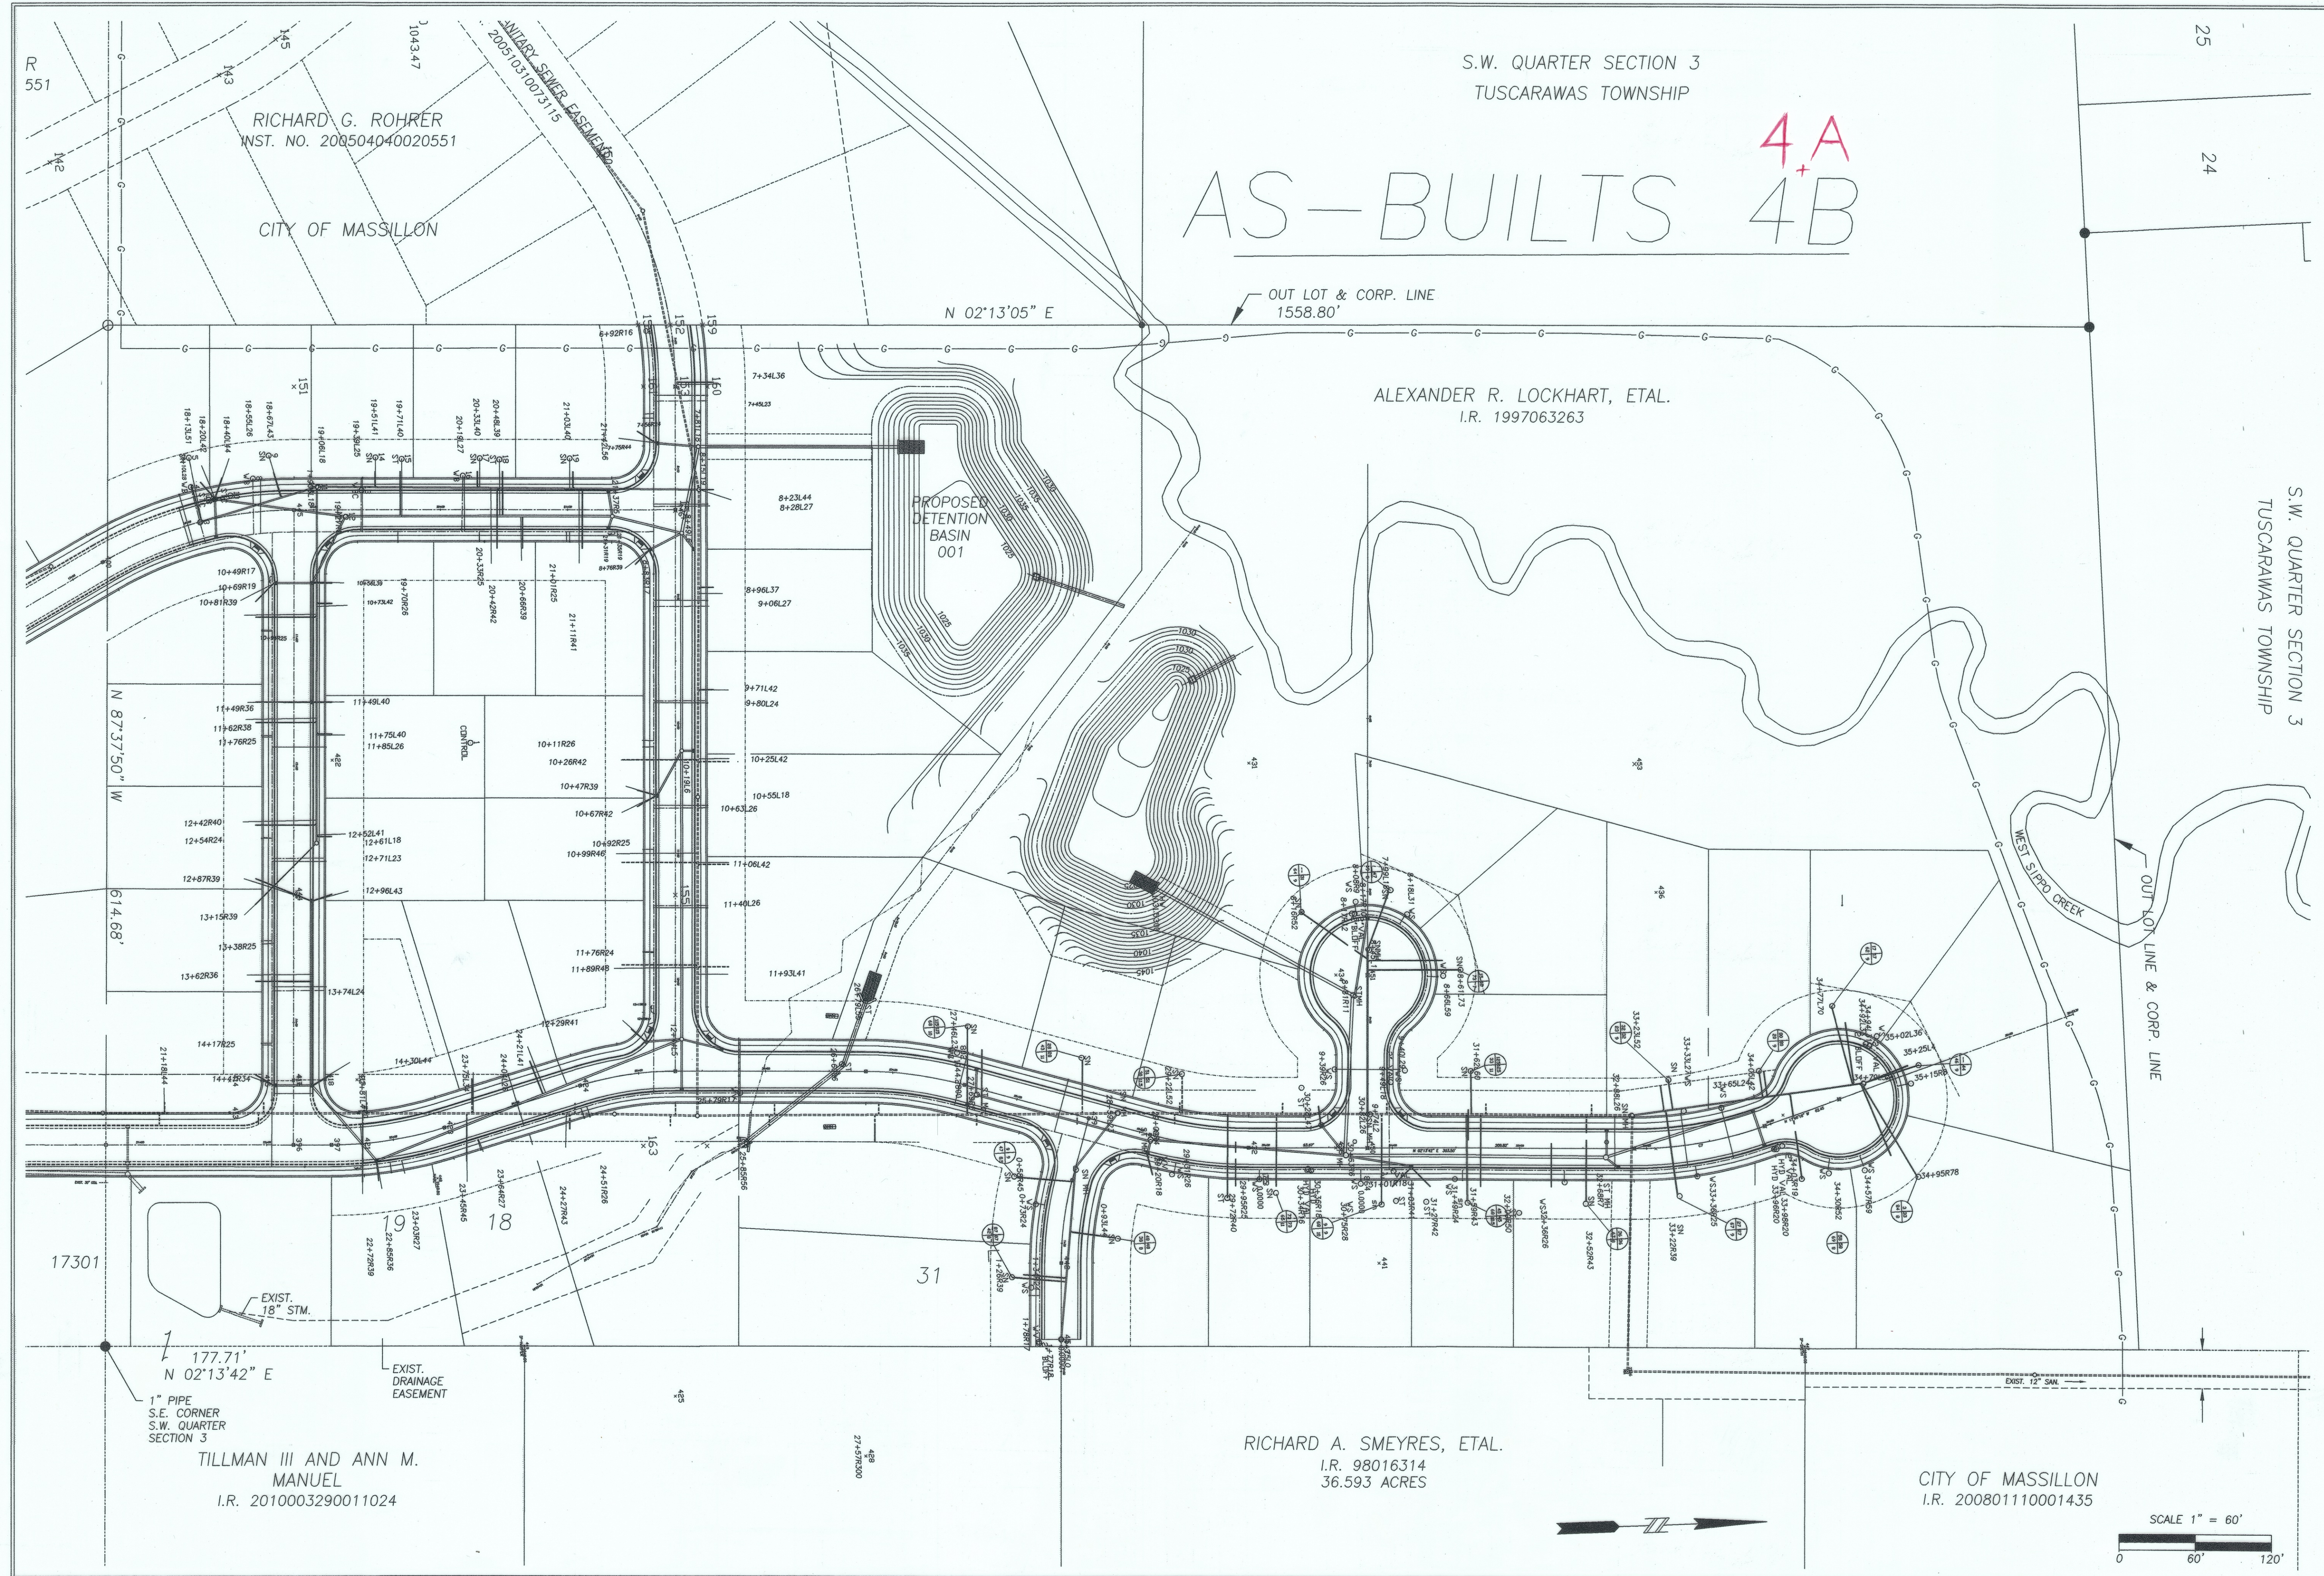

RICHARD G. ROHRER
INST. NO. 200504040020551

CITY OF MASSILLON

S.W. QUARTER SECTION 3
TUSCARAWAS TOWNSHIP

AS-BUILTS 4A 4B

ALEXANDER R. LOCKHART, ETAL.
I.R. 1997063263

S.W. QUARTER SECTION 3
TUSCARAWAS TOWNSHIP

A.R. LOCKHART DEVELOPMENT CO.
800 WEST WATERLOO RD.
AKRON, OHIO

AS-BUILTS
WEST BROOK ESTATES PHASE 4
IN THE CITY OF MASSILLON
STARK COUNTY, OHIO

REVISIONS	DESCRIPTION	DATE	BY	CHKD
		12-22-17	SRC	SRC
		12-22-17	SRC	SRC

PROJECT No.
AS-BUILT

SHEET No.
2

DATE:
9-12-17

DRAWN BY:
SRC

TILLMAN III AND ANN M. MANUEL
I.R. 2010003290011024

RICHARD A. SMEYRES, ETAL.
I.R. 98016314
36.593 ACRES

CITY OF MASSILLON
I.R. 200801110001435

