




ORIGINAL	BY _____ DATE _____
SURVEYED	
FLOTTED	
TEMPLATE	
NOTE BOOK	
AREAS	
AREAS CHECKED	
NO _____	

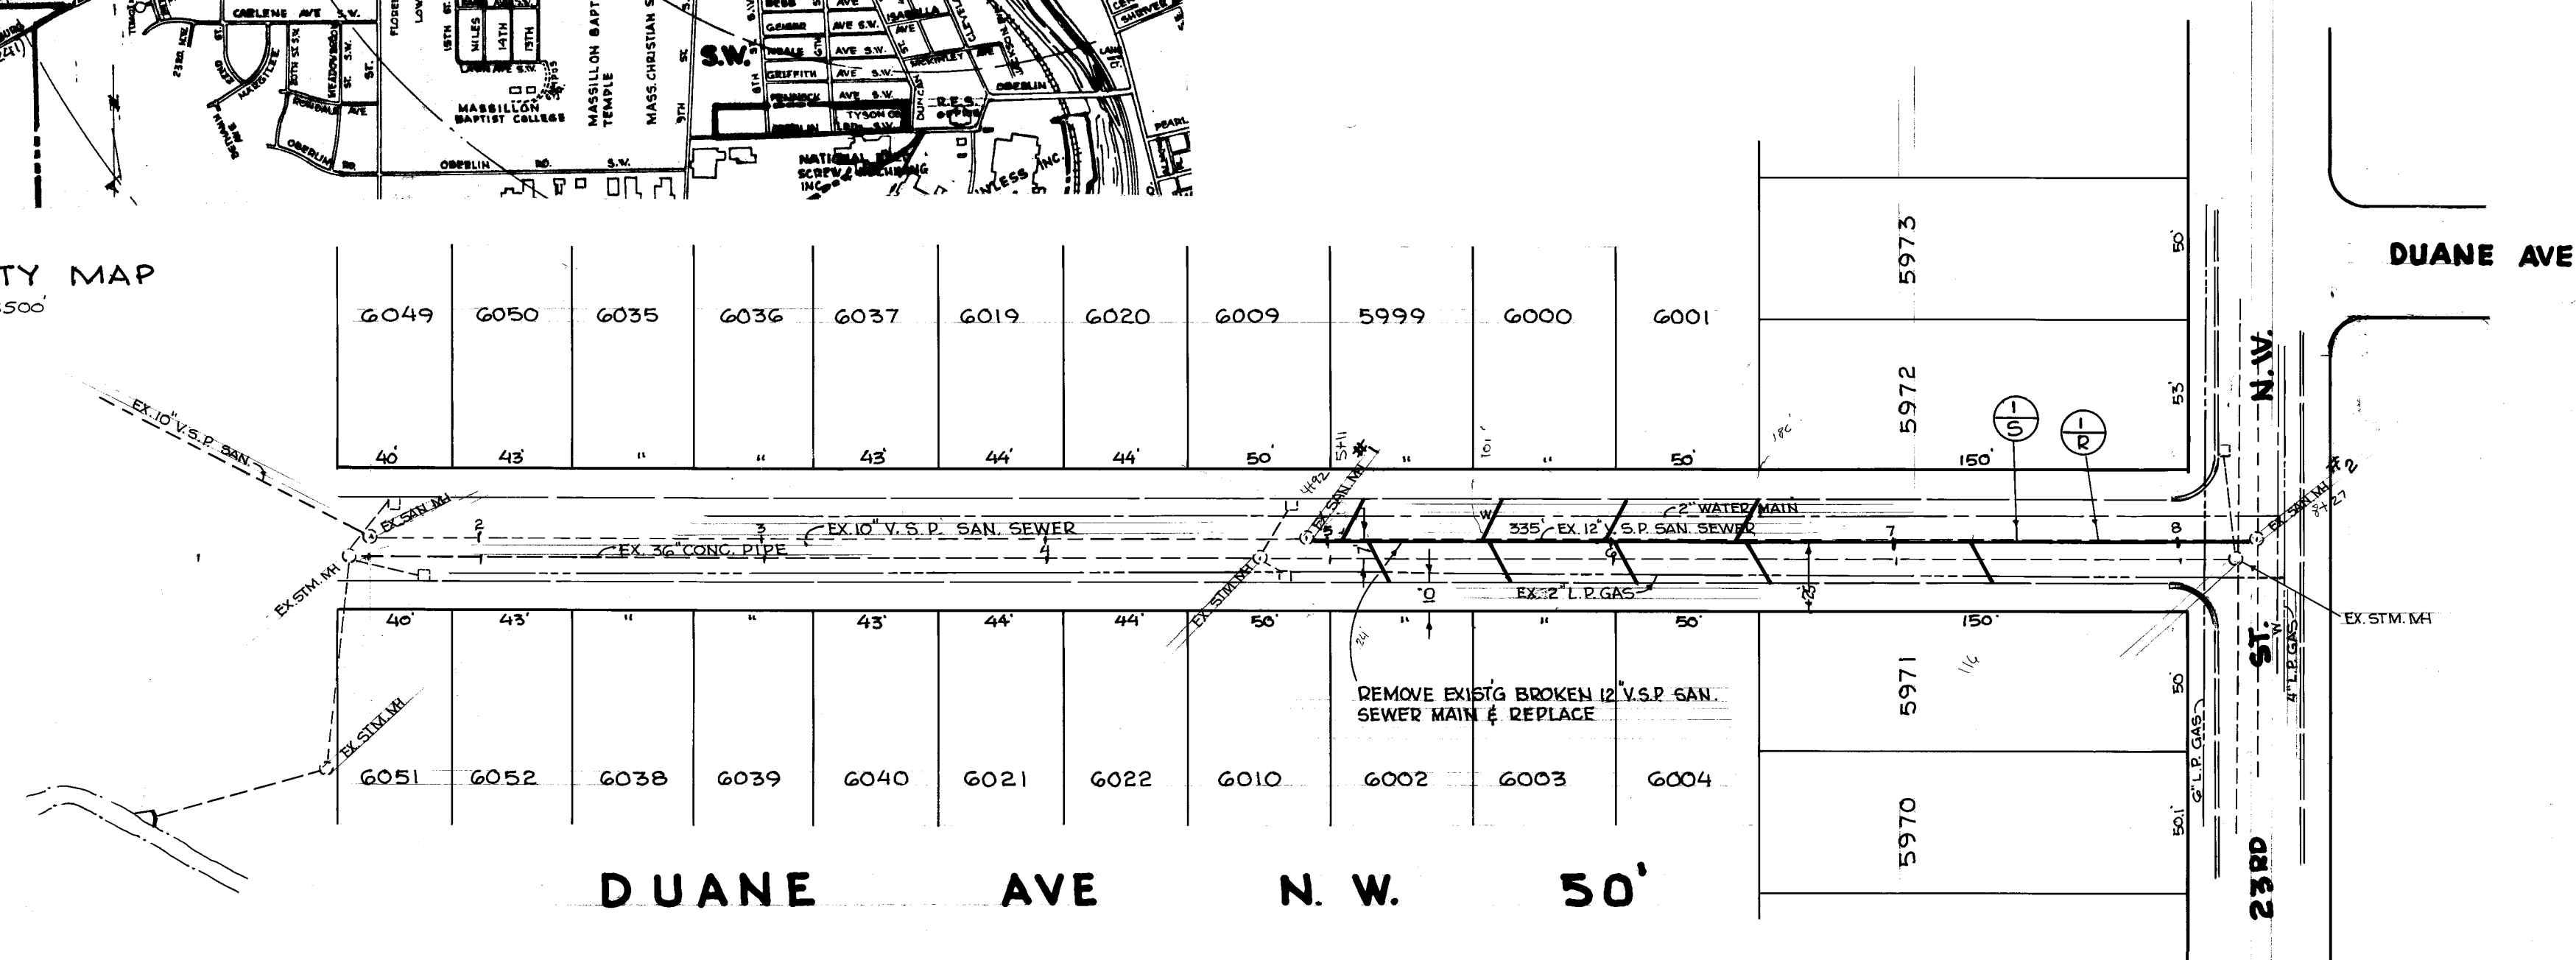

REMOVALS				
	STATION	SIDE	202 12" V.S.P. SAN. SEWER I.F.	
	FROM	TO		
1 - R	4+92	8+27	¢	335
TOTAL				335

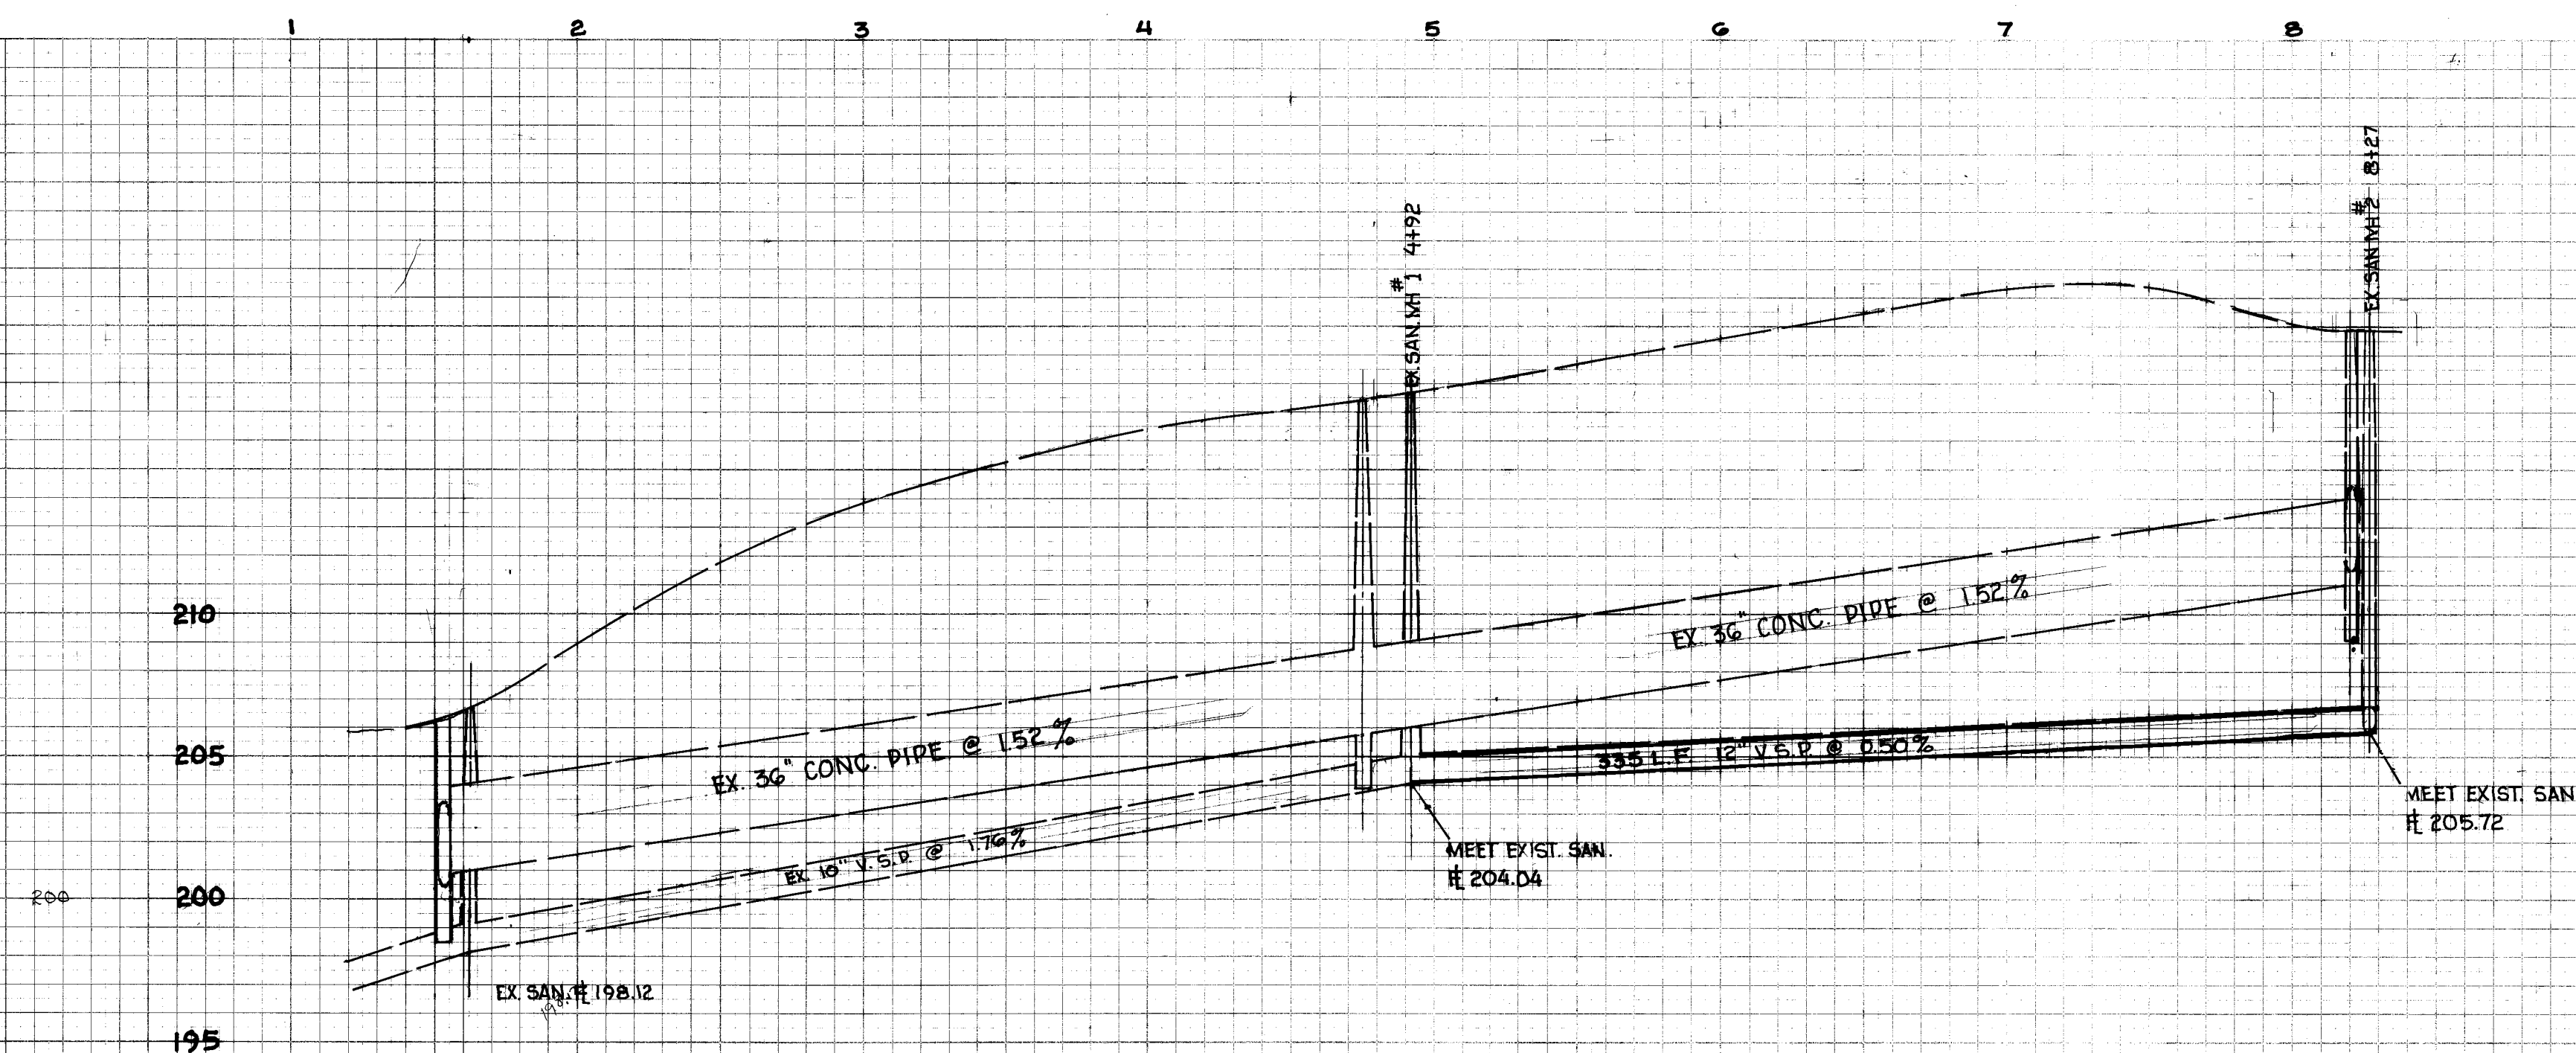

AVE. DAILY FLOW @ 100 GAL/DAY/PERSON	0.083 M/GAL/DAY
PEAK DAILY FLOW @ 250 GAL/DAY/PERSON	0.207 M.GAL/DAY
PIPE CAPACITY	1.486 M.GAL/DAY

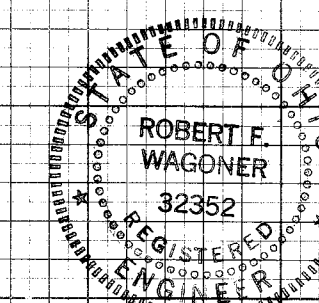


THE SANITARY SEWER PLAN SHOWN HEREON WAS PREPARED
UNDER MY DIRECTION: Robert F. Wagoner
ROBERT F. WAGONER, P.E., OHIO REG. NO. 32352

CITY OF MASSILLON, OHIO
DUANE AVE N.W. 50' R/W


DR BY WON MCPHERSON	DEPT. OF PUBLIC SERVICE ENGINEERING DIVISION
CITY ENG. ROBERT WAGONER	
SCALE 1" = 50'	DATE - 8-91

10-21 Helman

DATE	BY	SURVEYED	PLOTTED	NOTE BOOK	AREAS CHECKED
FINAL					
SURVEY					
NO.					

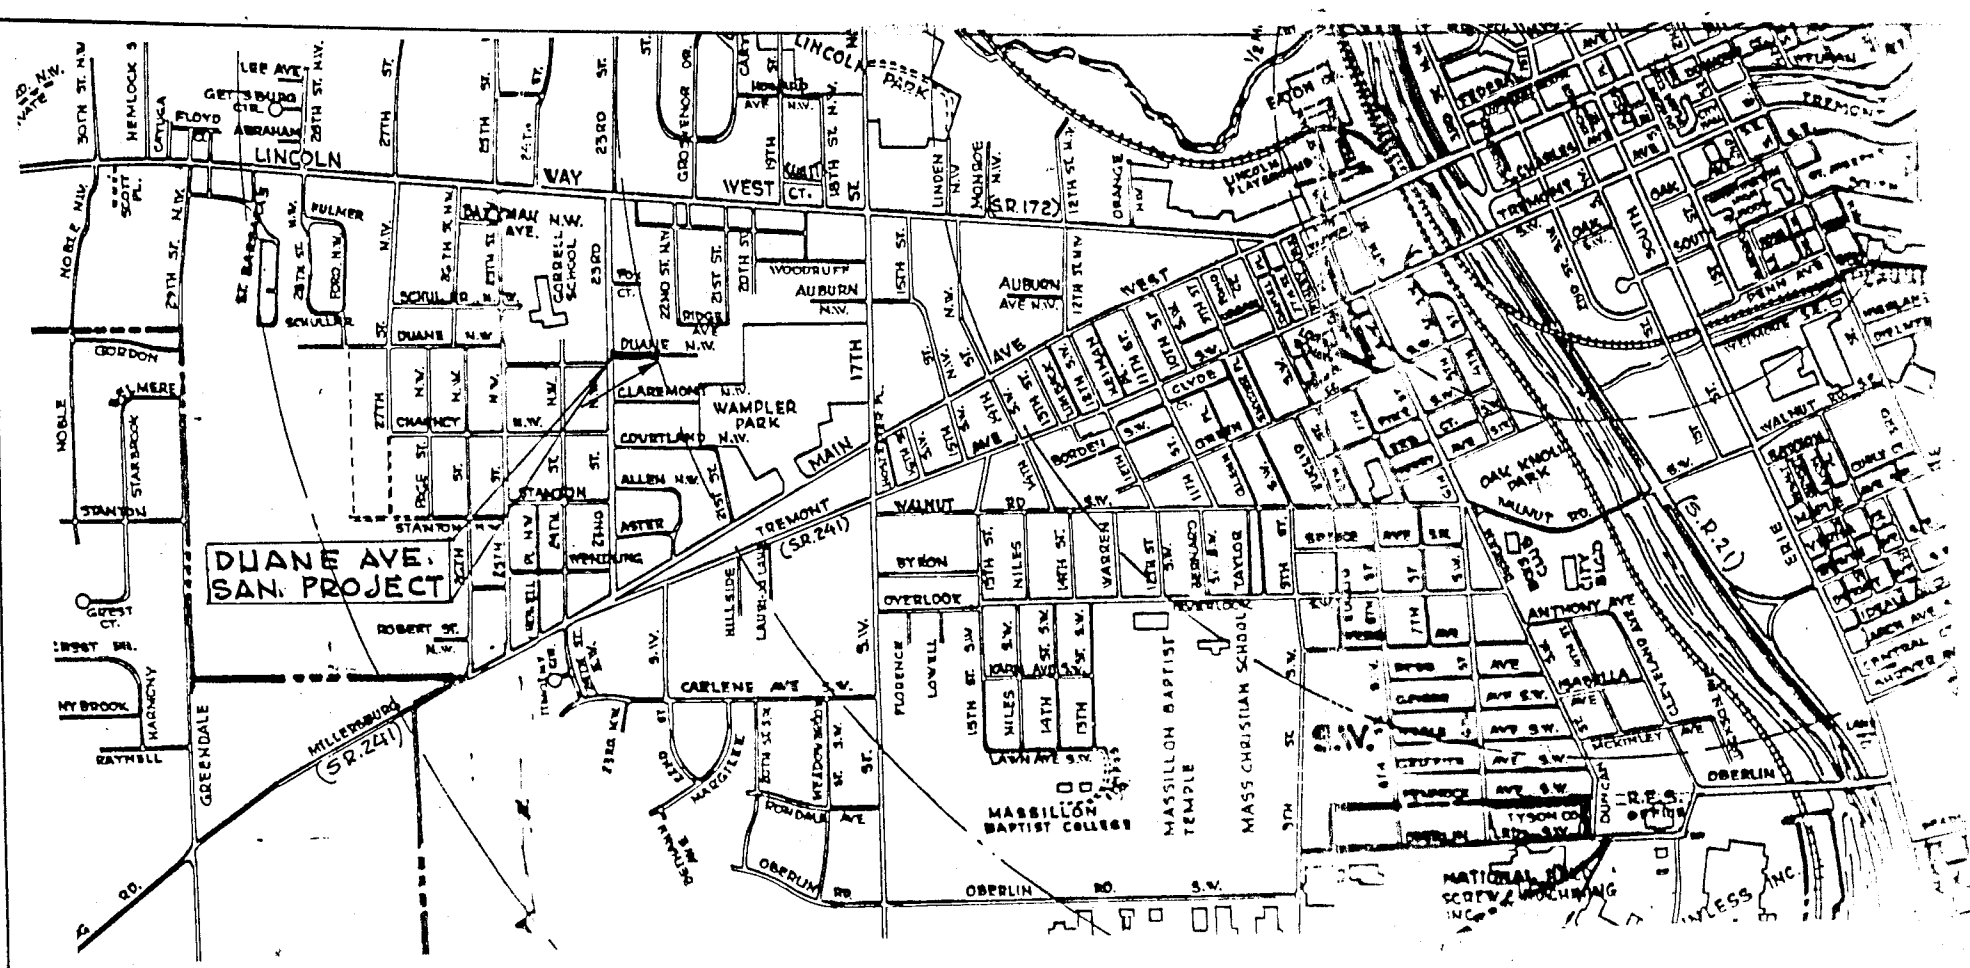

VICINITY MAP
SCALE 1"=1500'

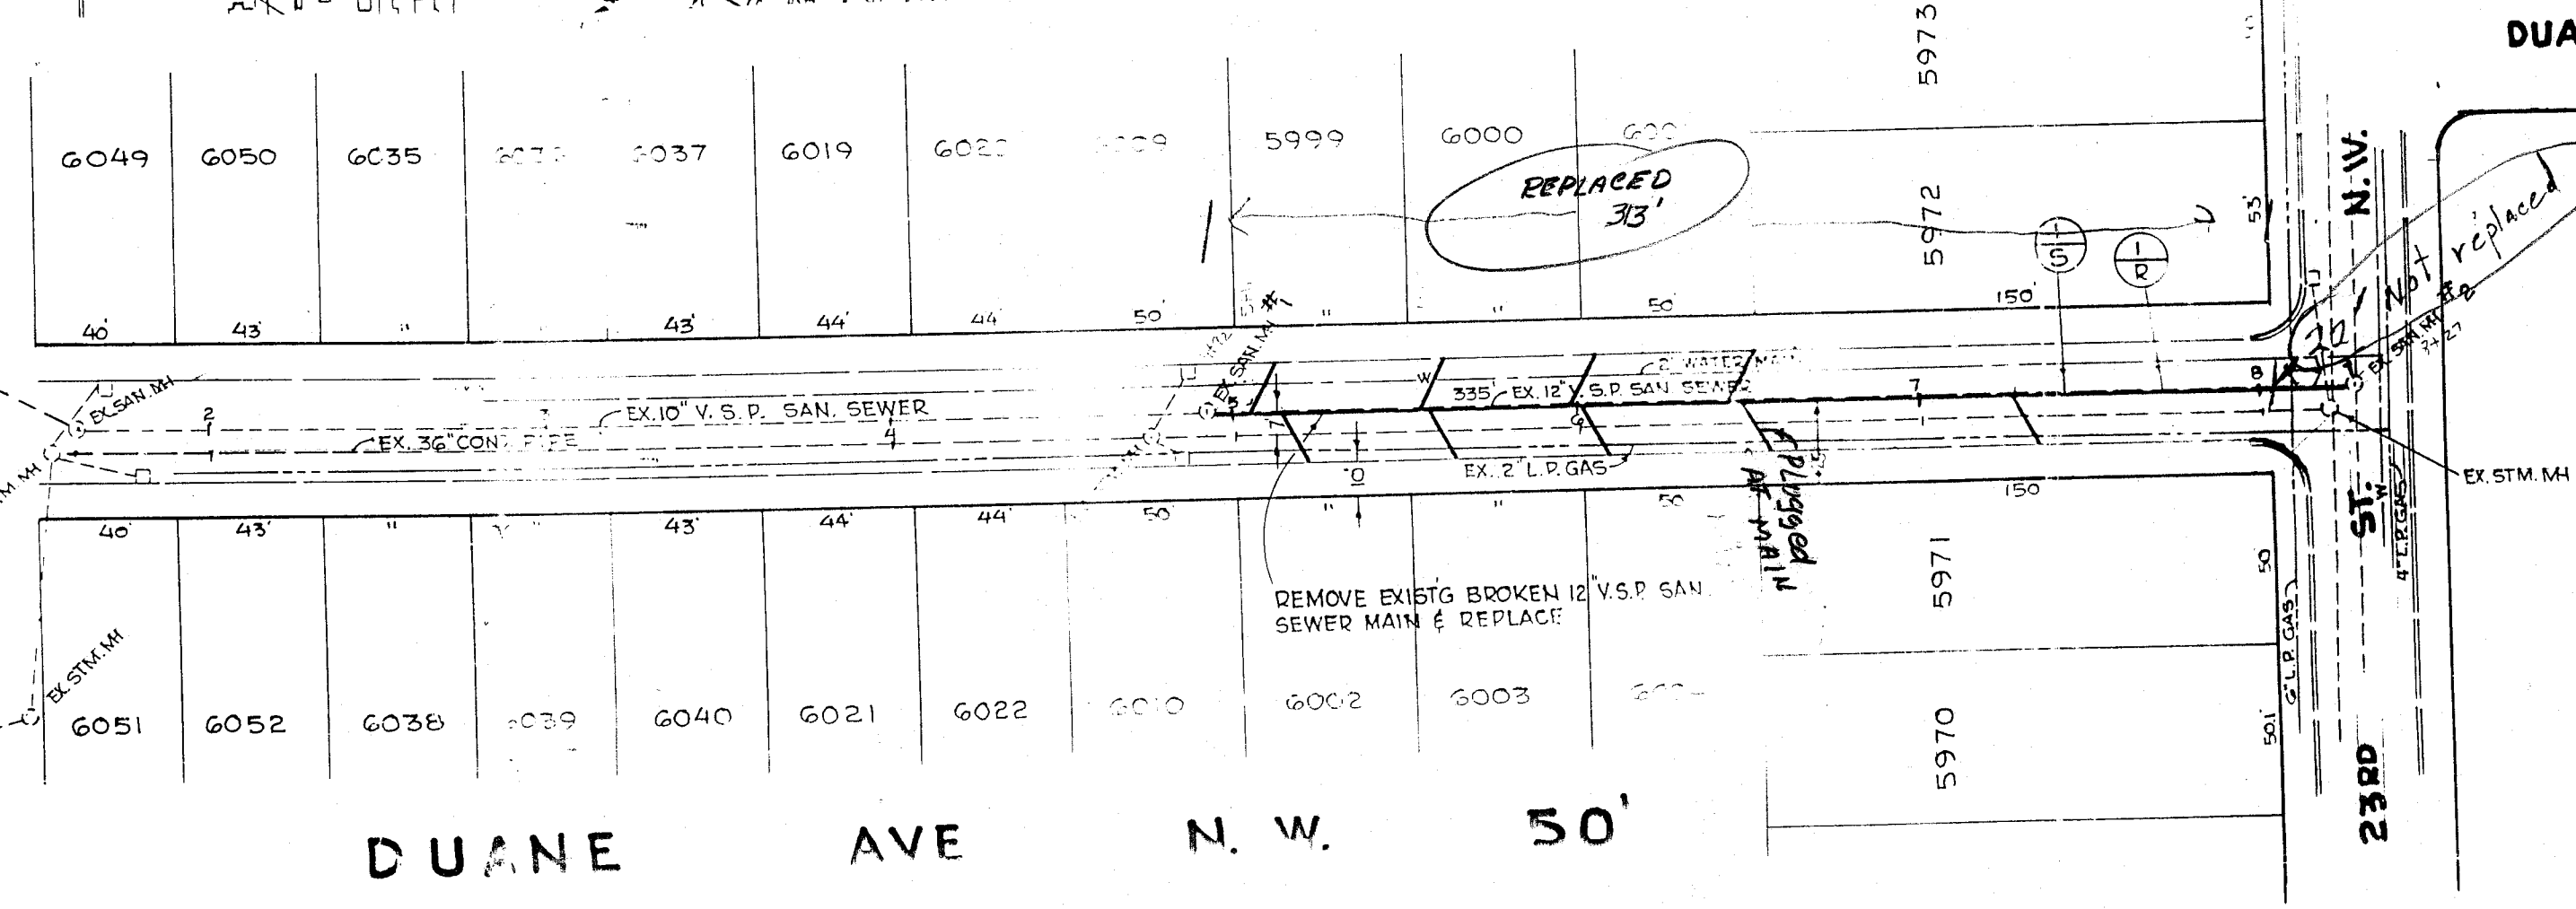


ESTIMATED QUANTITIES			
STATION	SIDE	12" V.S.P. SAN SEWER L.F.	
FROM TO			
1-5 4+92 8+27	E	335	
TOTAL		335	

REMOVALS			
STATION	SIDE	202 12" V.S.P. SAN SEWER L.F.	
FROM TO			
1-11 4+92 8+27	E	335	
TOTAL		335	


603 6" V.S.P. 70' DARK RUN

DATE	BY	SURVEYED	PLOTTED	NOTE BOOK	AREAS CHECKED
ORIGINAL					
SURVEY					
NO.					

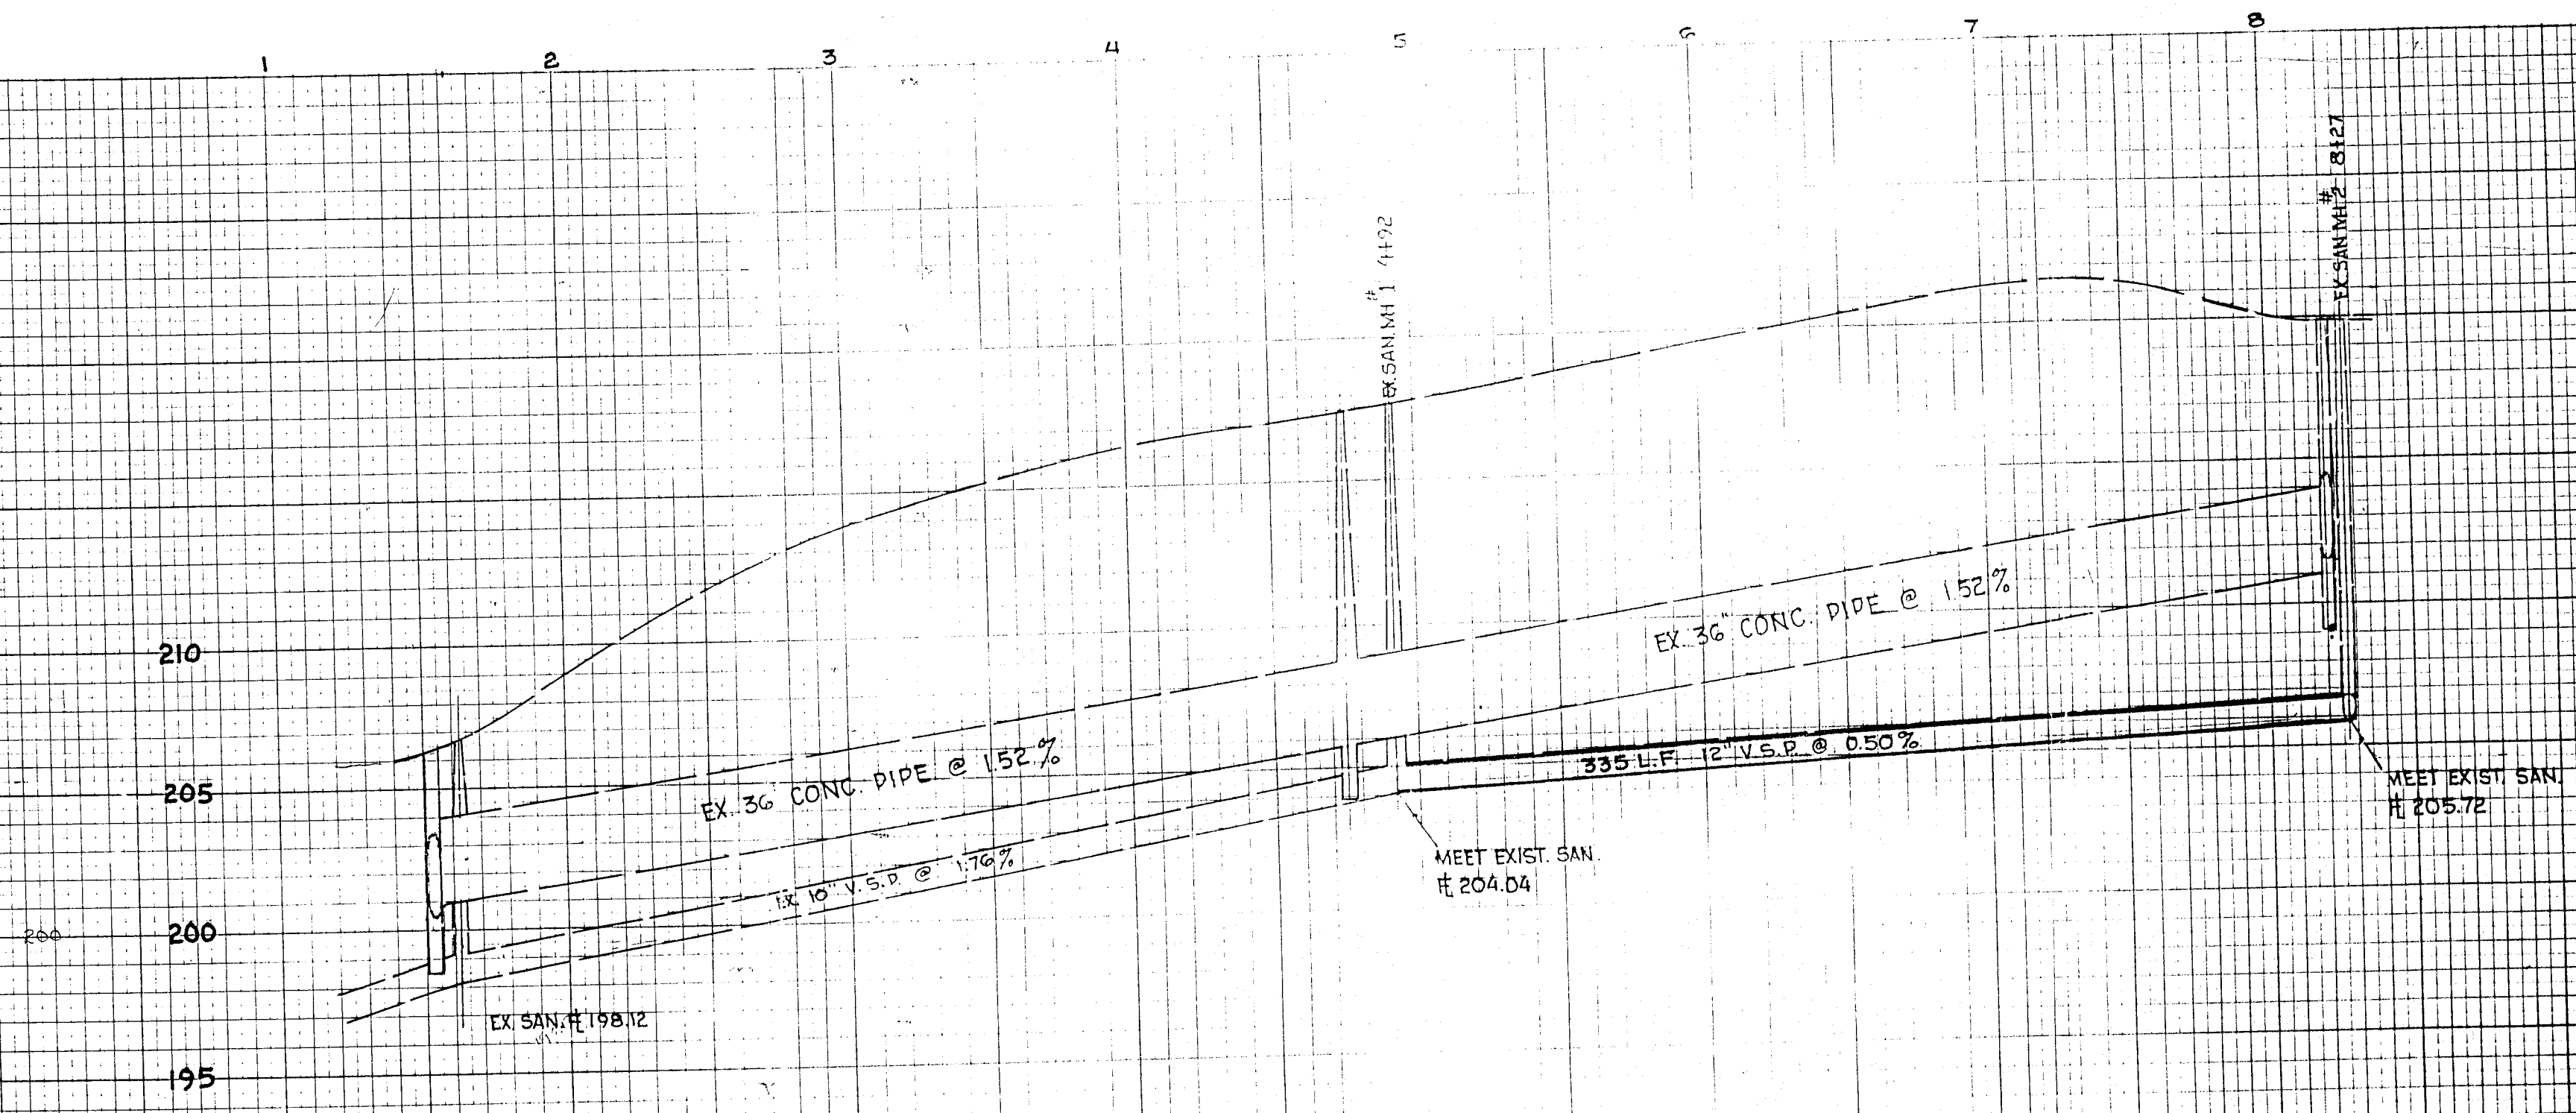

AS BUILT BY Bill PAPPAS

AVE. DAILY FLOW @ 100 GAL/DAY/PERSON 0.085 M.GAL/DAY
PEAK DAILY FLOW @ 750 GAL/DAY/PERSON 0.607 M.GAL/DAY
PIPE CAPACITY 1.436 M.GAL/DAY

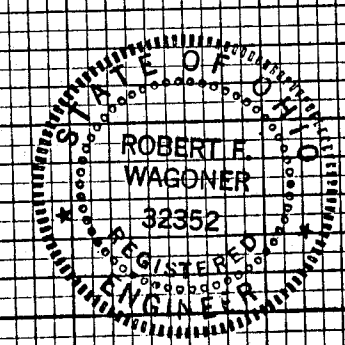

THE SANITARY SEWER PLAN SHOWN HEREON WAS PREPARED
UNDER MY DIRECTION: *Robert F. Wagoner*
ROBERT F. WAGONER, P.E., OHIO REG. NO. 32352

CITY OF MASSILLON, OHIO	
DUANE AVE N.W. 50' R/W	
DR BY: RON MCHEXSON	DEPT. OF PUBLIC SERVICE
CITY ENG. ROBERT WAGONER	ENGINEERING DIVISION
SCALE: 1"=50'	DATE: 8-19

14:46(AS-BUILT)