


3 1/2" Trunk

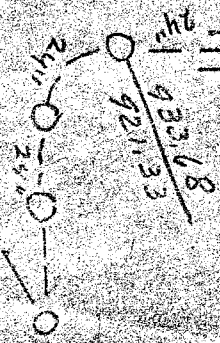

ST.

Edwin

Maple

Elm

Walnut

South


Wetmore Ave.

930.62
940.55

Wheat E.

6th St. N.E.

6th St. S.E.

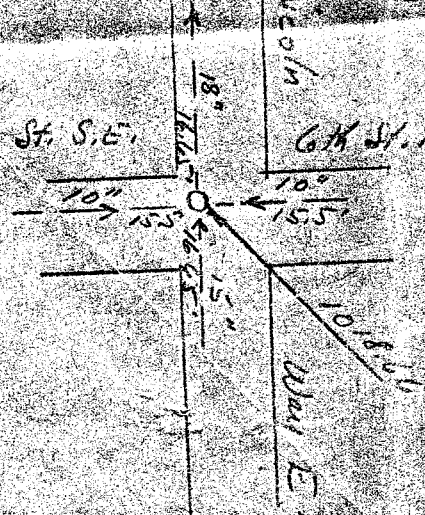

Lincoln

A
~~AKRON ST~~ 22
AMHERST RD. NE Cherry To Commonwealth

B

C
CHERRY ST 21
CHARLES ST 13
~~CHARLES ST~~ 10
~~CECIL ST~~ 6
5TH ST SE

D

E
ERIE ST (S) 1
" " 2
" " 3
" " 8
See 3rd st NE 17
See 1st st SE 19
ERIE ST (TRUNK TO RIVER) 1
8TH ST SE Lincoln Way E.
To Wellman ave SE 20

F

5TH ST SE Lincoln Way E.
To Wellman 7
4TH ST NE North and South
From Chestnut 9
FEDERAL AVE NE Erie St No.
To 4th St NE 14
1ST ST SE South and Northerly 18
1ST ST NE Federal ave NE
To North ave NE 18

G

GREEN ST - 19

H
HIGH ST 20
see 4th st SE

I

3600
2615
2000

J

K

L

LINCOLN WAY EAST 4TH 5
ST NE To WALES RD NE 6

M

MAIN ST 5
See Lincoln Way E. 6
Main ave M 11
Main St S 18
See 1st st SE 18
See 1st st NE

N

NORTH ST - 15

O
OAK AVE SE 4
ST (E.)

P

See Federal ave NE
PLUM ST - 14
See 4th st NE
PROSPECT ST - 9
PENN AVE SE Erie st
South To 1st st SE 9

Q

R

See Penn ave SE
RATCHFORD ST - 9

S

SOUTH ST - 16

T

TREMONT ST (H) 23
" " " 24
3RD ST NE North ave To
Cherry Rd NE 17
3RD ST SE Oak ave SE 19
200' South

U

V

W

WELLMAN ST - 20

X


Y

3600
2615
2000


Z

DESCRIPTION OF THE LATERAL SEWER ON S. ERIE ST. FROM CHESTER TO DWIGHT ST.

Manholes (2) as designated on Profile & Plan
Lateral Connection One 12 inch Caliber facing East on Edwin Street
There are eight 6" Y House connections on the west side on S. Erie St.
and 10.. 6" inch Y House connections on the East side of S. Erie St.
starting for the West side Connections opposite the South Line of Chester Street
and the Connection for the East side one foot North of the South Line of said Chester St.
all House and Lateral Connections are in cloud and marked with a Little Circle and a red cross
The Connections on Lots Nos 1022, 1023, 1024, & 1025 to be connecting for measuring
from the South west Corner of Edwin Street which is also the S. West Corner of Lot
No. 1022. all distances between Connections given on Plan, as here represented.

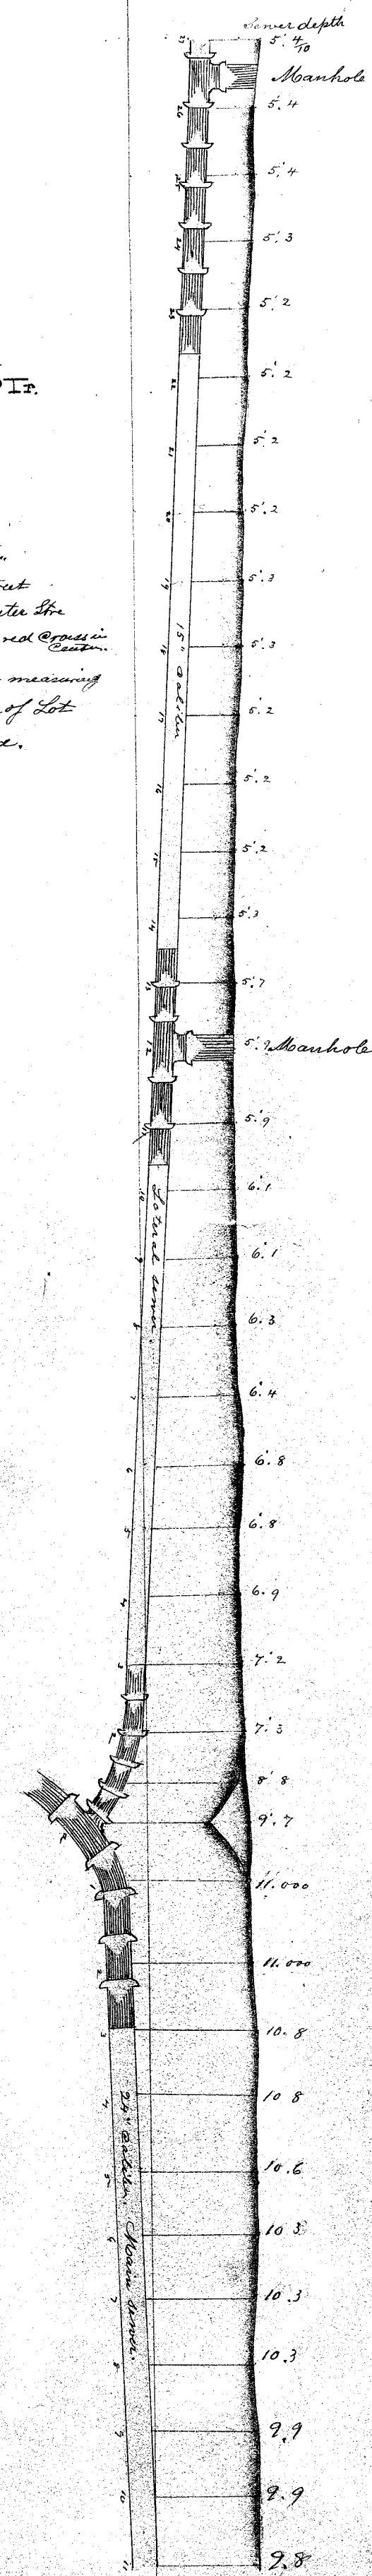

PROFILE OF LATERAL SEWER ON SOUTH ERIE STREET BETWEEN CHESTER & DWIGHT STREET

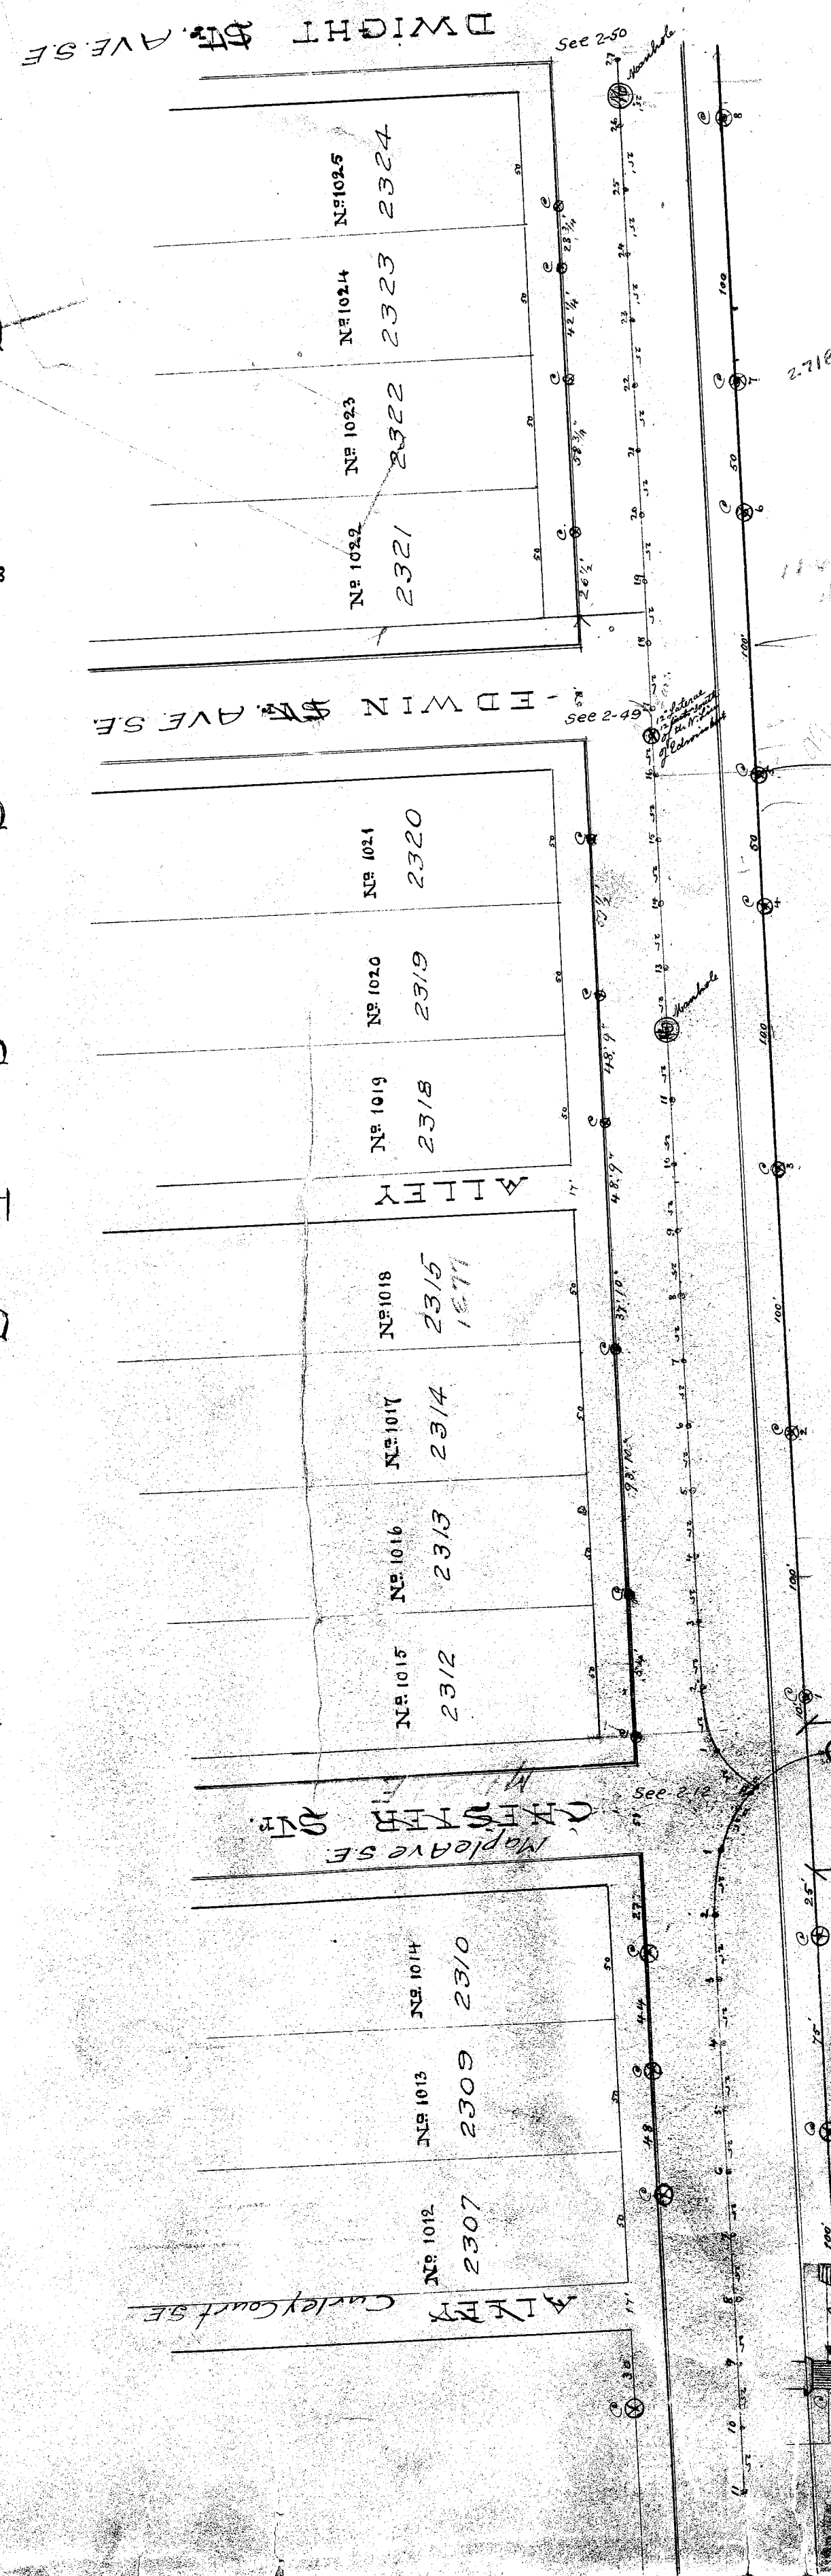


DESCRIPTION OF THE TRUNK SEWER

Said Trunk Sewer is constructed of 24 inch caliber sewer pipe and extends from the outlet on the River to the middle Line of South Erie Street, where junctions are formed for the extension of a Main Sewer of 24 inch pipe and two lateral junctions one to extend south on South Erie Street and one facing Eastwardly towards Chester Street.
Lateral sewer laid on South Erie southwardly is 15 inch Caliber pipe, said Connection is 34 feet eastwardly from the middle of Manhole depth 9 1/2 feet.
Lateral Connection for Chester Street eastwards 49 feet from middle of Manhole 12 inch Caliber Connection depth 9 1/2 feet.
The depth of sewer are marked on Profile below.

Connected to Main
Trunk Sewer at this
Point see plan
Sheet No Page 48

Abandoned to River


PLAN & PROFILE OF TRUNK SEWER in SEWER DIST. No. 3 BETWEEN THE RIVER and WEST SIDE of S. ERIE ST.

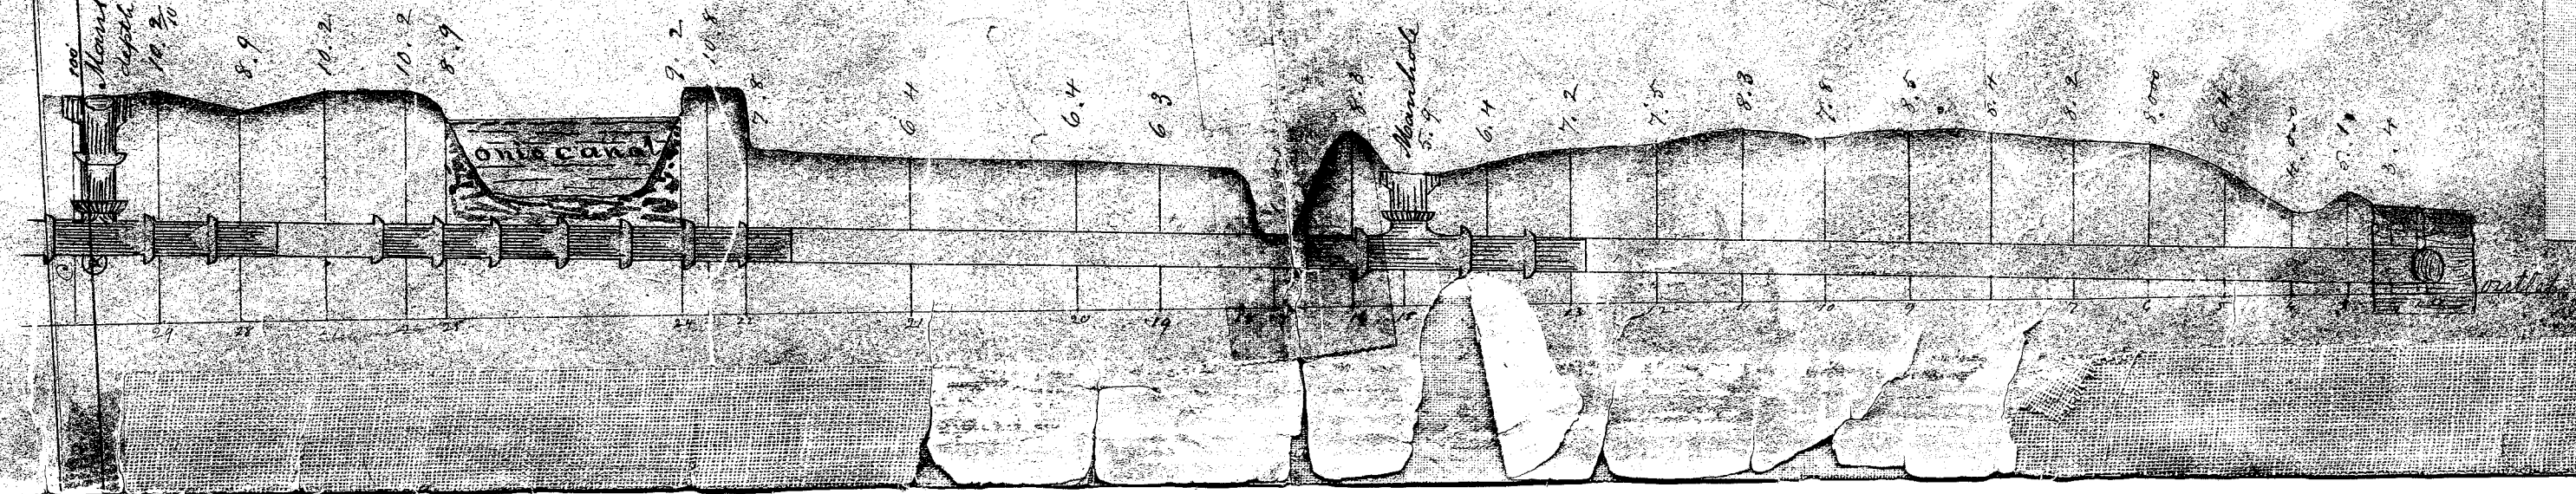


Green No3 = Server Permits

1" = 50
1" = 10

Beginning opposite the North Line of Chester Street. First connection is 25 feet distance from said Point and from thence all distances given between Connections. The first of Russell Connection on the said west Line of S. Erie Street is 27 feet south of the south east corner of Lower shops

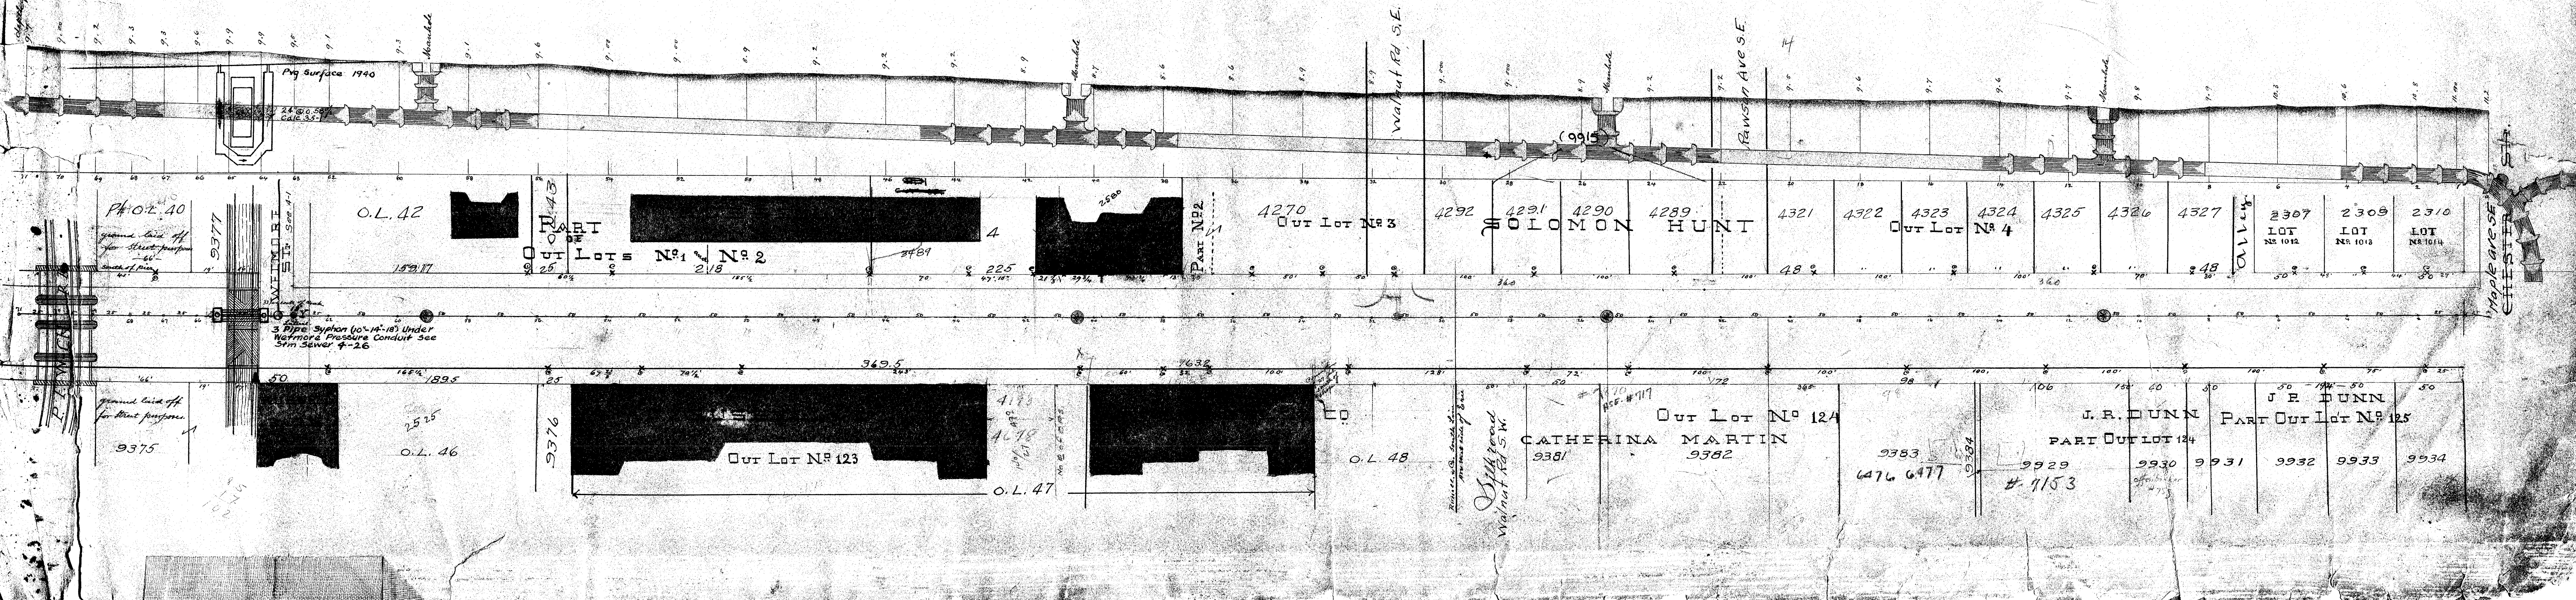

PLAN & PROFILE OF S. ERIE STREET SEWER FROM STATION No. 66 SOUTH OF THE P.F.W. & CH. R.R. BRIDGE TO A POINT FEET SOUTH OF TREMONT ST.

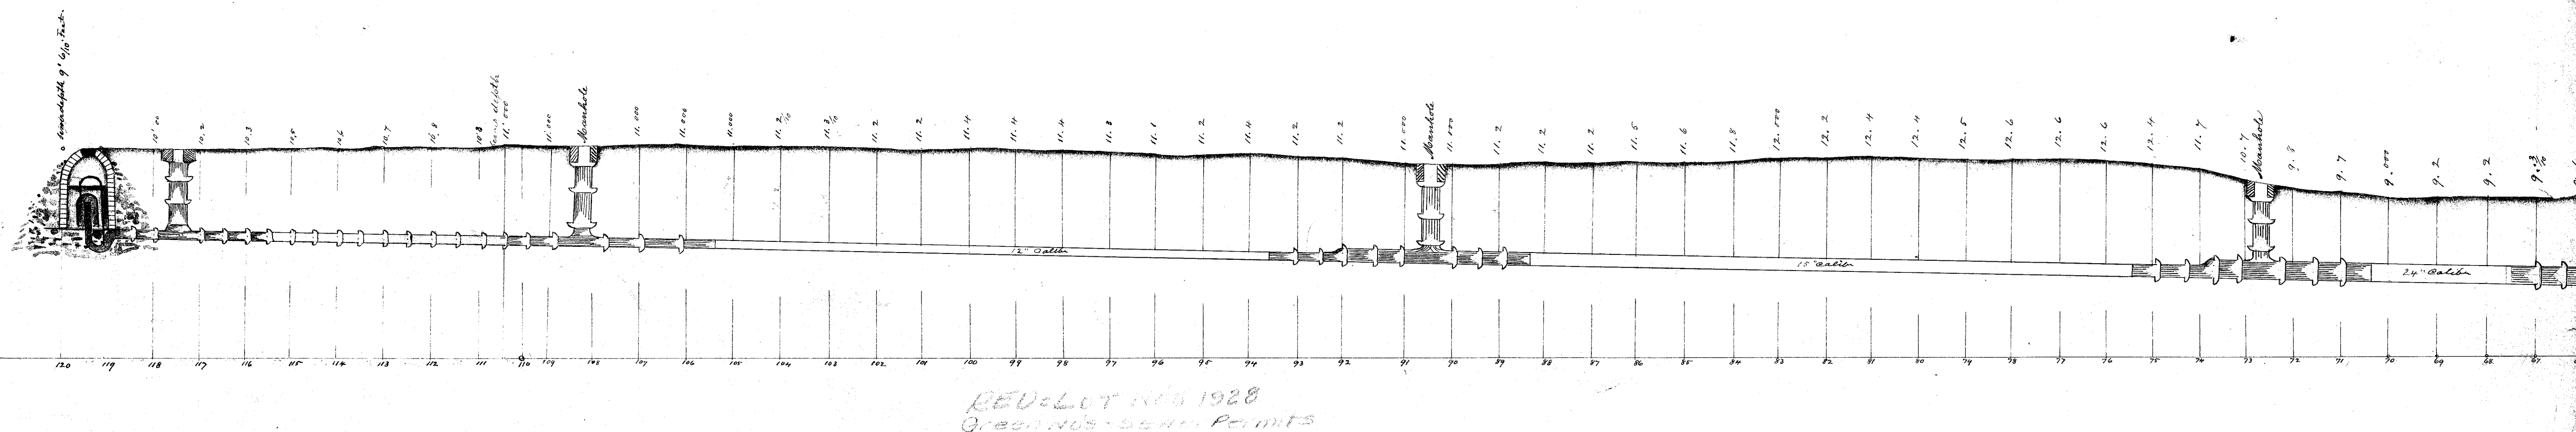

REFERENCES AS TO THE SEWER
MANHOUS LATERAL HOUSE CONN^{ection}

The depth of some is marked with red figures above the Profile of Erie Street.

Gravel pits as designated therein.

Off House and Lateral Connections are Y Connections

Strut on Railroad Street facing East is 13 1/2 feet North of middle of Manhole and is a 12 inch Connection

Lateral Connections on E. South Street 12 inch Connection

Facing East 10 feet North of middle of Manhole

Lateral Connections have 8 inch 8 inch Connection is 24 feet North from middle of Manhole

All House Connections marked on plan for Street, and distances given between Connections from Street to Street, are on east side of Erie Street, Railroad ground Connection is 10 feet North of the south end of RR Bridge Pier


The House Connections between Railroad and E. South Street are Connections on the South west Corner of Lot 998 on Railroad Street

Extending to East side of West South Street.

The Connections from the West line of East South Street to the South line of E. Oak Street are also marked with red cross on Chart & Letter C above is Connection

The same refers to the west side of South Erie Street

REFERENCES AS TO THE HOUSE CONNECTION
BETWEEN EAST OAK & TREMONT ST.


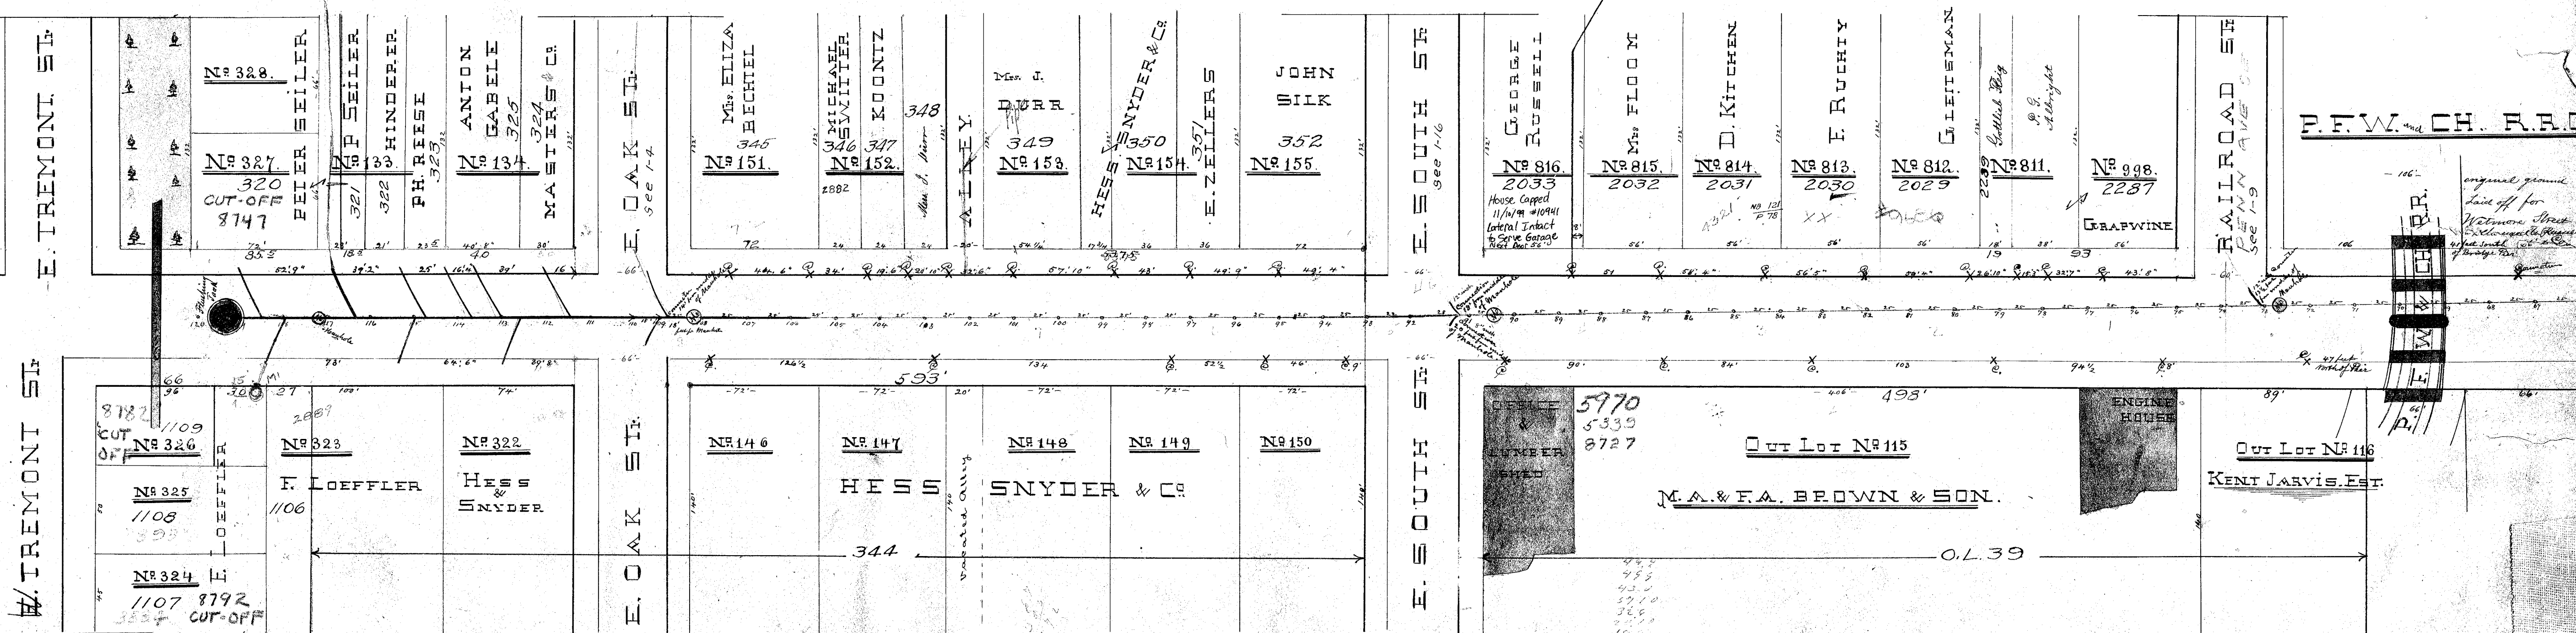
[illegible]

PLAN & PROFILE OF EAST OAK STREET SEWER BETWEEN S. ERIE & S. EAST STREET
IN SEWER DISTRICT N^o 3.

DESCRIPTION OF THE HOUSE CONNECTIONS

- House Connections South Side.
- Oliver Bechtel 1st Connection is 19 feet east from the east line of South Erie Street
 - Henry Kelly 2nd Connection is 7 1/2 feet east from the east line of the lot facing Oak St.
 - Samuel Hunt 2nd Connection is 11 1/2 feet east from the east line of South Erie Street
 - John Kirchhofer 1st Connection is 1 1/2 feet east from his west line facing Oak Street
 - Jonas Lutz 2nd Connection is 3 feet east of Manhole on alley
 - Ally Northport Connection is 4 1/2 feet east from her west line facing Oak Street
 - Samuel & Harsh Connection is 32 1/2 feet east from the west line of South Erie Street
 - Anna S. Reilly 1st Connection is 30 feet east from the east line of South Erie Street
 - School Lot 2nd Connection is 66 feet east from the east line of South Erie Street
- House Connections North Side.
- Masters & Finley 1st Connection is 54 1/2 feet east from the east line of South Erie Street
 - Frank Oliver 2nd Connection is 20 1/2 feet east from the east corner Westward
 - Wm. D. Kailey 1st Connection is 4 feet east from his west corner facing Oak Street
 - Caroline & Hardgrove 2nd Connection is 38 feet east from the east line of South Erie Street
 - Samuel & Berlin 2nd Connection is 108 feet east from the east line of S. Erie Street
 - Chas. & D. Harsh 2nd Connection is 3 feet east from her west line
 - Samuel & Berlin 1st Connection is 1 1/2 feet east from his west line
 - Chas. & D. Harsh 1st Connection is 2 1/2 feet east from his west line
 - Christina Church 1st Connection is 18 feet east from the east line of South Erie Street
 - Christina Church 2nd Connection is 86 1/2 feet east from the west line of East Street




Lateral Connections
Two laterals on Mill Street one facing south and one facing north which are right
and 2' connecting right side of Manhole 17' 8" from the east line of Oak St. to the west line of Manhole
Two laterals on Erie Street one facing south and one facing north which are 8' and 10' and
the one facing north is 10 1/2 feet east from the east line of South Erie Street
Oak Street Sewer is constructed of 18" (8") inch cast iron pipe

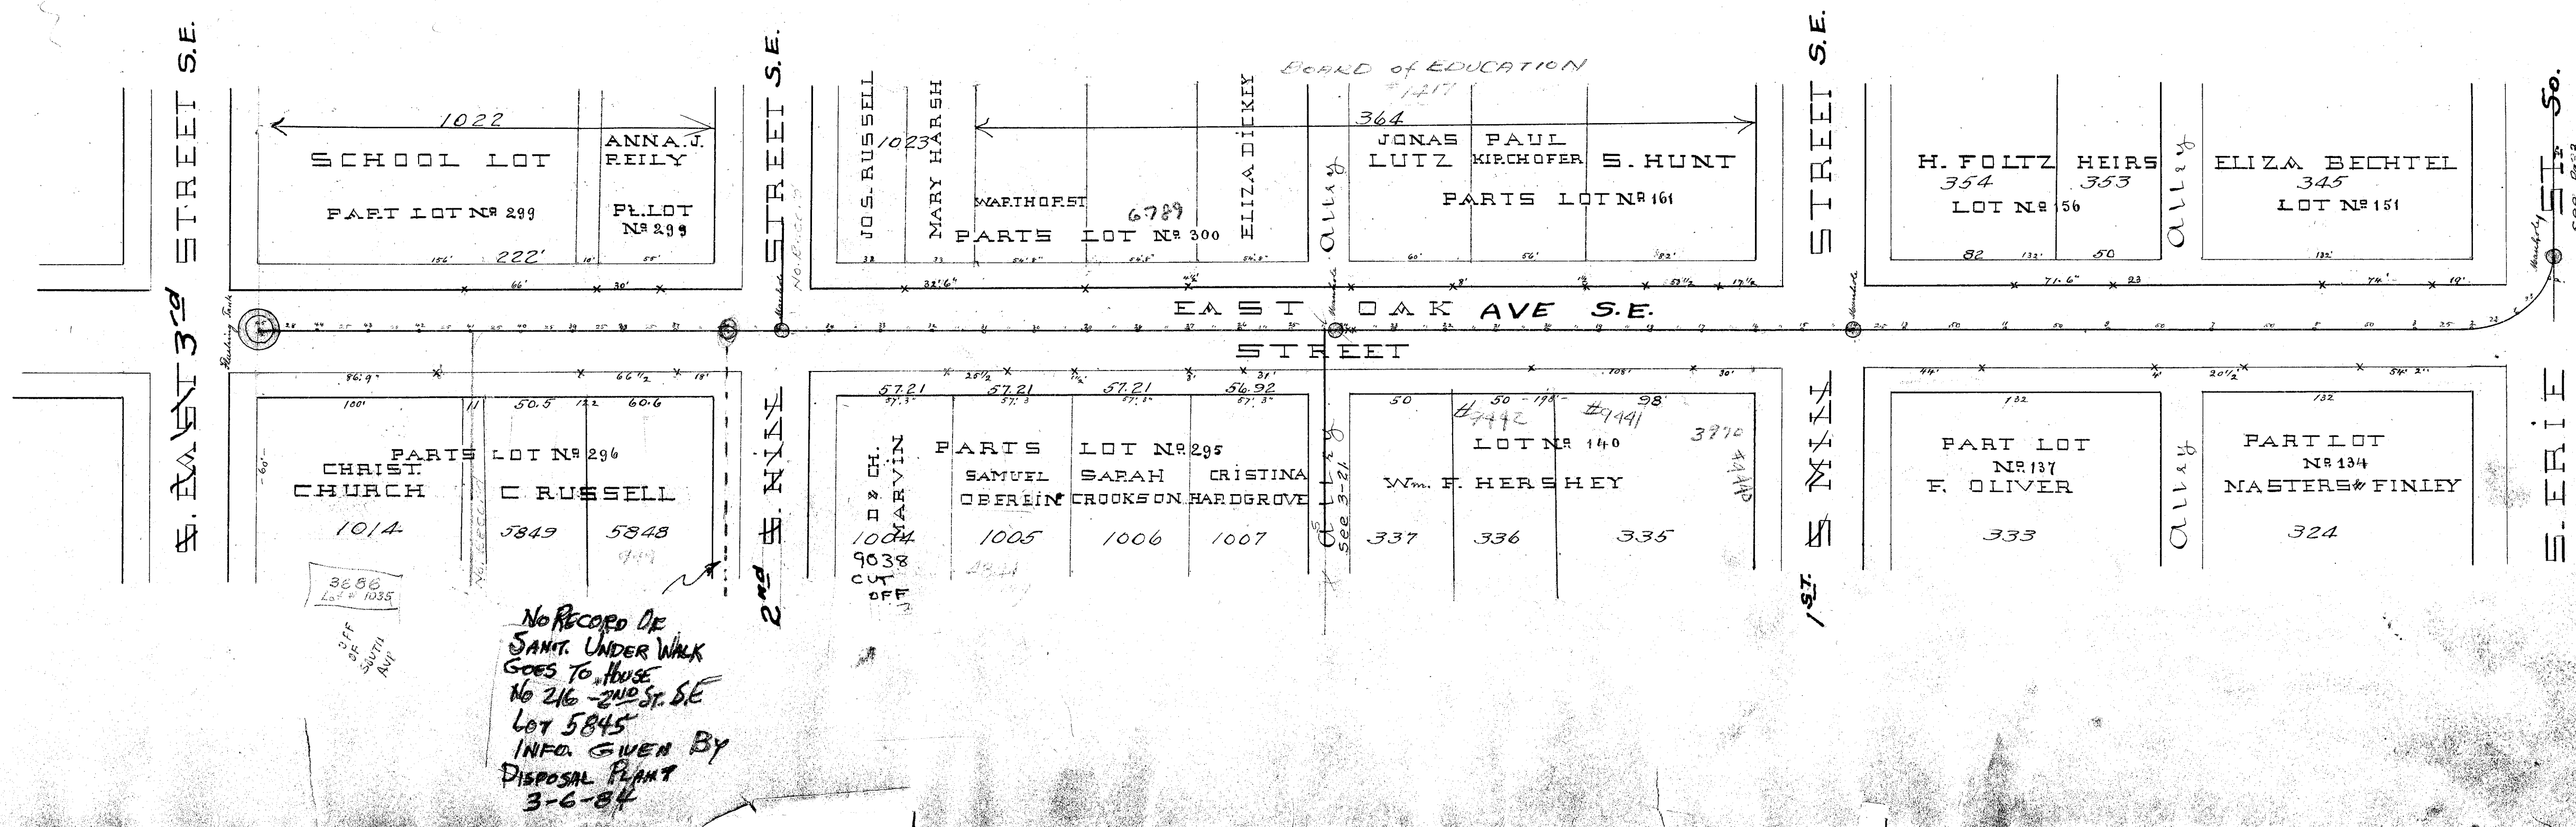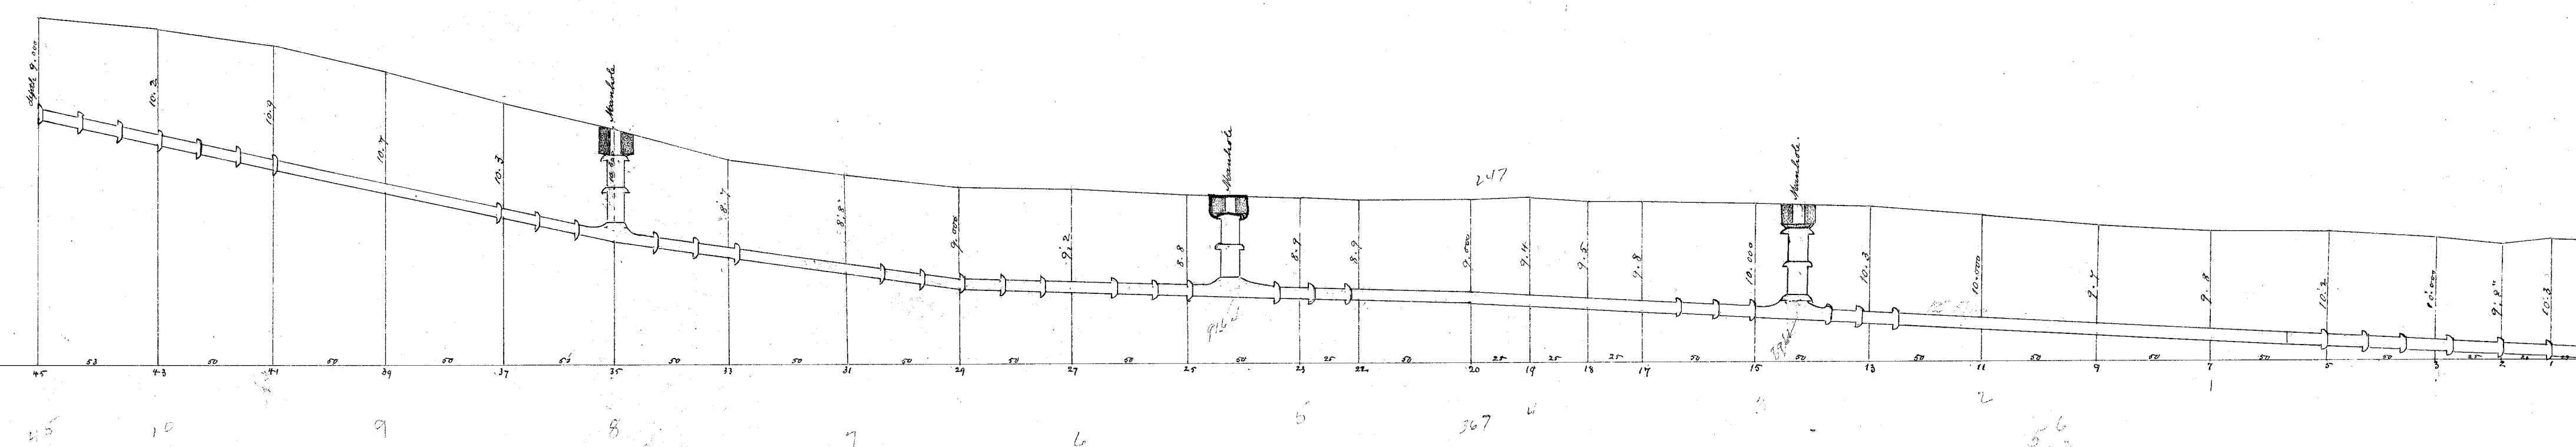

See ATTACHED
SHEET 7

PHOTO COPY

5 1/2" Trunk

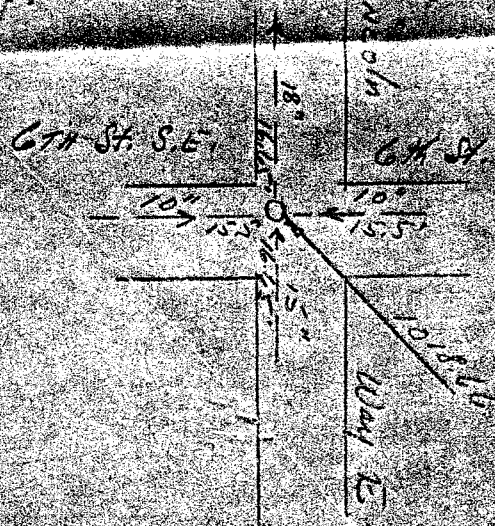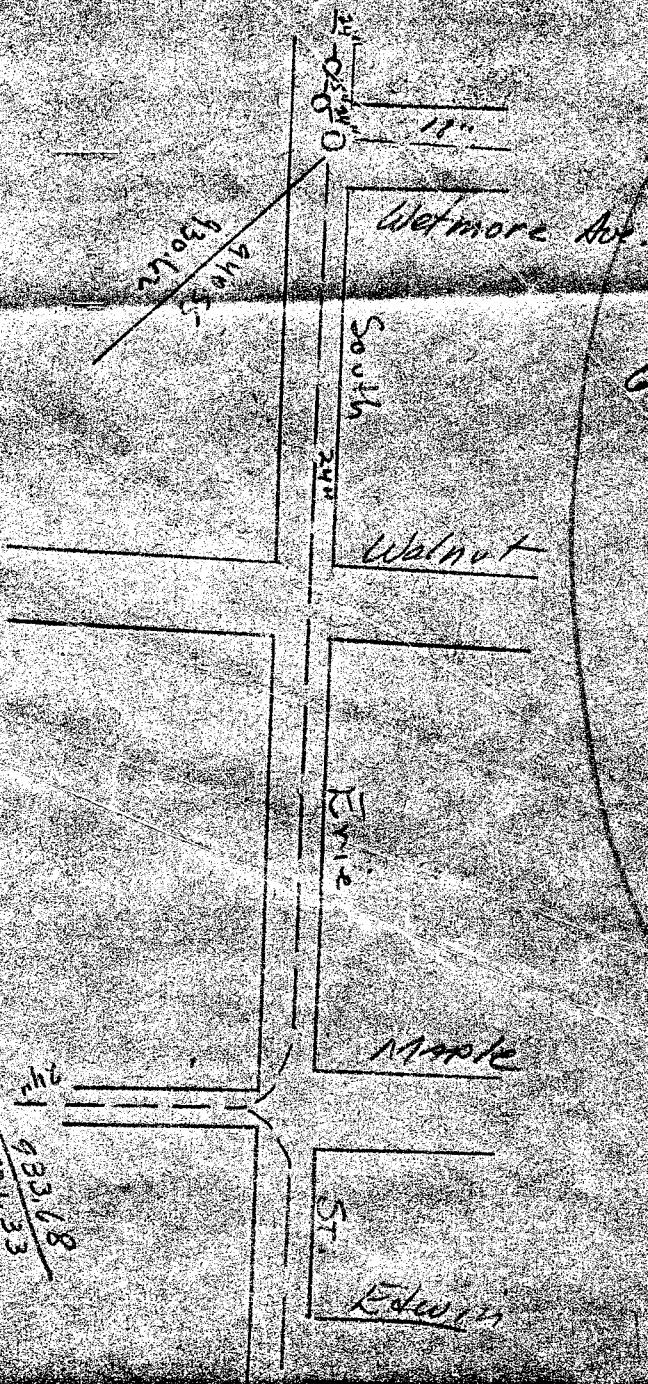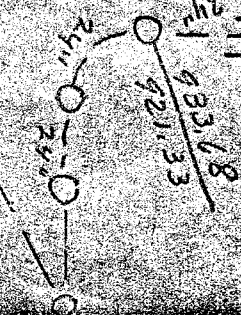

Lincoln Ave.


Barstow Connections as follows.

North side of Main Street

Burton Connections	74 1/2 feet east from the East Line of Fairport Street (only one) between Lots 57 & 58
Moengenthaler	is opposite the west Line of C. Order Street Lot 59.
Allen's Grand	is 144 1/2 feet east of the East Line of Cedar Street Lot 60
" "	is 58 feet east of his East Line Lot 61
J. D. Waller 1 st	is 54 feet east of his west Line Lot 61
" - Waller 2 nd	is 47 1/2 feet west of his East Line Lot 62
Mr. Reed	is 11 feet east of his west Line Lot 215
Mr. Brown 1 st	is 5 feet east of the west Line of Lot 216
" 2 nd	is 57 1/2 feet east of the west Line of Lot 216
Anna Rice	is 44 1/2 feet east of the west Line of Lot 217
M. Neider	is 11 feet west of the west Line of his Lot part 218
Altman	is 18 inches east of his west Line (of his Lot part 218
Fr. Cove	is 19 feet east from his west Line of part 219 answering both buildings of [unclear]
W. B. Blumhagen	is 18 inches east from his west Line of Lot 220
Mr. Clay	is 19 1/2 feet west of the East Line of Lot 220
W. C. Lang 1 st	is 14 1/2 feet east from his West Line of Lot 221
" 2 nd	is 29 feet west from the East Line of Lot 220

[illegible]



PLAN & PROFILE OF E. MAIN STREET SEWER. DEPTH & INCLINATION OF THE SAME
AND THE DIFFERENT HOUSE CONNECTIONS.

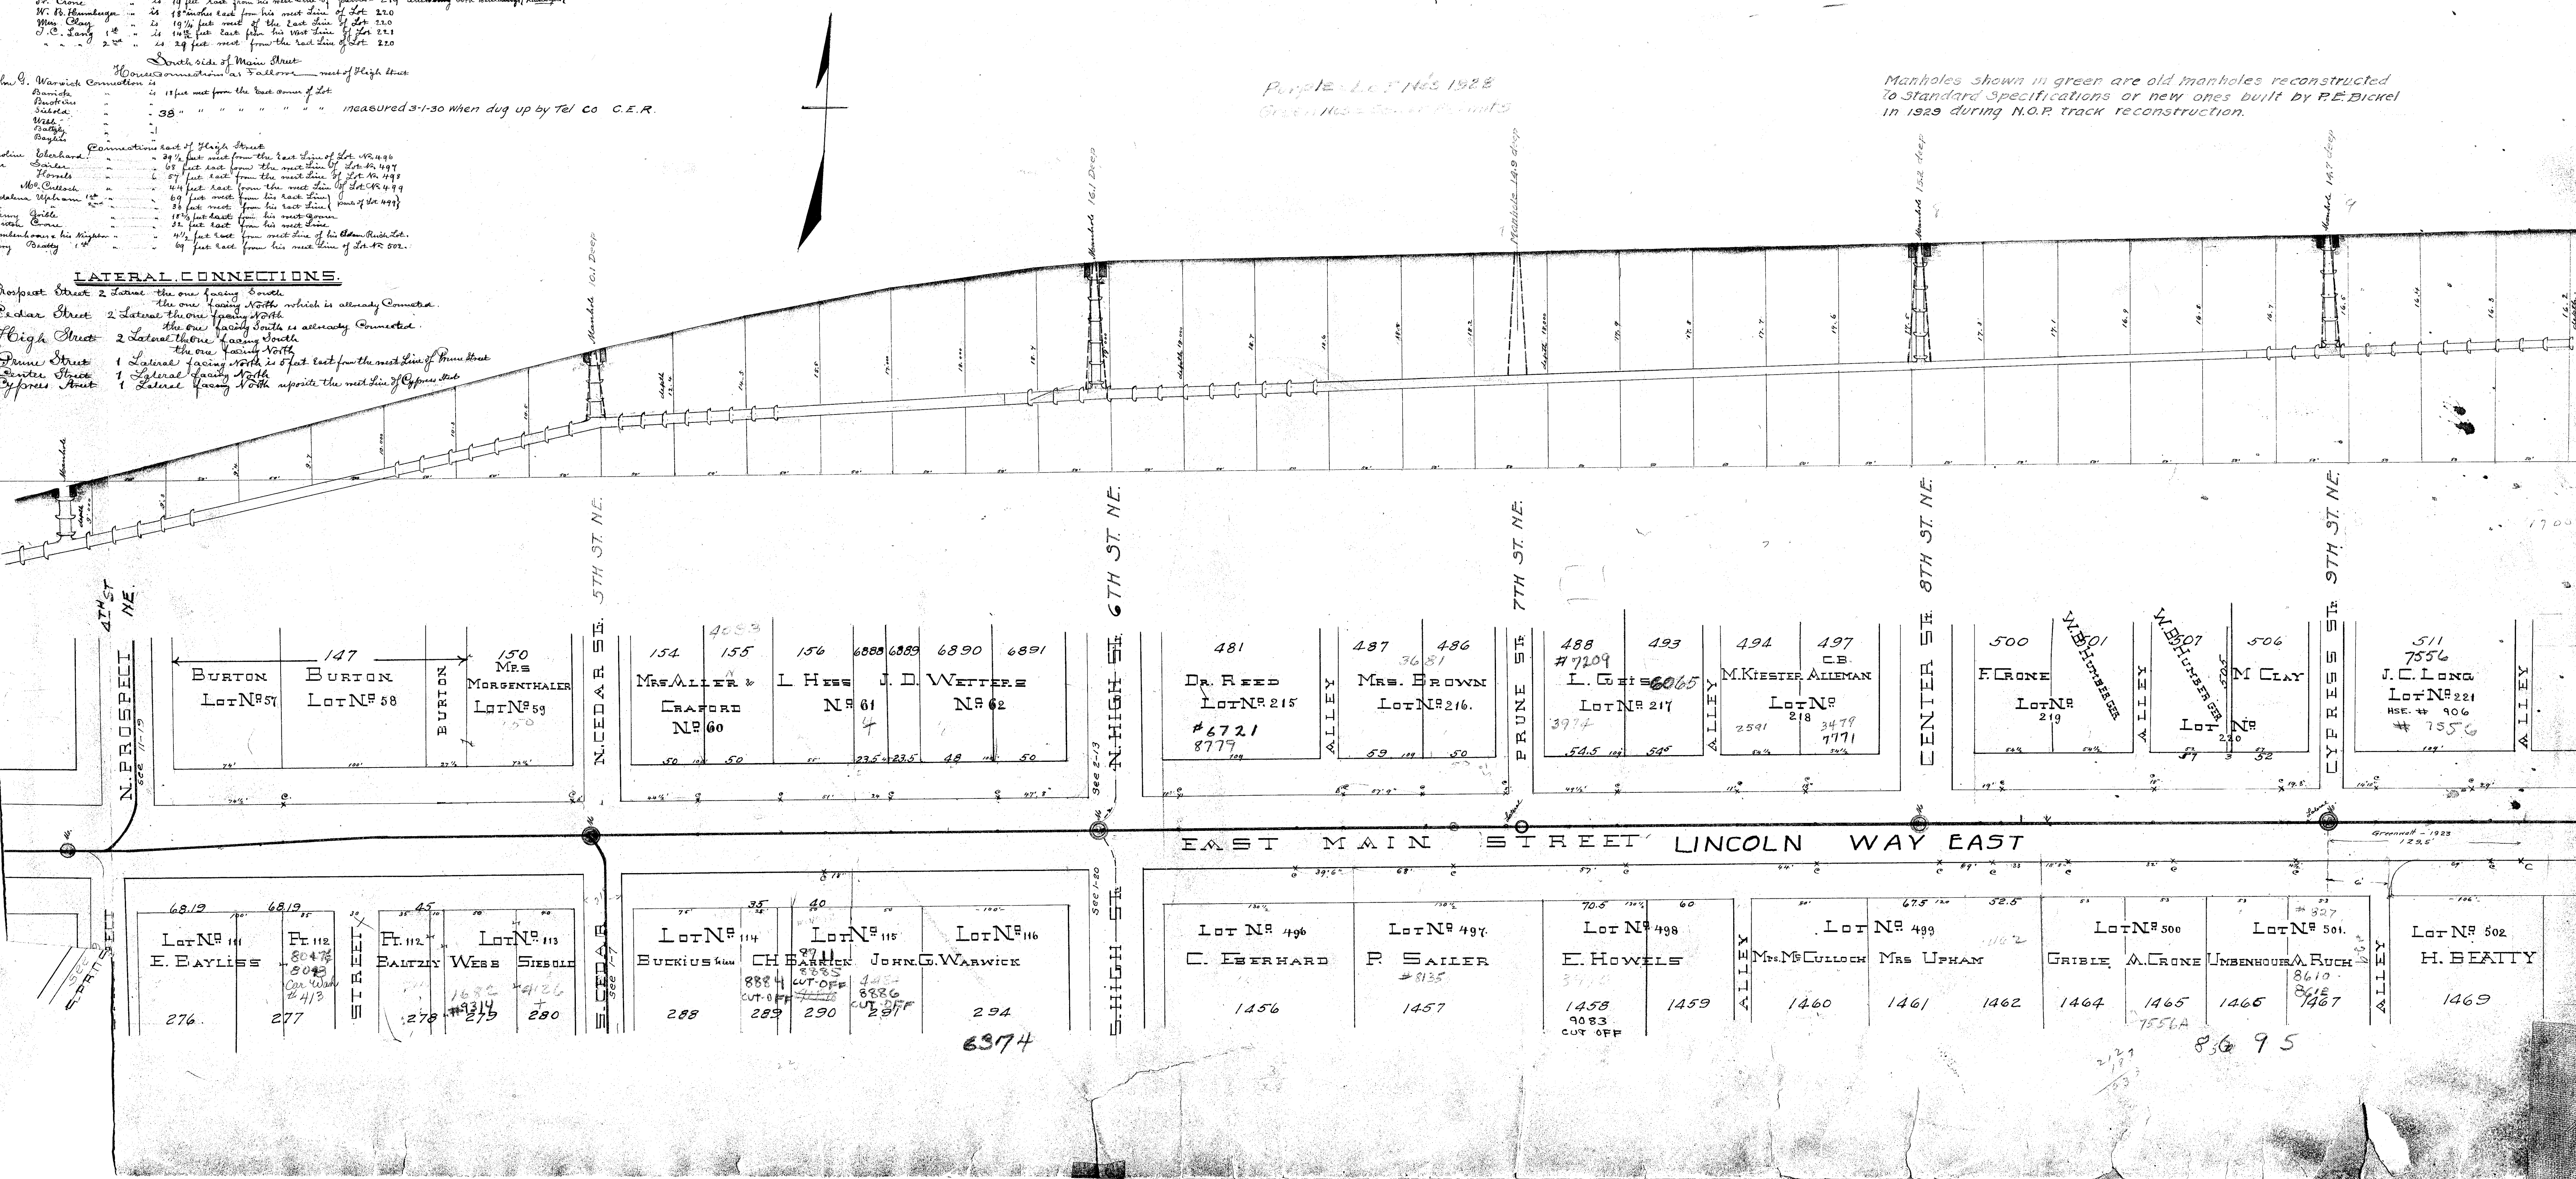

Purple Leaf Hoes 1928
 Green Hoes & Flower Plants

Manholes shown in green are old manholes reconstructed to Standard Specifications or new ones built by P.E. Bickel in 1929 during N.O.P. track reconstruction.

PLAN & PROFILE OF S. CEDAR STREET SEWER

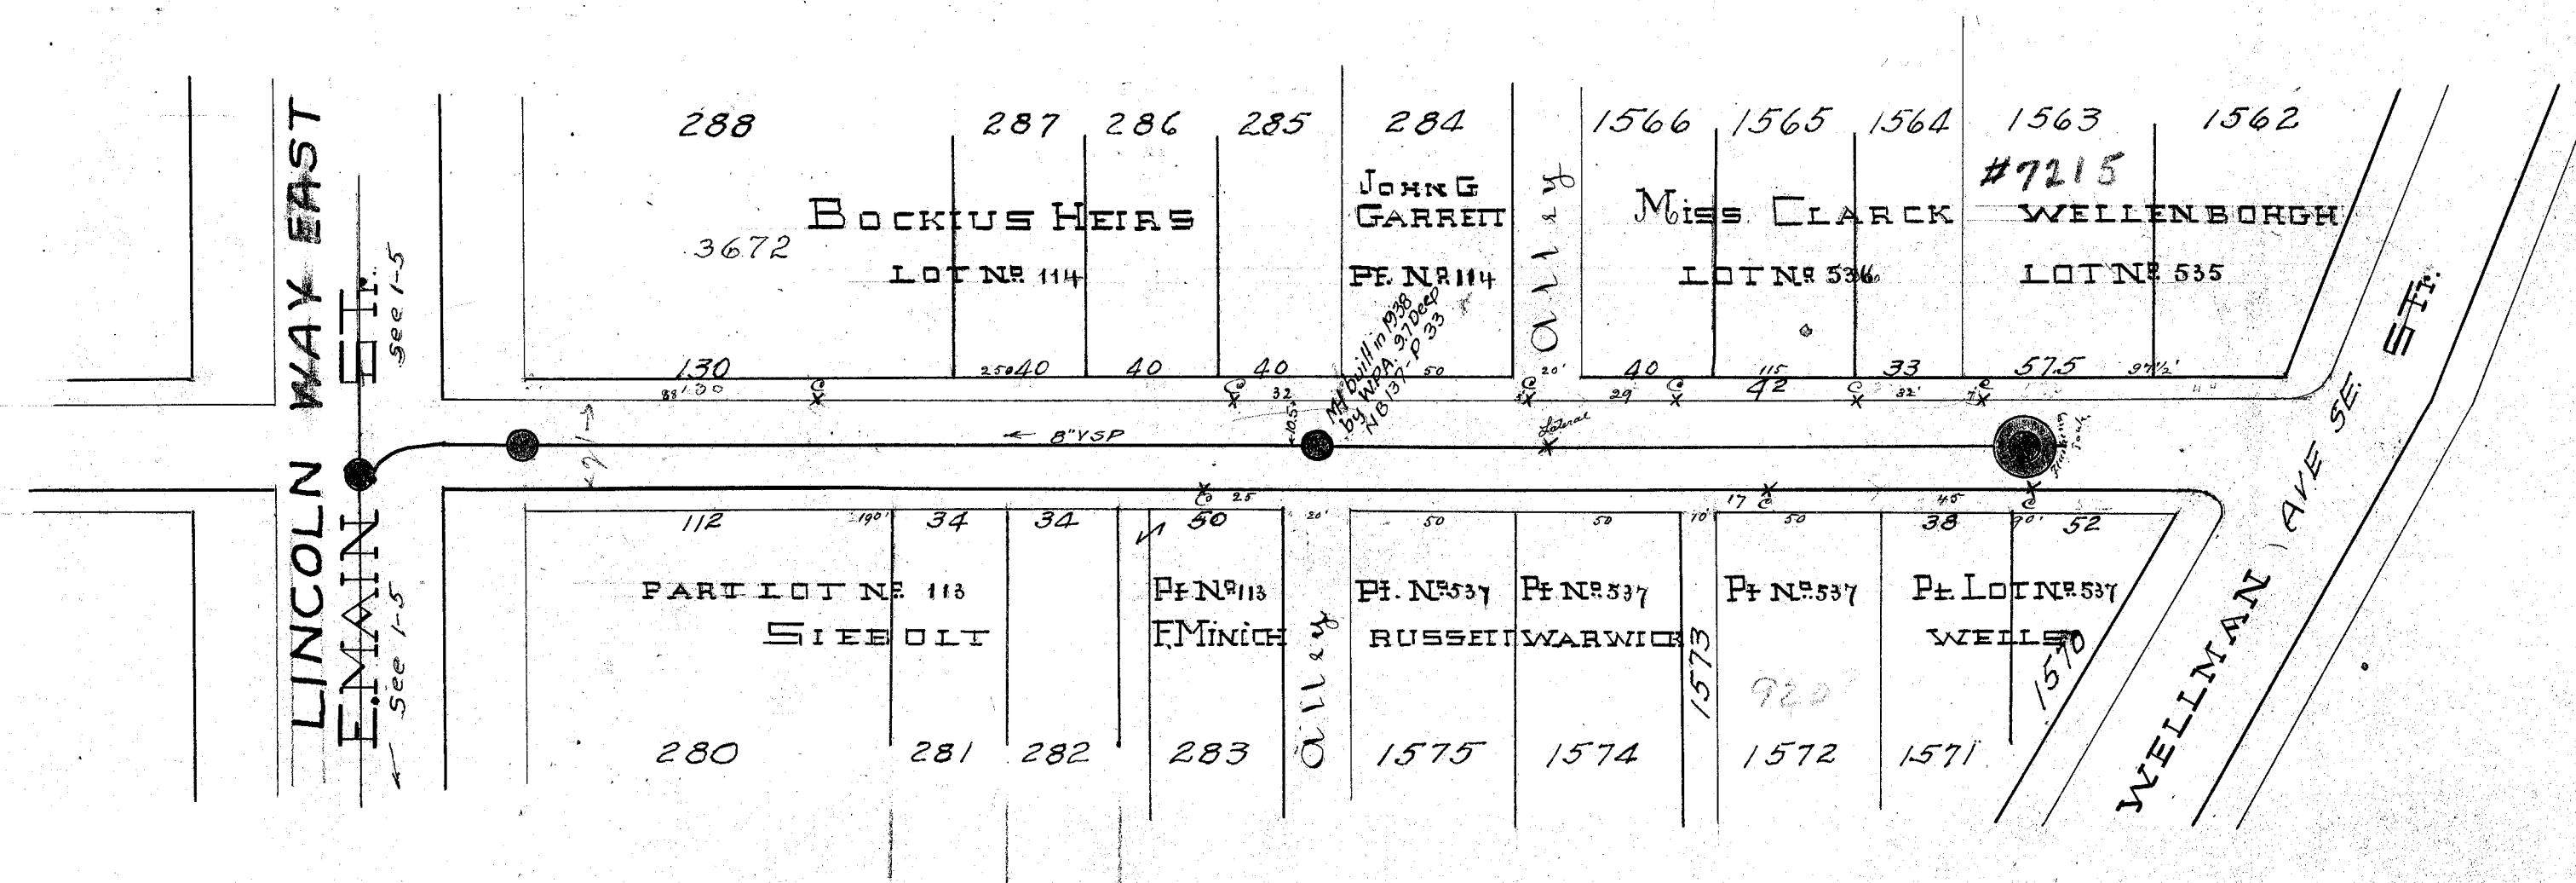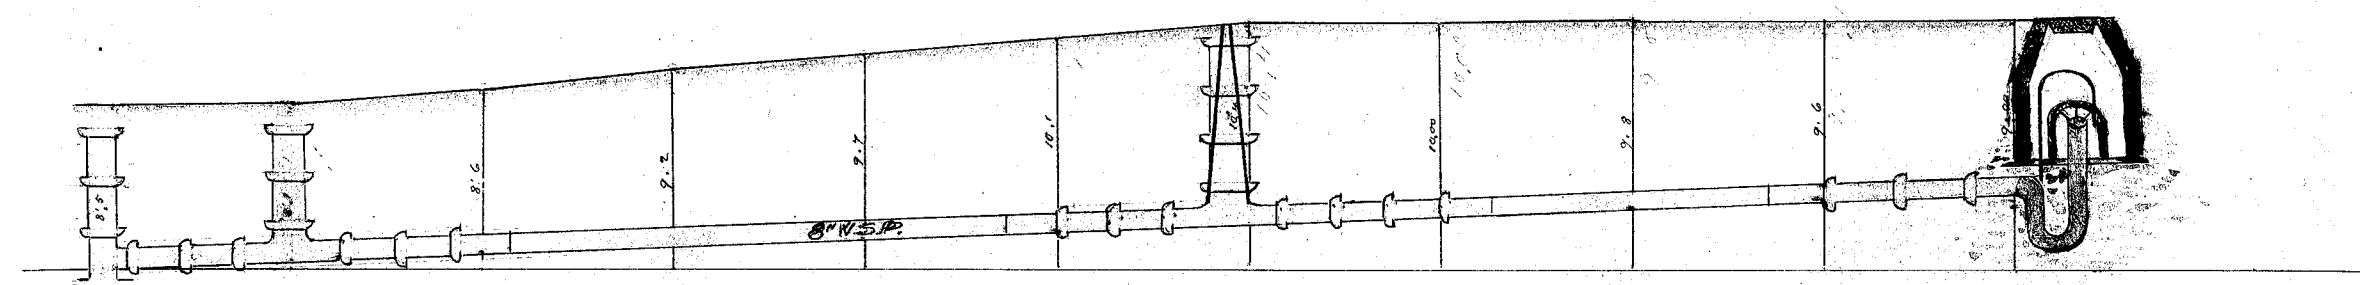

NOTES OF THE LOCATIONS OF HOUSE & LATERAL CONNECTIONS.

House connections on West side of Cedar Street Fifth St SE

Buckhins place " " " " 8 ft south from Main Street " "

Spencer place " " " " 33 ft south from Main Street " "

John C. Gwynett " " " " 5 ft south of its South west Corner. Roadway " "

Myrle Clark " " " " 2 ft south from the North west Corner of 1st St. 114

Williamough " " " " 7 ft south from the South west Corner of 1st St. 936

House connections on West side of Cedar Street Fifth St SE

Selkirk has no connection on west side of Cedar Street

Frank Smith " " " " 25 ft south from Main St. Council Alley 1st St. 113

Wardell " " " " " " " " 1st St. 16, 537

Wardell " " " " " " " " 1st St. 16, 537

Waller " " " " 17 ft south from the South west Corner of Alley 1st St. 537

" " " " 2 ft south " " " " " " " " 1st Alley " 16, 537

One Lateral Connection facing East in middle of Alley between Garrett & Clark Lot

Purple = Lot Nos 1328
 Green = Senior Permits

SCALE. HOR. 50' = 1. INCH. VERT 10' = 1"

January 16th 1893

PLAN & PROFILE OF A SEWER ON S. ERIE
BETWEEN TREMONT & EAST OAK ST.
EXTENDED & CONNECTED AS SHOWN ON PLAN
SEWER DISTRICT NO. 3

EXTENSION OF S. ERIE ST.
SEWER BETWEEN OAK & TREMONT
IN SEWER DISTRICT NO. 3

NOTES





LOCATION OF HOUSE LATERAL CONNECTIONS
ON S. ERIE BETWEEN E. CHARLES E. TREMONT
HOUSE CONNECTIONS

- EAST SIDE**
1. Mrs. J. Wagner Connection is 2 1/2 feet south from the North west corner of the lot.
 2. Messrs. Loeffler Connection is 2 1/2 feet south from the N.W. corner of the lot.
 3. Mrs. Jones Connection is 30 1/2 feet south of the N.W. corner of the lot.
 4. Mrs. Jones Connection is 17 feet south of the N.W. corner of the lot.
 5. Mrs. Jones Connection is 10 feet north of the S.W. corner of the lot.
 6. Mrs. Jones Connection is 9 feet at the curb line.

- WEST SIDE**
- City Landing place no connection
Sworm & Willemans Connection is 4 1/2 feet south from the N. E. corner of the lot
Russell Co. Connection is 4 1/2 feet north from the south lot corner
depth of connection 9 1/2 feet at the curb line

LATERAL CONNECTIONS

Two lateral connections of 8" pipes on East Tremont in middle of street one facing East and one facing West depth 10 feet each at the middle intersection of the lot and west line of Erie with Tremont Street

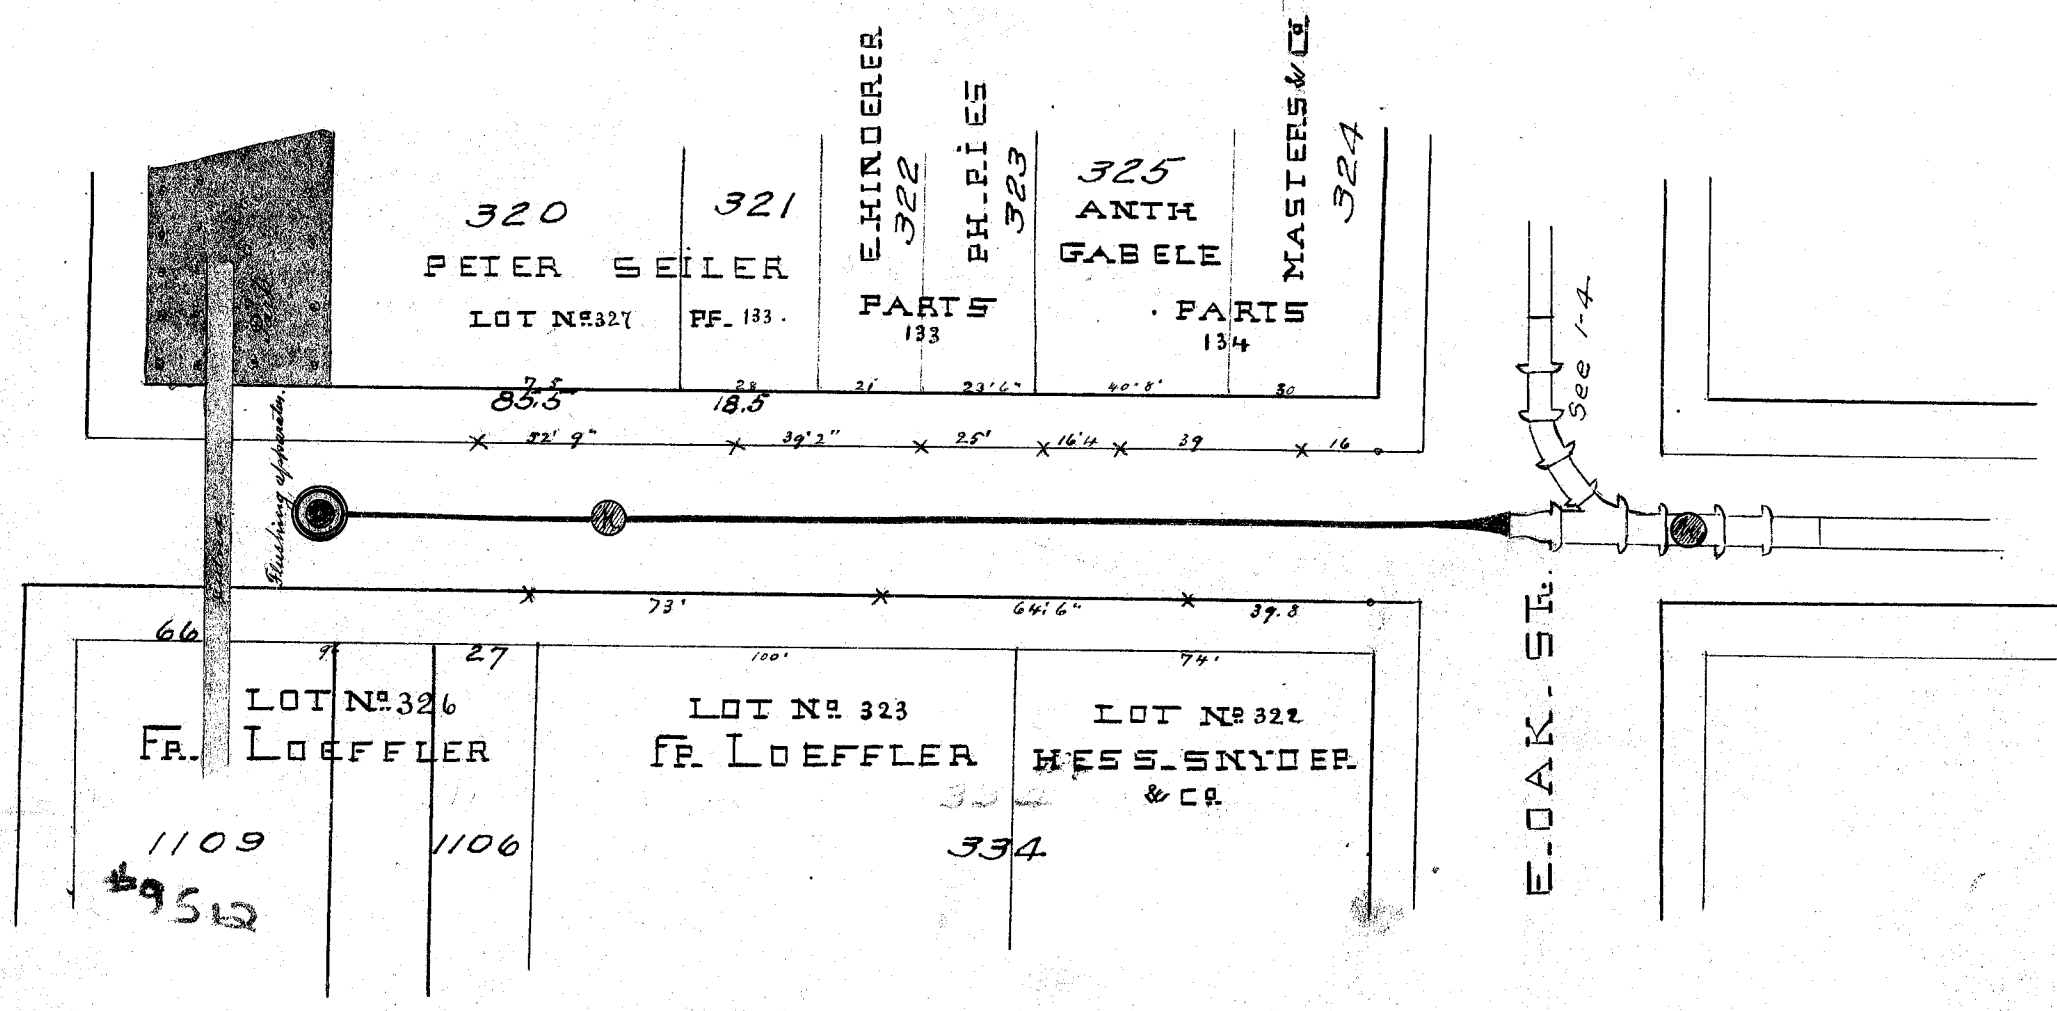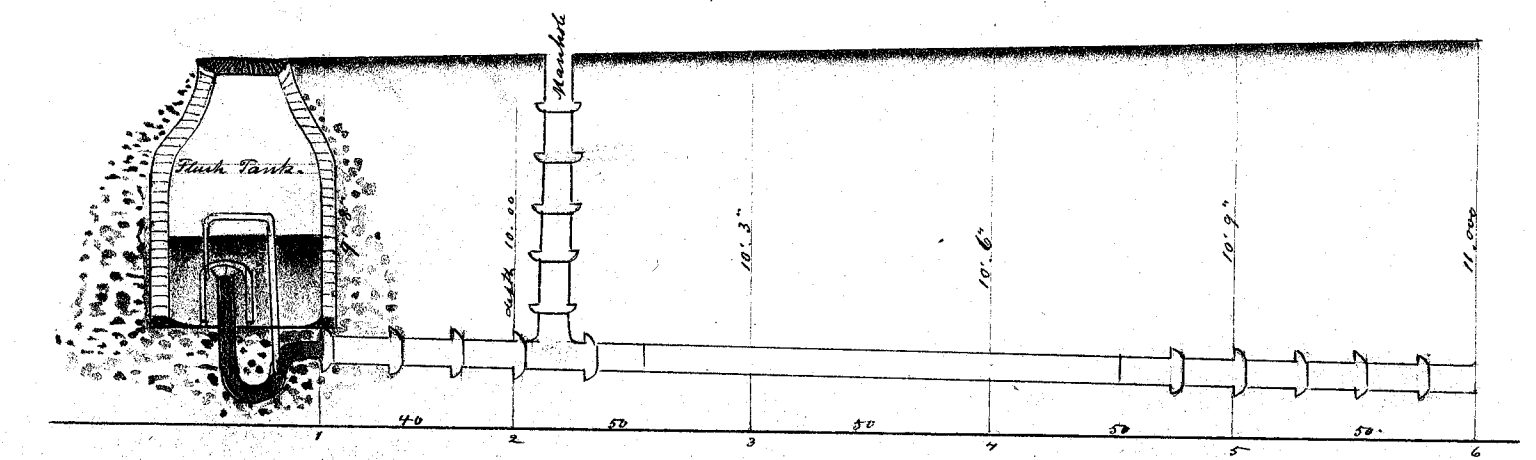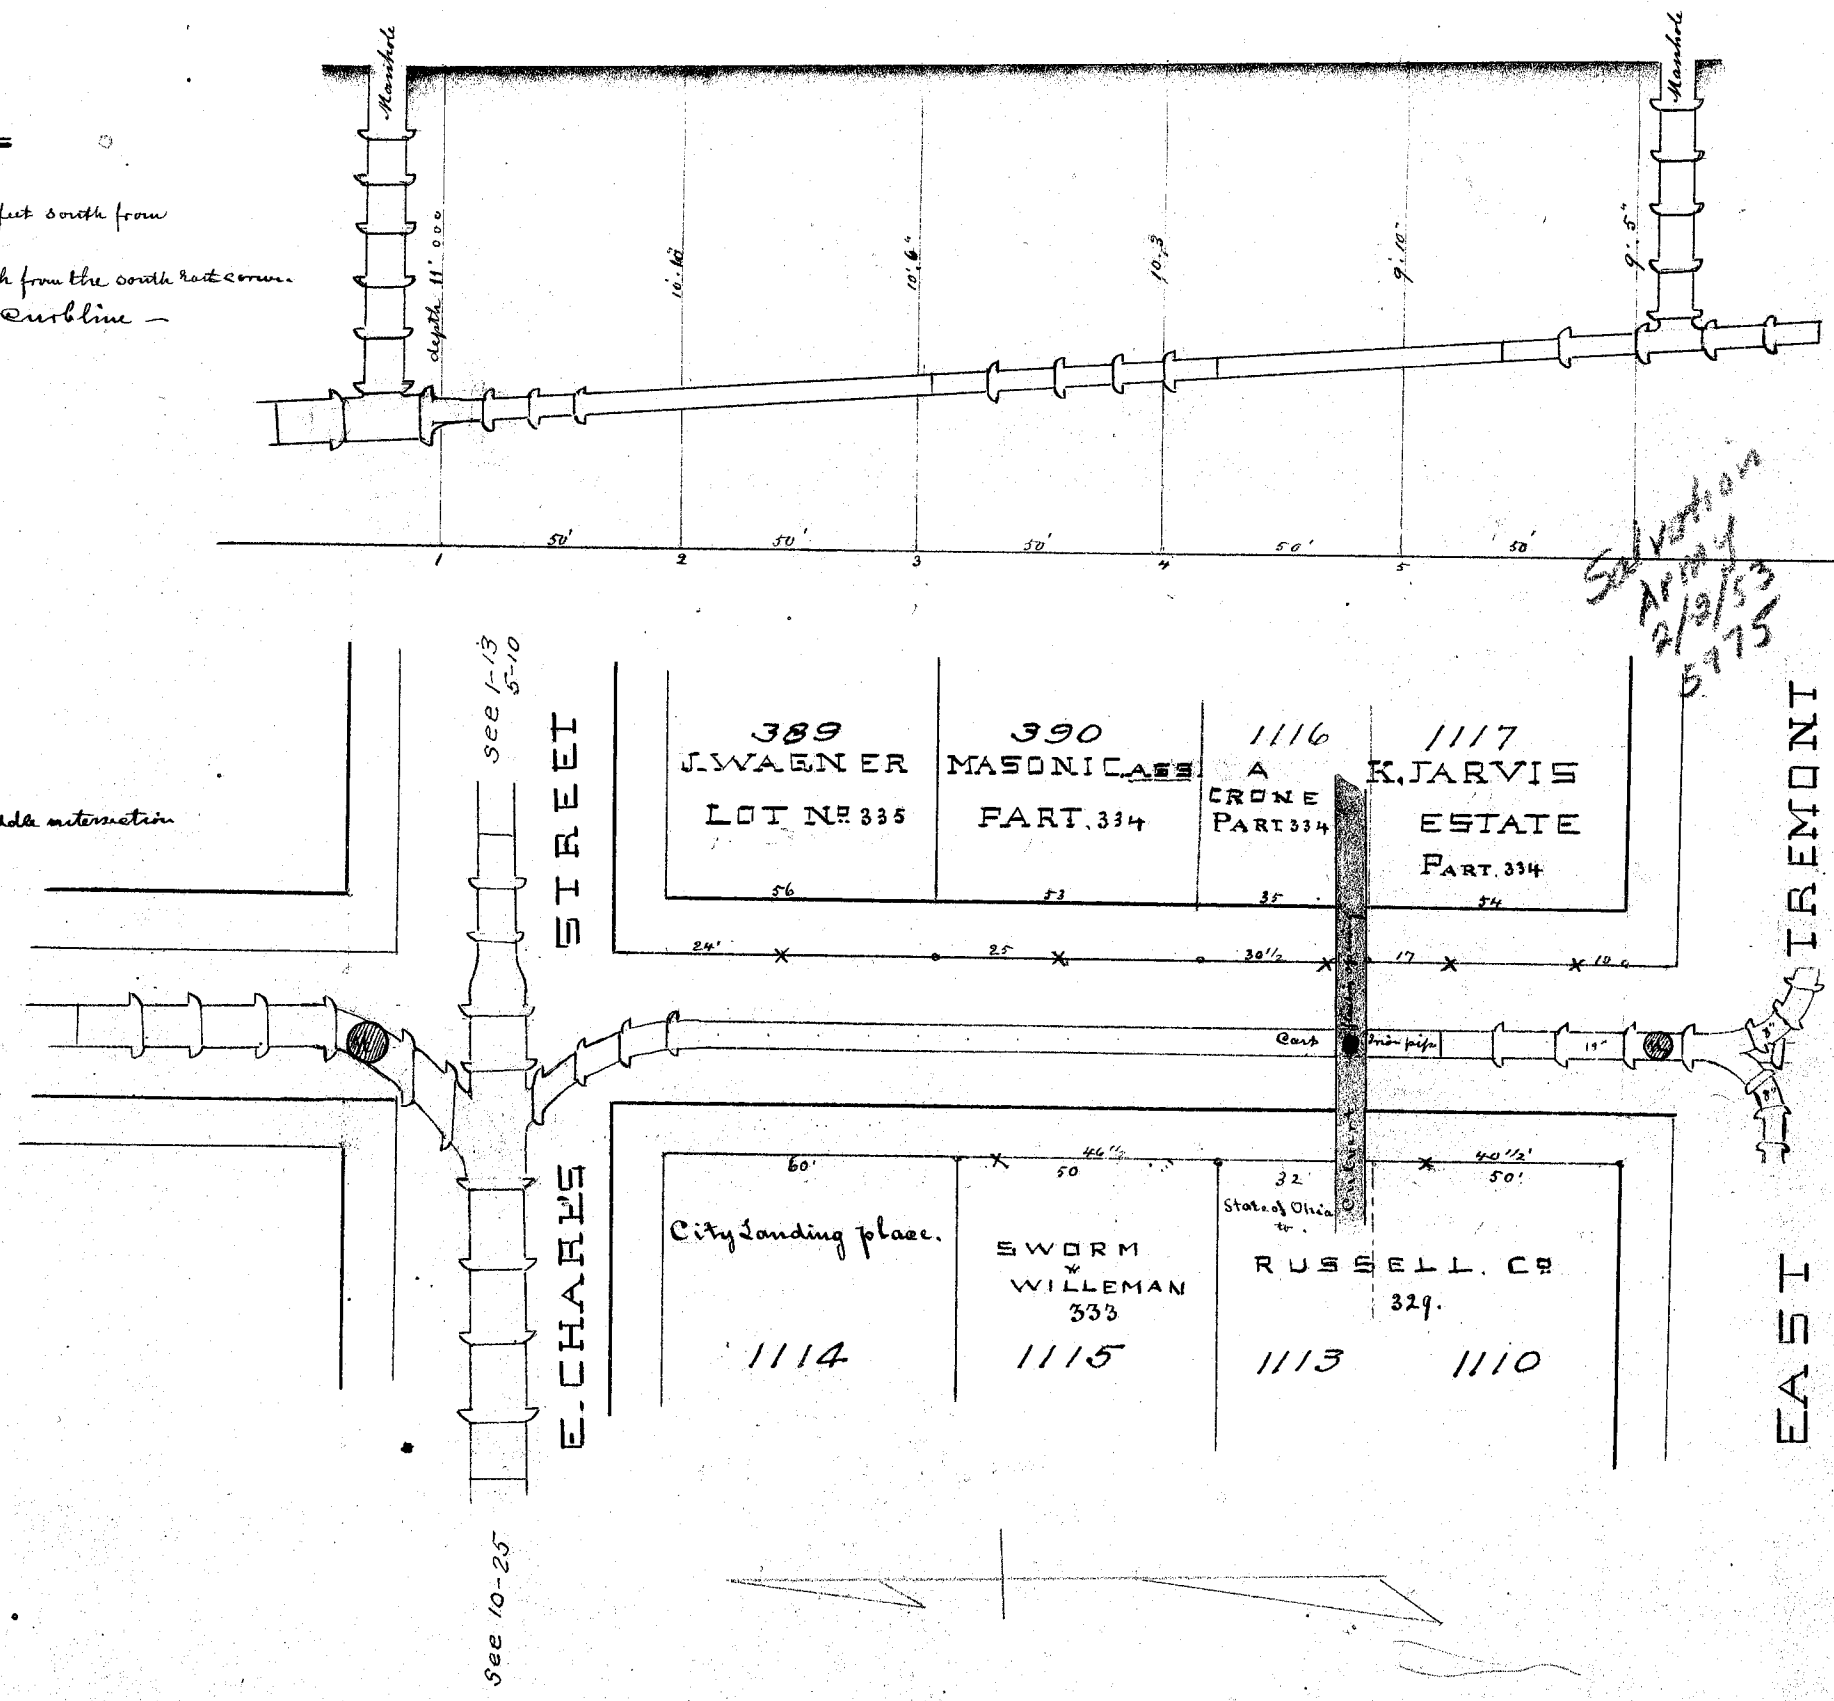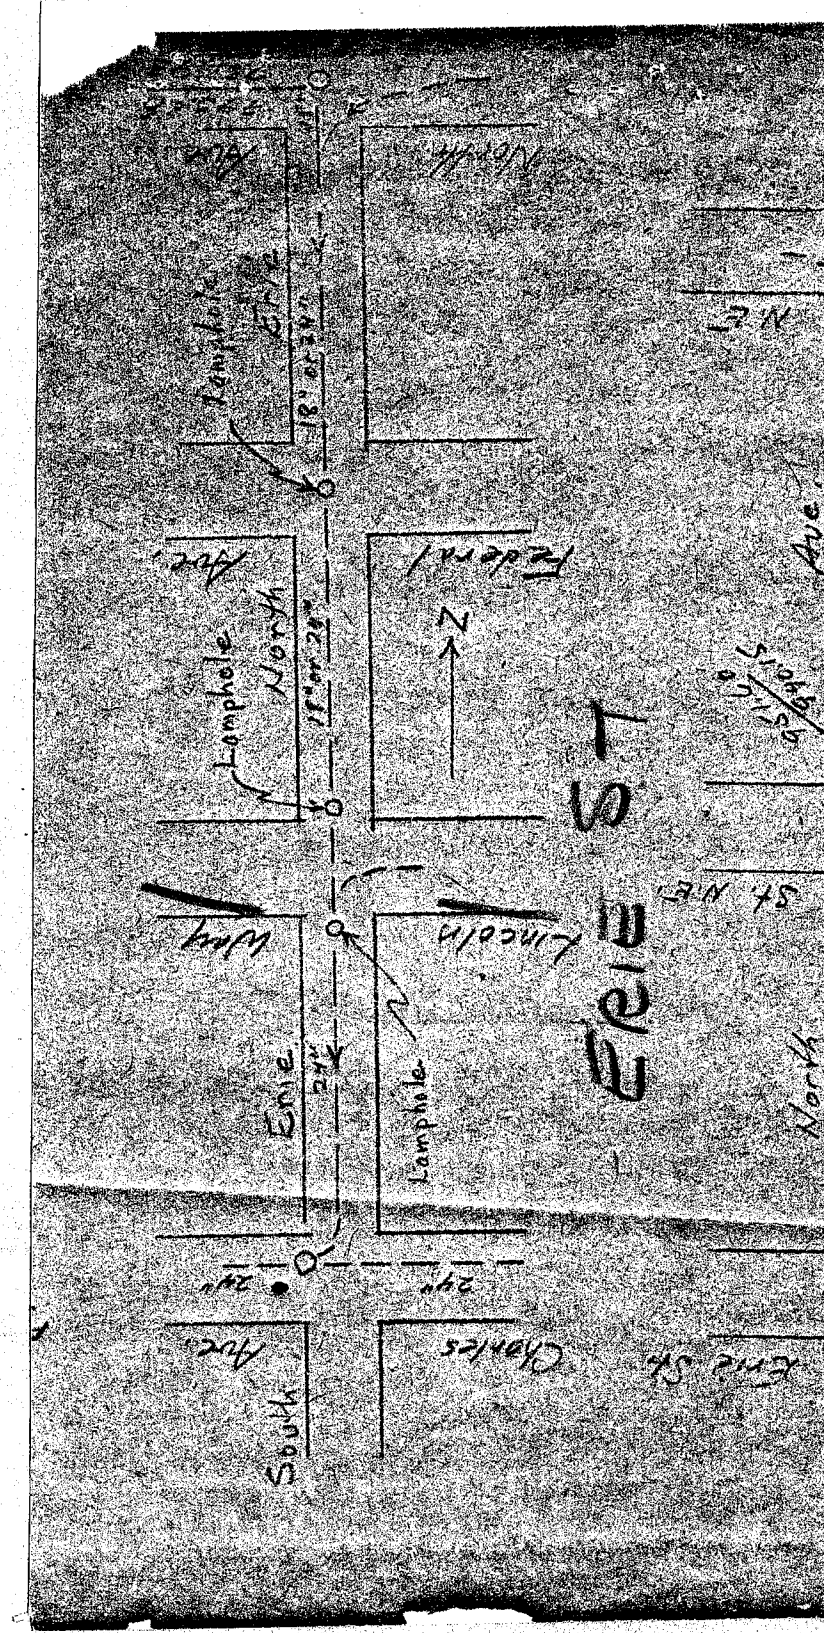

NOTES OF THE LOCATIONS OF
HOUSE CONNECTIONS

EAST SIDE

- Messrs. Seiler Connection is 16 feet North of the S.W. corner
Messrs. Seiler Connection is 16 feet North of the S.W. corner
Messrs. Seiler Connection is 16 feet North of the S.W. corner
WEST SIDE

- Messrs. Seiler Connection is 16 feet North of the S.W. corner
Messrs. Seiler Connection is 16 feet North of the S.W. corner
Messrs. Seiler Connection is 16 feet North of the S.W. corner
PLAN OF LOT NOS 1100
GIVEN NOS 2 SEWER DISTRICT



Plan of Seiler
City Engineer, 1893.

39
38
37
NOTES OF THE LOCATIONS OF HOUSE CONNECTIONS
North Side of Street

Wm. King Connection is 34' 8" west from the South West Corner of Mill Street -
H. Clements 1st Connection is 30' 2" Dist from King Connection
W. Clements 2nd Connection is 27' 6" - - - - - H. Clements 1st Connection
David Miller 1st Connection is 27' 6" - - - - - H. Clements 2nd Connection
Miller 2nd Connection is 36' 6" - - - - - from the South West Corner of Alley
Mrs. Kessler Connection is 16' 2" - - - - - from Miller 2nd Connection
Mrs. Walter Connection is 32' 7" - - - - - west from Mrs. Kessler Connection

PENNA AVE SE.
PLAN & PROFILE OF RAILROAD STREET
SEWER BETWEEN MILL STREET
IN SEWER DIST. NO. 3

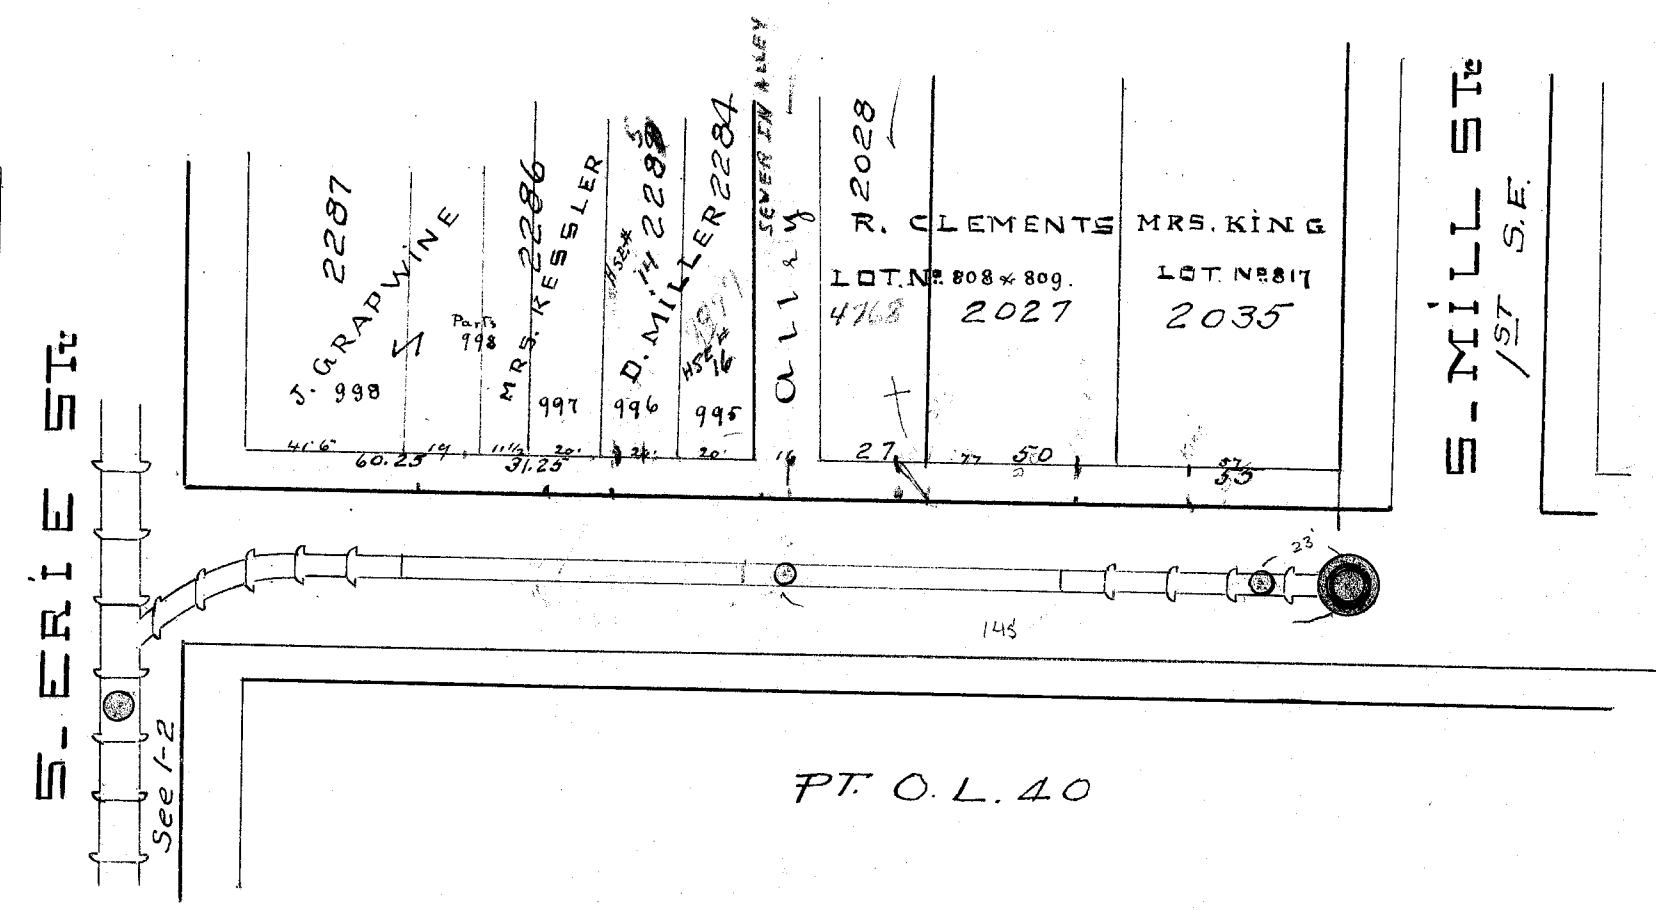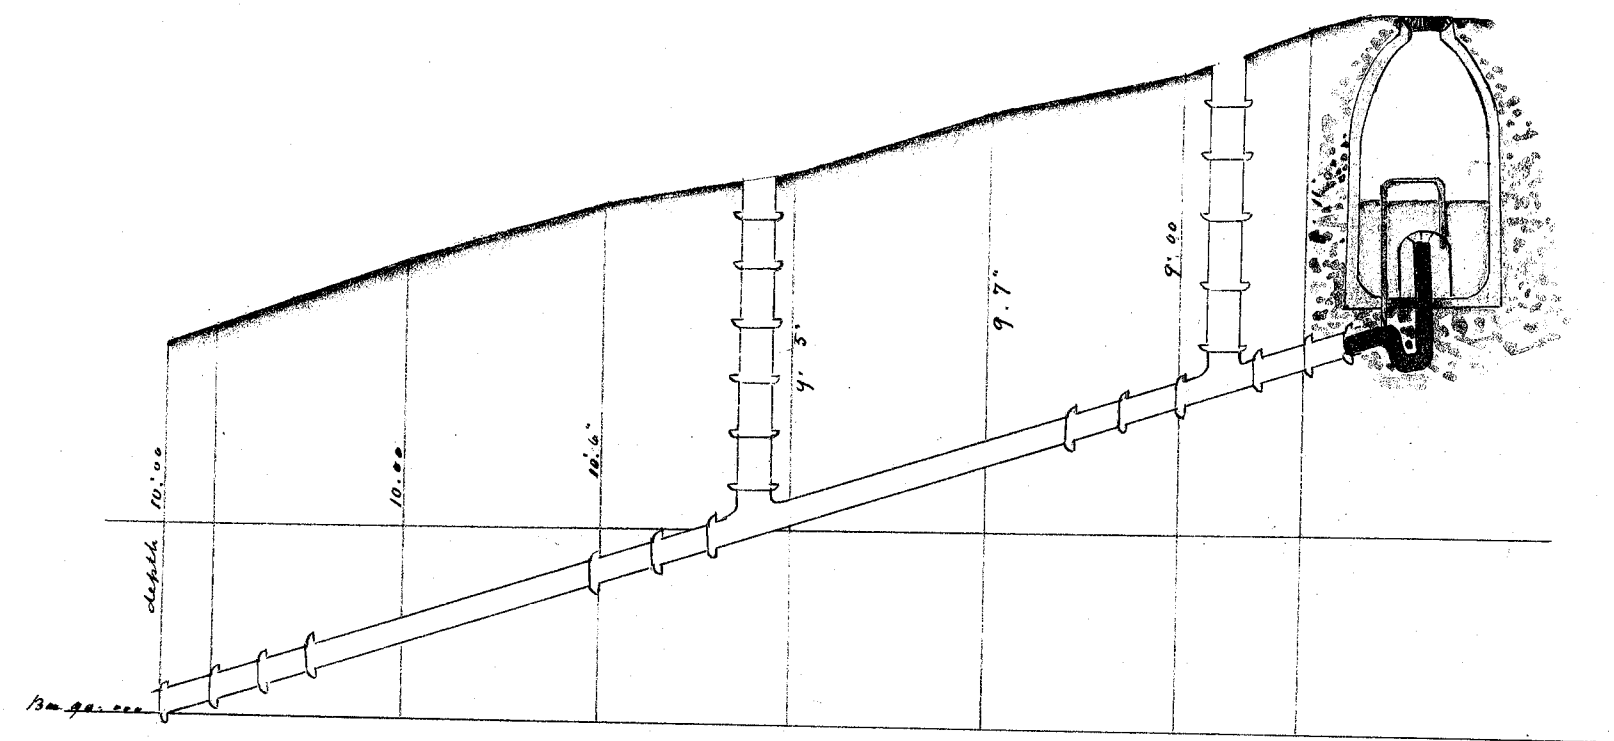


Scale 30' to 1" Hor. 5' to 1" Vert.
D. A. Miller City Engineer
January 1893

PLAN & PROFILE OF THE EXTENSION OF PROSPECT
STREET SEWER BETWEEN THE FLUSHING
TANK & SPRING ALLEY IN SEWER DIST. NO. ONE


NOTES OF THE LOCATION OF HOUSE CONNECTIONS
EAST SIDE WEST SIDE

R. H. Folger Connection is 20 feet north from his south line street end
R. H. Folger 2nd Connection is 6 1/2 feet north from his north line street end
Mrs. Brown Connection is 11 1/2 feet North of the South Corner of Lot
Gale Connection at end of sewer.
C. B. Lightly Connection is
C. B. Lightly 1st Connection is 42 feet North of his south
Lot Line 7 1/2 feet deep at Carblin
Humbinger Connection is 3 feet South of his north
Line 6 1/2 feet deep at Carblin
Frank Christen Connection is 2 feet South of the
South Line between both Rows 3 feet deep at
Carblin

LATERAL CONNECTION
in middle line of Chestnut Street brought up to the East Line

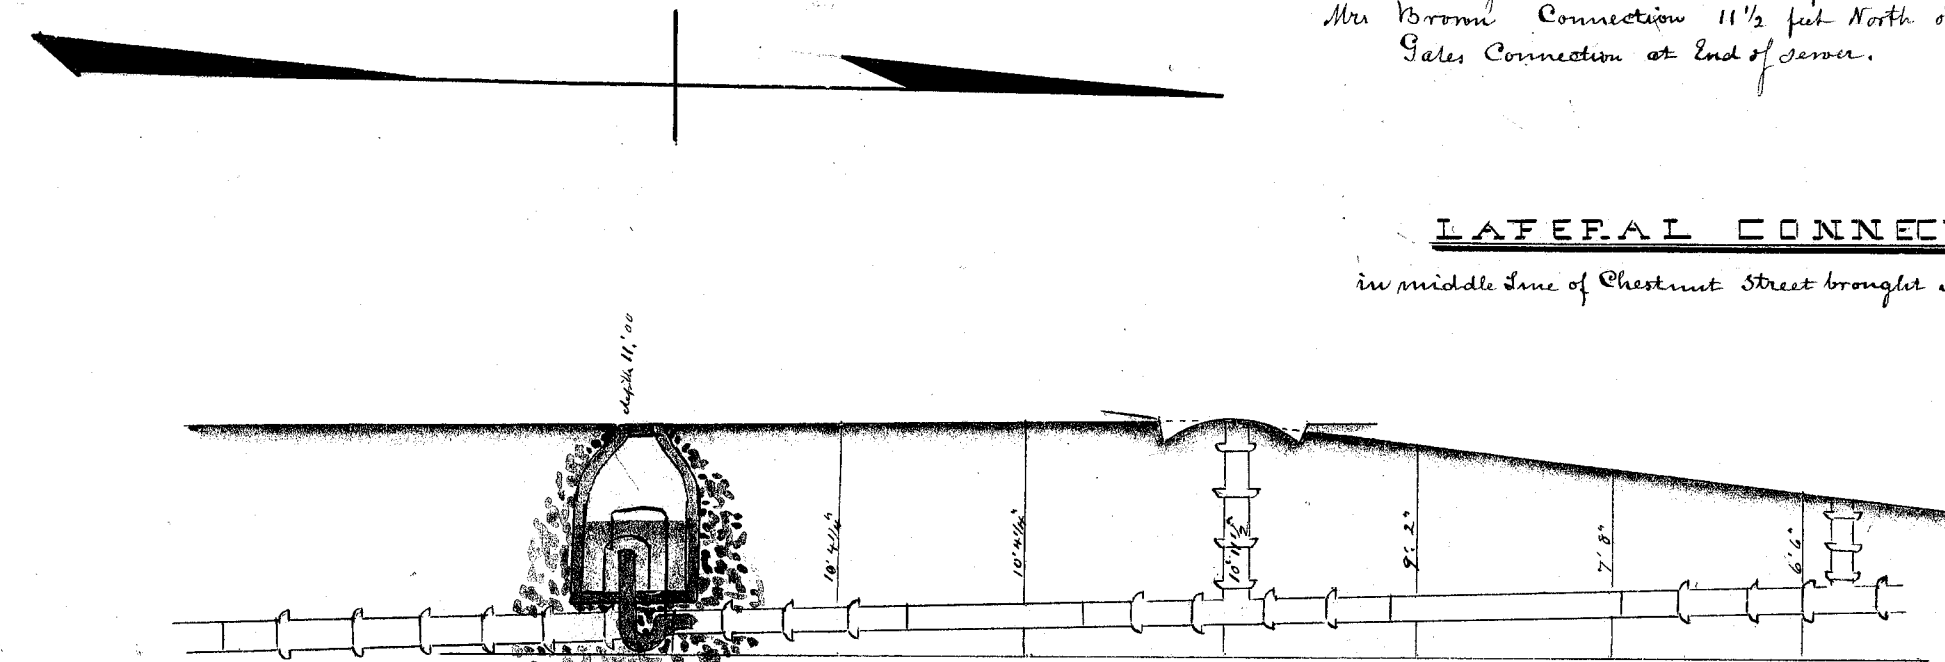

Scale Hor 50' to 1" Vert 10' to 1"
D. A. Miller City Engineer
January 1893

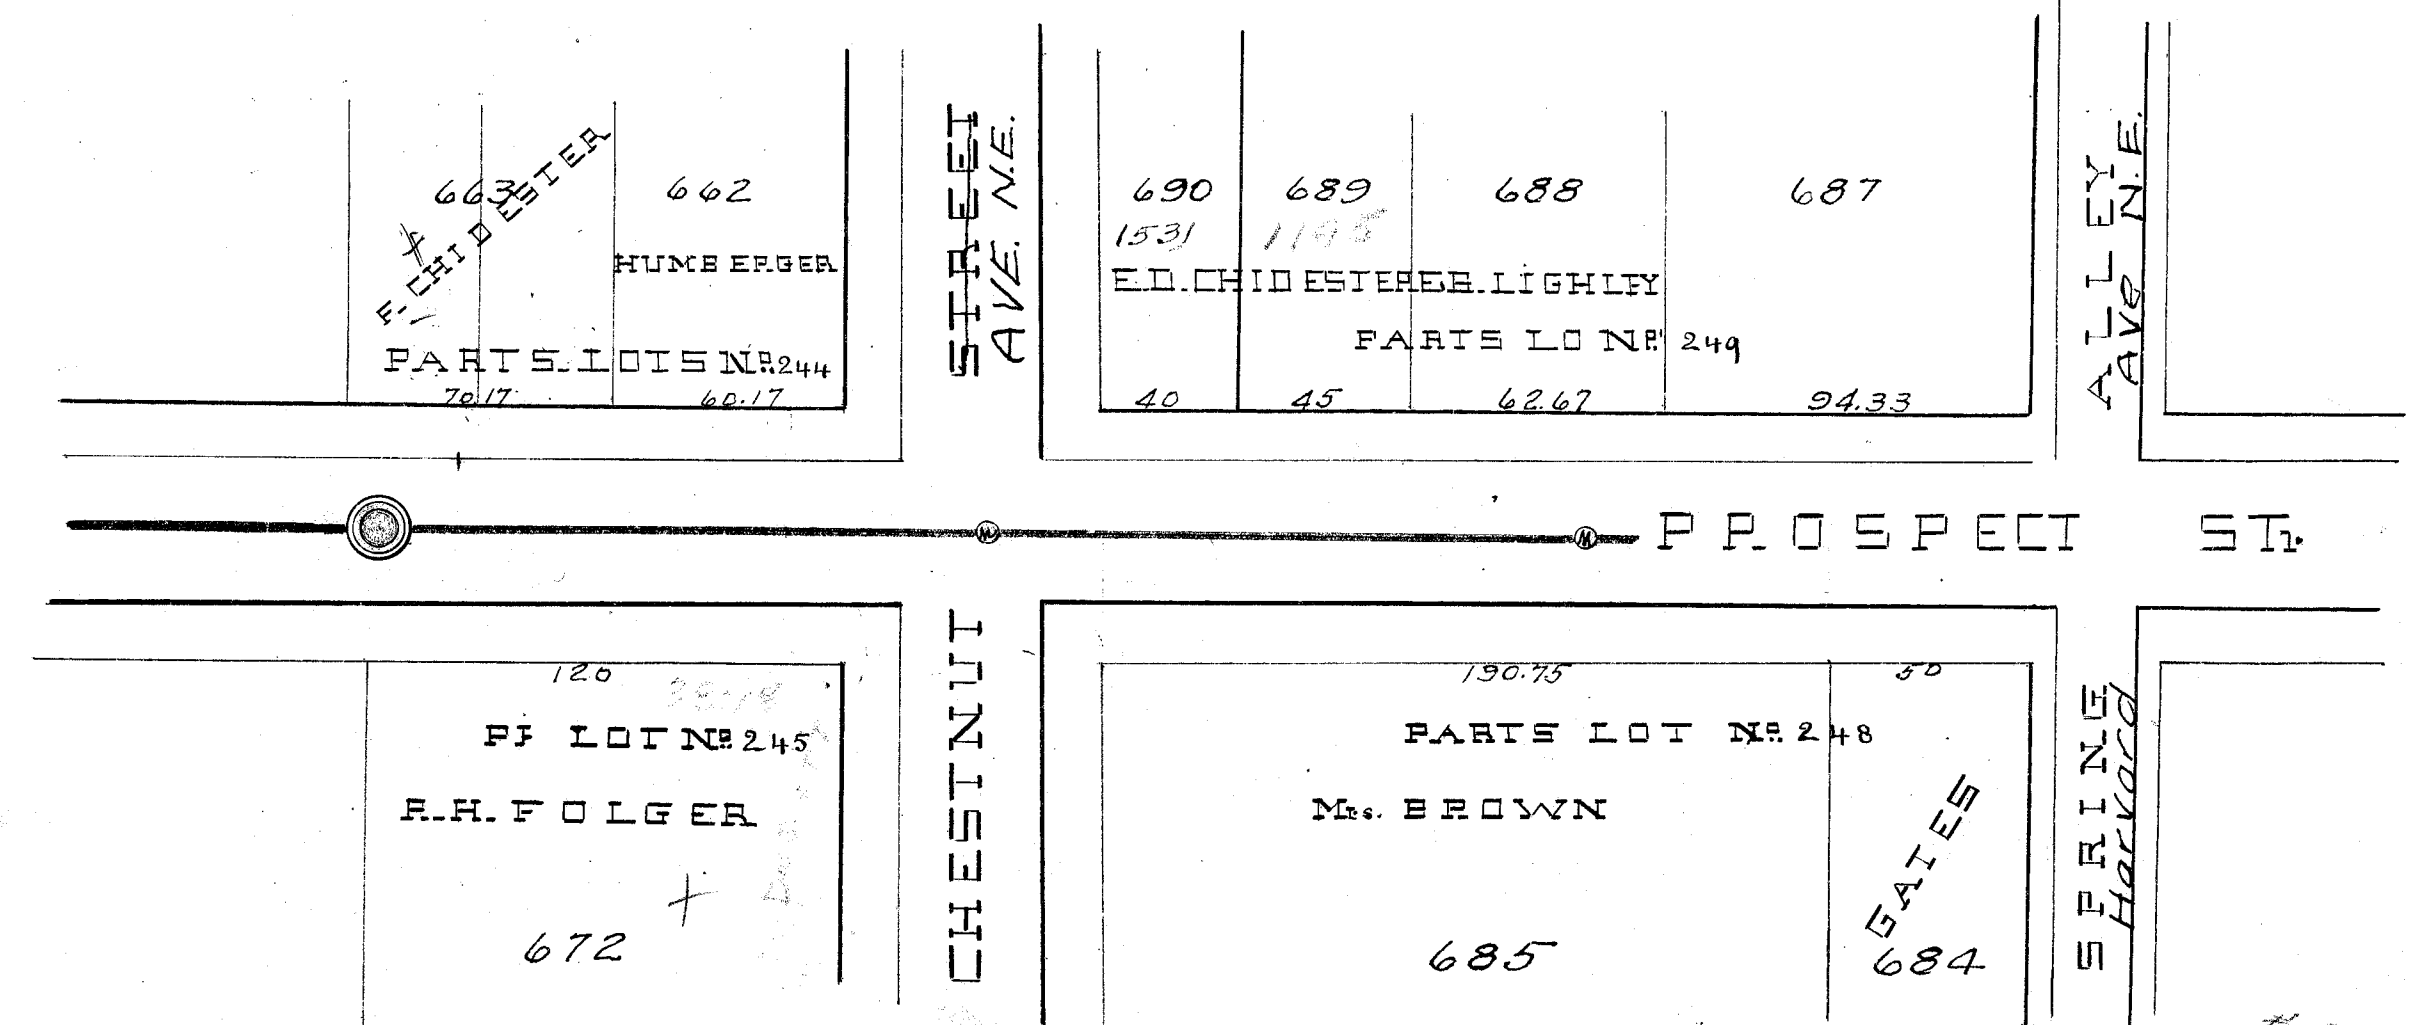

FOR NEW PLAN and PROFILE SEE SR. 11-20

2208

NOTES FOR HOUSE & LATERAL CONNECTIONS

NORTH SIDE

Wissmar 1st Connection is 67 feet west from Canal Street
 2nd " " " 25 10 1/2 feet from the East Line of Alley
 Henry Decker " " 25 21 1/2 feet west of Alley
 Mr. Breed " " 25 43 1/2 feet west of Ohio Canal
 Mr. Keller " " 25 38 1/2 feet west of Muskingum
 Phipps Connection " " 25 all Connected
 Mr. Long " " 25 26 feet east from the East Line of Alley
 Mr. Brown " " 25 70 feet east from the East Line of Alley


SOUTH SIDE

Dr. Schaefer 2nd Connection is 30 feet east of the Alley #315
 1st Connection is 45 1/4 feet east of his 2nd Connection #315
 Philipp Schaefer Connection is 25 feet west of Alley
 Martin Schaefer " " 25 3 1/2 feet east of his west line
 Mohr Ess. " " 25 1 feet east of his west line
 Allinger " " 25 6 feet east of his west line
 Hackett " " 25 24 feet west from the West Line of Muskingum Street
 John Ford 2nd Connection is 20 feet east of the Alley
 1st " " 25 23 feet west from his East line


PLAN & PROFILE OF THE TRUNK SEWER ON WEST CHARLES STREET FROM WEST TO ERIE STREET IN SEWER DISTRICT NO. 3

PURPLE = LOT NOS 1928

LA #312 = Eagles
 Cutoff 9461

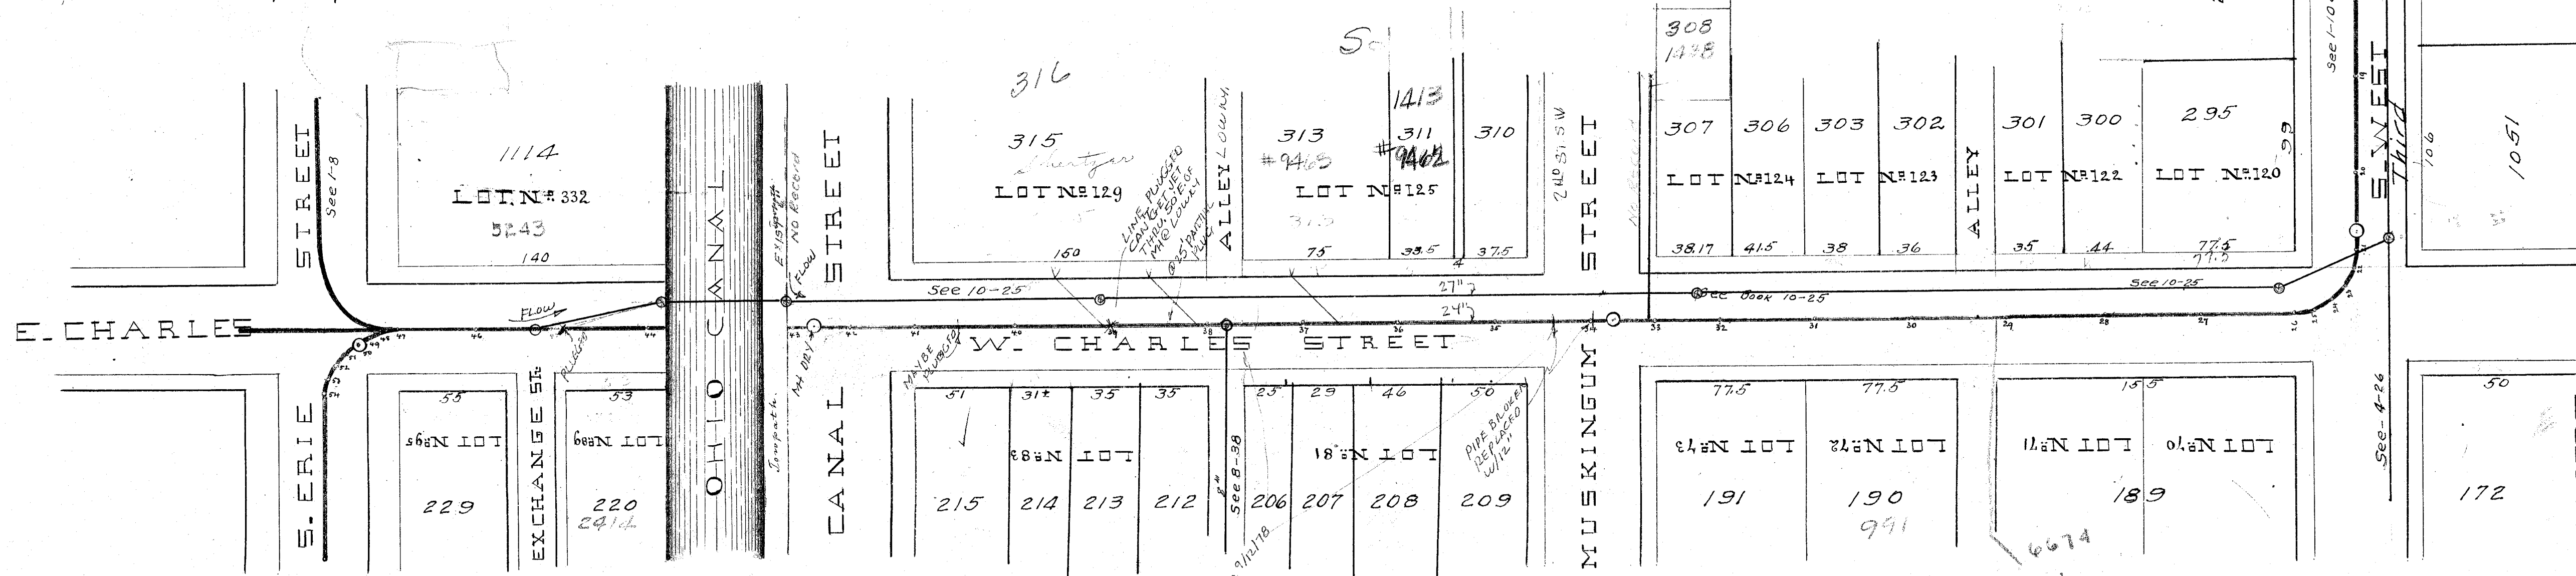

CHARLES STREET SEWER PROFILE FROM WEST TO ERIE STREET

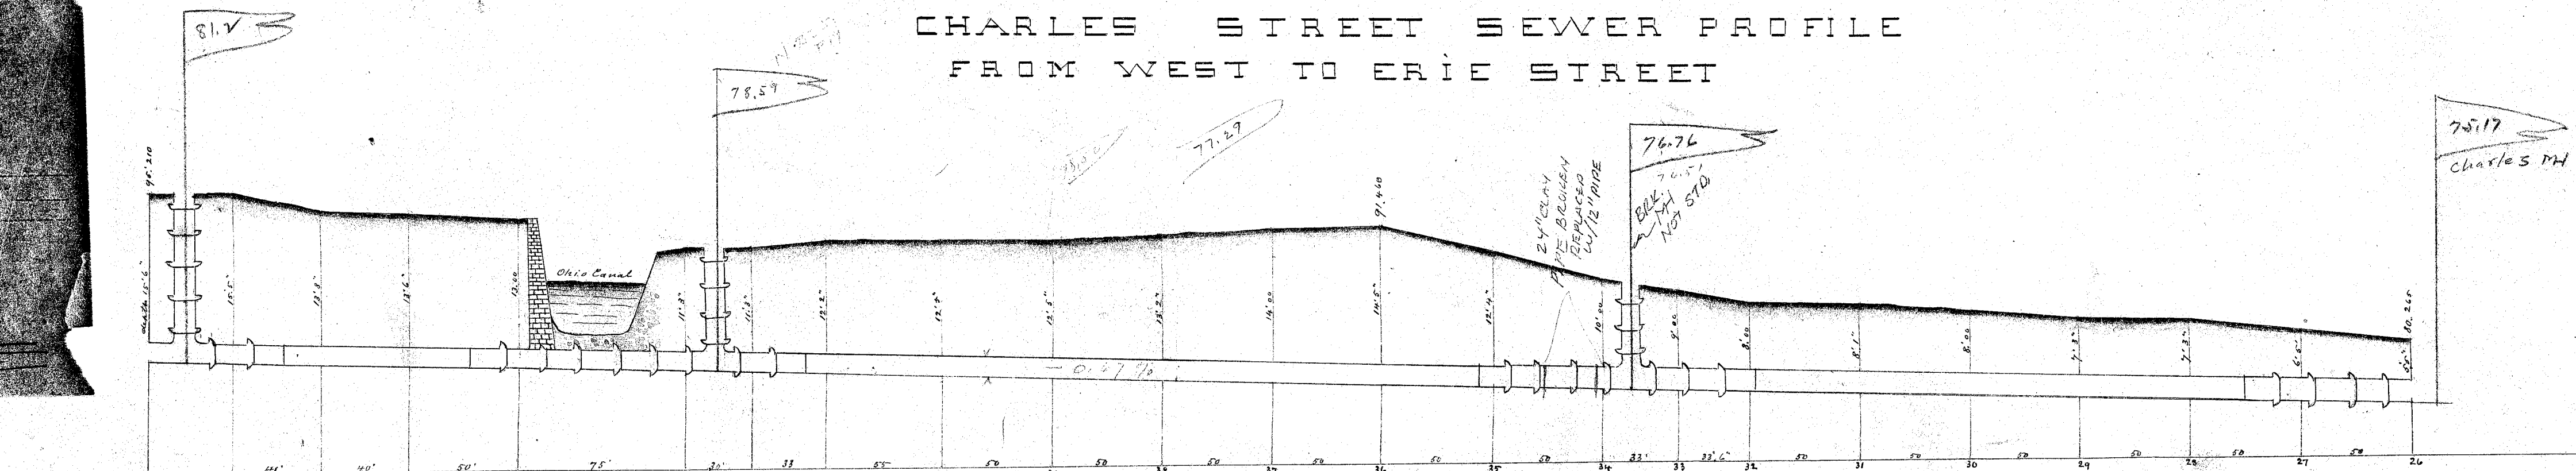


NOTES OF HOUSE CONNECTIONS ON WEST STREET BETWEEN TREMONT & CHARLES

West Side Connections
 Mrs. Manning Connection is 15 1/2 feet south of the East Line of Tremont Street
 Phipps Connection is 25 feet north of the West Line of Tremont Street
 Phipps Connection is 25 feet north of the West Line of Tremont Street
 Phipps Connection is 25 feet north of the West Line of Tremont Street



East Side Connections
 Adam Winding Connection is 48.8 feet from the South Line of Tremont Street
 Mr. Winding Connection is 48.8 feet from the South Line of Tremont Street
 Mr. Winding Connection is 48.8 feet from the South Line of Tremont Street

11

Scale Hor: 50': 1" Vert 10': 1" inch 12 x 10" caliber paper

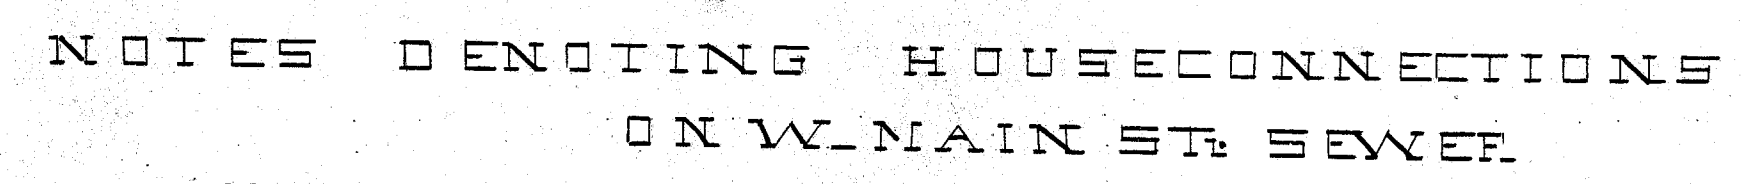

Purple = Lot #23 1928

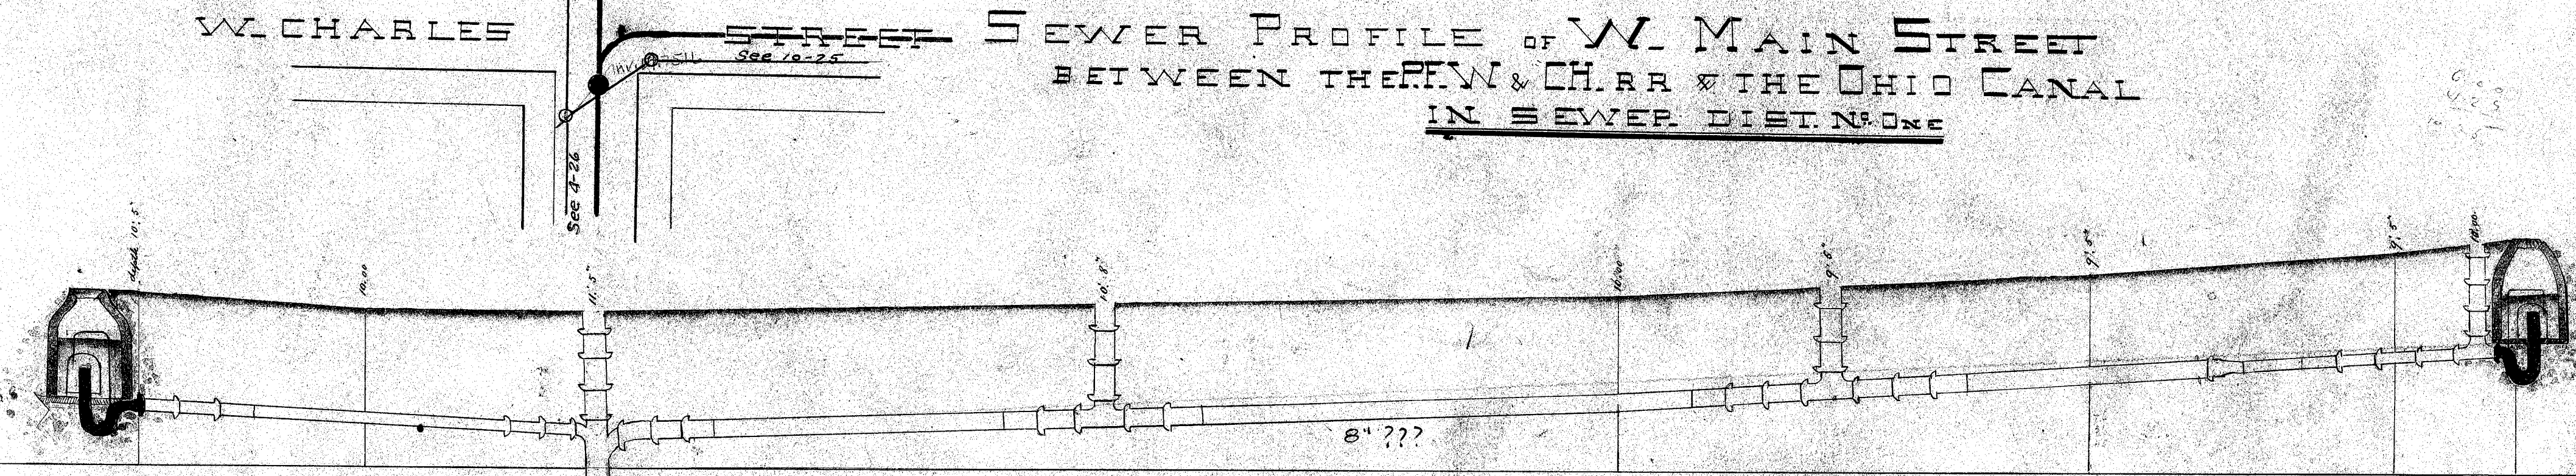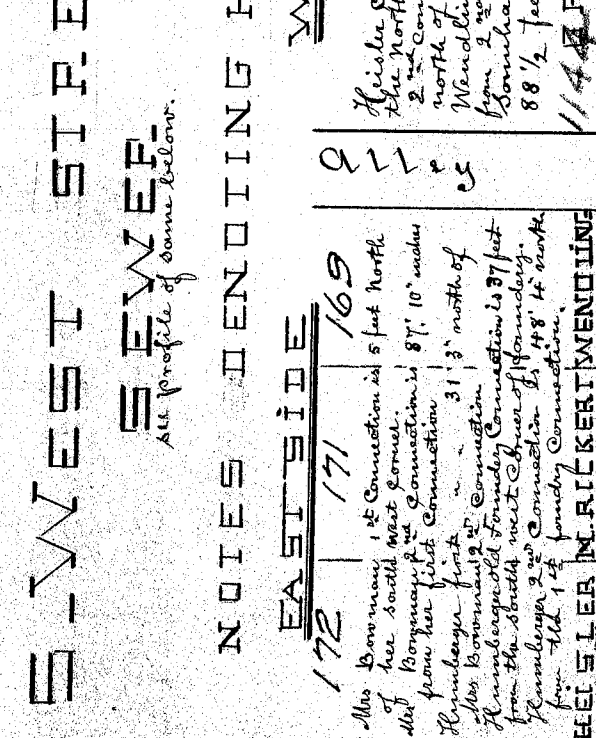


17	1	2	3	100
----	---	---	---	---	---	---	---	---	---	----	----	-----

Plan and Profile of Charles Street Sewer


Horizontal Scale 8 ft to 1 inch Vertical 8 ft to 1 inch

PL 112-127 LOT NO'S 1125-1139
DRAINAGE SEWER PLAN

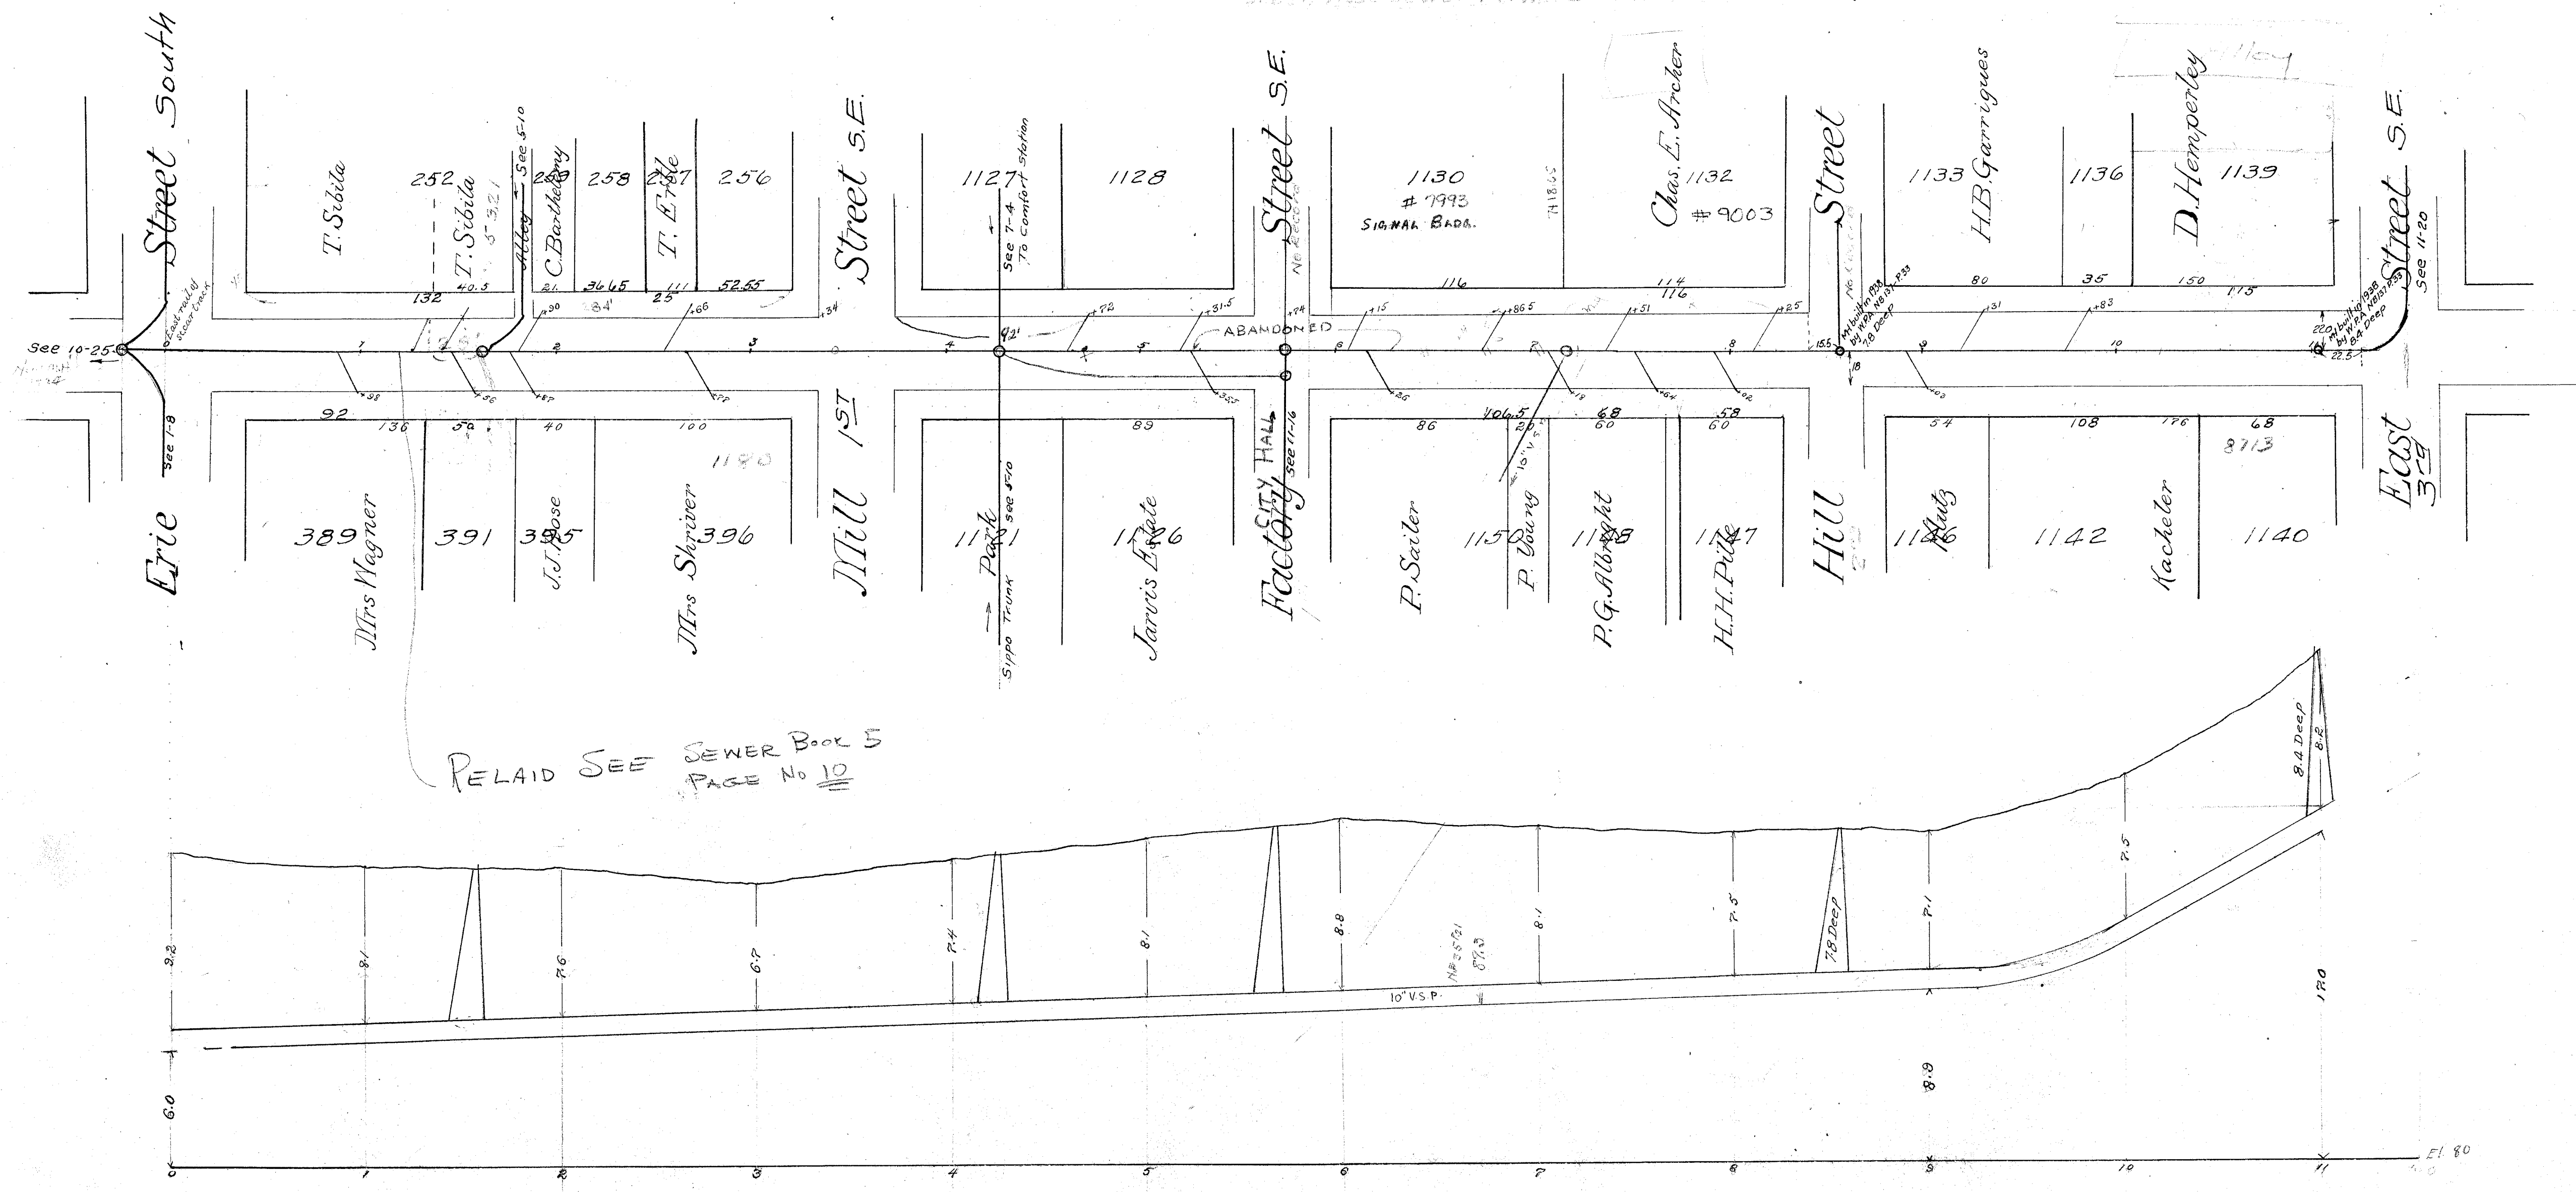

RELAY SEE SEWER BOOK 57
PAGE No 10

8290
CUR-077

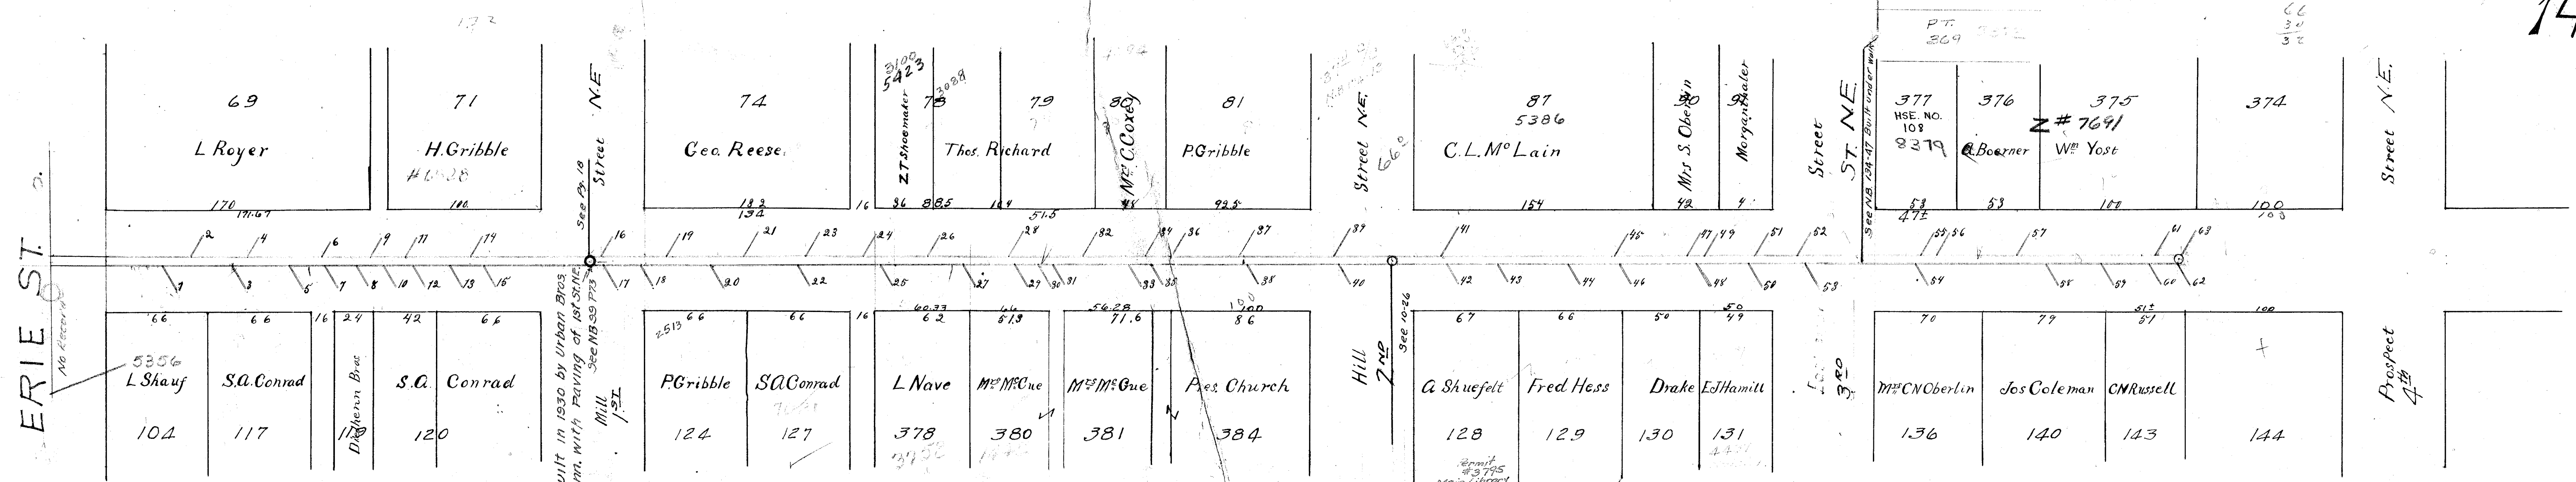

Plan and Profile of Plum Street Sewer
Hor Scale 1"=50' Ver Scale 1"=10'


Laterals
No. 1 is 373 ft East of the East Line of Mill St

2	842			
3	817			
4	90.8			
5	118.3			
6	138.9			
7	140.7			
8	162.0			
9	169.8			
10	178.2			
11	193.3			
12	198.5			
13	221.4			
14	235.0			
15	249.5			
16	33.0	West	MILL	
17	70.0			
18	64.0	East		
19	14.0			
20	42.0			
21	63.3			
22	94.7			
23	102.7			
24	140.0			
25	151.0			
26	181.4			
27	202.0			
28	233.3			
29	237.3			
30	252.0			
31	262.0			
32	281.4			
33	310.5			
34	320.8			
35	325.0			
36	338.8			
37	352.7			
38	355.7			


Laterals Continued
No 39 is 140 ft East of the West Line of Hill St

40	18.0			
41	17.5			
42	21.5	East		
43	54.0			
44	109.0			
45	129.0			
46	132.6			
47	172.7			
48	181.3			
49	186.3			
50	214.8			
51	319.3			
52	16.0	West		
53	20.5			
54	25.7	East	East	
55	29.0			
56	37.7			
57	71.2			
58	110.0			
59	145.8			
60	173.7			
61	177.7			
62	179.0			
63	176.0			
64				

Note: Lateral #20 was dug up Feb 10 1927
a Wye Pole was found in middle of street
going down to Wye on Main. - No Lateral
to curb - chainage was OK for Wye -
G.C. Wallace

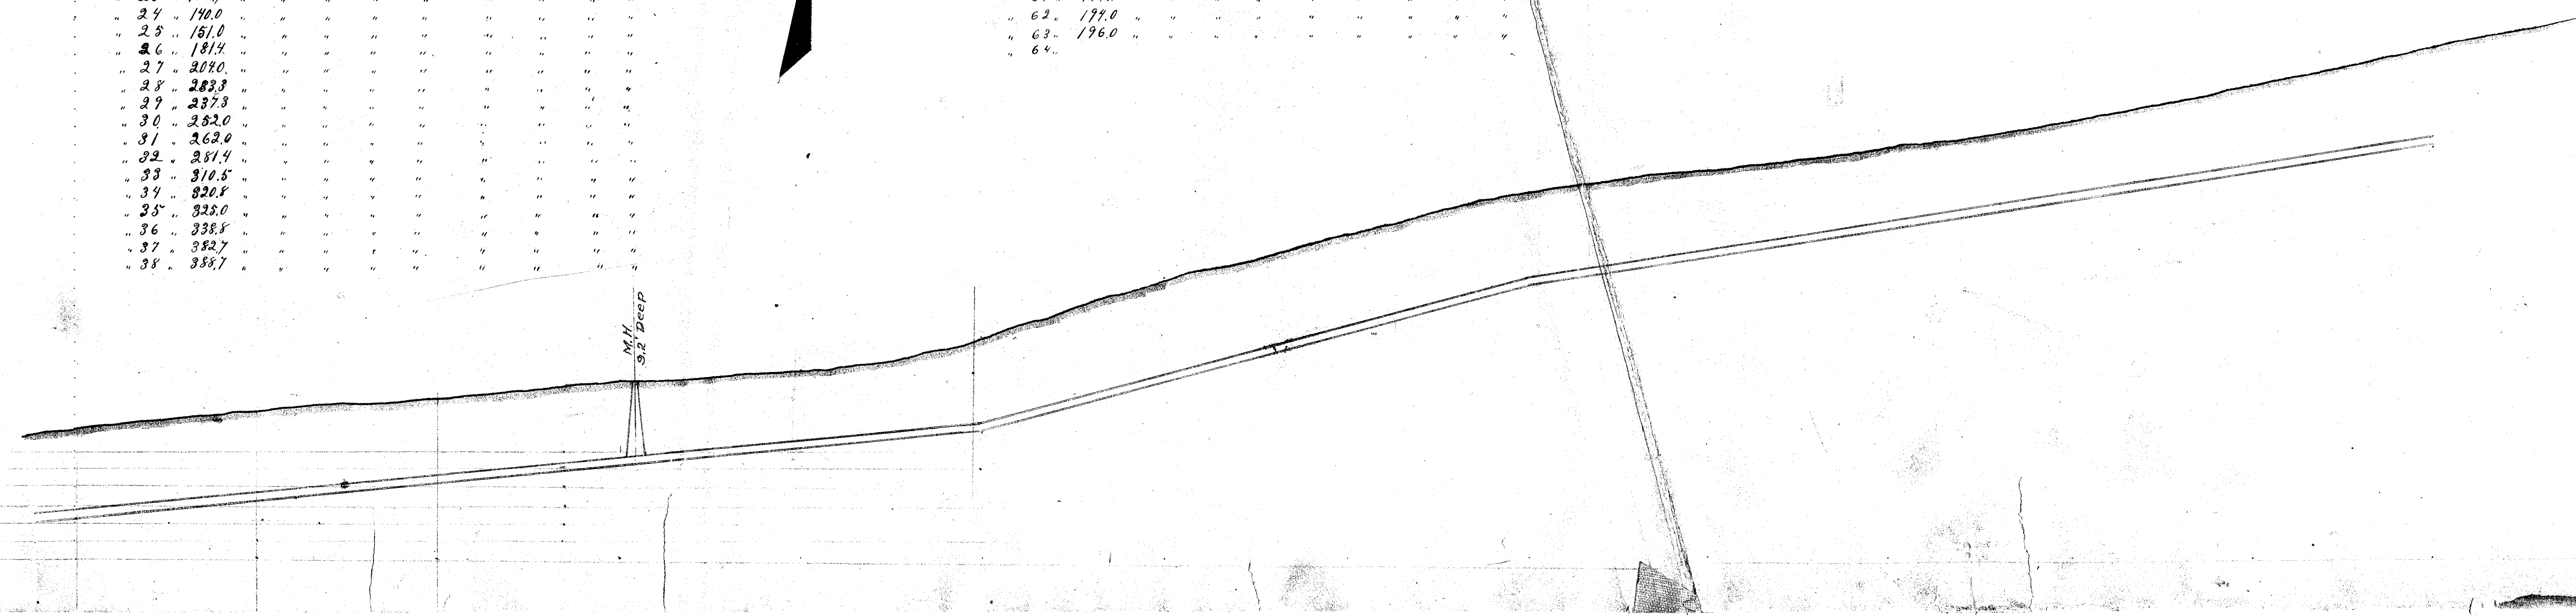

20
5
18
15
17
20

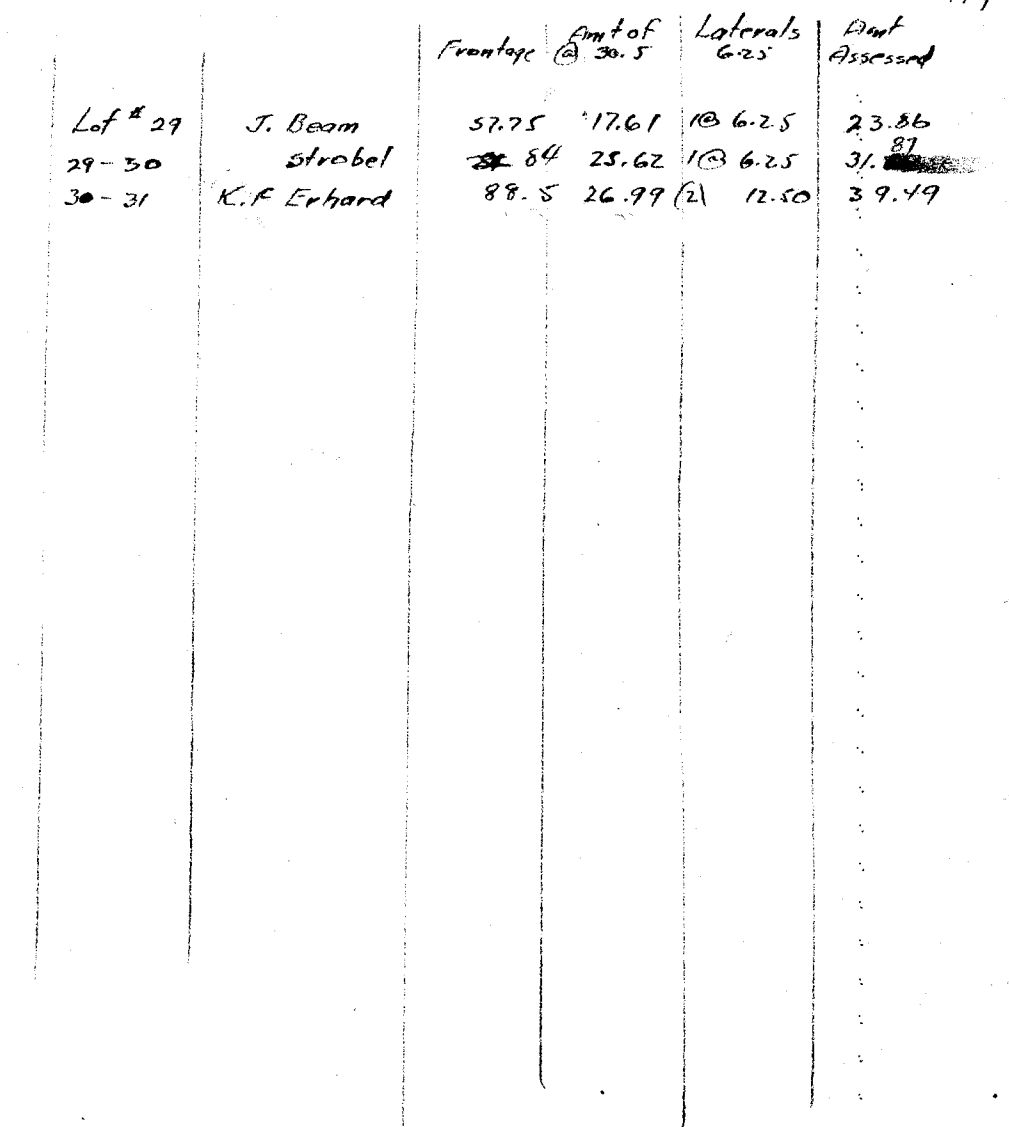


Purple = Lot No's 1228
Green = No's 1229-1230

PLAN OF SOUTH STREET SEWER

SHOWING LOCATION OF HOUSE CONNECTIONS EXTRA Y BRANCHES
MANHOLES AND FRONTAGE. SCALE 40 FT. TO 1 IN
MEASUREMENTS FOR CONNECTIONS ARE GIVEN FROM THE EAST LINE OF
OF EACH STREET, FOR MANHOLES AND Y BRANCHES FROM THE CENTER
OF ERIE STREET AND EACH SUBSEQUENT MANHOLE.


Lateral to school lot
15 286' From M.H. on 1st St. S.E.

D.C. Barton C.E.

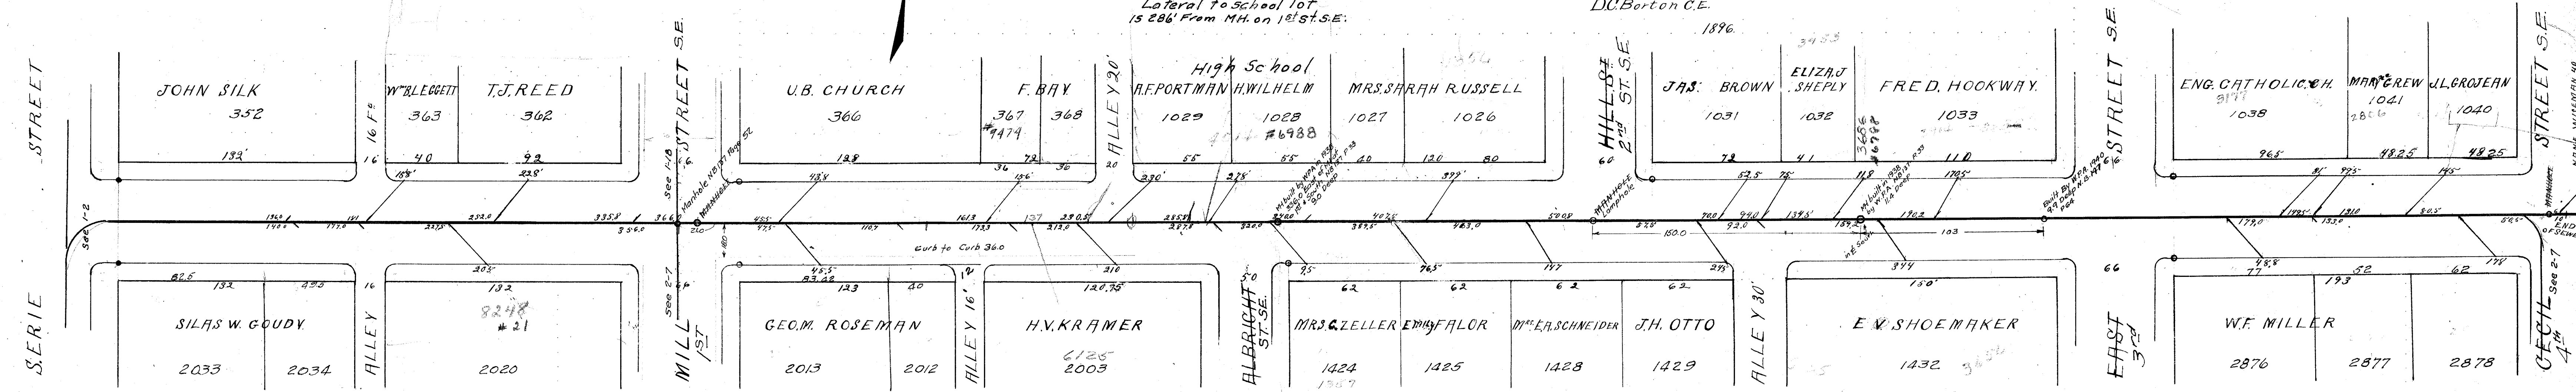

PROFILE Scale Ver 1"=10' Hor 1"=40'

PURPLE LOT 1923
GREEN LOT 1923


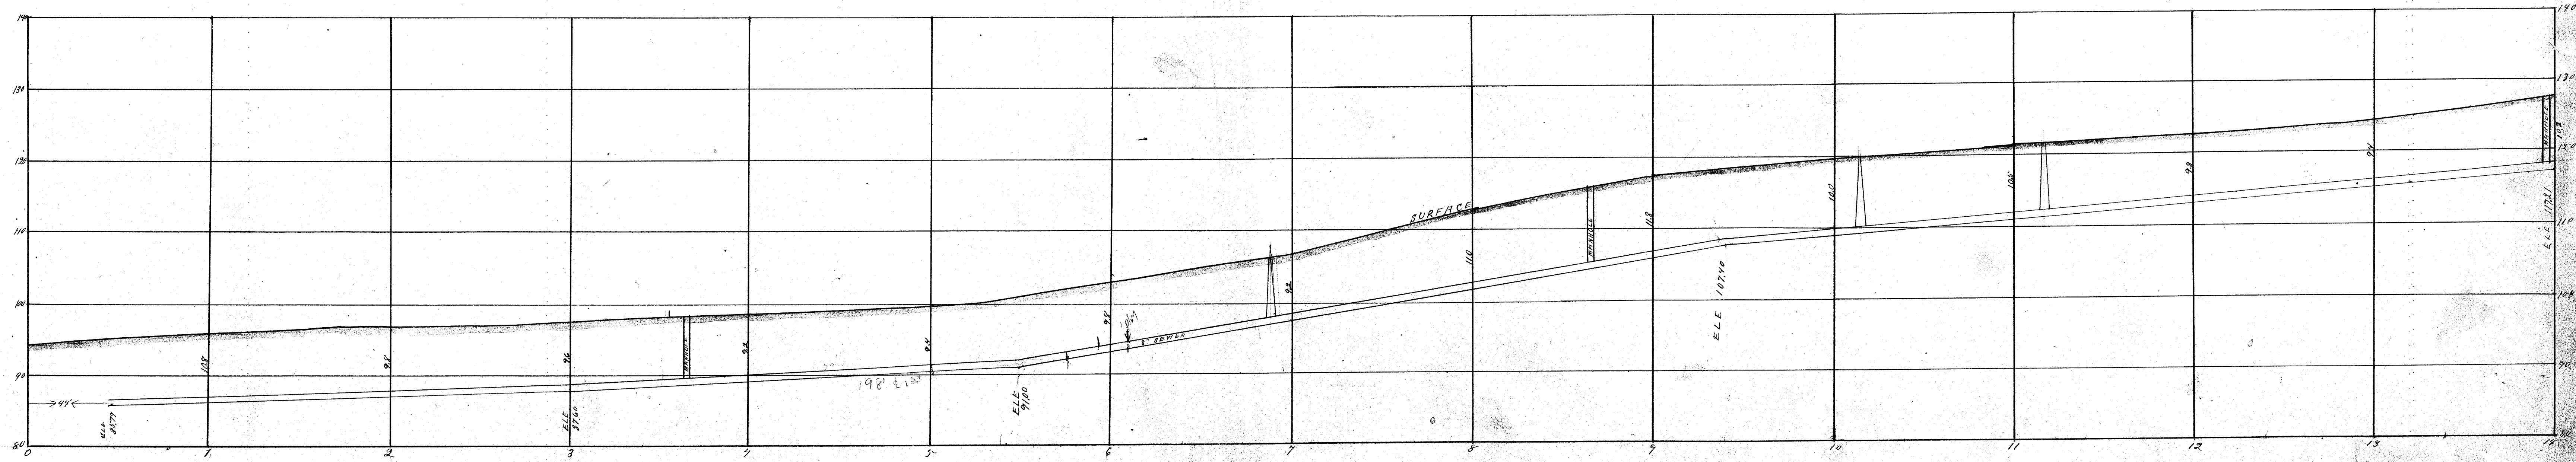


7.60
21.40
25.00
9.00

12.21
12.21
1.50


EAST ST Lincoln





17

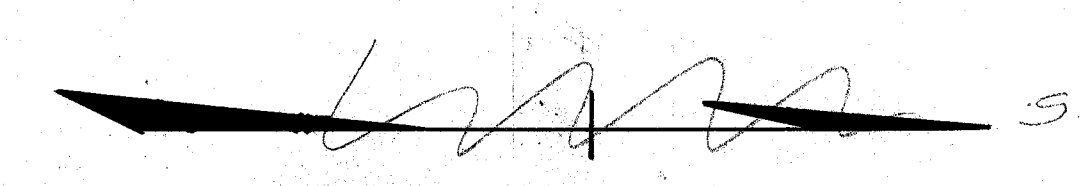
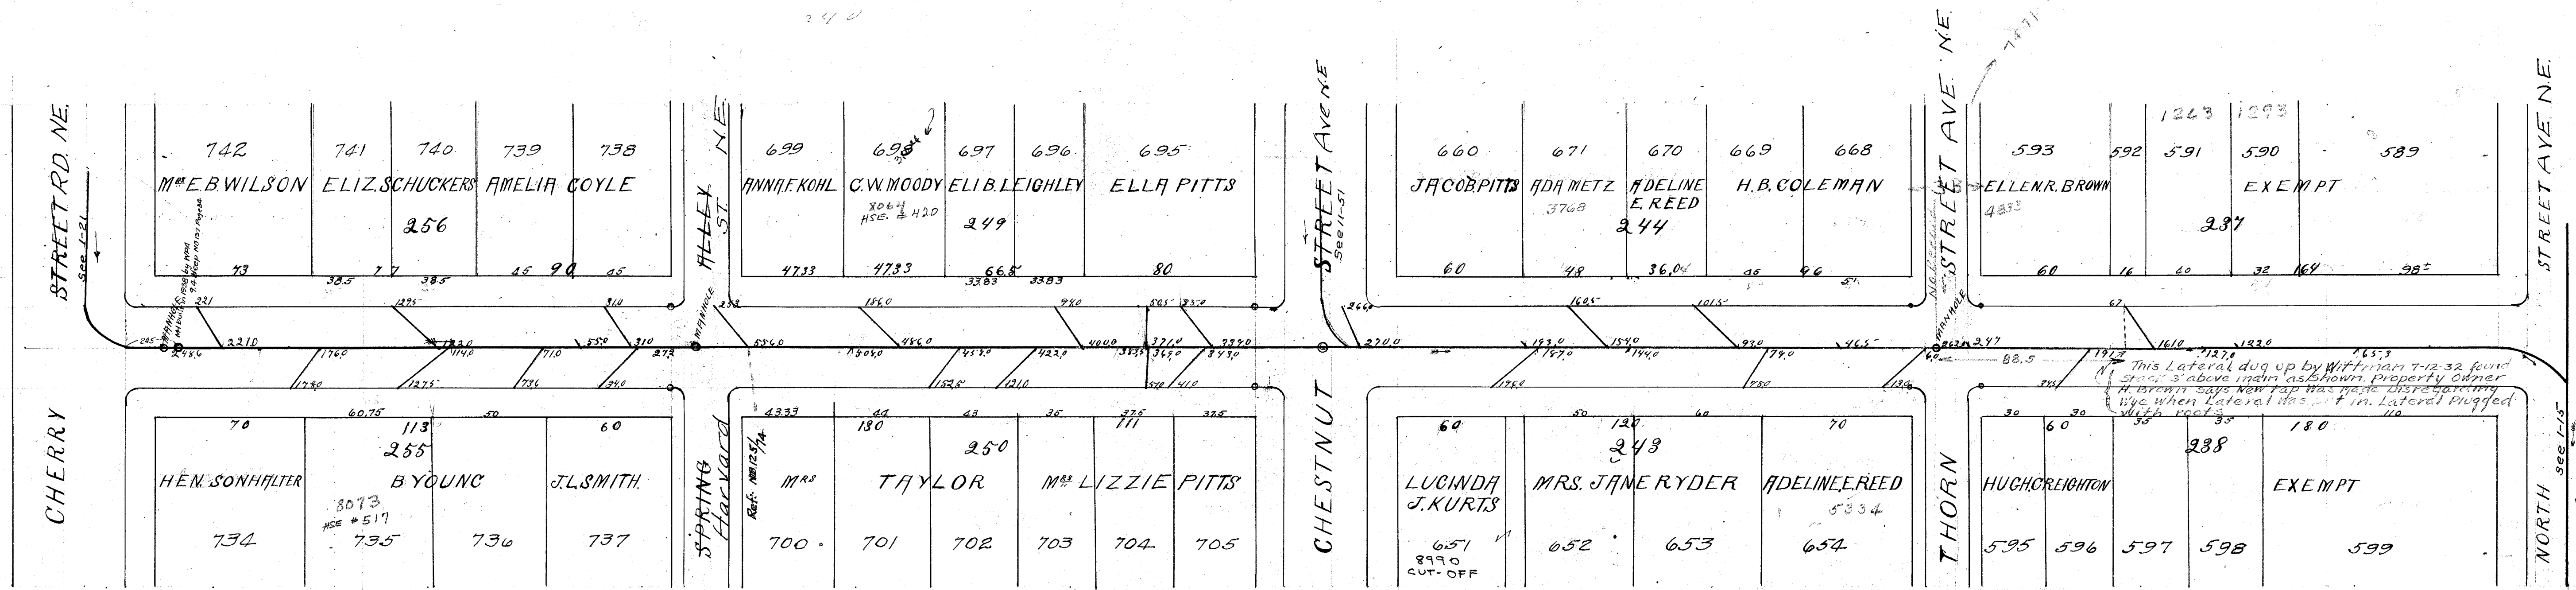



Third St. NE.
Purple = Lot Nos 1928
Green = Main Sewer Permit

Scale Ver 1"=10'
Hor 1"=40'


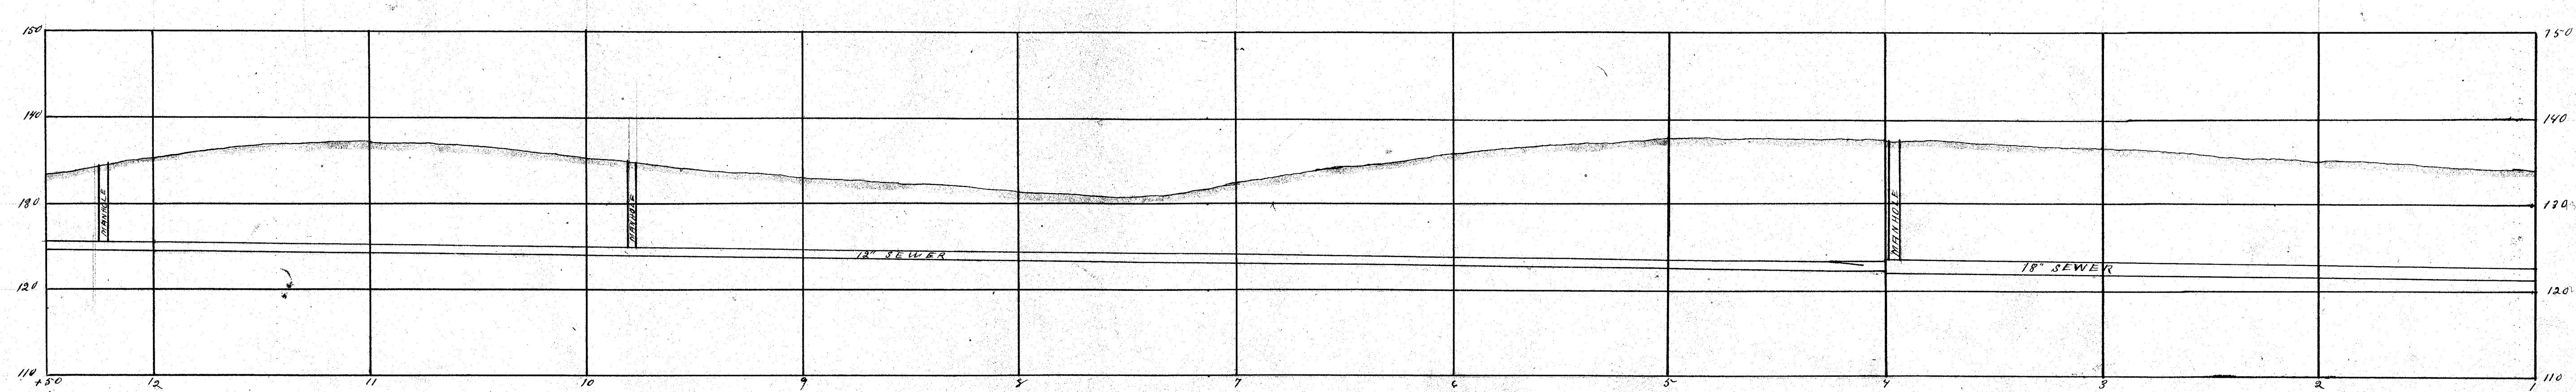


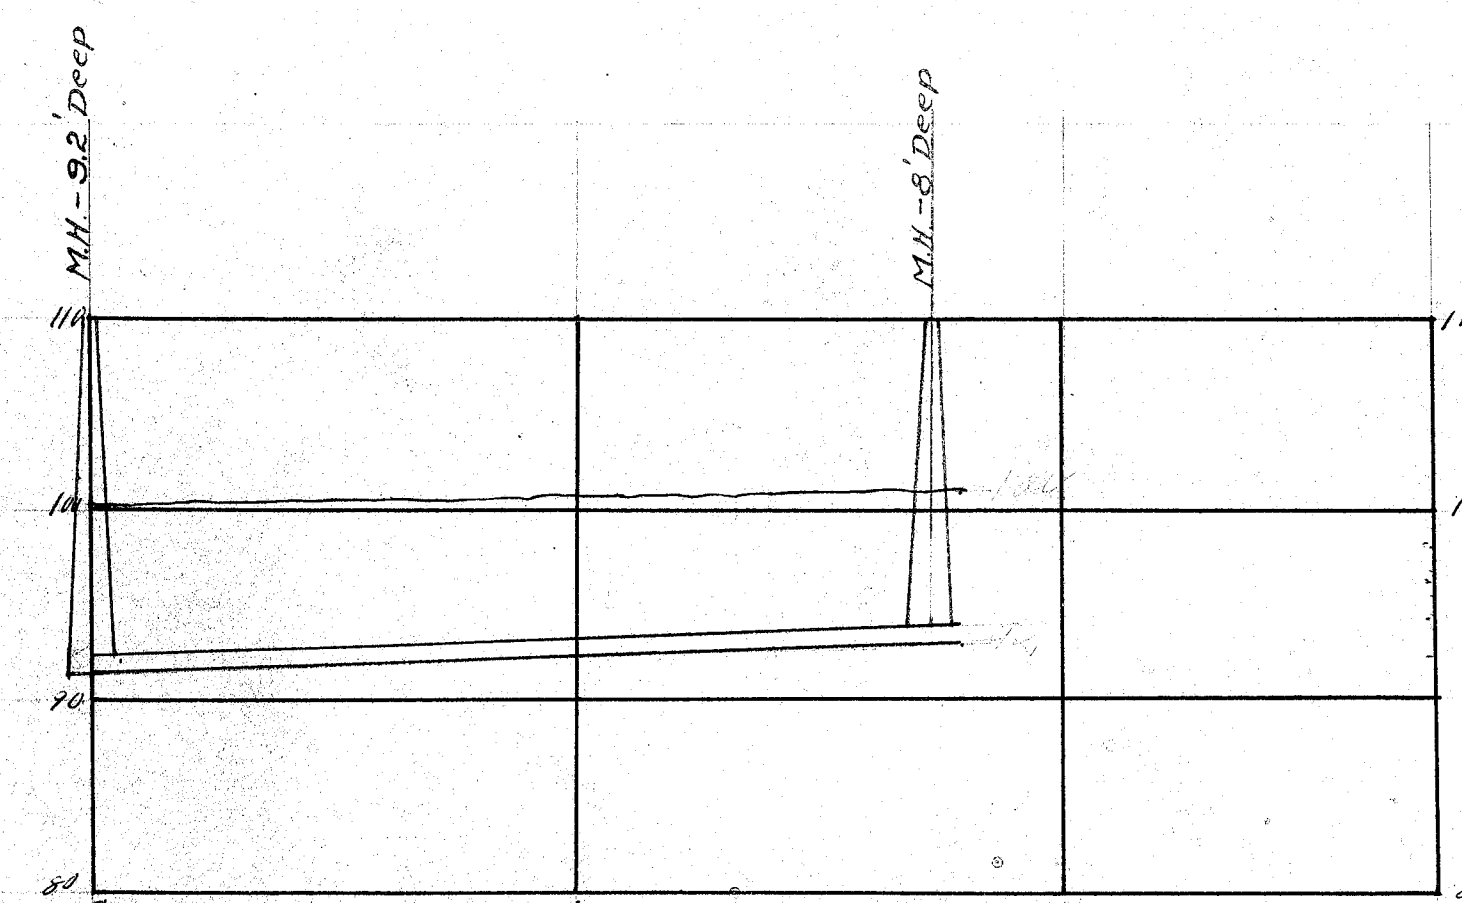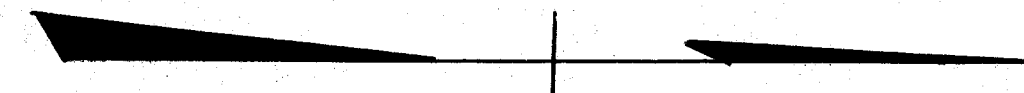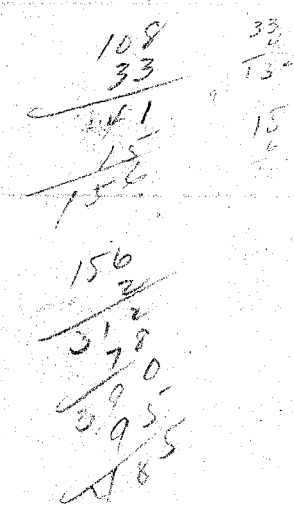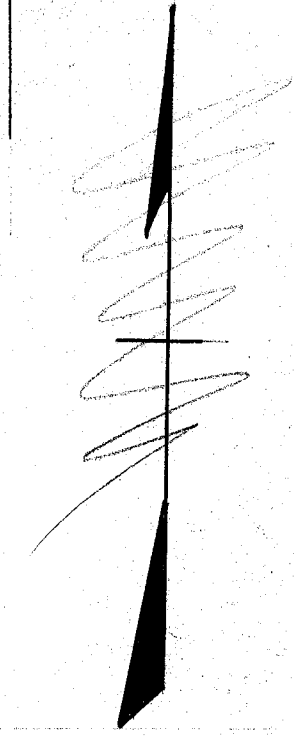

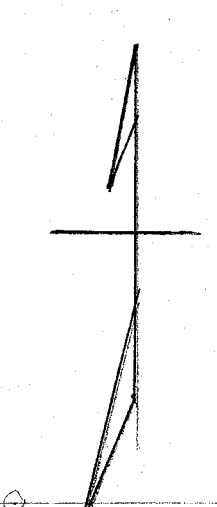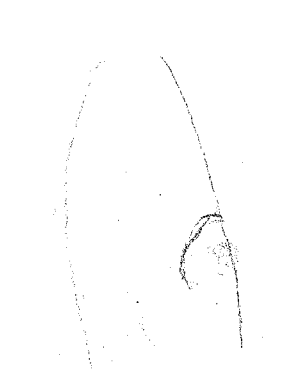

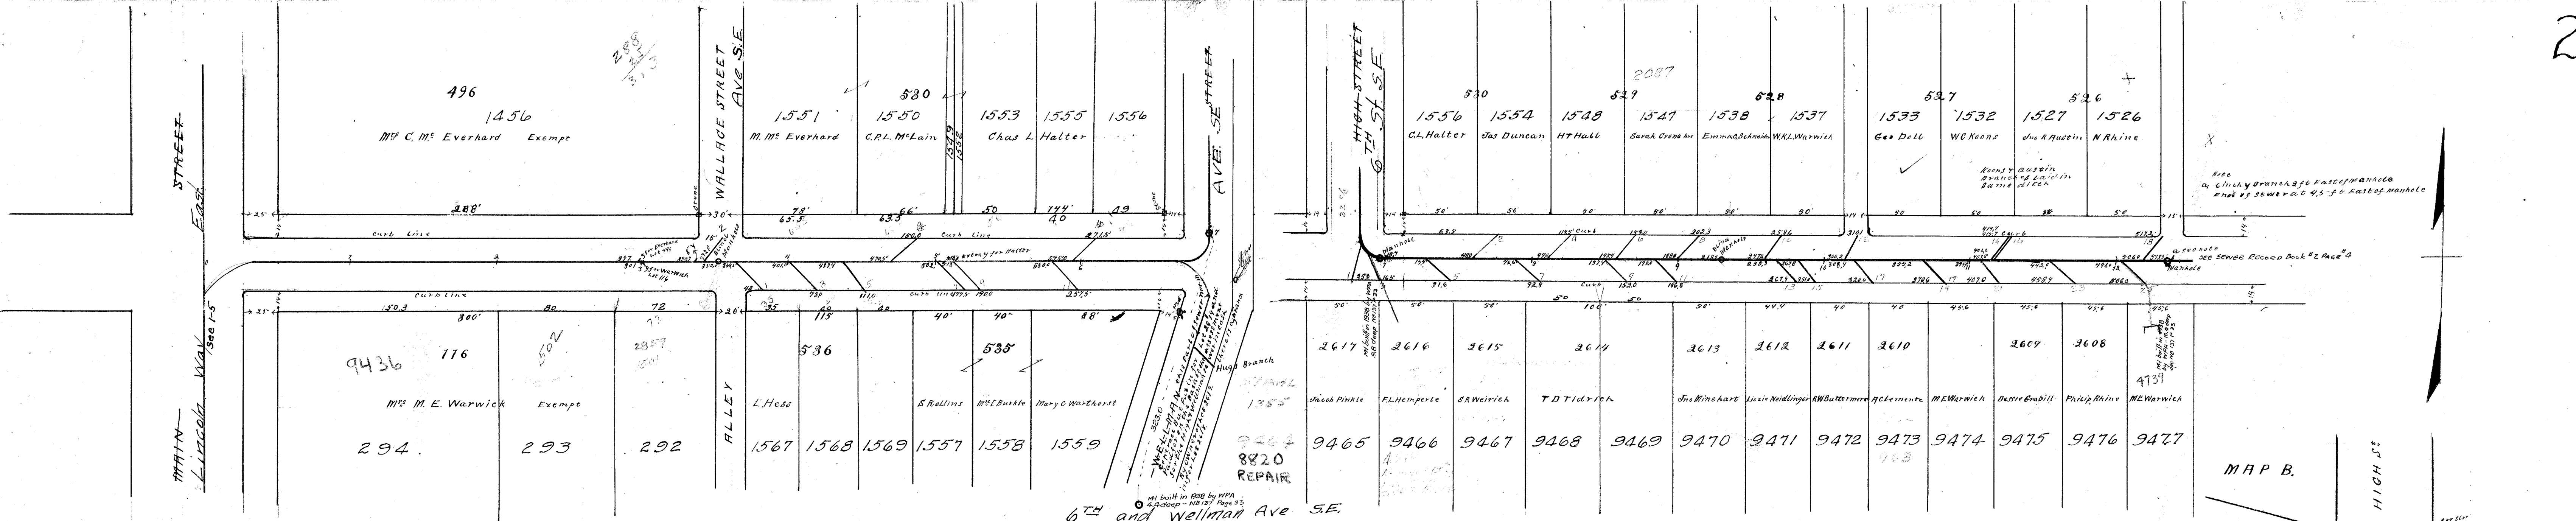

PLAN OF THE HIGH AND WELLMAN ST^S SEWER.
ON HIGH ST the Y Branches are located by measuring South from the center of Main St^S as Marked above
The branches at the curb are located by measuring South from the North line of Wallace St^S " " "
ON WELLMAN St the Y Branches are located by measurement from the East line of High St^S " " "
The branches at the curb are located the same as the Y's. The branches at the intersection are located as
Indicated By Small map marked B
Scale of map 20'-1" Profile Max 20'-1" Min 10'-1"
May 31 1899 D.C. Barton City Engr. Purple Lot Nos 1928
Green Nose Sewer Profile


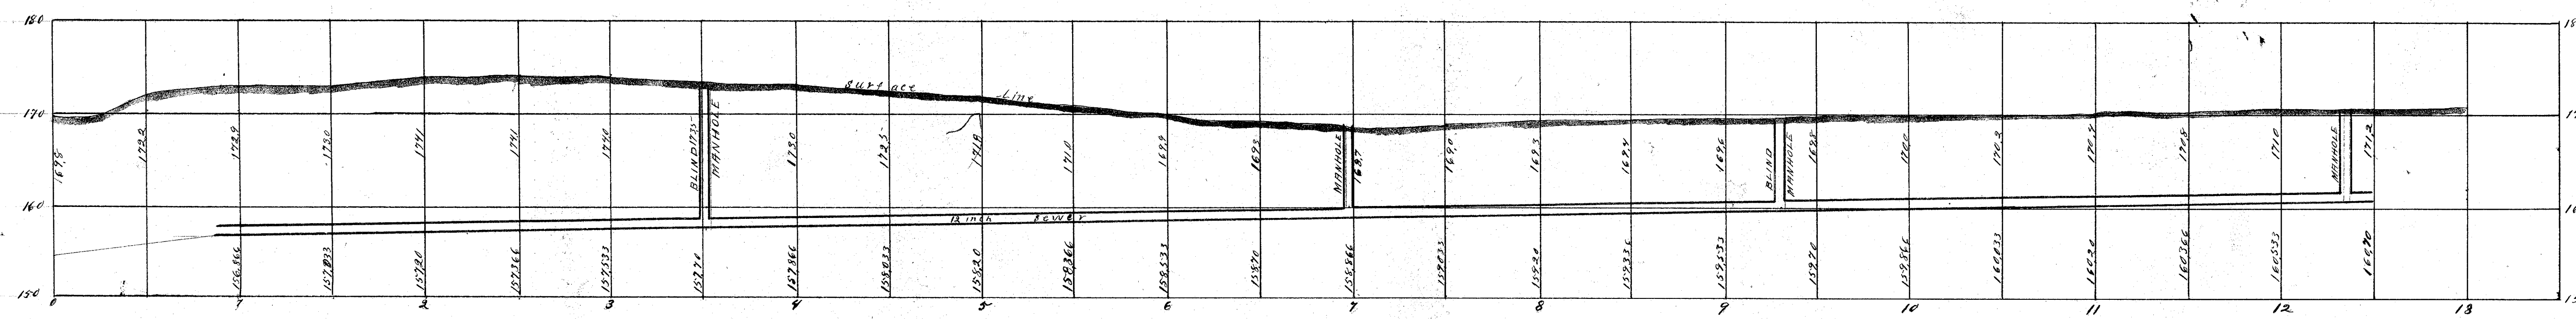
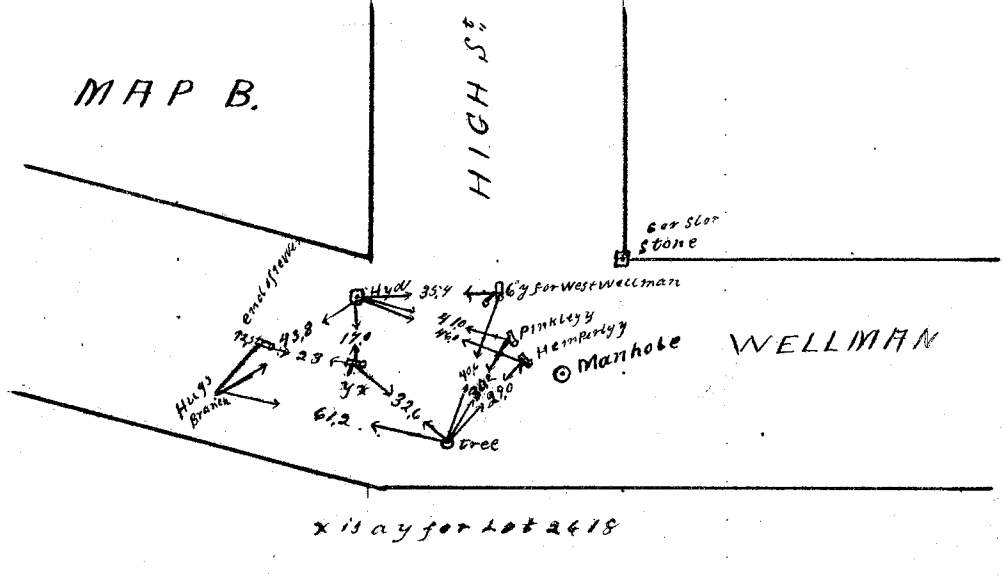


6TH ST SE Measured From The North Line of Wallace Ave SE

LAT.	LOT NO.	SIDE	STATION	REMARKS
2	1531	E	0+15	
4	1550	"	1+50	
6	1536	"	2+11.5	
7	1537	W	0+42	
3	1538	"	0+78	
5	1569	"	1+11	
7	1557	"	1+74.5	
9	1538	"	1+90	
11	1559	"	2+57.5	


WELLMAN AVE SE From The East Line of 6TH ST SE.


LAT.	LOT No.	SIDE	STA.	REMARKS
2	1531	W	0+33.8	
4	1548	"	1+14.5	
6	1547	"	1+5.9	
8	1539	"	2+0.2	
10	1537	"	2+5.8	
12	1533	"	3+1.0	
14	1532	"	4+14.7	
16	1527	"	4+15.7	
18	?	"	5+17.2	
1	9465	So.	0+35	West
3	9466	"	0+16.5	
5	9467	"	0+31.6	
7	9468	"	0+92.8	
9	9469	"	1+5.2	
11	9470	"	1+8.6	
13	9471	"	2+67.9	
15	9472	"	2+81	
17	9473	"	3+20.6	
19	9474	"	3+70.6	
21	9475	"	4+0.7	
23	9476	"	4+58.9	
25	9477	"	5+0.6	

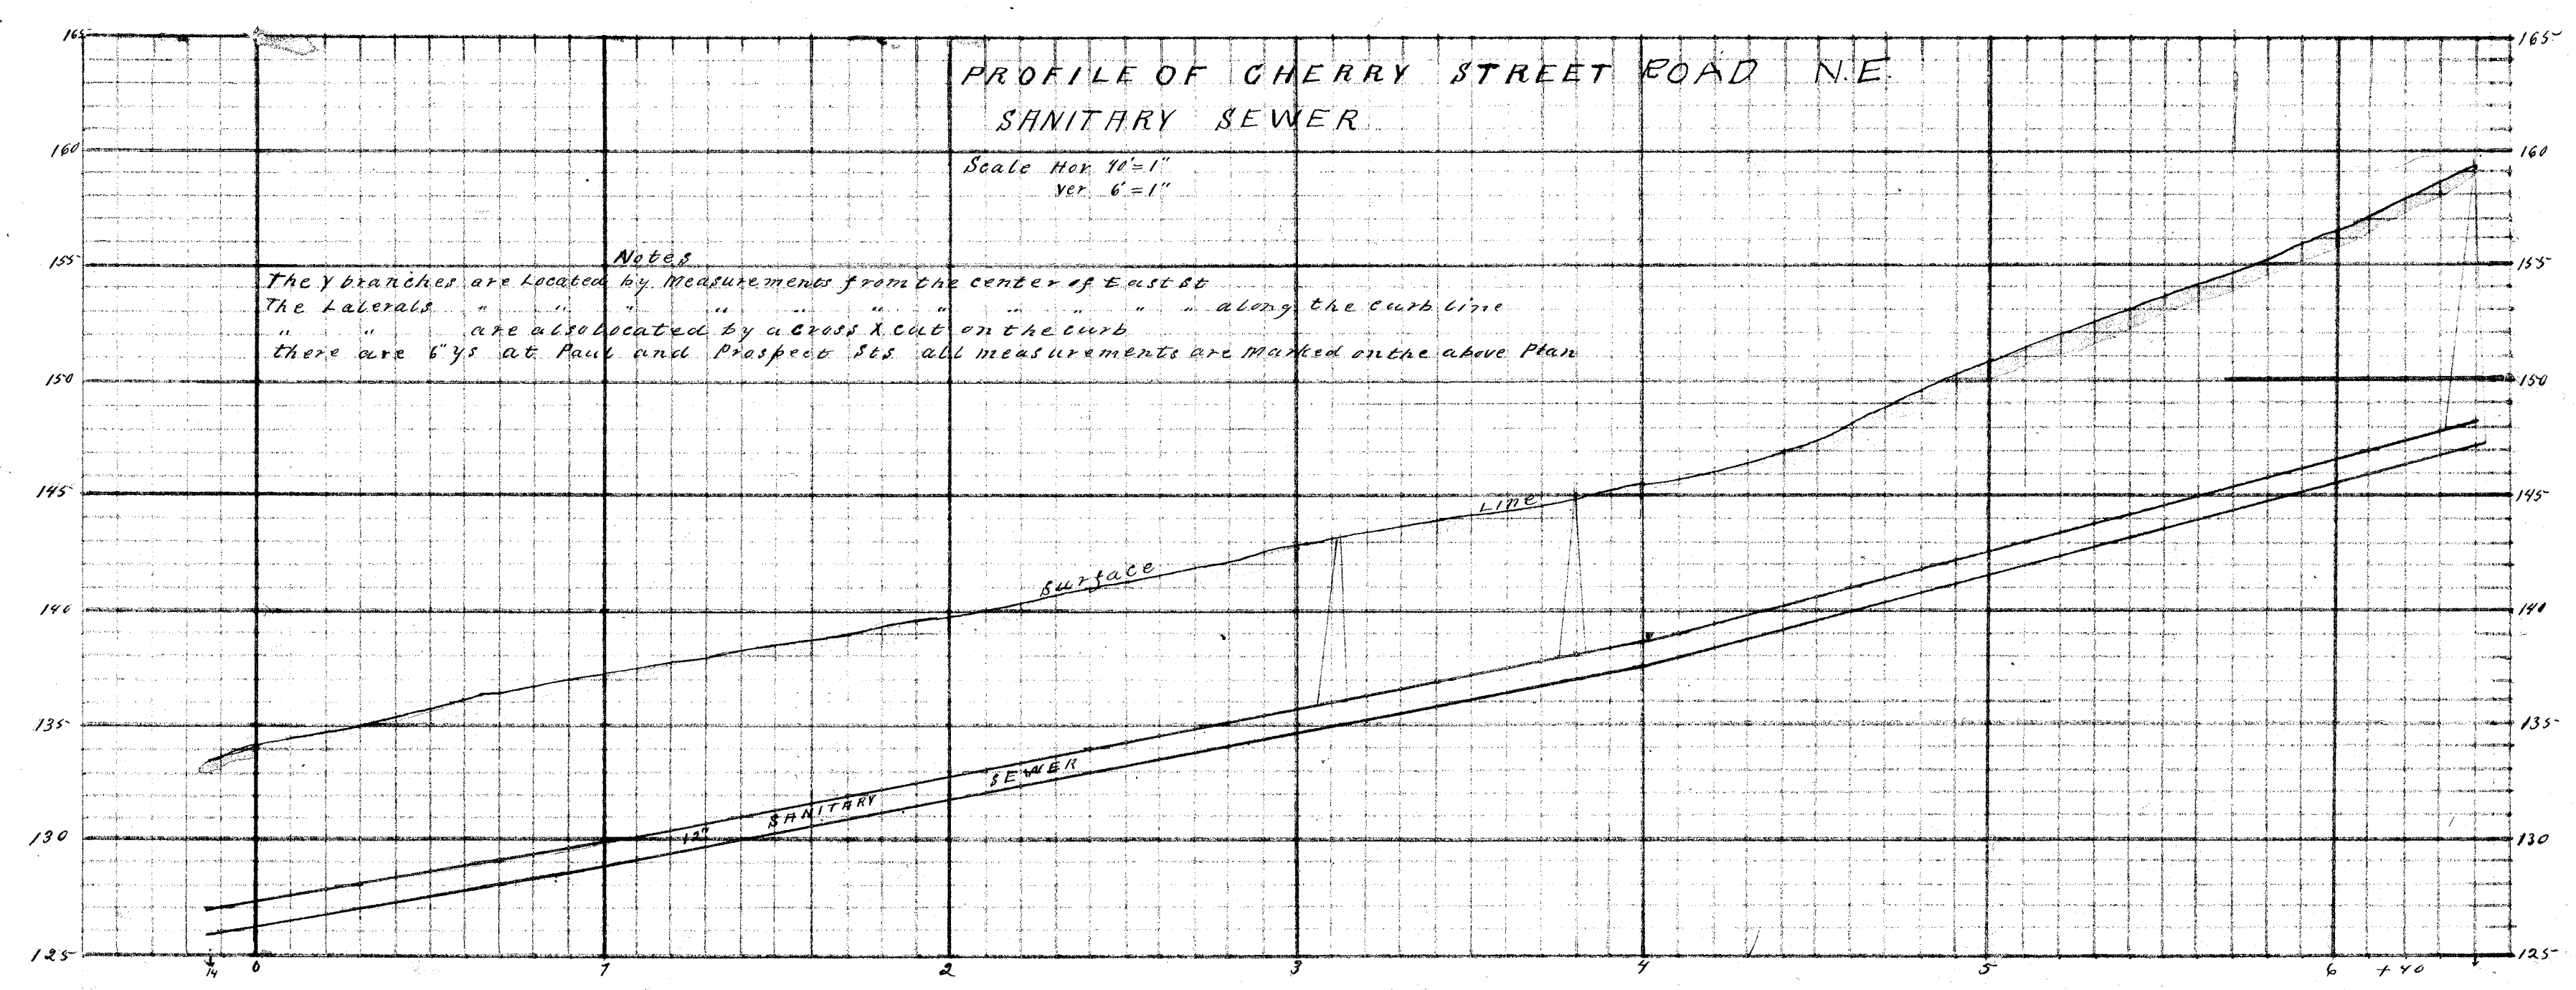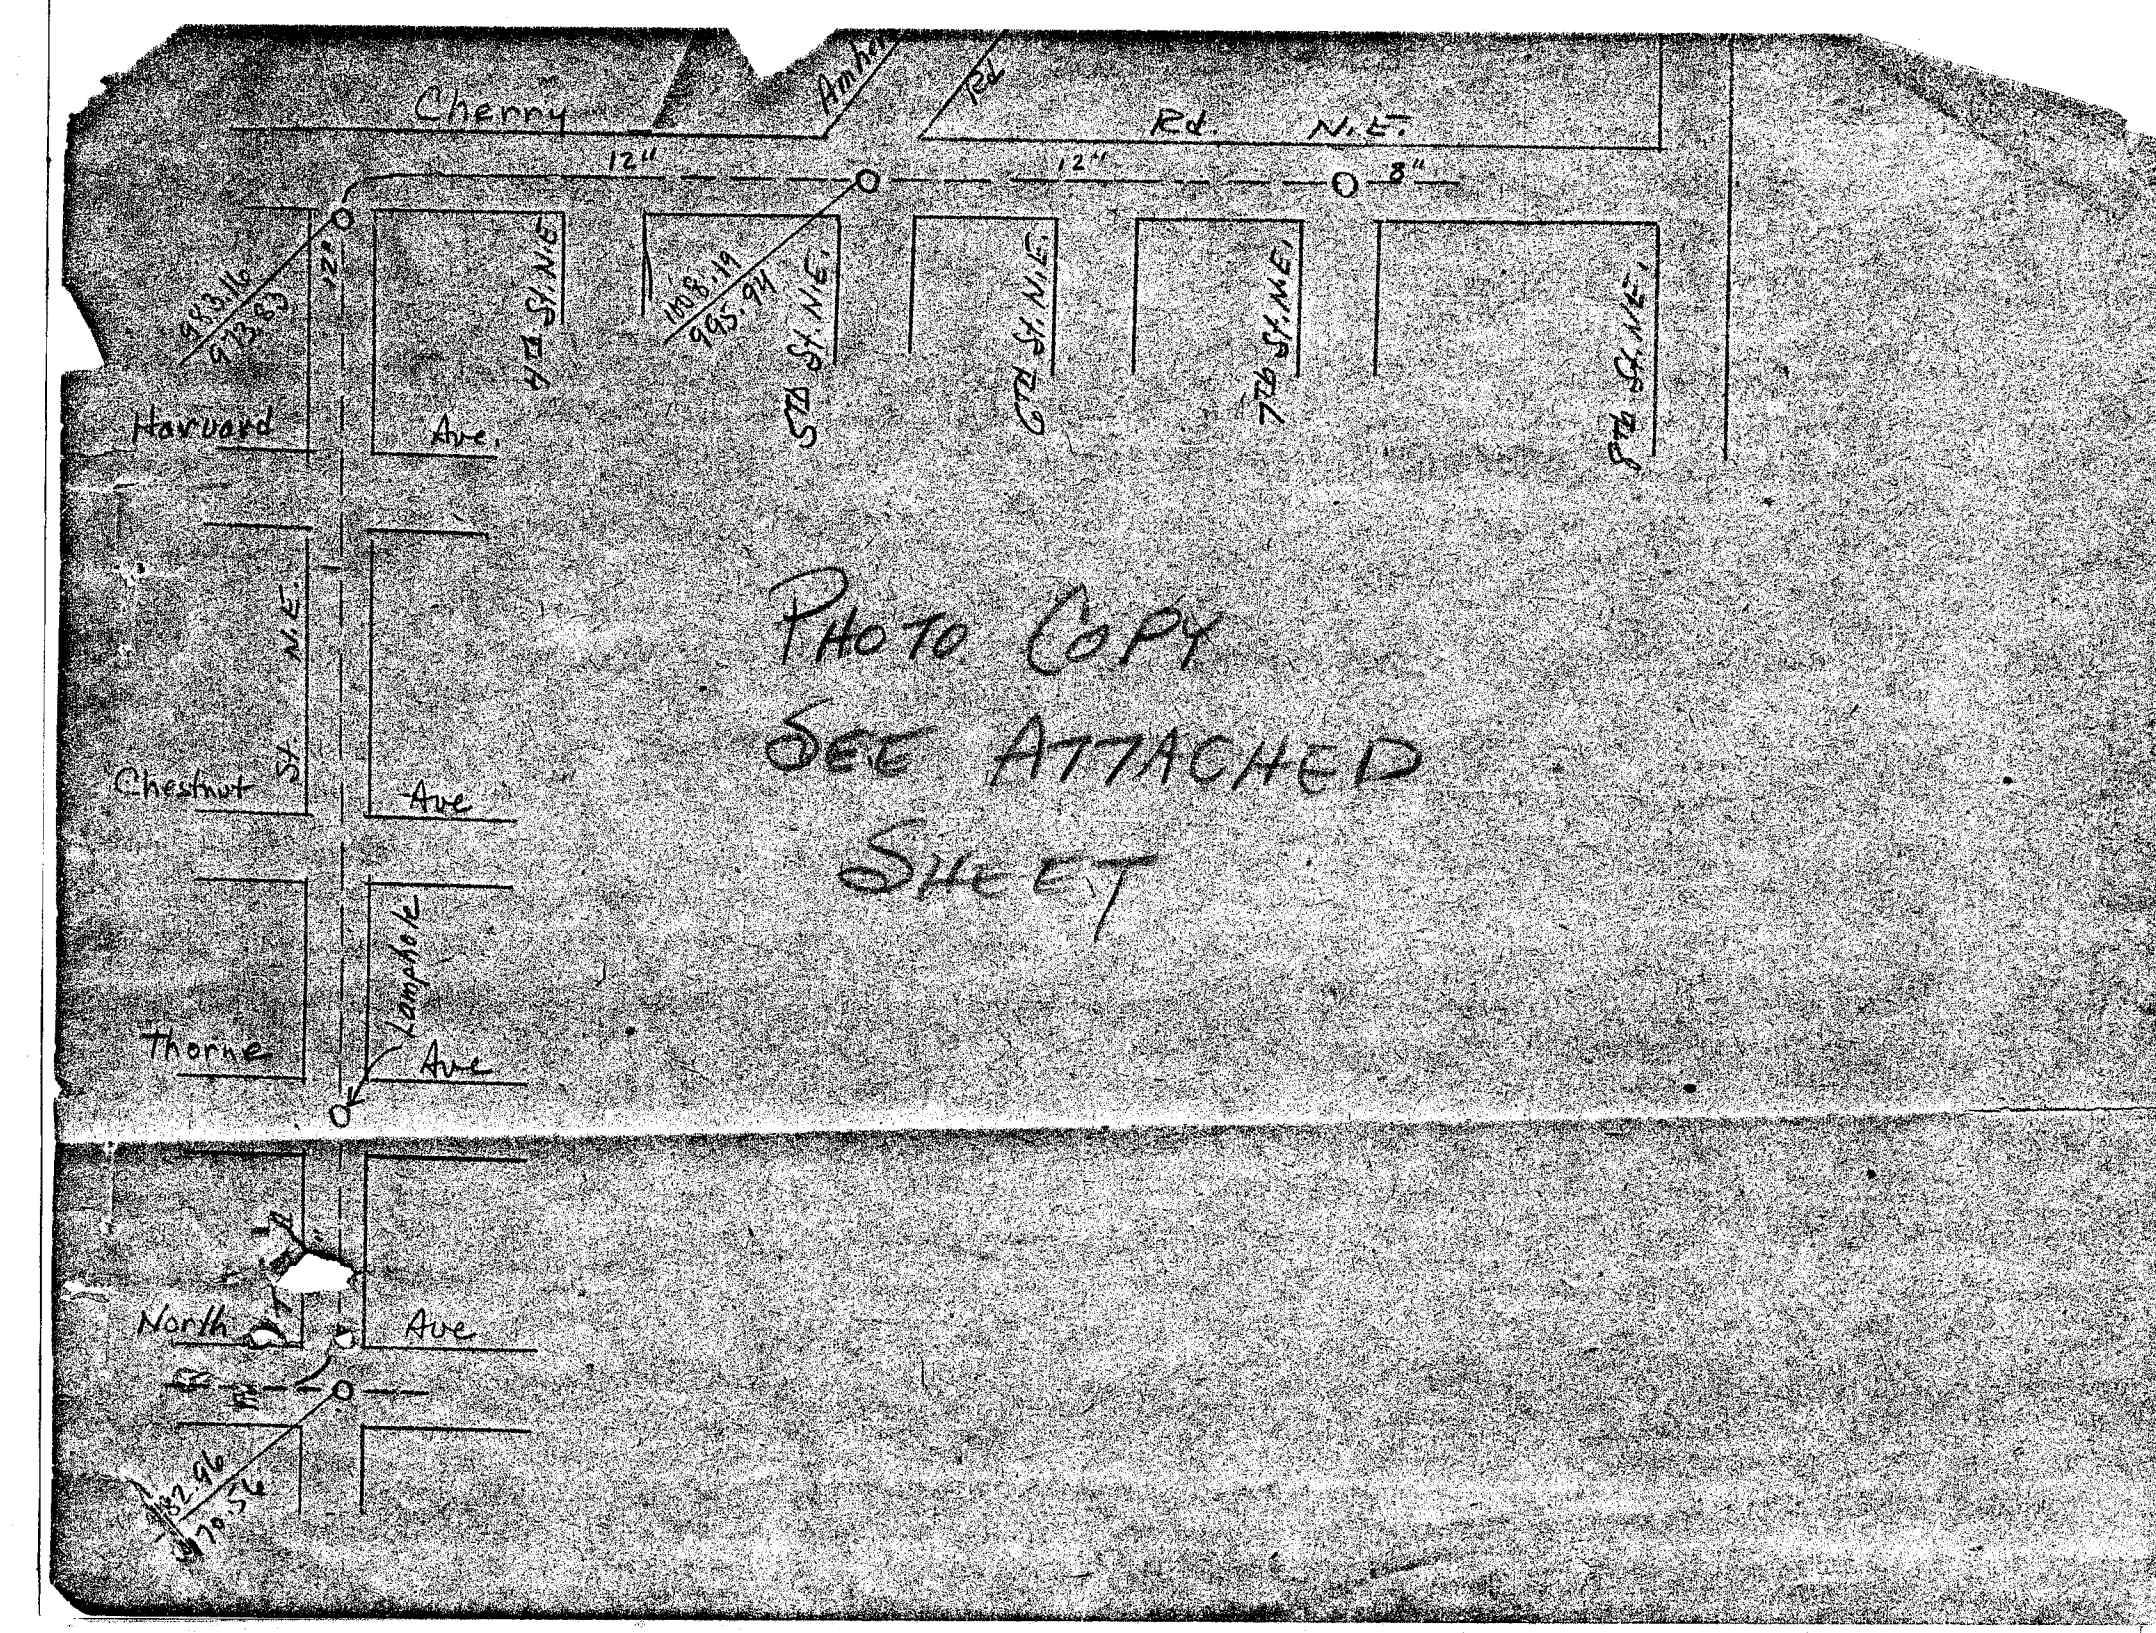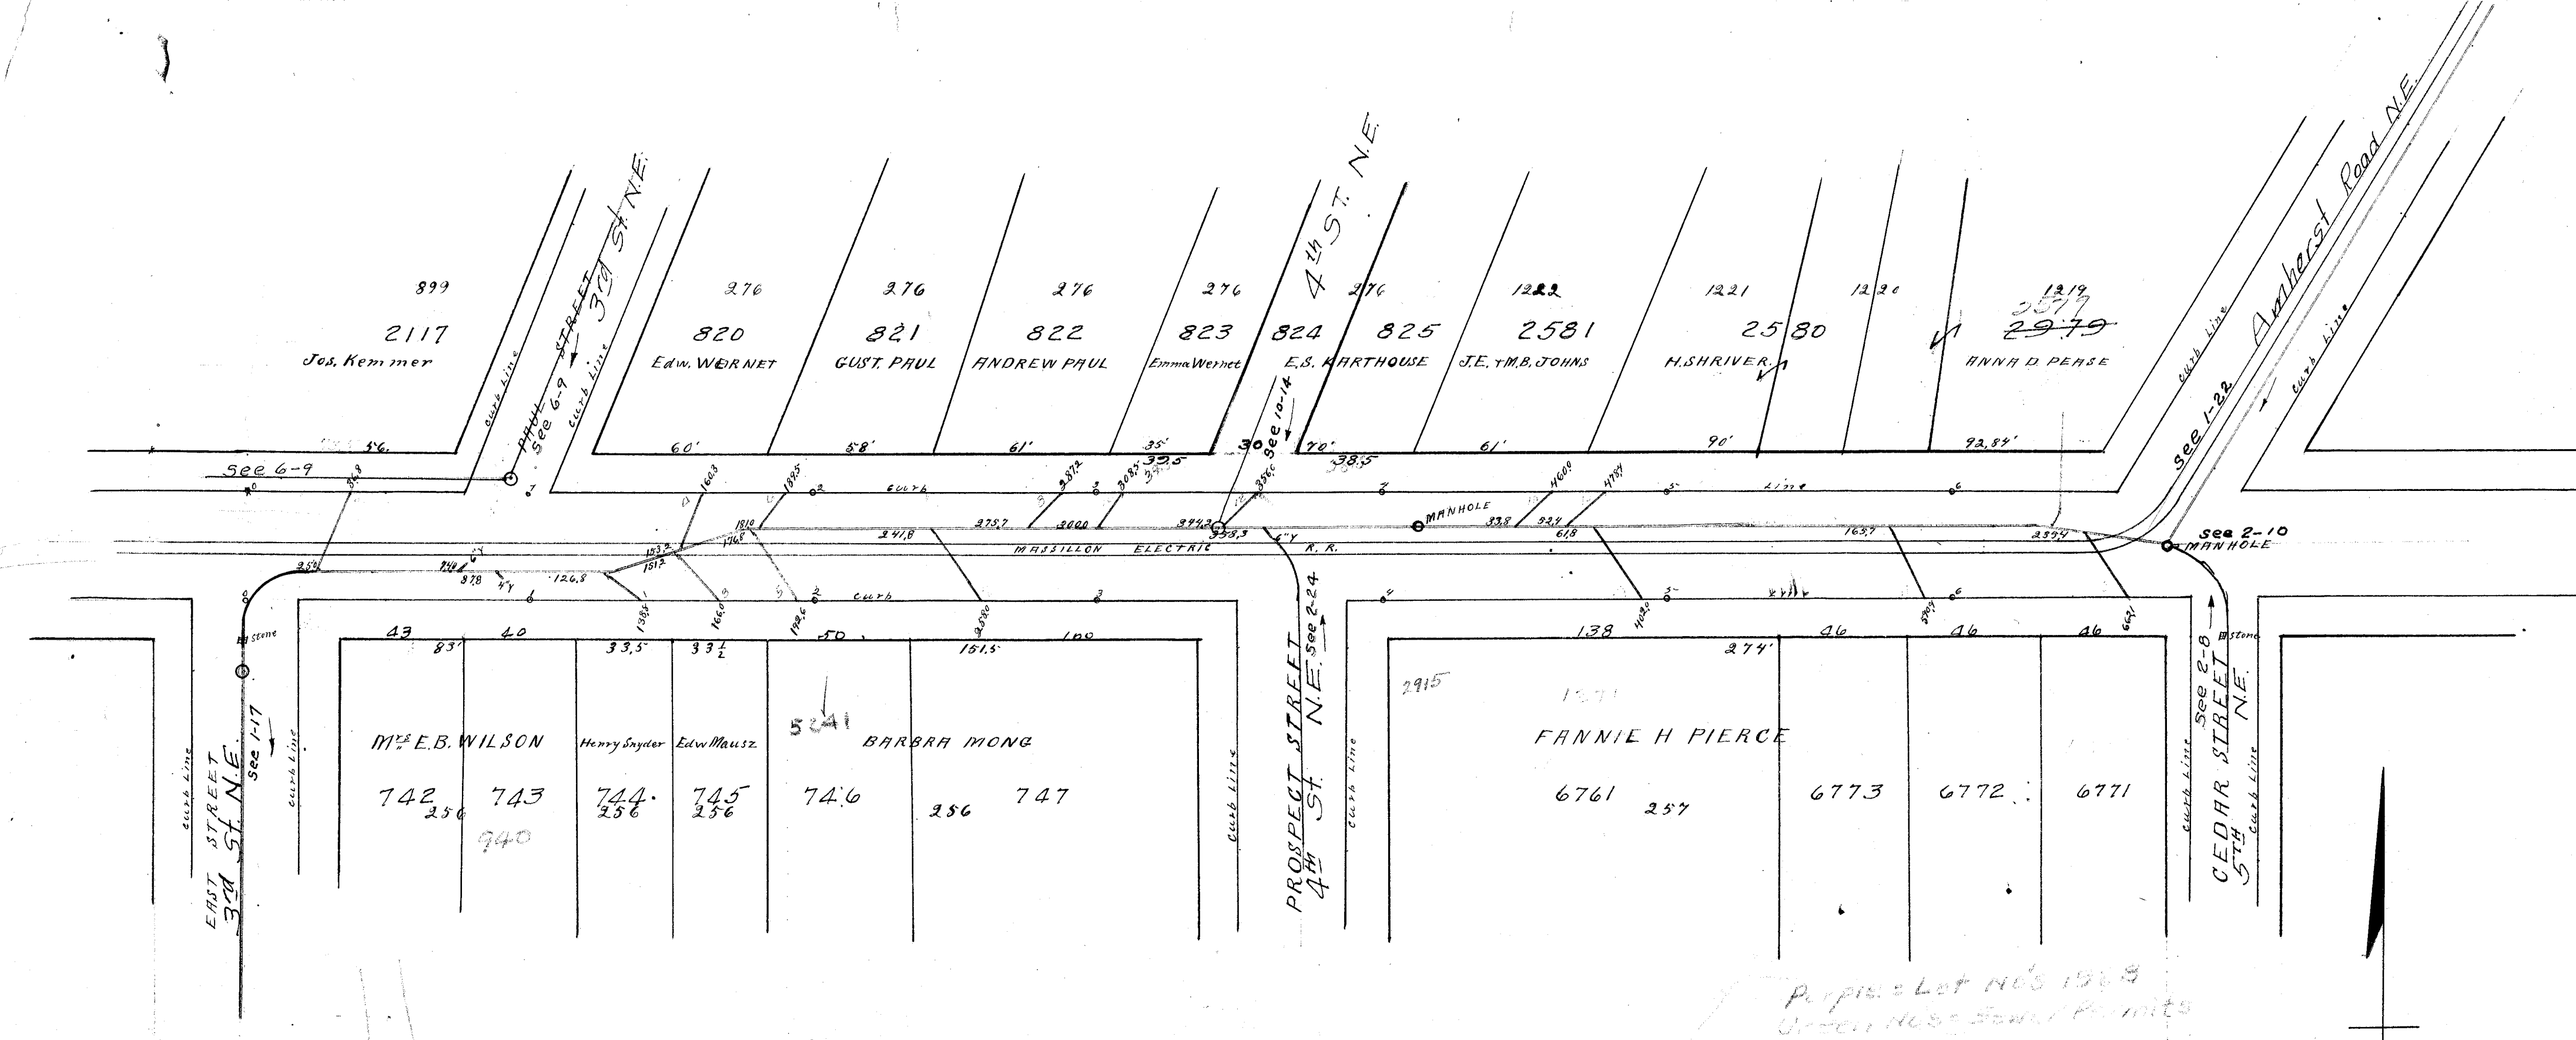

MEAS.
CHERRY RD. NE. Along curb line from the E. of 3rd St NE.


LAT	Lot No.	Side	Station	Remarks
2	2117	No.	0+36.8	
6" Y	820	"	0+74	6" WYE 3rd St NE.
4	821	"	1+60.5	
6	822	"	1+82.5	
8	823	"	2+87.2	
10	825	"	3+08.5	
12	825	"	3+56	
14	2581	"	4+60	
16	2580	"	4+78.1	
4" Y	743	So.	0+87.8	Blind Y.
1	744	"	1+32.8	
3	745	"	1+60	
5	746	"	1+92	
7	747	"	2+58	
6" Y		"	3+58.3	4th St NE.
9	6761	"	4+02	
11	6772	"	5+70.9	
13	6771	"	6+62.1	
	2579	North	Lat. at Curb 36° N. of Amberst sec. with saddle hub terrain (see map 161714)	

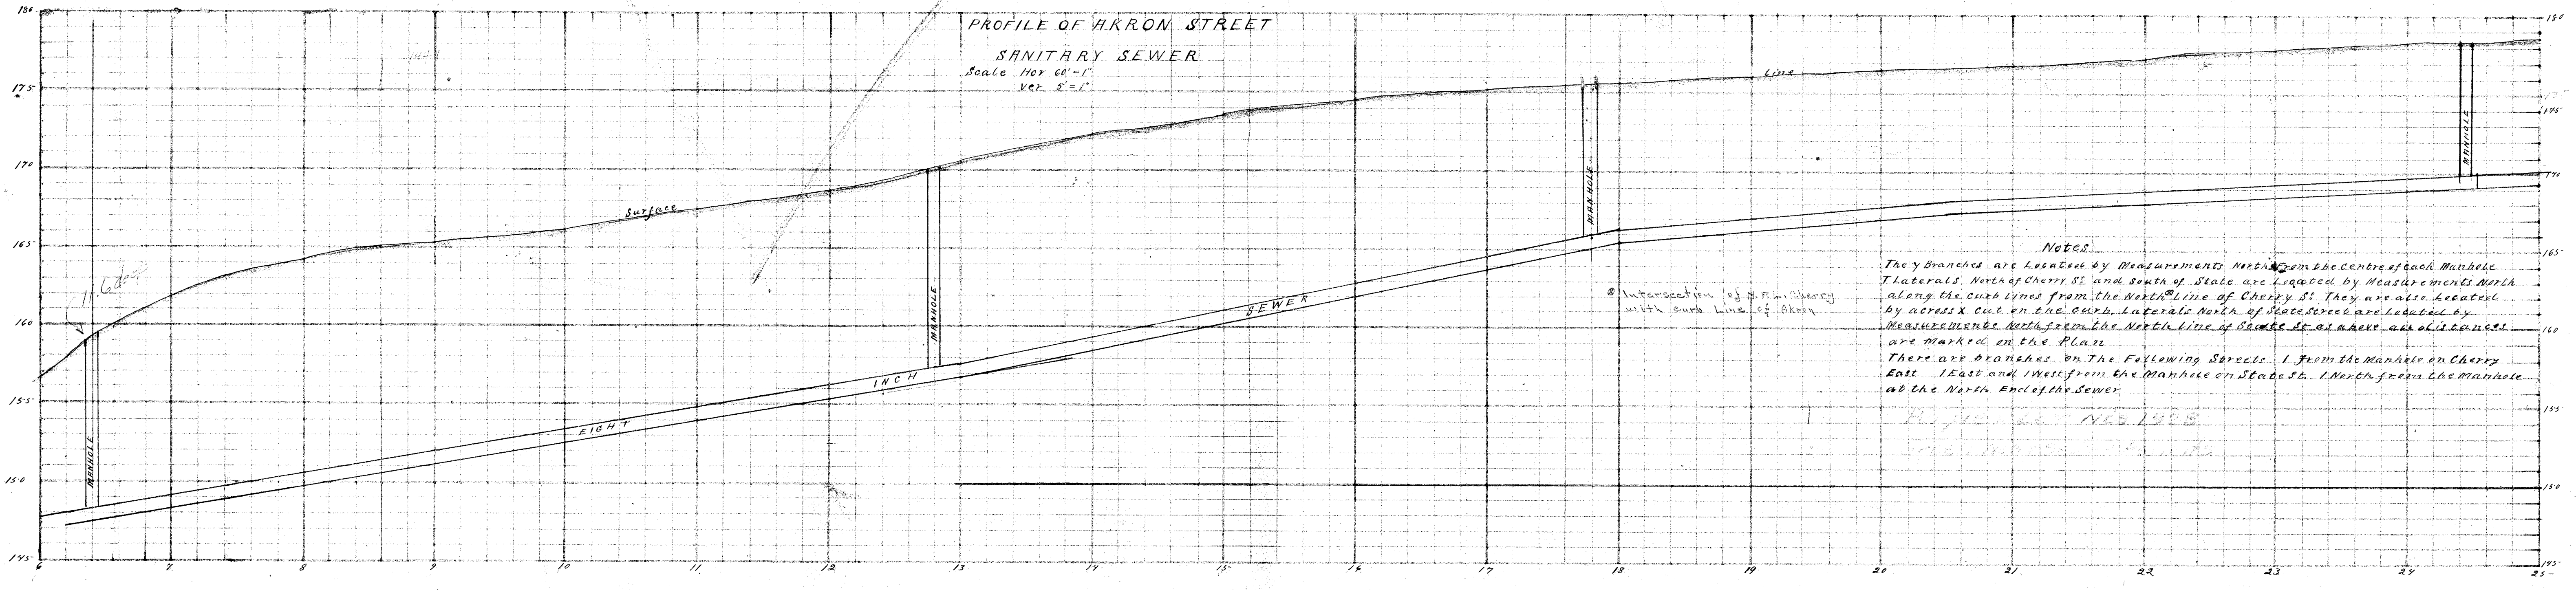


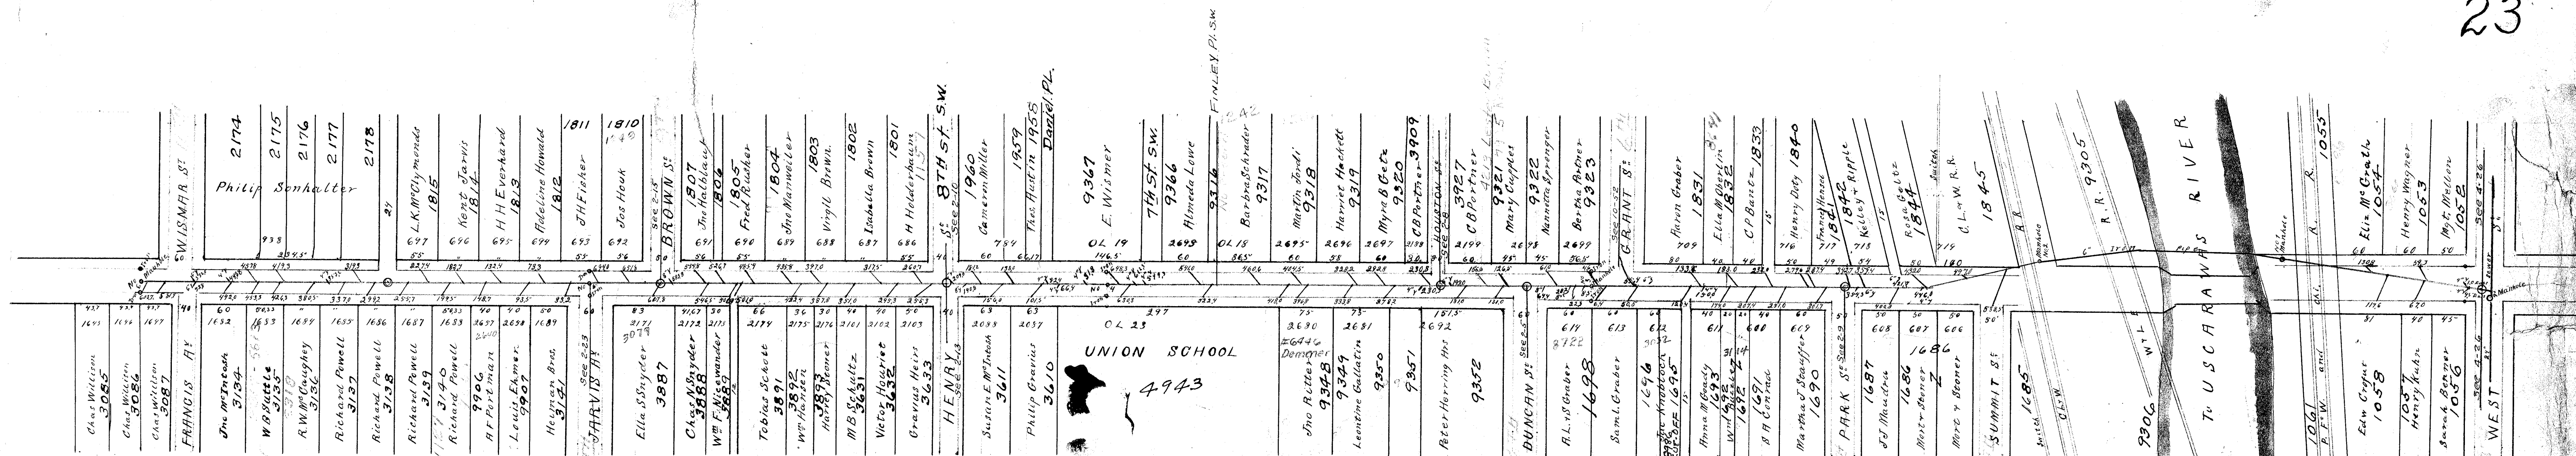

PLAN OF THE WEST TREMONT STREET
SANITARY SEWER

SHOWING LOCATION OF MANHOLE LATERALS AND Extra Y Branches
 Measurements East of the River as from the West to the West
 " " West of " " " N^o 3 Manhole EAST
 " " " N^o 3 Manhole to N^o 4 Manhole are West From N^o 3
 " " " N^o 4 " " N^o 5 " " " " 9
 " " " N^o 5 " " N^o 6 " " " " 3
 The laterals are Located along the curb line From Points at Right angles
 to the center line of the Sewer at the Center of the Manhole covers
 as above described
 There is 8' Pipe at N^o 8 Manhole For Jarvis AV
 See Next Page For Sewer from Wisconsin to Butler St
 Distances between Manholes N^o 2 to N^o 3 655.0' N^o 3 to N^o 4 647.7'
 N^o 4 to N^o 5 696.0' N^o 5 to N^o 6 660.0'

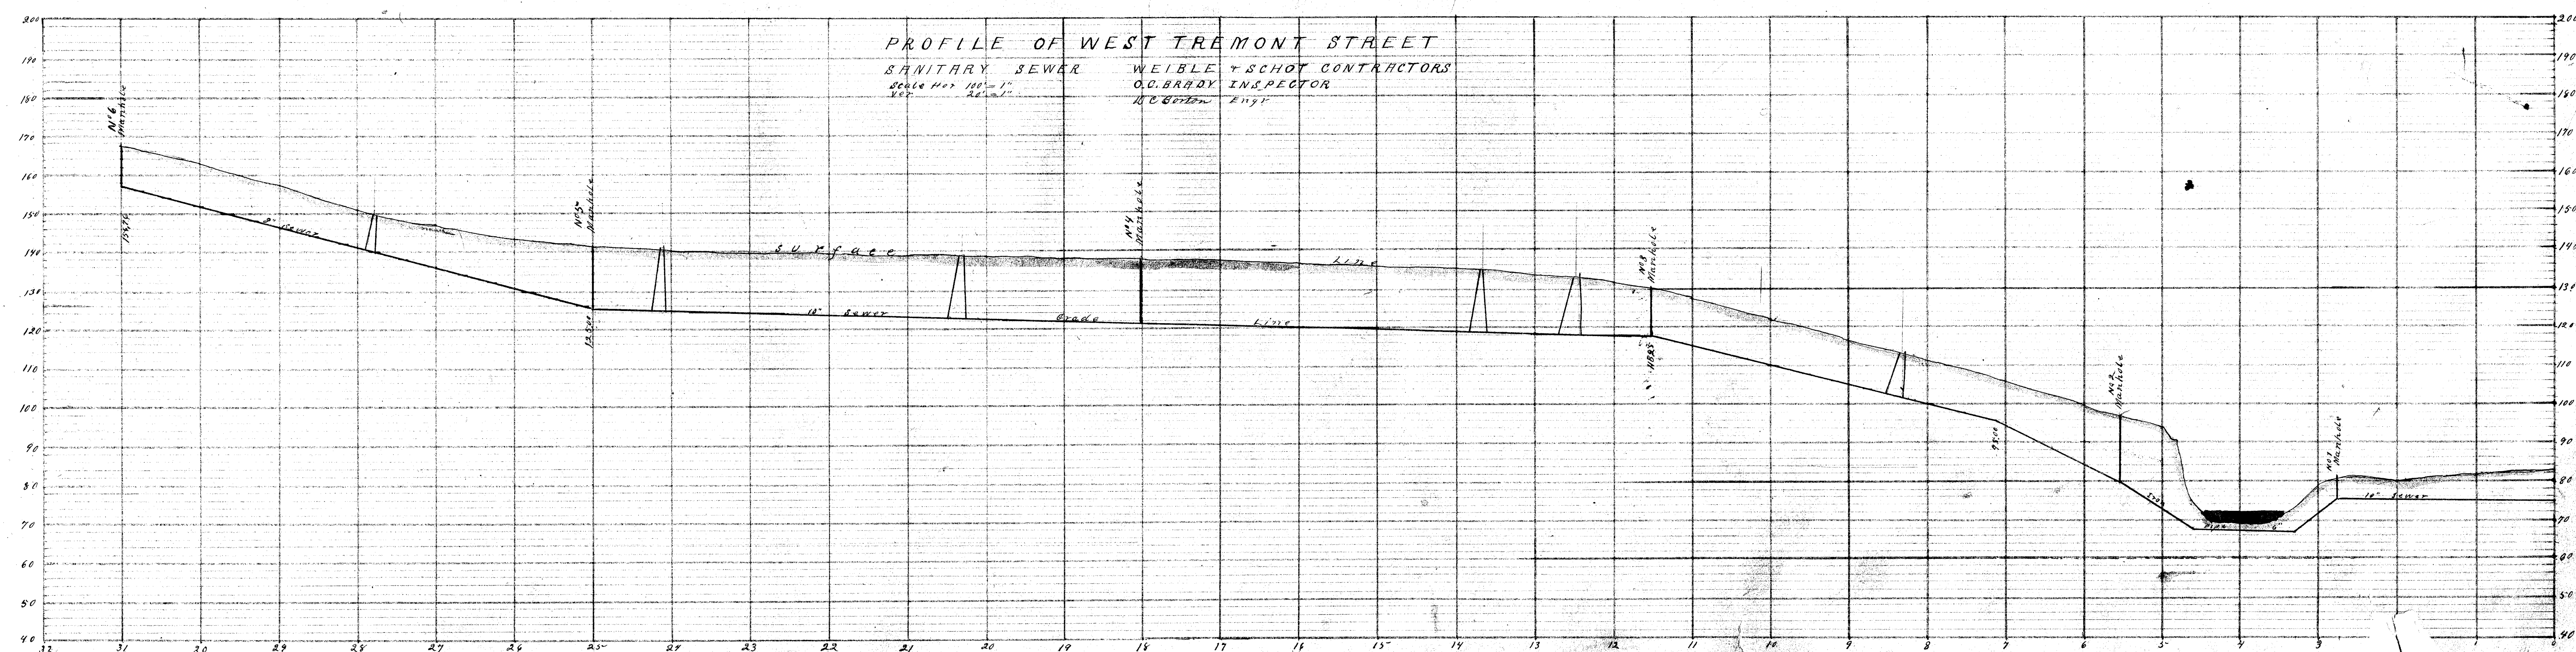

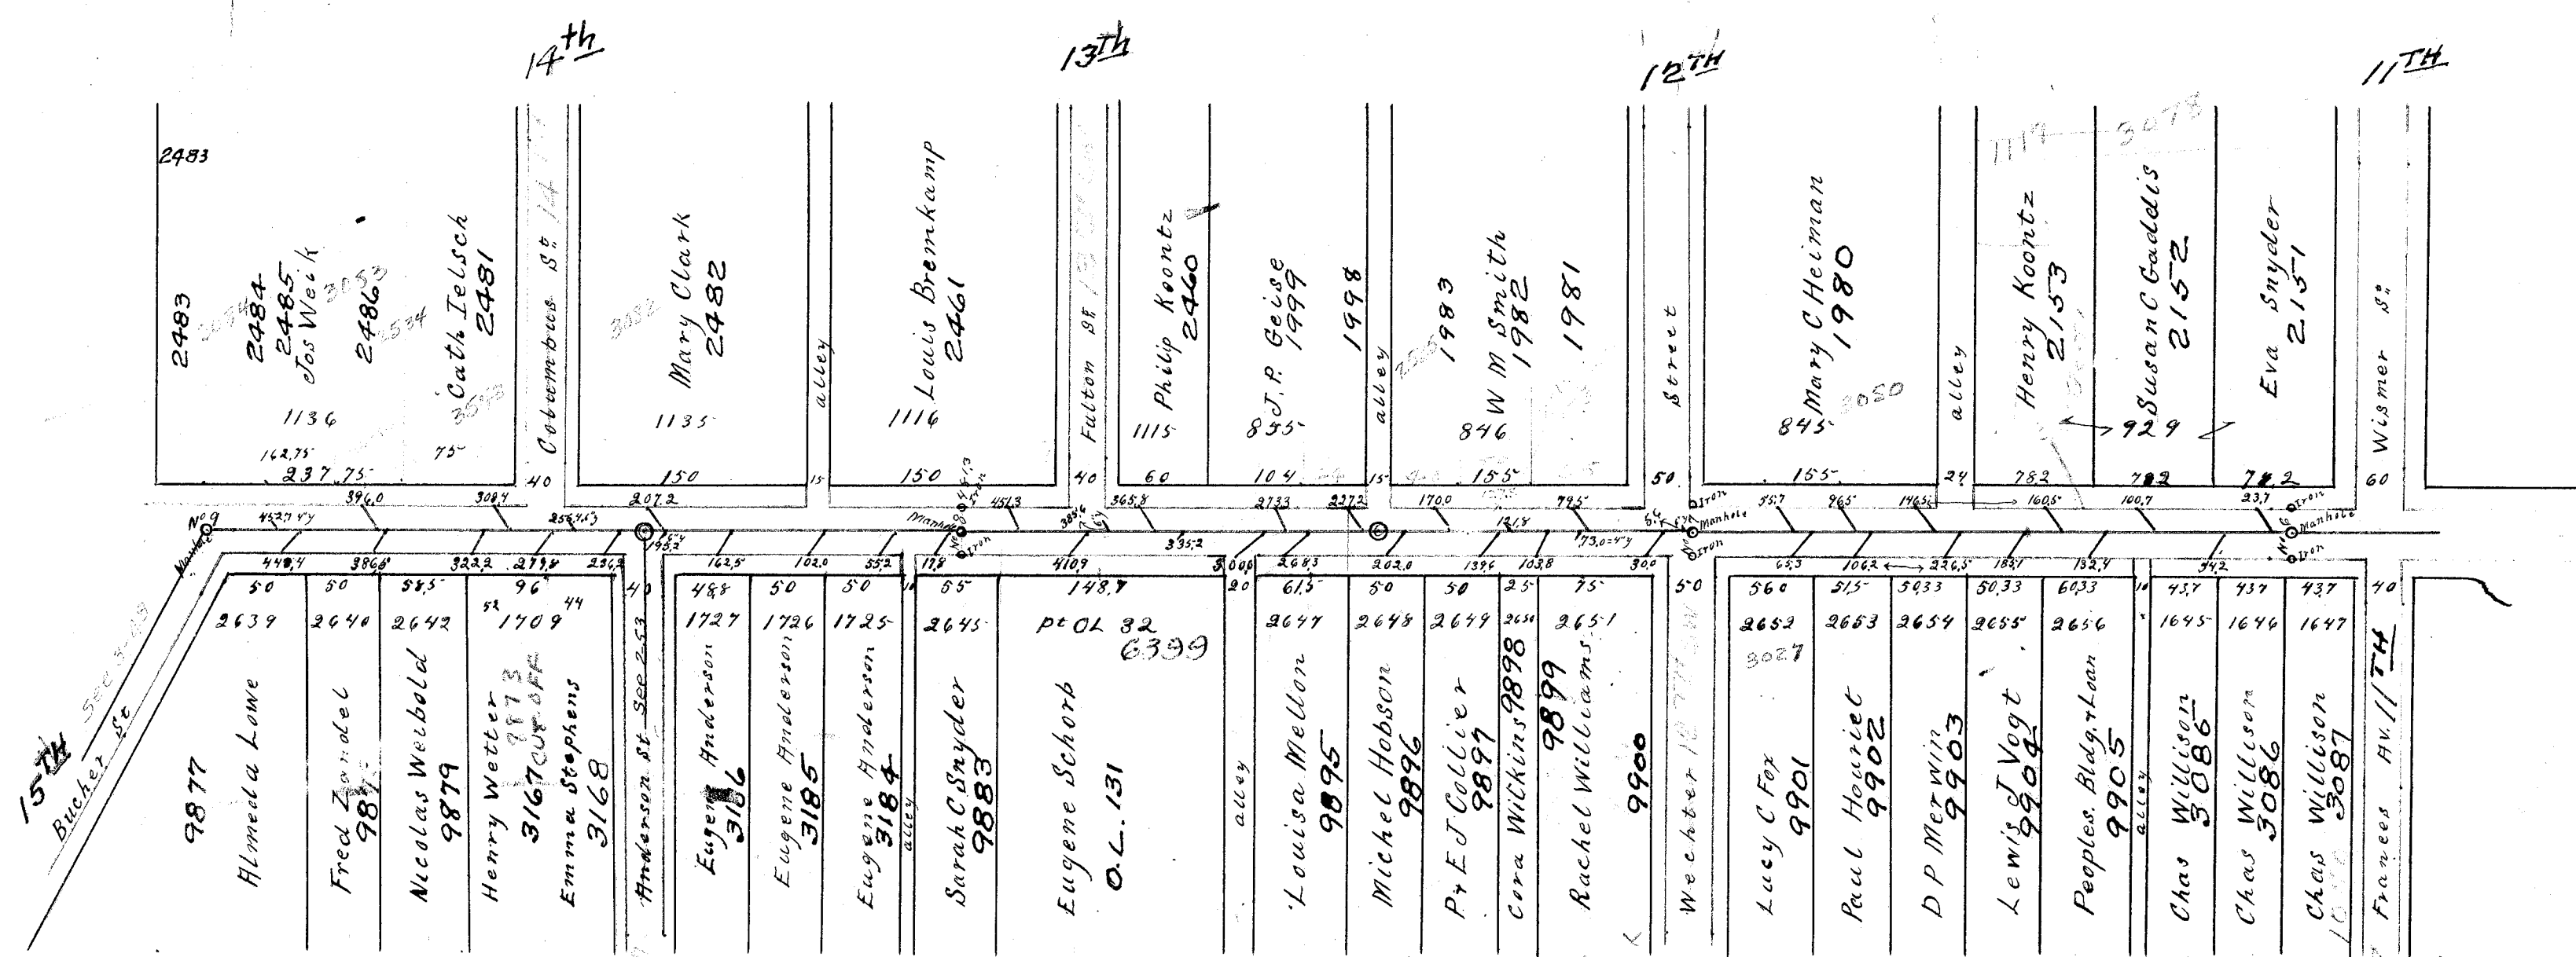

PLAN of WEST TREMONT ST. SANITARY SEWER FROM WISMER ST. TO BUCHER ST.
Showing Location of Manholes, Laterals and extra y branches.
Measurements are taken From Manhole N°6 West to the angle of the Street
and East From N°7 to the same angle. Then From N°7 West to N°8 and
West from N°8 to the End of the Sewer all Measurements taken from points at
Right angles to the centerline of the sewer at the center of the manhole covers.
Distances between Manholes are 64.7 392.8 74.8 481.1 8-9 498.6
Scale 1/4" = 1'

