


PENNOCK-OBERLIN AVE. **12" SANITARY SEWER**

FROM DUNCAN ST. TO INTERSECTION
OF EIGHTH & OBERLIN AVE. S.W.
LATERAL RECORD

LAT. No.	LOT NO.	SIDE	DPH.	X	STA.	REMARKS
M.H. #4					11+75	
1		S.	14		12+18 ^s	12" X 6" BLIND WYE
2		N.	14		12+22 ^s	" " "
M.H. #5					13 ^s 12+74	
3		S.	13 ^s		12+86 ^s	" " "
4		N.	13 ^s		12+90 ^s	" " "
5		S.	13		13+48 ^s	" " "
6		N.	13		13+52 ^s	" " "
7		S.	13		14+10 ^s	" " "
8		N.	13		14+14 ^s	" " "
9		S.	13		14+72 ^s	" " "
10		N.	13		14+78 ^s	" " "
11		S.	12 ^s		15+34 ^s	" " "
12		N.	12 ^s		15+38 ^s	" " "
M.H. #6					13 ^s 15+85	
13		S.	12 ^s		15+97	" " "
14		N.	12 ^s		16+01	" " "
15		S.	12		16+59	" " "
16		N.	12		16+63	" " "
17		S.	12		17+21	" " "
18		N.	12		17+25	" " "
M.H. #7					12 ^s 18+72	

STARTED JAN. 1937 - COMPLETED JAN. 1938.
BUILT BY W.P.A. LABOR - JULIUS WITTMAN
FOREMAN TO STA. 15+82 - JULIUS MOLSEN
TO STA. 18+98 - CALKITE JOINTS USED.
DESIGNED BY CITY ENGINEERING DEPT.
C.E. RICE - CITY ENGR. - H. PIPER - CONST. ENGR.
PRELIM. NOTES - N.B. 132 - PAGE 10
CONSTR. NOTES - N.B. 133 - PAGE 57-61 incl.
FINAL NOTES - N.B. 131 - PAGE 78
PLOTTED JAN. 28, 1938 BY H. PIPER.
SCALE: 1" = 5' VER. - 1" = 50' HOR.

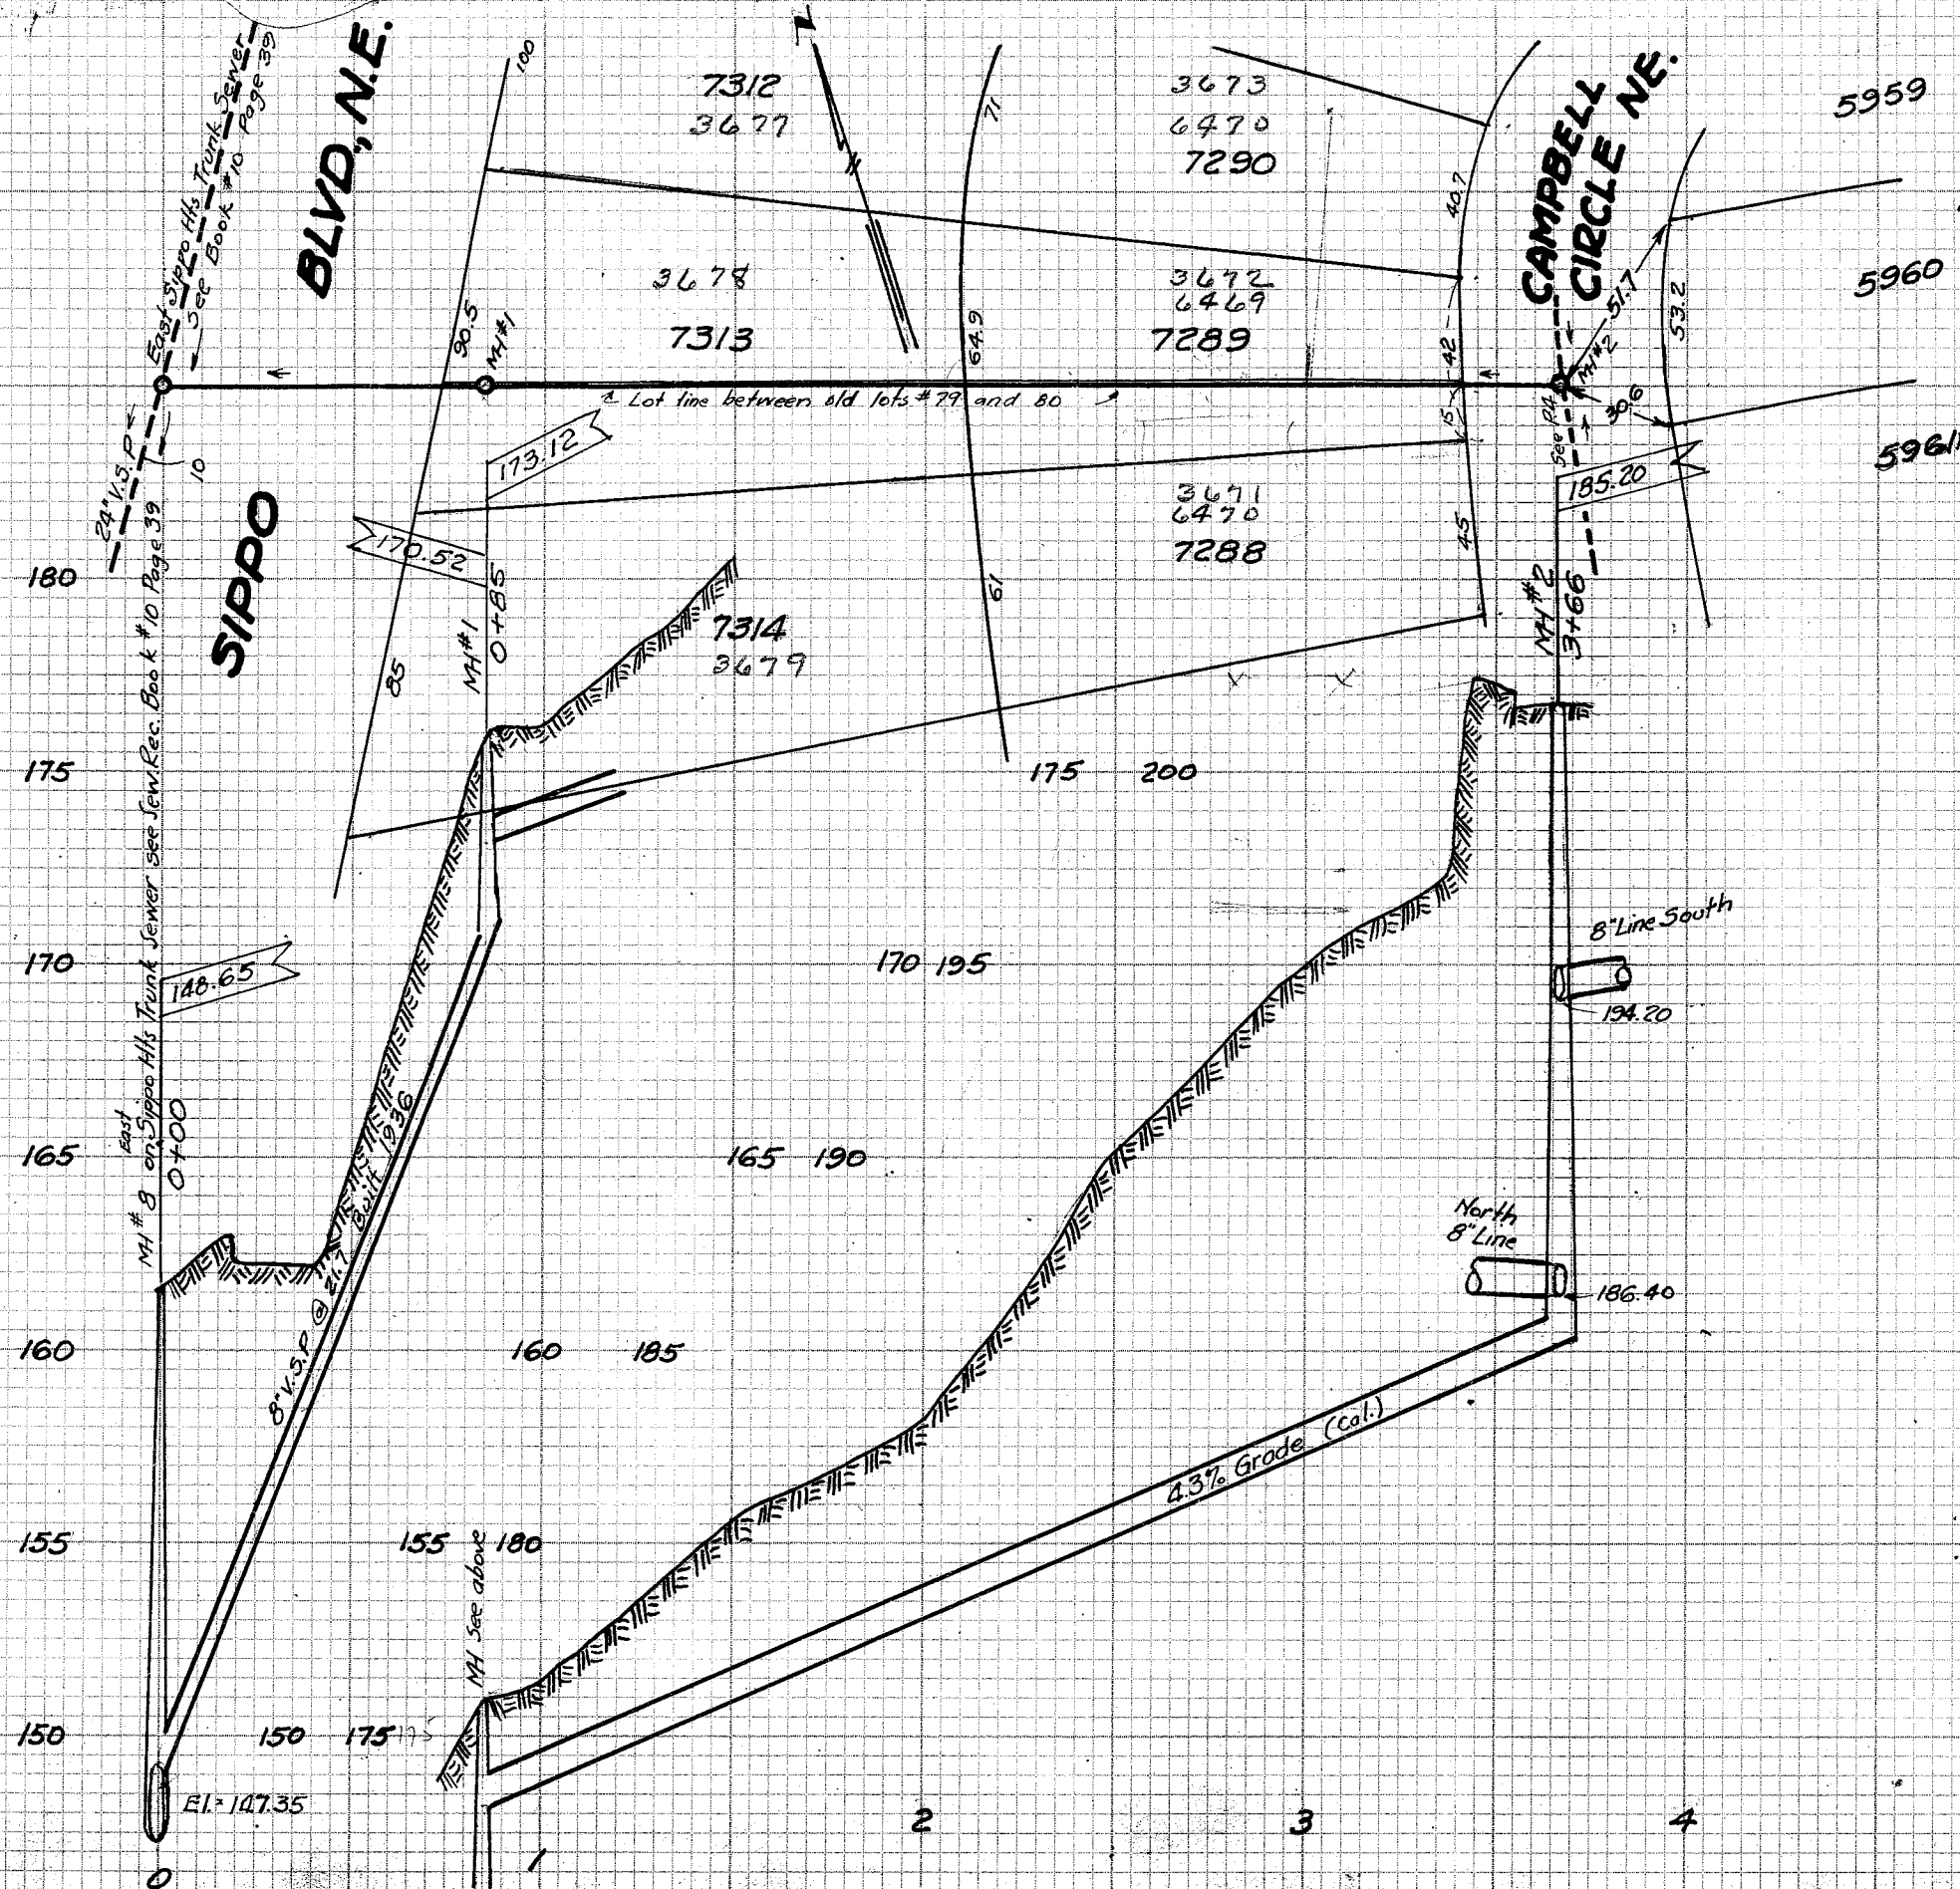

Note: Do not guarantee any dimensions

SIPPO HEIGHTS SEWER SYSTEM

The lateral locations were taken from an old blue print with the laterals, mains, and distances from the old property lines shown in red ink.

I made notes as I found the records. Profiles, Manhole depths, taken from a field survey in Note Book 138, Pages 2 to 8 incl. by Harry Piper & Herbert Shertzer - Plotted by Geo. Wallace Feb 1938 - Blue print of this was furnish by Clarence Hostetter, this print is the only one in existence at present.

All laterals seem to run within a few feet of property line (Street) distances seem to indicate the end of each lateral, some lots dont show any laterals going to them.

The grade of the mains where assumed to be going straight between manholes. The plan indicated that the mains are close to the center lines of the street.

Data in red old lots, purple sanitary sewer lines and distances.

Checked by H. Piper and H. Shertzer Feb 24 1938

4" Laterals