



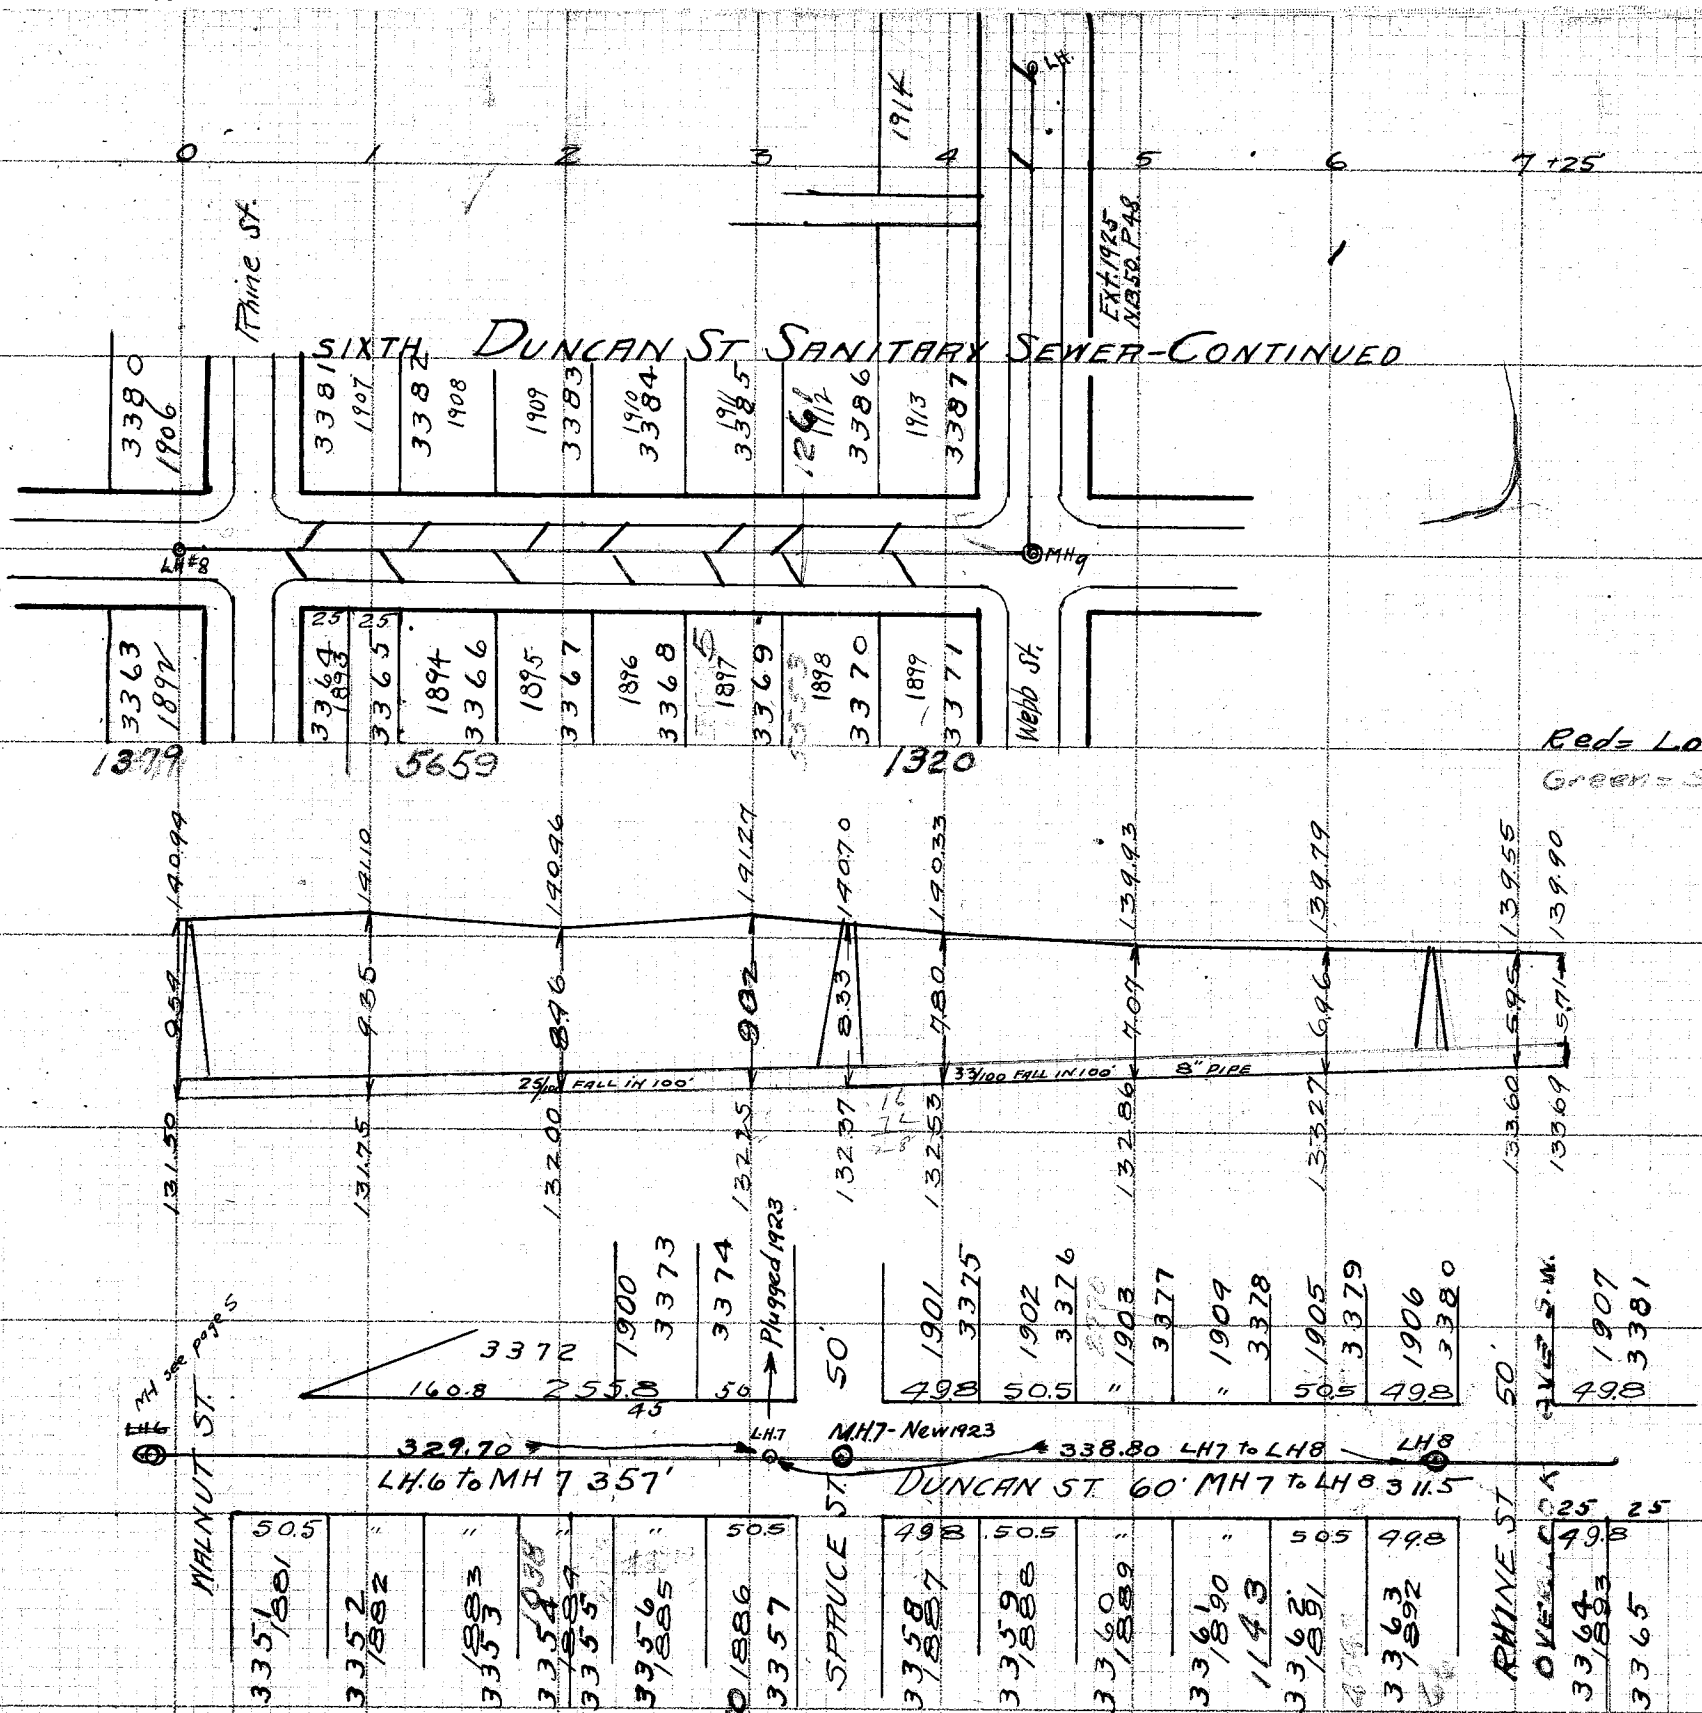

PLAN AND PROFILE
— WALNUT ST. SANITARY SEWER —
FROM DUNCAN ST. TO A POINT 625' WEST
Constructed
Contractor
Price of main per ft.
Price of Lateral per ft.
Const. notes note book #3 page 92.

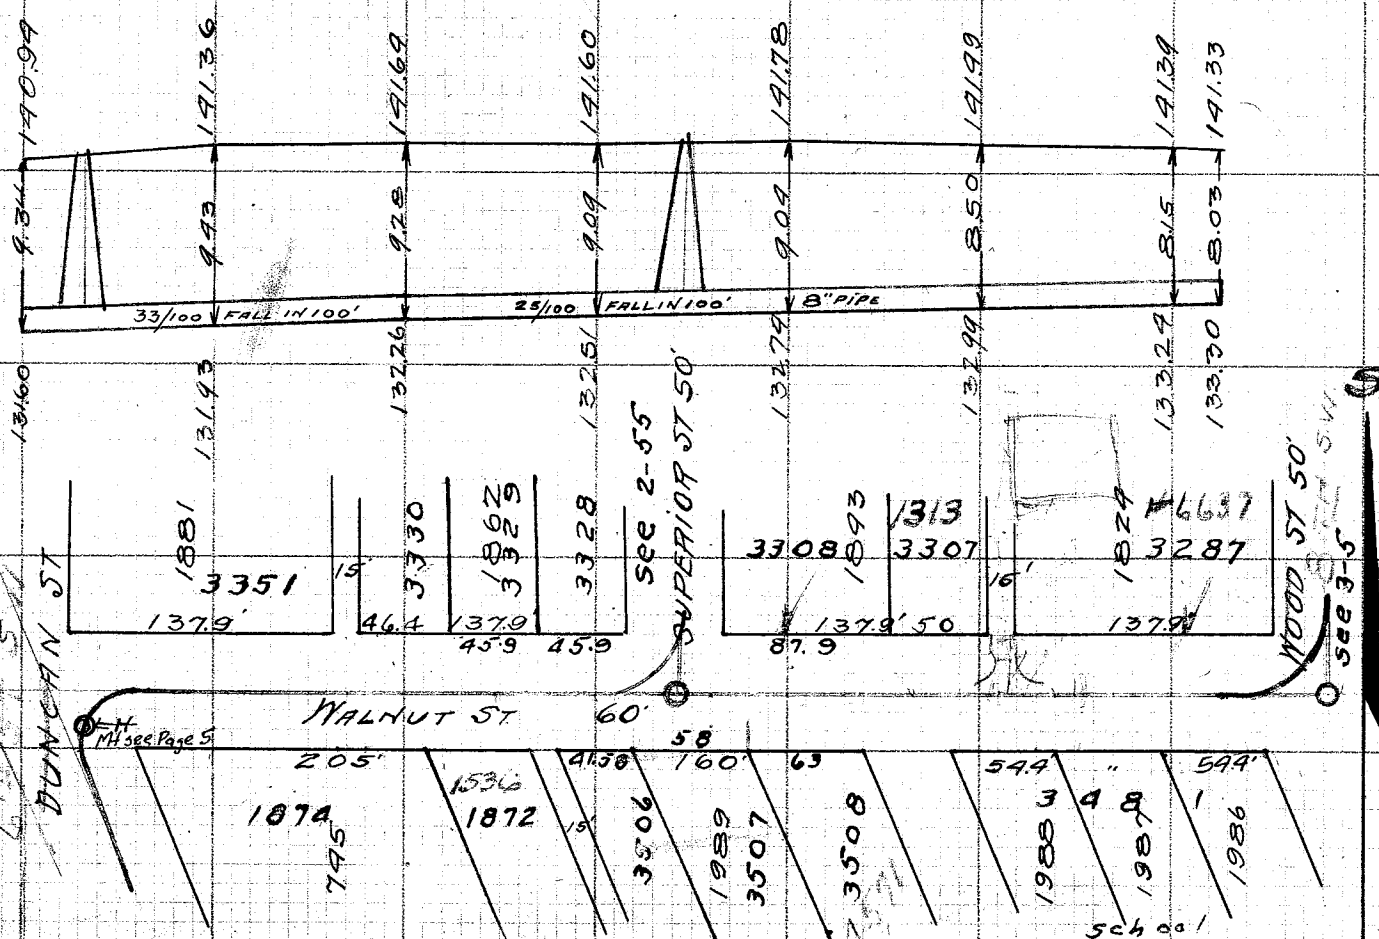

WALNUT STREET
FROM WEST CURB OF DUNCAN ST.

S. SIDE	N. SIDE
46.0'	279.6'
109.1'	338.8'
176.0'	605.3' School
219.4'	
271.5'	
388.8'	
598.0'	

M.H. at End Walnut St. Sewer to Edna St. 148.5' Superior Y 292.5'

WORK SHOWN IN GREEN DONE IN 1930
IN CONN. WITH PAVING OF WALNUT RD.
BY URBAN BROS.