


LATERAL RECORD

LLAT	LOT NO	SIDE	DPH	X	STATION	LOT NO	REMARKS
FROM	STRATFORD AVE	N.E. SOUTH					
M.H.			12.0		0+00		STRATFORD AVE N.E.
1	6715	W	7.5	15.0	1+70		8341
2	7900	E	6	10.0	2+17		8579
3	6714	W	6	16.0	2+18		8340
4	7899	E	5.5	10.5	2+72		8578
5	6713	W	5.5	13.0	2+74		8339
7	6712	W	6.5	6.0	3+27		8338
M.H.	#1		7.6		3+30		
6	7898	E	6.0	18.0	3+43		8577
FROM	STRATFORD AVE	N.E.					NORTH
M.H.			12		0+00		STRATFORD AVE N.E.
8	0.L. 250	E	6.0	15.0	2+37		0.L. 348
9	0.L. 250	W	6.0	15.0	2+37		" 349
10	0.L. 250	E	6.5	19.0	2+97		" 348
11	0.L. 250	W	7.0	14.0	3+06.5		" 349
M.H.	#1		8.6		3+13		CLAREMONT AVE. N.E.
13	0.L. 250	W	7	15.0	3+51		" 348
12	0.L. 250	E	6.5	16.0	3+37		" 348
14	0.L. 250	E	6.5		4+10		" 349
15	0.L. 250	W	7	15.0	4+11		" 348
16	0.L. 250	E	6.5	15.0	4+55		" 349
17	0.L. 250	W	7	15.0	4+60		" 349
M.H.	#2	DROP	7.3		5+69		8819
19	7883	W	7.0	16.0	5+86		PROVIDENCE RD N.E.
M.H.	#2		8.4		7+15		BLIND Y INSP RECORD
17A	0.L. 250	W			4+93		" 348

COVENTRY ROAD N. E. ✓
PROVIDENCE RD. N. E. 1045 FT SOUTH
PORTION SHOWN IN PURPLE BUILT IN 1927 BY P. E. BICKEL FOR THE
CHARITY ROTCH DEVELOPMENT CO. PORTION SHOWN IN GREEN BUILT
IN 1927 BY JULIUS WITTMAN FOR M. P. L. KIRCHOFFER BOTH UNDER
SUPERVISION OF THE CITY ENGINEERING DEPARTMENT. C. E. RICE
CITY ENGINEER. WM. BELKNAPP AND WM. DEWALT CONSTRUCTION
ENGINEERS. F. B. JONES INSPECTOR. CONSTRUCTION NOTES FIELD
BOOK 66 PG 59 & 69 PG 56 & 67 PG 51 FINAL MEASUREMENTS
FIELD BOOK 62 PGS 55-57 & 72 PG 2. INSPECTORS RECORD NO
153 PG 6 & 22 PG & 103 PG 12. PLOTTED JAN 3 1928 BY C.
E. RICE SCALES H 1"=50' V 1"=5'

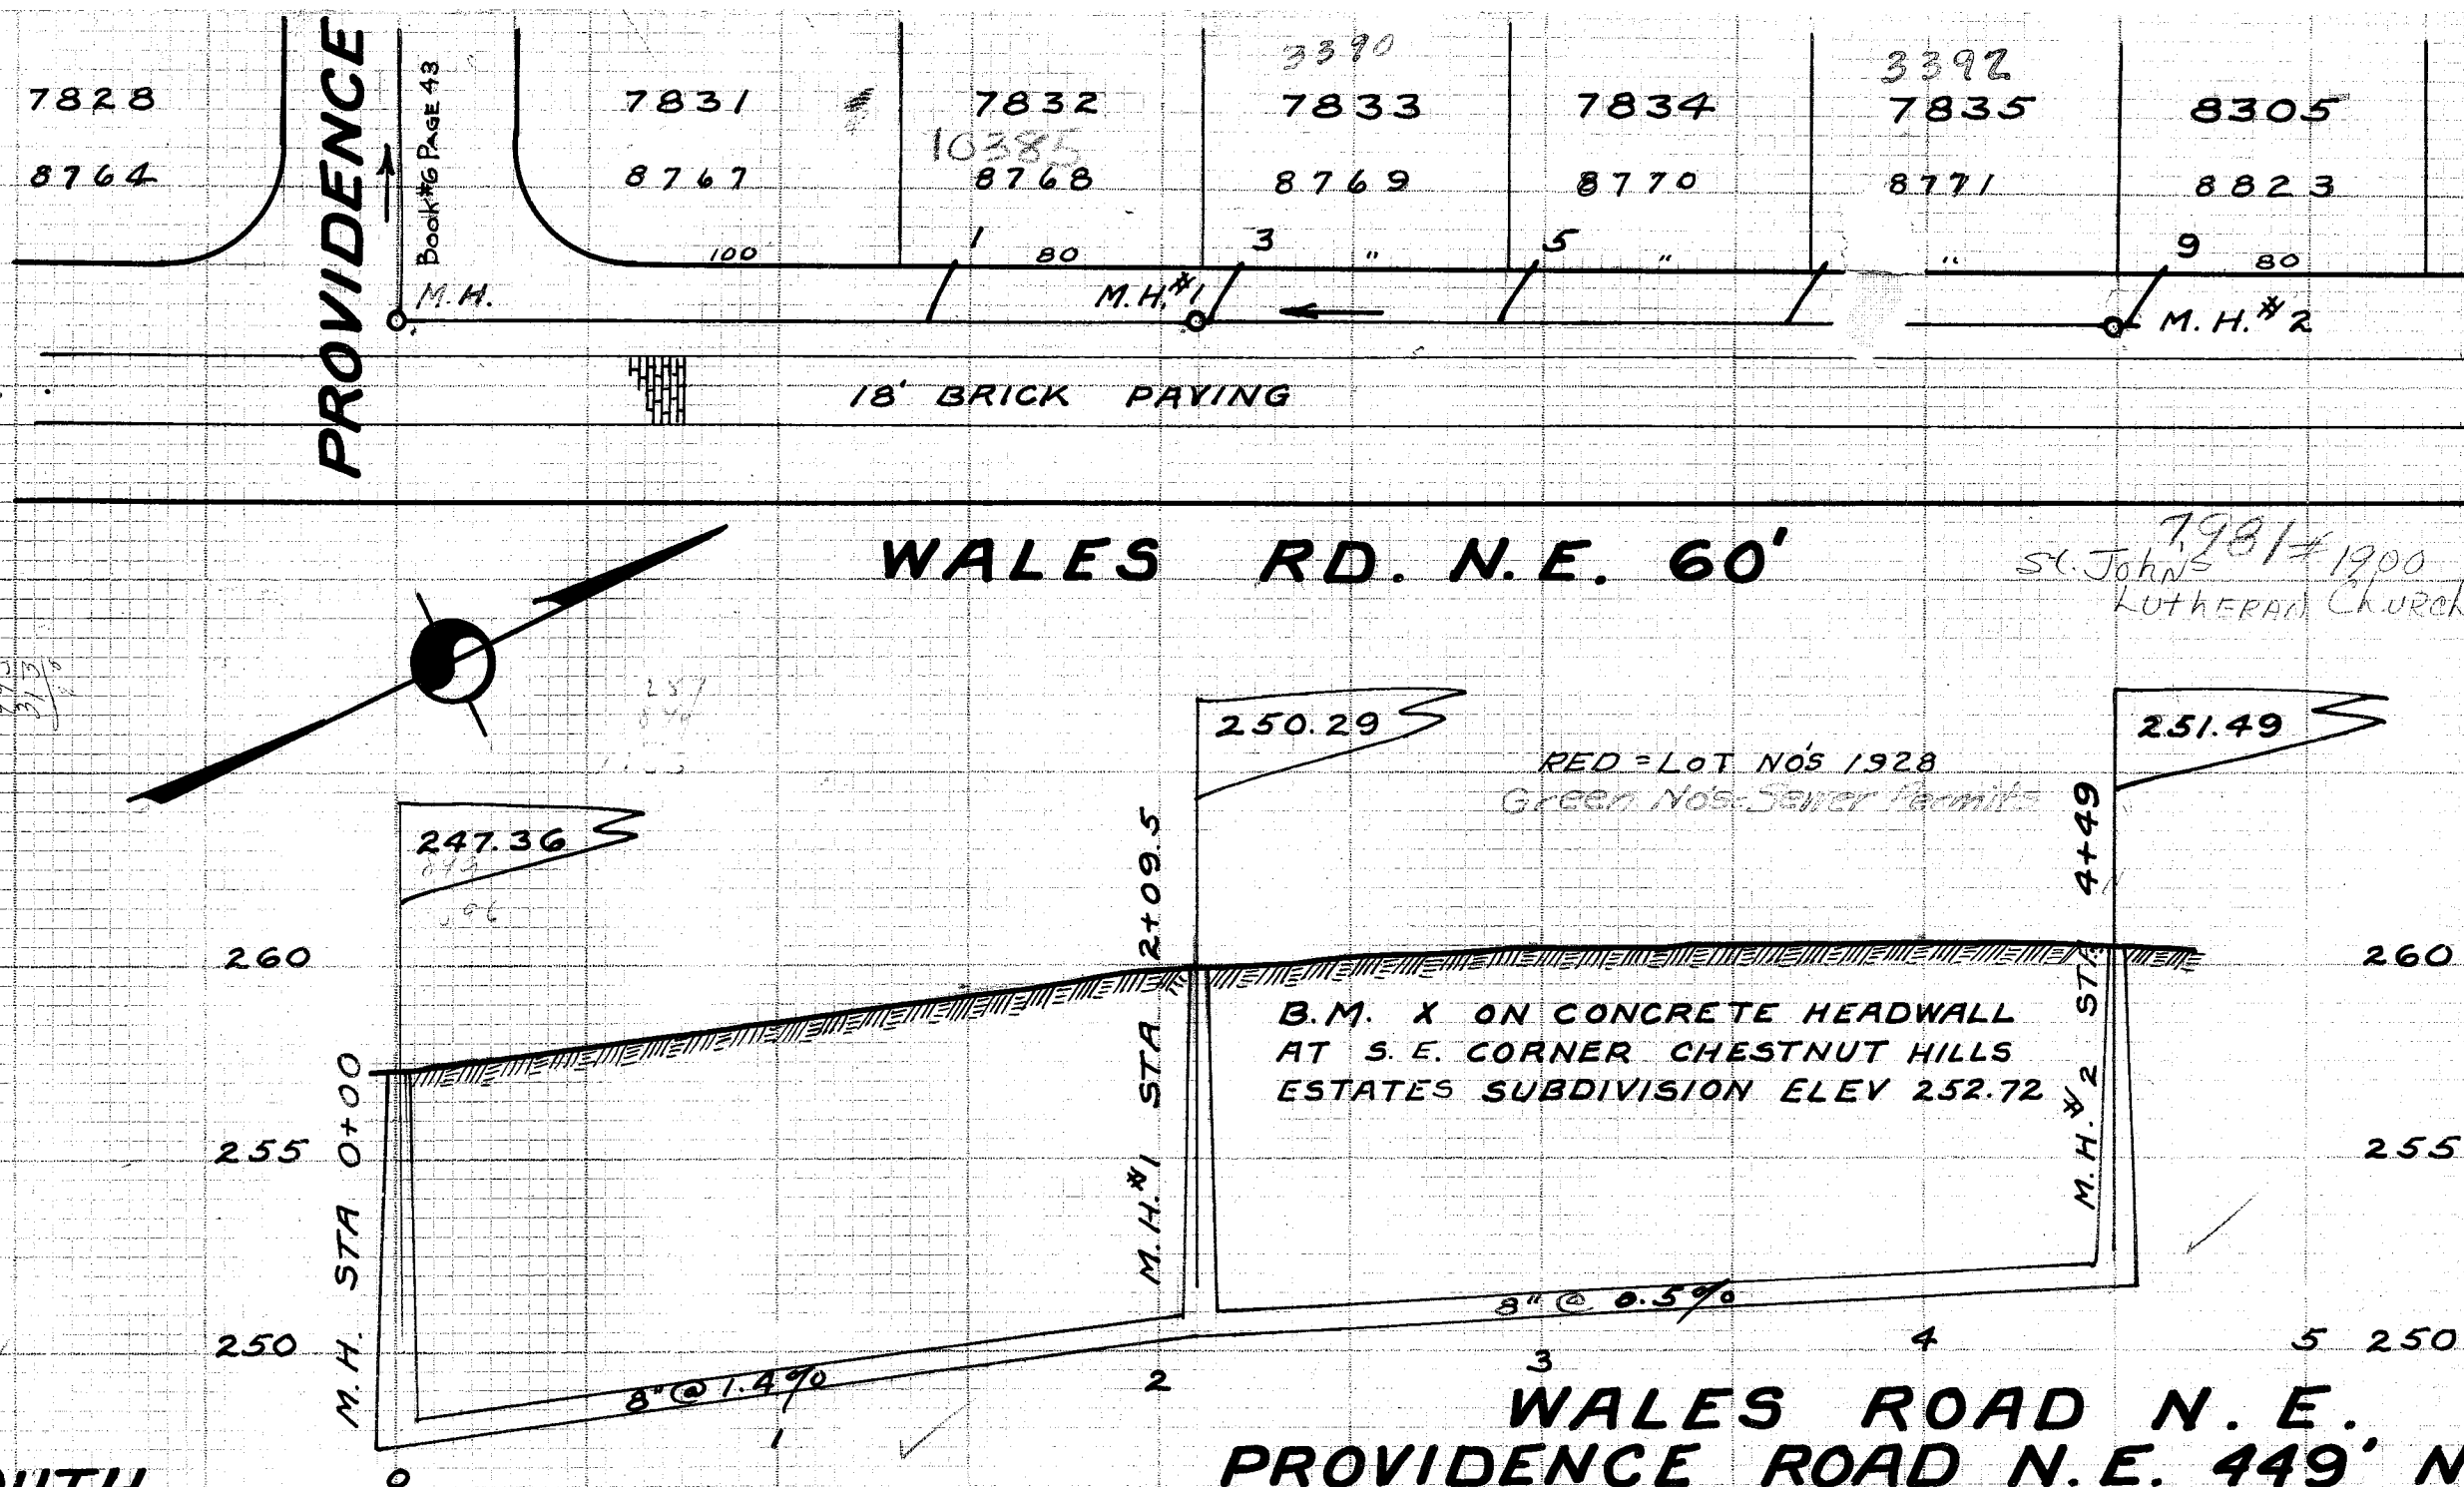

LATERAL RECORD

LLAT	LOT NO	SIDE	DPH	X	STATION	LOT NO REMARKS
M.H. 1	7832	W	10.2	15	0+00	PROVIDENCE RD N.E.
M.H. 3	* 1 7833	W	10.0	15	1+46 2+09.5	8768
5	7834	W	11	15	2+20.	8769
7	7835	W	9	15	2+97	8770
M.H. 9	* 2 8305	W	9.4	15	3+74 4+49 4+60	8771 8823

**WALES ROAD N. E.
PROVIDENCE ROAD N. E. 449' NORTH**
BUILT 1927 BY JULIUS WITTMAN FOR M. P. L. KIRCHOFFER UNDER
PLANS MADE BY AND SUPERVISION OF CITY ENGINEERING DE-
PARTMENT. C. E. RICE CITY ENGINEER. WM. DEWALT CONSTRUCT-
ION ENGINEER. JOHN EHMER INSPECTOR. PRELEMINARY NOTES
FIELD BOOK NO 61 PGS 7 & 8. CONSTRUCTION NOTES FIELD
BOOK NO 67 PG 58. FINAL MEASUREMENTS FIELD BOOK NO
62 PG 70. INSPECTORS RECORD NO 22 PG. 8. PLOTTED JAN.
3 1927 BY C. E. RICE. SCALES V 1"=5'. H 1"=50'