


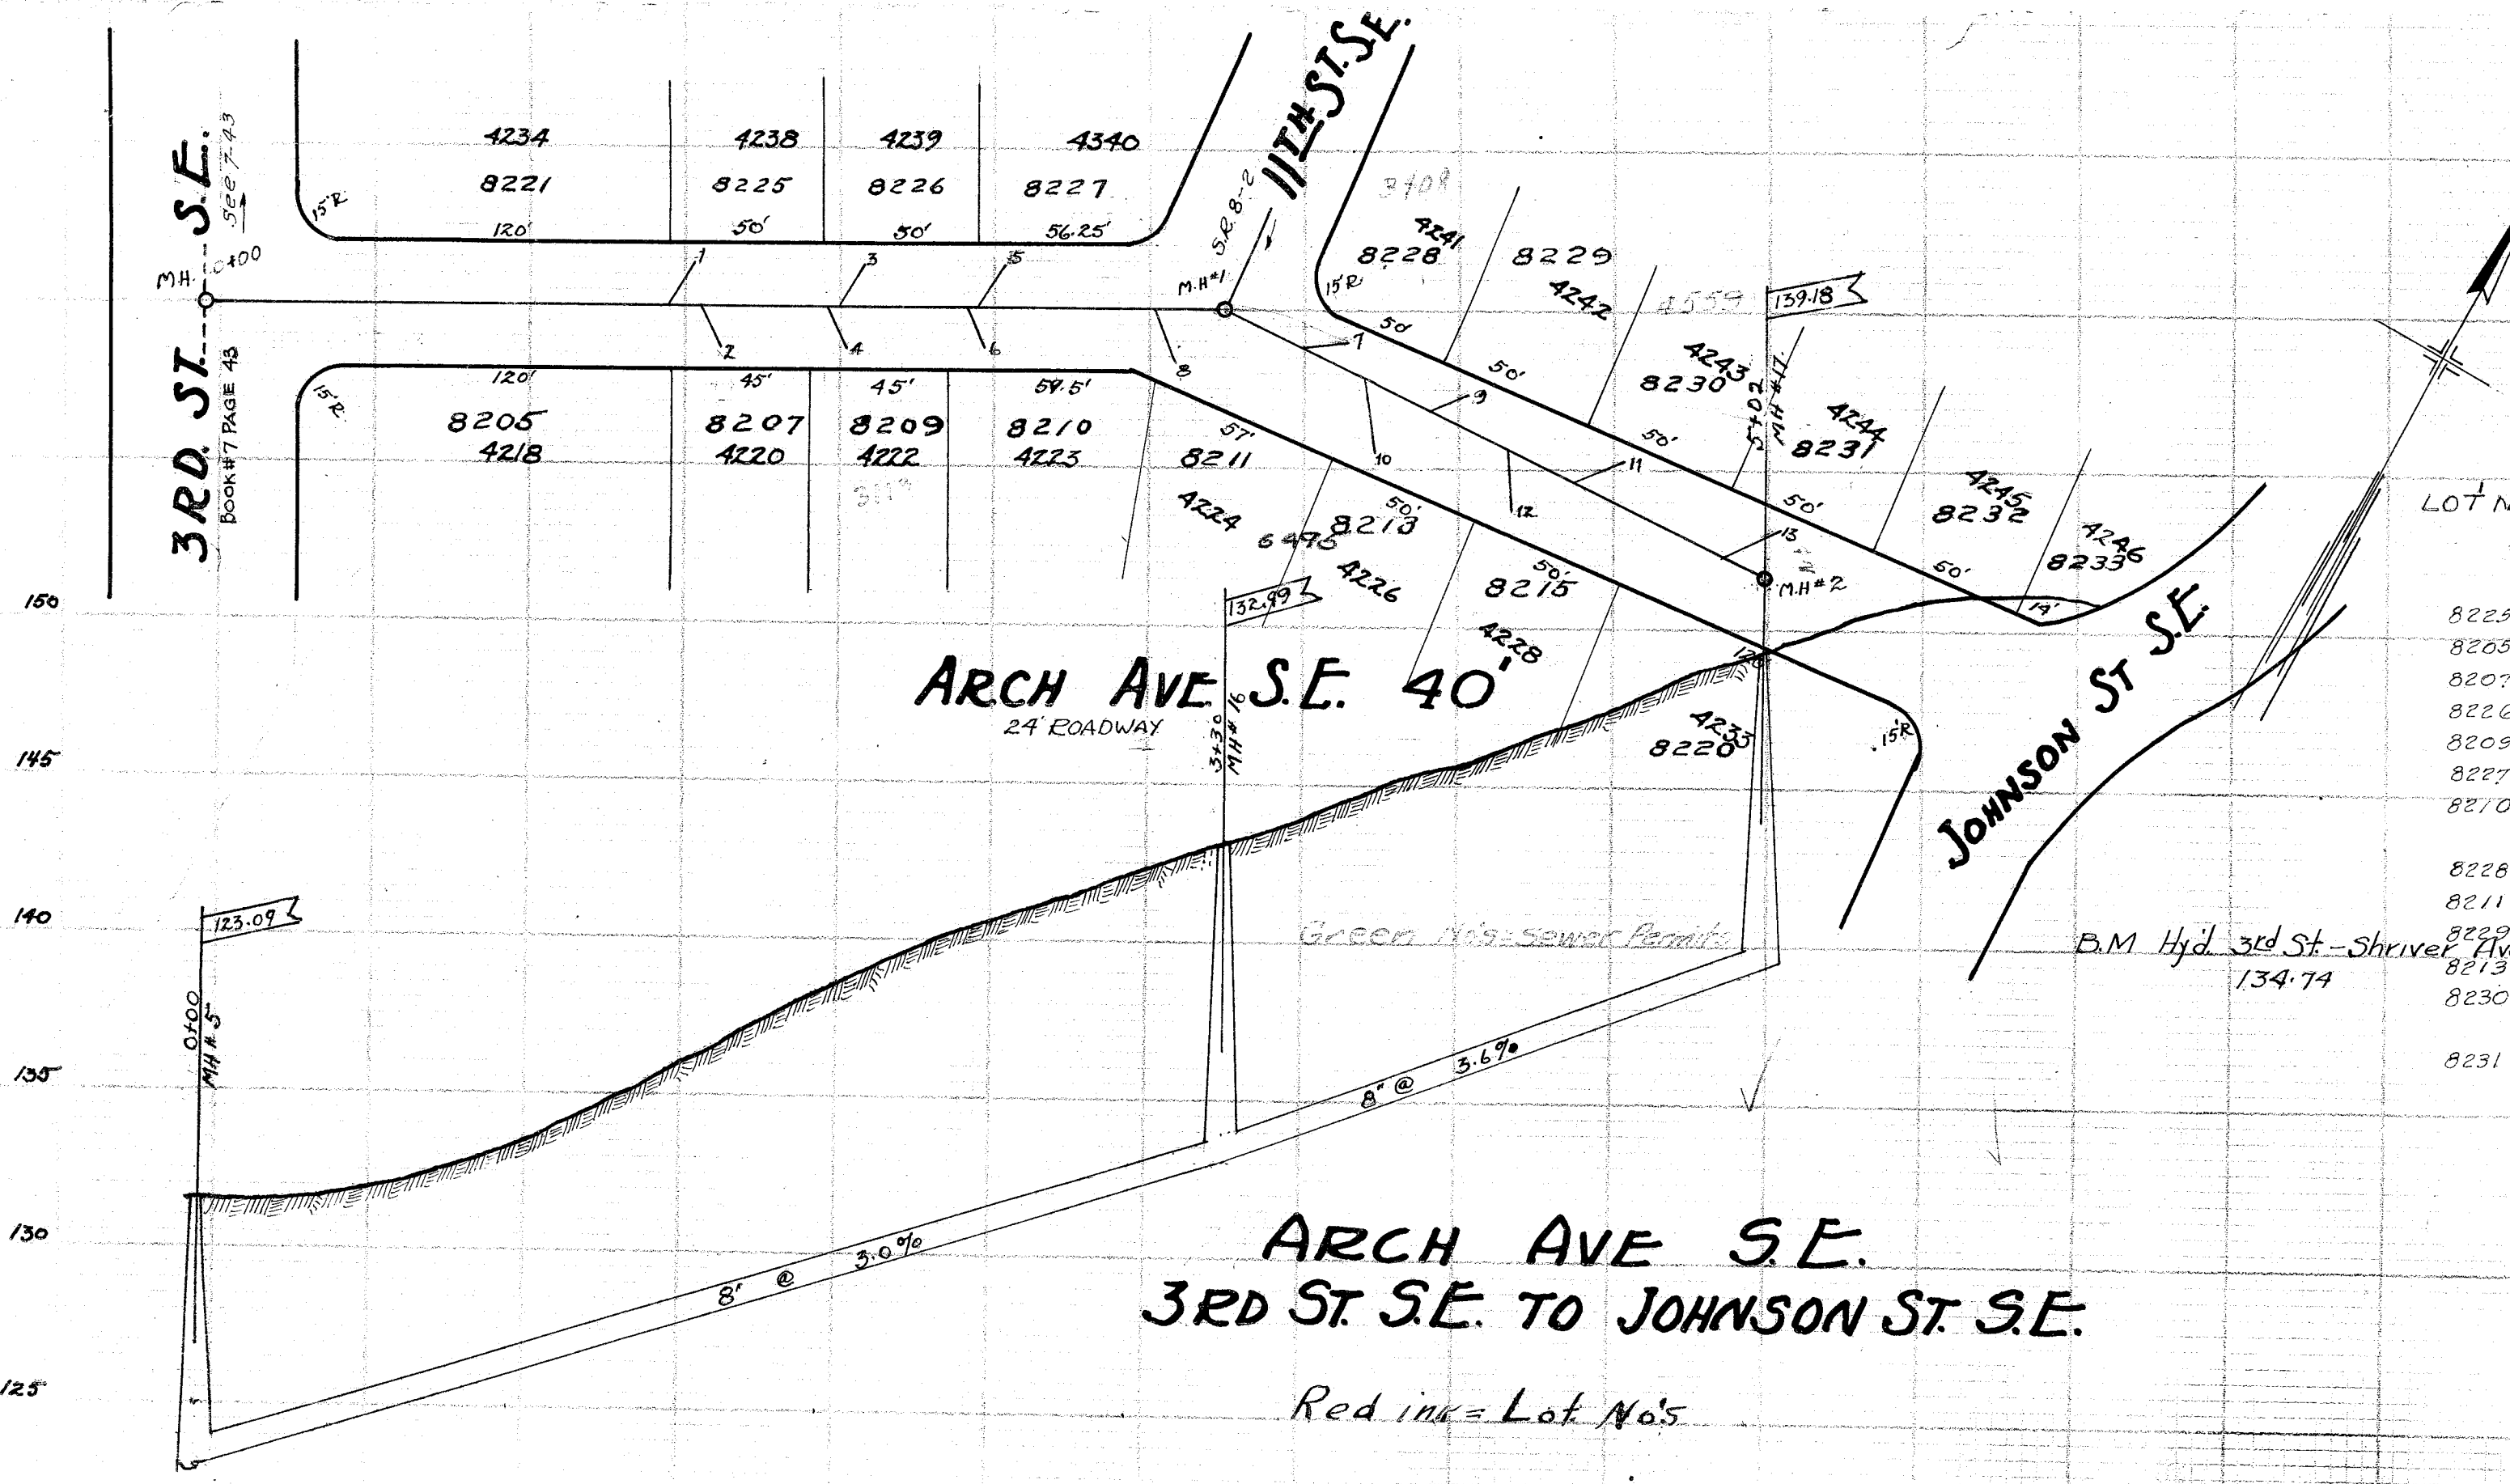

ARCH AVE S.E. LATERAL RECORD

LOT NO	LAT	LOT NO	SIDE	D'PH	X	STA	REMARKS
EAST FROM 3RD ST S.E.							
MH #1				9.1		0+10	3RD ST S.E. ARCH
8225	1	4238	N	7	12	1+62	
8205	2	4220	S	7	"	1+66	
8207	4	4222	S	7	"	2+08	
8226	3	4239	N	7	"	2+10.5	
8209	6	4223	S	7	"	2+54	
8227	5	4340	N	7	"	2+58	
8210	8	4224	S	7	"	3+14.5	
MH #1				9.4		3+30	ARCH ST 11th ST
8228	7	4241	N	7	"	3+68	
8211	10	4226	S	7	"	3+77	
8229	9	4242	N	7	"	4+06	
8213	12	4228	S	7	"	4+22	
8230	11	4243	N	7	"	4+58	
MH #12				9.3		5+02	ARCH ST S.E.
8231	13	4244	N	7	"	5+03.5	

ARCH AVE S.E.
3RD ST. S.E. TO JOHNSON ST. S.E.

Red ink = Lot No's

BUILT IN 1928 BY P.E. BICKEL UNDER PLANS MADE BY AND UNDER SUPERVISION OF CITY ENGR. DEPT., C.E. RICE, CITY ENGR., DOC. SHERTZER, CONST. ENGR., C. ELSEA, INSPECTOR., PRELIM. NOTES. F.B. 64 P. 24. INSPECTOR'S RECORDS, #111 PAGES 20-21. PLOTTED NOV. 5 1928 BY H. RAUBER. SCALE 1"=5' VER. 1"=50' HOR. CONST. B81 P36. FINALS B 79 P30. Geo Wallace
ck by H J Weinrich