


LATERAL RECORD

LOT NO	Lot.	Lot No.	Side.	D'ph	X	Sta.	Remarks
	MH	#1		8.7'		2+43	Overlook Ave.
8991	11	8496	E	5.0	13	2+78	THIS M.H. WAS BUILT BY J. WITTMAN UNDER CONTRACT SHOWN ON PAGE 25.
8992	13	8497	"	6.5'	12	3+33	
8993	15	8498	"	"	"	3+89	
8994	17	8499	"	"	"	4+42	
8275	2	5042	W			4+52	Blind Wye.
8995	19	8500	E	7.0'	12	4+86	
8276	4	5043	W			5+02	Blind Wye.
8996	21	8501	E	7.0'	13	5+40	
	MH	#2		9.9'		5+43	
8997	23	8502	E	6.5'	12	5+91	
OL 276	6	B.61173	W	7.0'	"	6+10	
8998	25	8503	E	6.5'	"	6+39	
" 276	8	B.61173	W	7.0'	"	6+62	
8999	27	8504	E	6.5'	13	6+95	
9000	29	8505	"	"	12	7+48	
" 276	10	B.61173	W	7.0'	"	7+63	
" 276	12	" "	"	"	13	8+08	
	MH	#3		8.0		8+23	Karn Ave.
9001	31	8506	E	6.3'	12	8+55	
" 277	14	C. Lomas	W	7.0'	13	8+67	
9002	33	8507	E	6.5'	"	9+17	
" 277	16	C. Lomas	W	6.0'	"	9+22	
9003	35	8508	E	6.5'	12	9+71	
	MH	#4		7.2		10+12	
9004	37	8509	E	6.5'	13	10+21	
" 278	18	C. Lomas	W	"	"	10+45	
9005	39	8510	E	"	"	10+72	
" 278	20	C. Lomas	W	"	"	11+08	
9006	41	8511	E	"	"	11+22	
9007	43	8512	"	"	"	11+73	
" 279	22	J Bell	W	6.0	"	11+74	
	MH	#5		7.7'		12+17	Dead End.
9008	45	8513	E	6.5	13	12+21	

Built in 1928 by R.E. Bickel under plans made by and under the supervision of City Engineering Dept. C.E. Rice, city engr Sam Jones, const engr, H. Piper, Inspector Prelim. notes N.B. 73 P44 const notes N.B. 81 P62-63 Finals B79 P49-50 Inspector's report #136 P12 Platted Jan 18, 1929 by H. Rauber Scale 1"=5' Ver 1"=50' Hor. G. Wallace

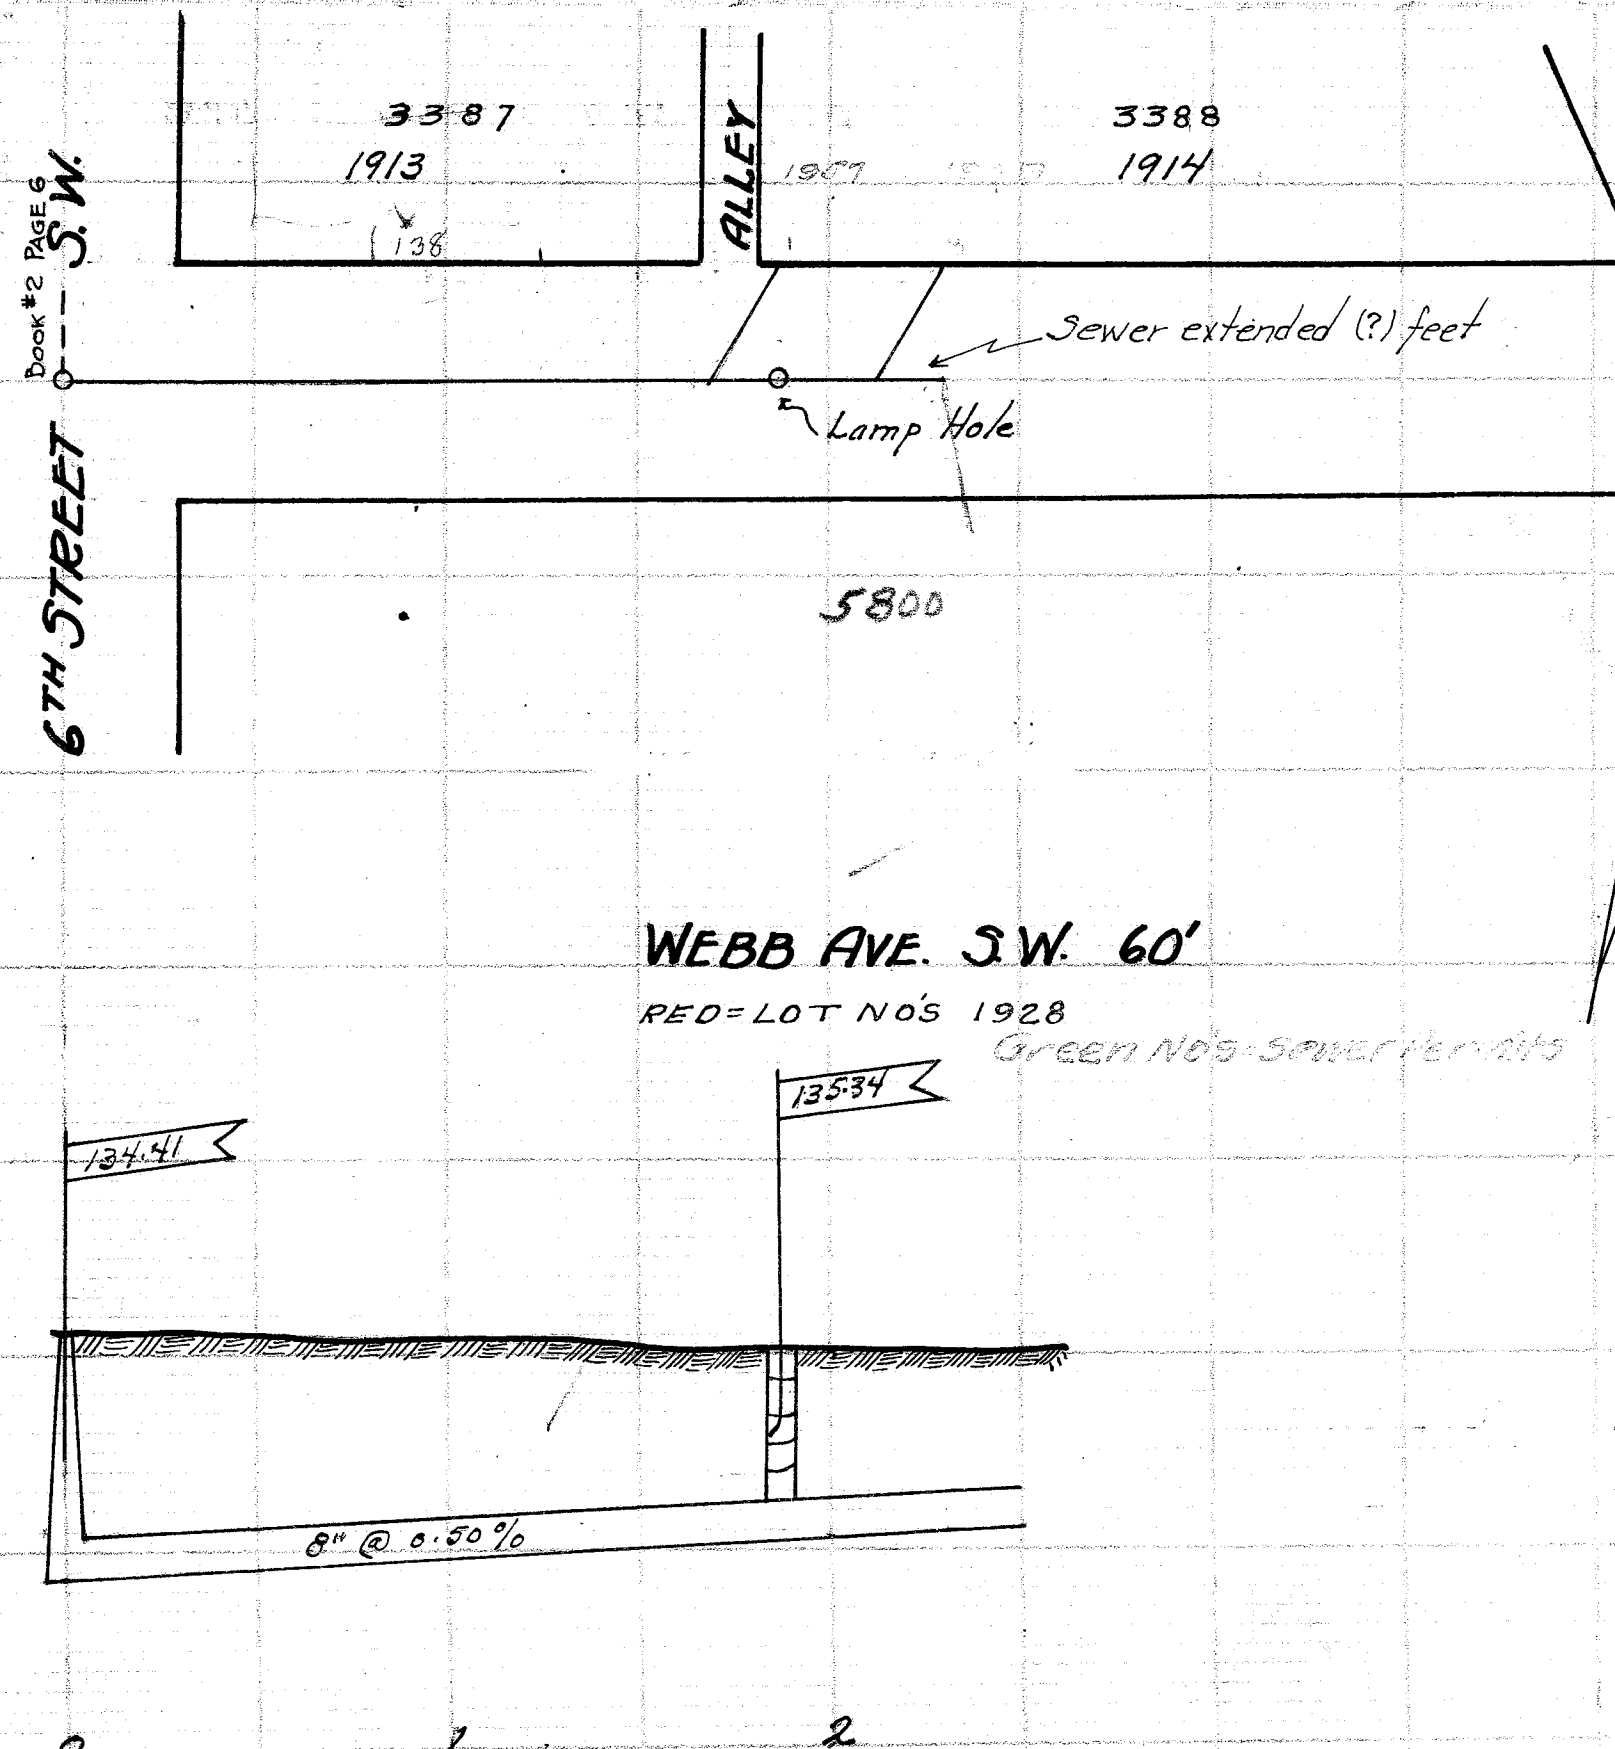

LATERAL RECORD

Lat	Lot No.	Side	Dph	X.	Sta	Remarks
MH					0+00	
1	191433	88N	4'	25	1+87	
LH			5'		1+87	Lamp Hole
3	191433	88N	3.5	25	2+30	

WEBB AVE S.W. SAN SEWER
FROM 6TH ST. APPROX 250' E.

Built in 1925 by J.F. Haecker under plans made by and under the supervision of City Engineering Dept.. C.E. Rice, city engineer, Sam. Jones, const eng'r J. Maloney, Inspector. Prelim notes N.B 49 P61 const notes NB 50 P48 Finals B 48 P66, Inspector's report # R Platted Jan 19, 1929 by H. Rauber Scale 1"=5 Ver 1"=50' Hor
BUILT FOR PRIVATE PARTIES.

15TH STREET S.W. SAN SEWER FROM
OVERLOOK AVE TO LAWN AVE S.W.