


BENCH MARK - BM

RIM OF SANITARY MANHOLE LOCATED ALONG THE
EASTERLY R/W OF 3RD STREET N.W. A DISTANCE
OF 160' FROM THE NORTHERLY R/W OF LINCOLN
WAY WEST ELEVATION = 933.69

BASIS OF BEARINGS

THE BASIS OF BEARINGS FOR THIS
SURVEY IS S 69°12'33" E AS THE
CENTERLINE OF LINCOLN WAY WEST
AS RECORDED IN PLAT BOOK 55
PAGE 41.

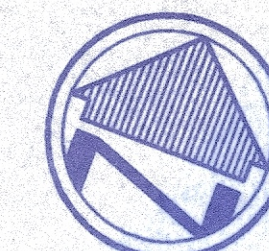

0' 20' 40' 60'

SCALE: 1"=20'

CONTOUR INTERVAL = 1'

LEGEND

- REC. - RECORD DISTANCE
OR ANGLE
- CAL. - CALCULATED DISTANCE
OR ANGLE
- OBS. - OBSERVED DISTANCE
OR ANGLE
- T.P.O.B. - TRUE PLACE OF
BEGINNING
- P.O.B. - PLACE OF BEGINNING
- MONUMENT BOX
- MONUMENT FOUND, SIZE
& TYPE AS INDICATED.
- 5/8" REBAR, 30 INCHES
IN LENGTH, WITH I.D. CAP
CBA SET
- P.K.(MASONRY) NAIL SET
- POWER POLE
- LIGHT POLE
- TELEPHONE POLE
- HYDRANT
- CATCH BASIN
- WATER METER
- WATER VALVE
- FENCE
- GAS VALVE
- POST
- HANDICAP SPACE
- SIGN
- R/W - RIGHT-OF-WAY
- GAS LINE MARKER
- MANHOLE
- SANITARY MANHOLE
- ELECTRIC BOX
- CENTERLINE
- (XXX'XX' - RECORD BEARING
XX.XX' - DISTANCE

UTILITIES LIST

- AMERITECH
- DOMINION EAST OHIO GAS
4725 SOUTHWAY ST. S.W.
CANTON, OHIO 44708
330-478-3136
- CITY OF MASSILLON - ENGINEERING
151 LINCOLN WAY E.
MASSILLON, OHIO 44646
330-830-1722
- NORTHEAST OHIO NATURAL GAS
- CONSUMER OHIO WATER
870 THIRD STREET N.W.
MASSILLON, OHIO 44647
330-832-7600
- GREAT LAKES ENERGY PARTNERS
- MASSILLON CABLE

"AS-BUILT" SURVEY

CVS PHARMACY
242 LINCOLN WAY WEST
MASSILLON, OHIO



CAMPBELL &
ASSOCIATES, INC.
Surveying, Engineering
(330) 945-4117

1923 Bailey Road Suite A Cuyahoga Falls, Ohio 44221

Date: 9/5/01
By: WBF
Scale: 1"= 20'
Job: 20011213
Sheet 1 of 1

EXISTING TOPOGRAPHIC CONDITIONS AND FEATURES ARE
GRAPHICALLY SHOWN BASED UPON A DILIGENT SEARCH AND
USE OF AVAILABLE PUBLIC RECORDS IN CONJUNCTION WITH
FIELD SURVEY MEASUREMENTS OF SAME.

TIMOTHY J. BRIGGS
REGISTERED
SURVEYOR
7495
9-10-2001
DATE

