


H:\Land Projects R2\08178\dwg\08178_AS BUILT_8-18-09.dwg 8/20/2009

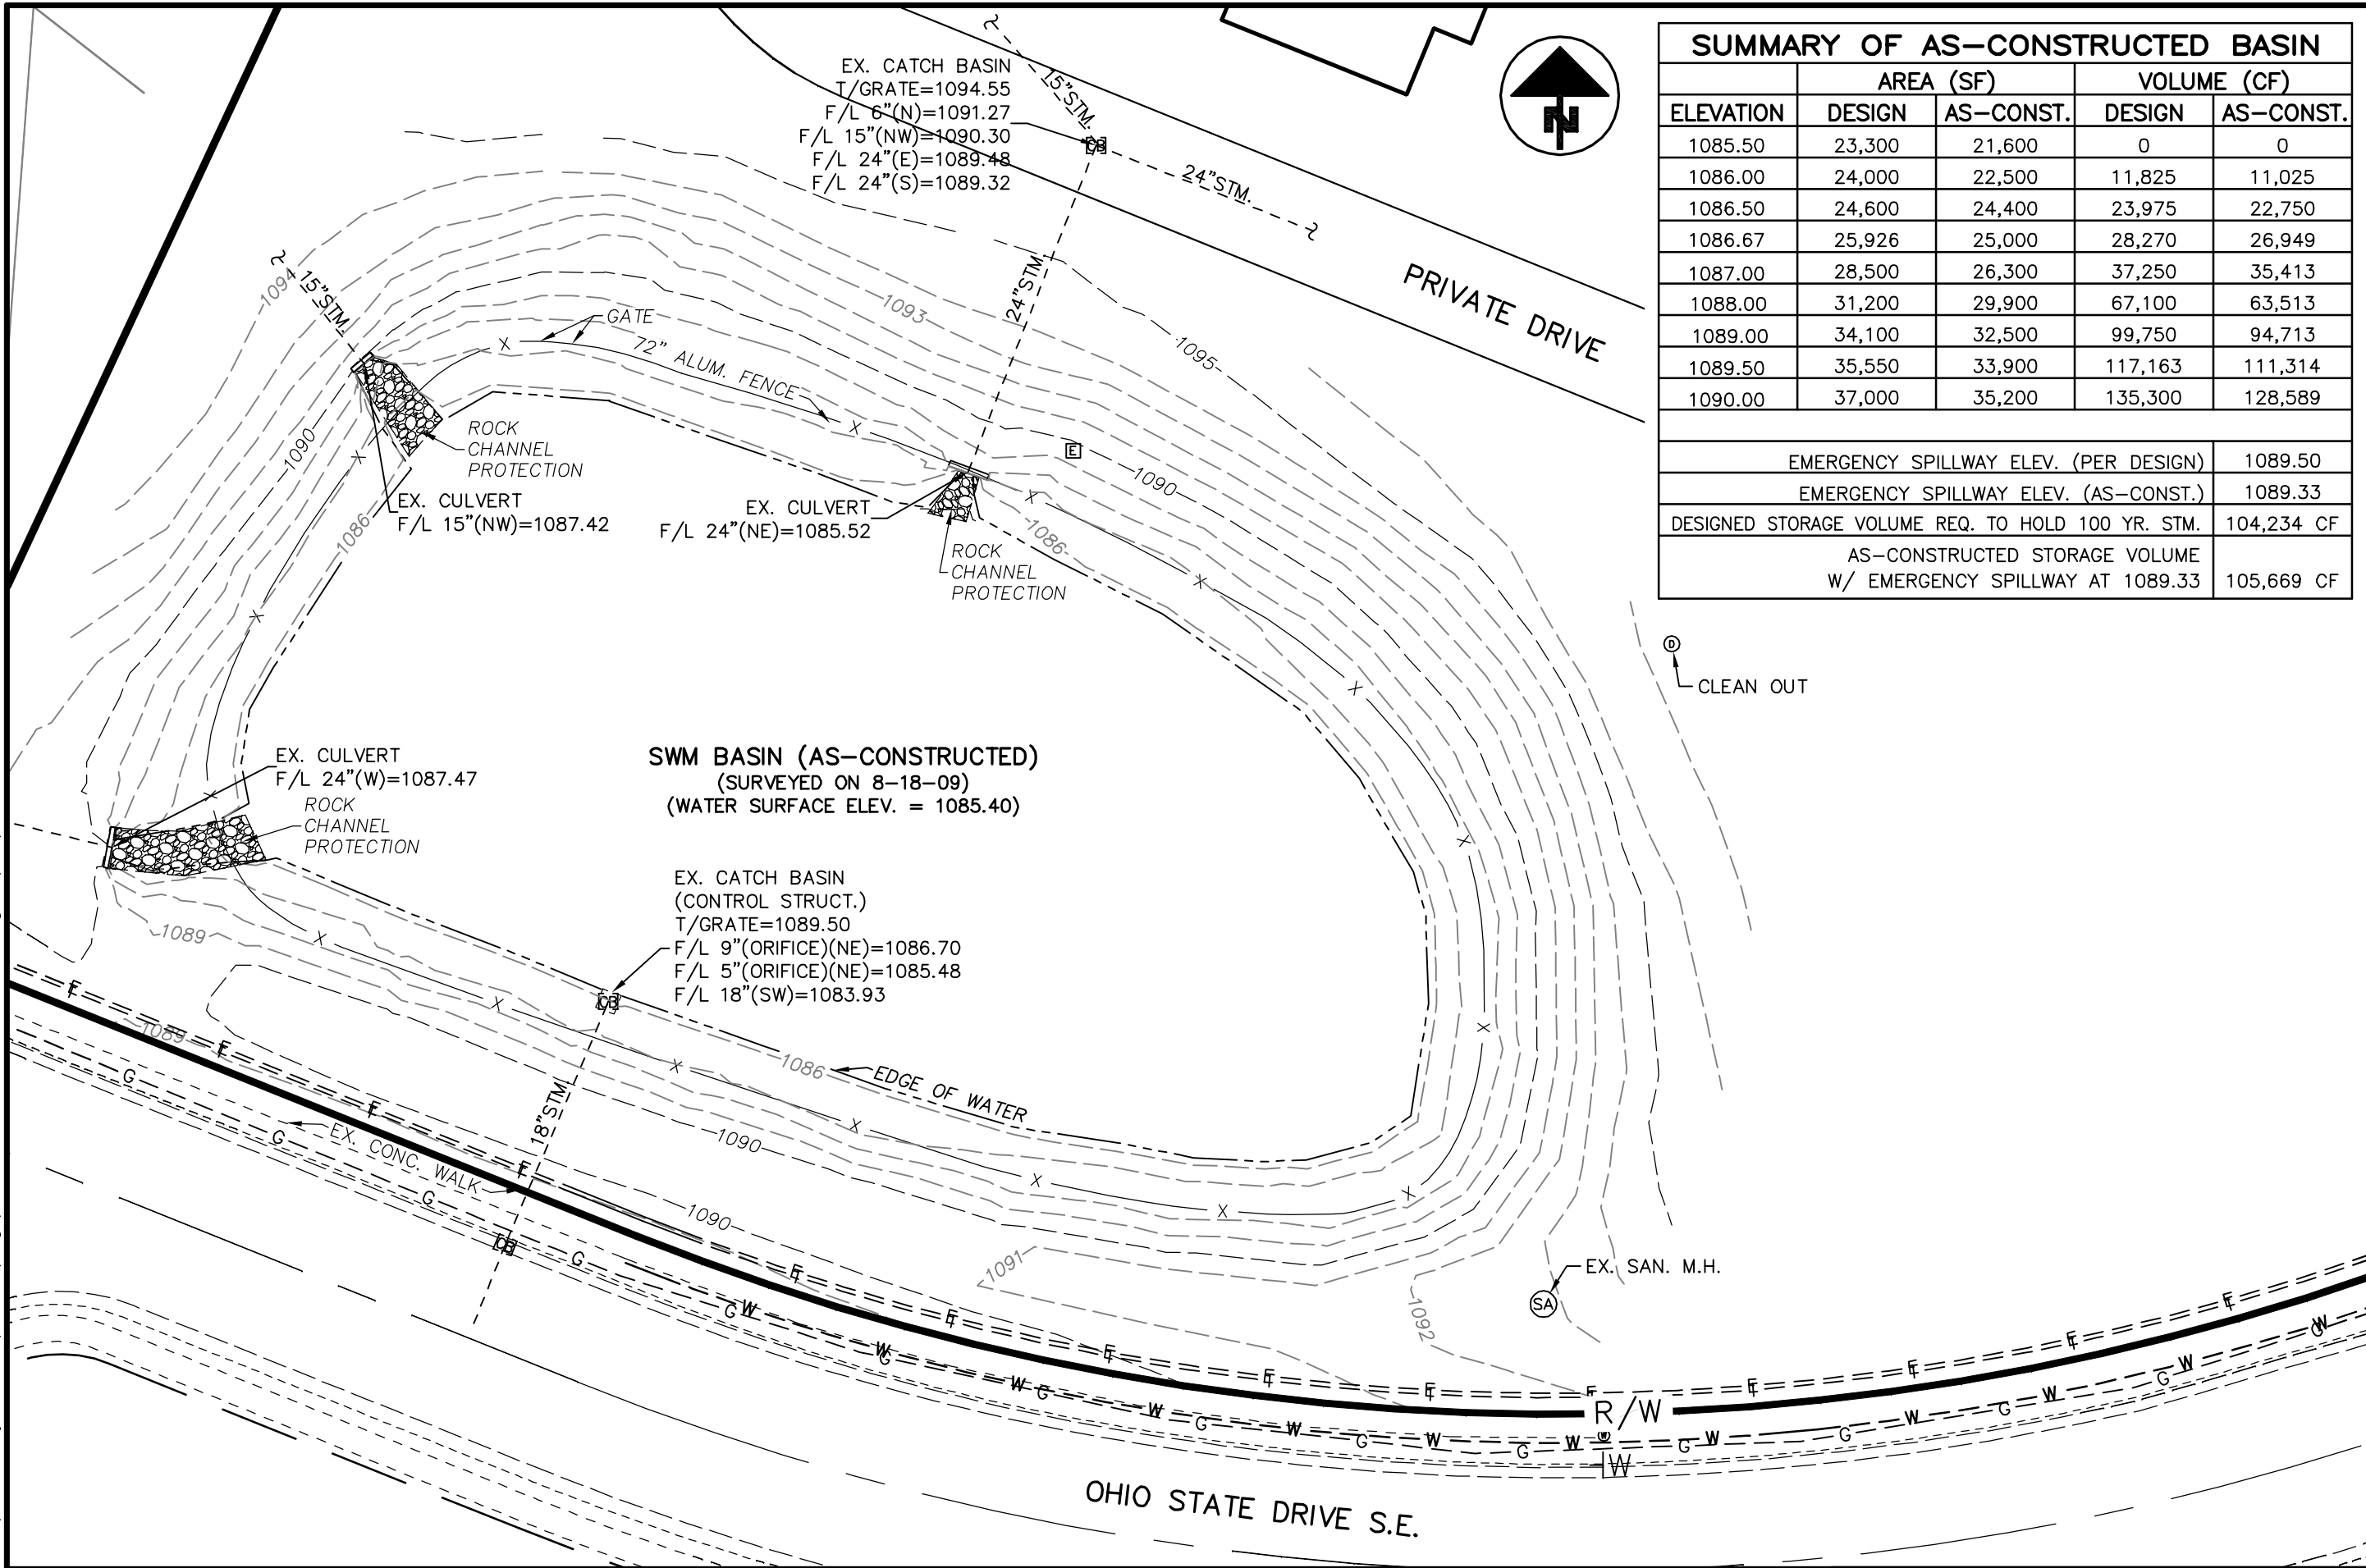

SUMMARY OF AS-CONSTRUCTED BASIN				
ELEVATION	AREA (SF)		VOLUME (CF)	
	DESIGN	AS-CONST.	DESIGN	AS-CONST.
1085.50	23,300	21,600	0	0
1086.00	24,000	22,500	11,825	11,025
1086.50	24,600	24,400	23,975	22,750
1086.67	25,926	25,000	28,270	26,949
1087.00	28,500	26,300	37,250	35,413
1088.00	31,200	29,900	67,100	63,513
1089.00	34,100	32,500	99,750	94,713
1089.50	35,550	33,900	117,163	111,314
1090.00	37,000	35,200	135,300	128,589
EMERGENCY SPILLWAY ELEV. (PER DESIGN)				1089.50
EMERGENCY SPILLWAY ELEV. (AS-CONST.)				1089.33
DESIGNED STORAGE VOLUME REQ. TO HOLD 100 YR. STM.				104,234 CF
AS-CONSTRUCTED STORAGE VOLUME W/ EMERGENCY SPILLWAY AT 1089.33				105,669 CF

DRAWN BY: BDB
CHECKED BY: BJA
DATE: 8/19/09

PHONE: (330) 452-5731
FAX: (330) 452-9110

COOPER & ASSOCIATES, LLP
ENGINEERS AND SURVEYORS
1359 MARKET AVE. NORTH
CANTON, OHIO 44714

SWM BASIN AS-BUILT

THE INN AT UNIVERSITY VILLAGE
FOR: McCLAIN DEVELOPMENT, INC.

SHEET
1 OF 1

PROJ.#
08178