




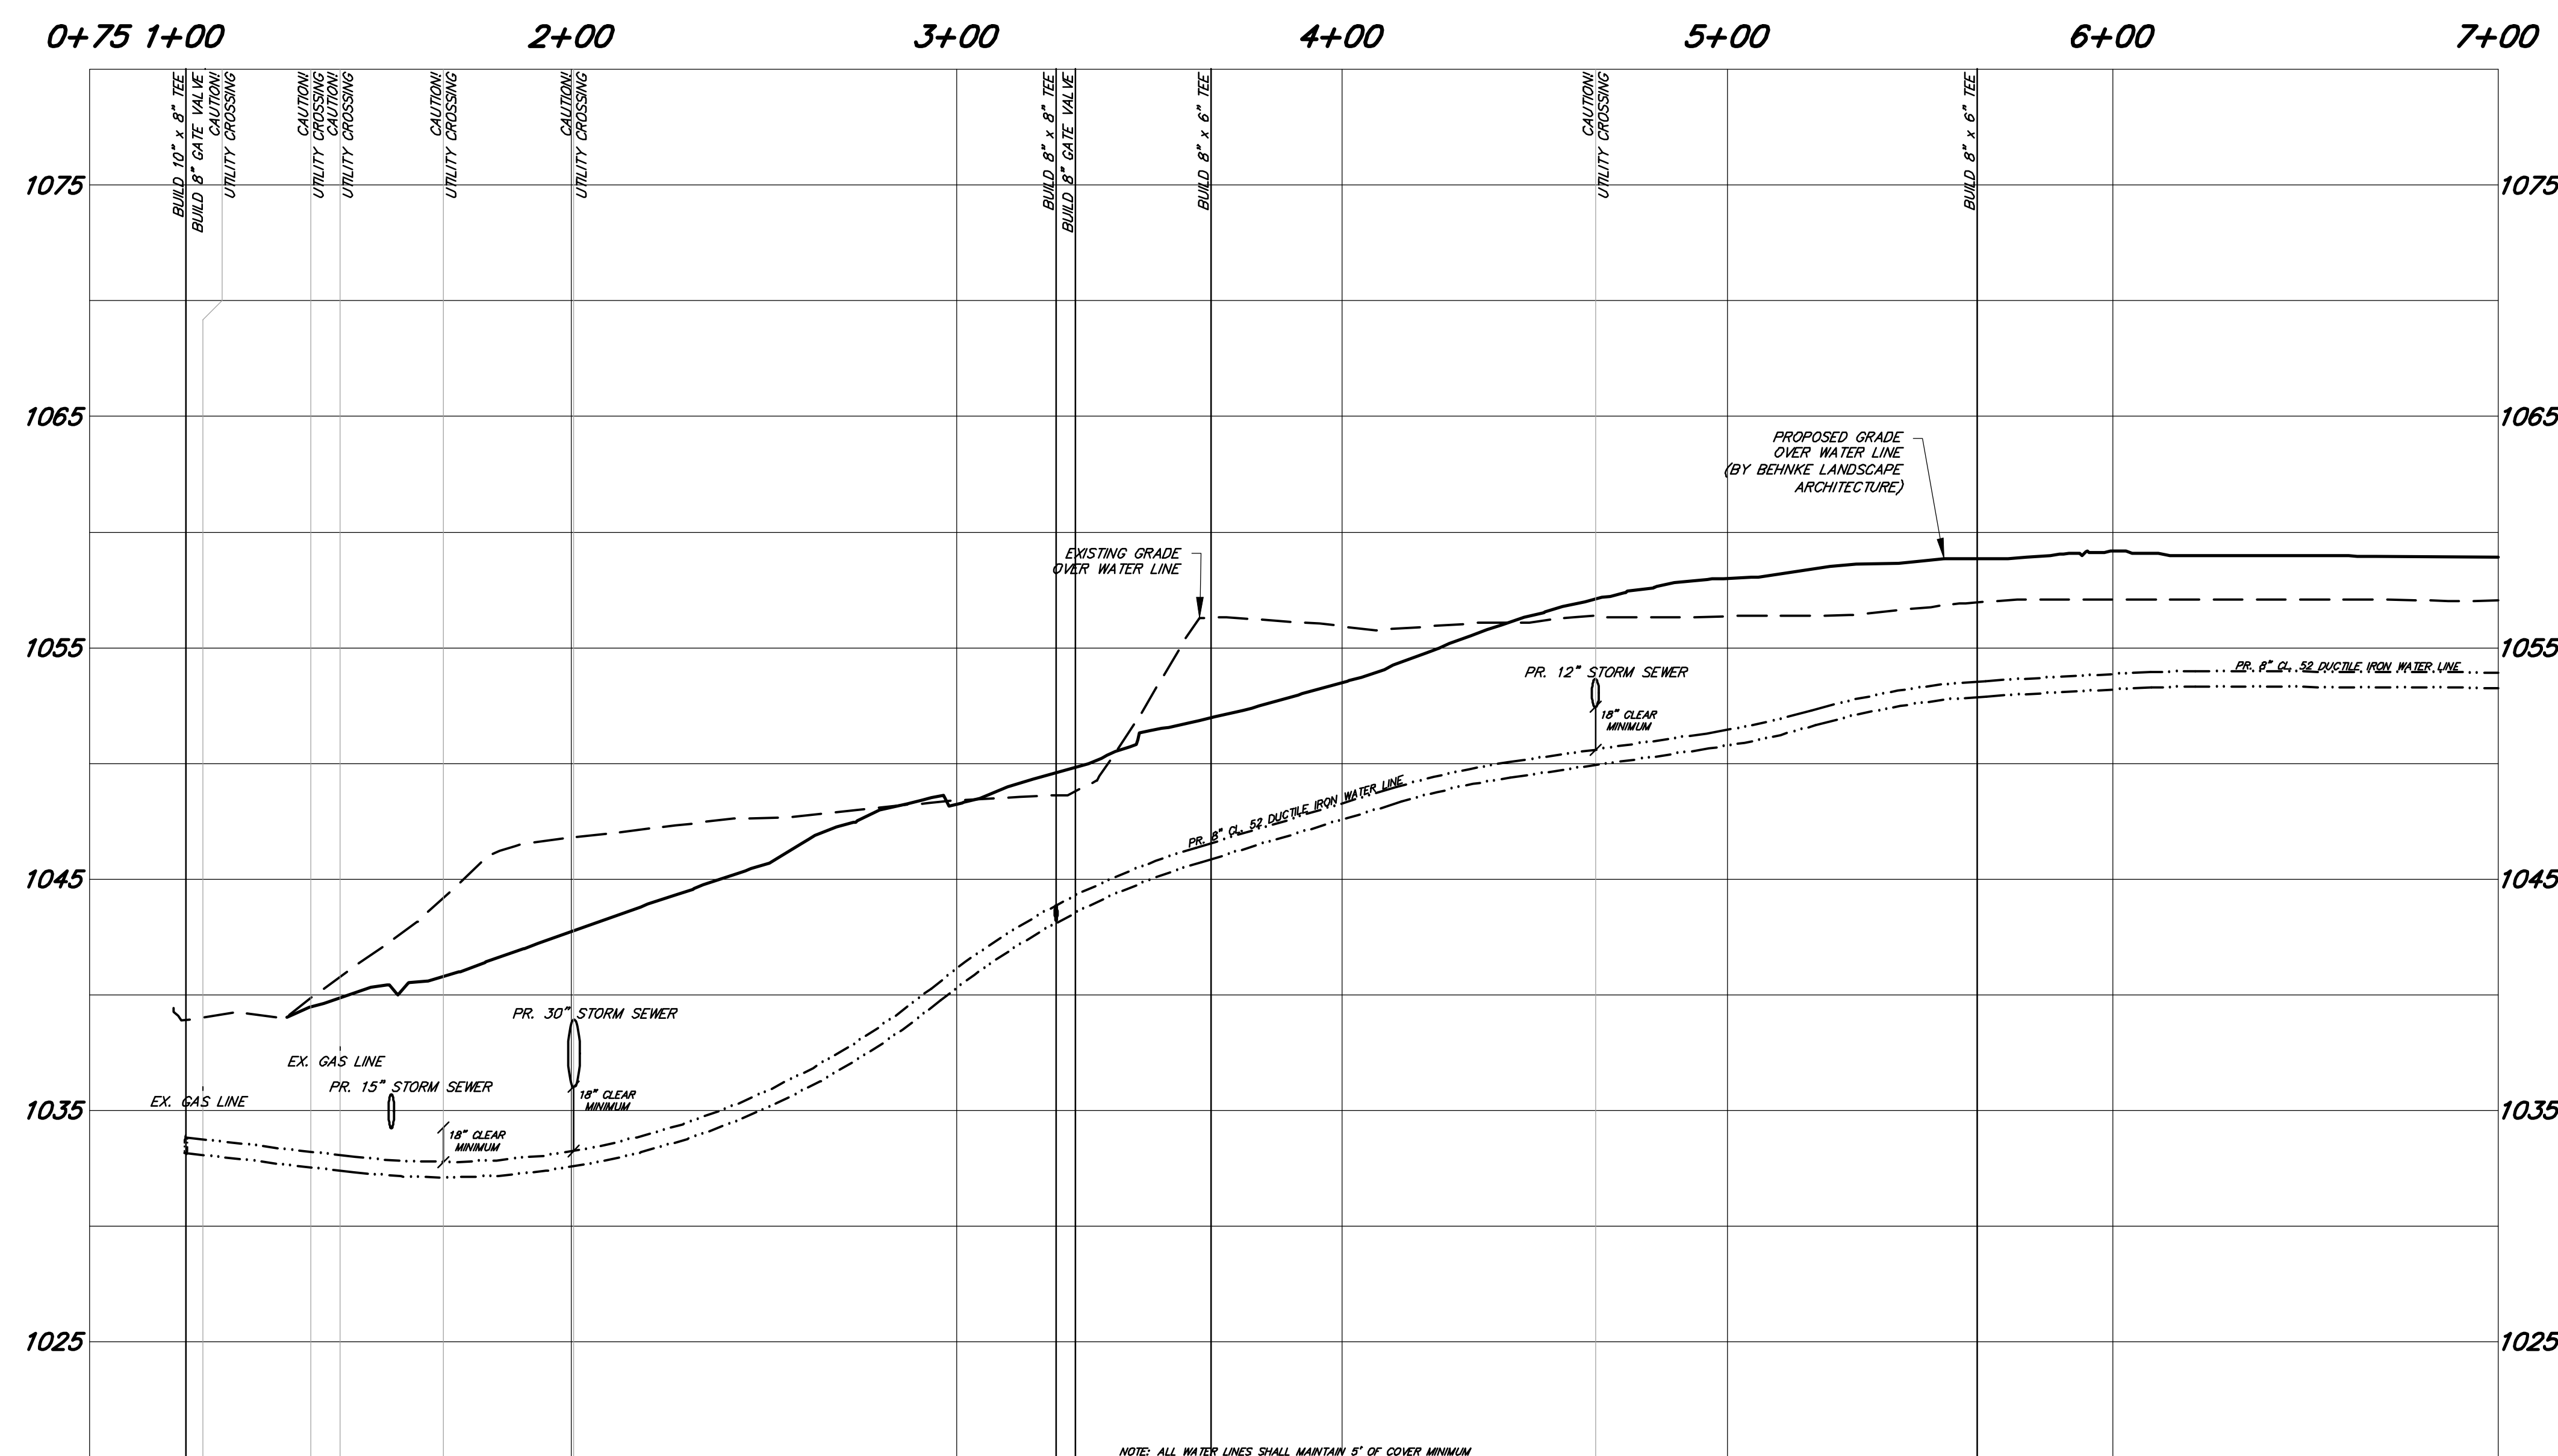


WATERLINE PROFILE STA. 0+75 TO 7+00
SCALE: HORIZ. 1"=30', VERT. 1"=5'

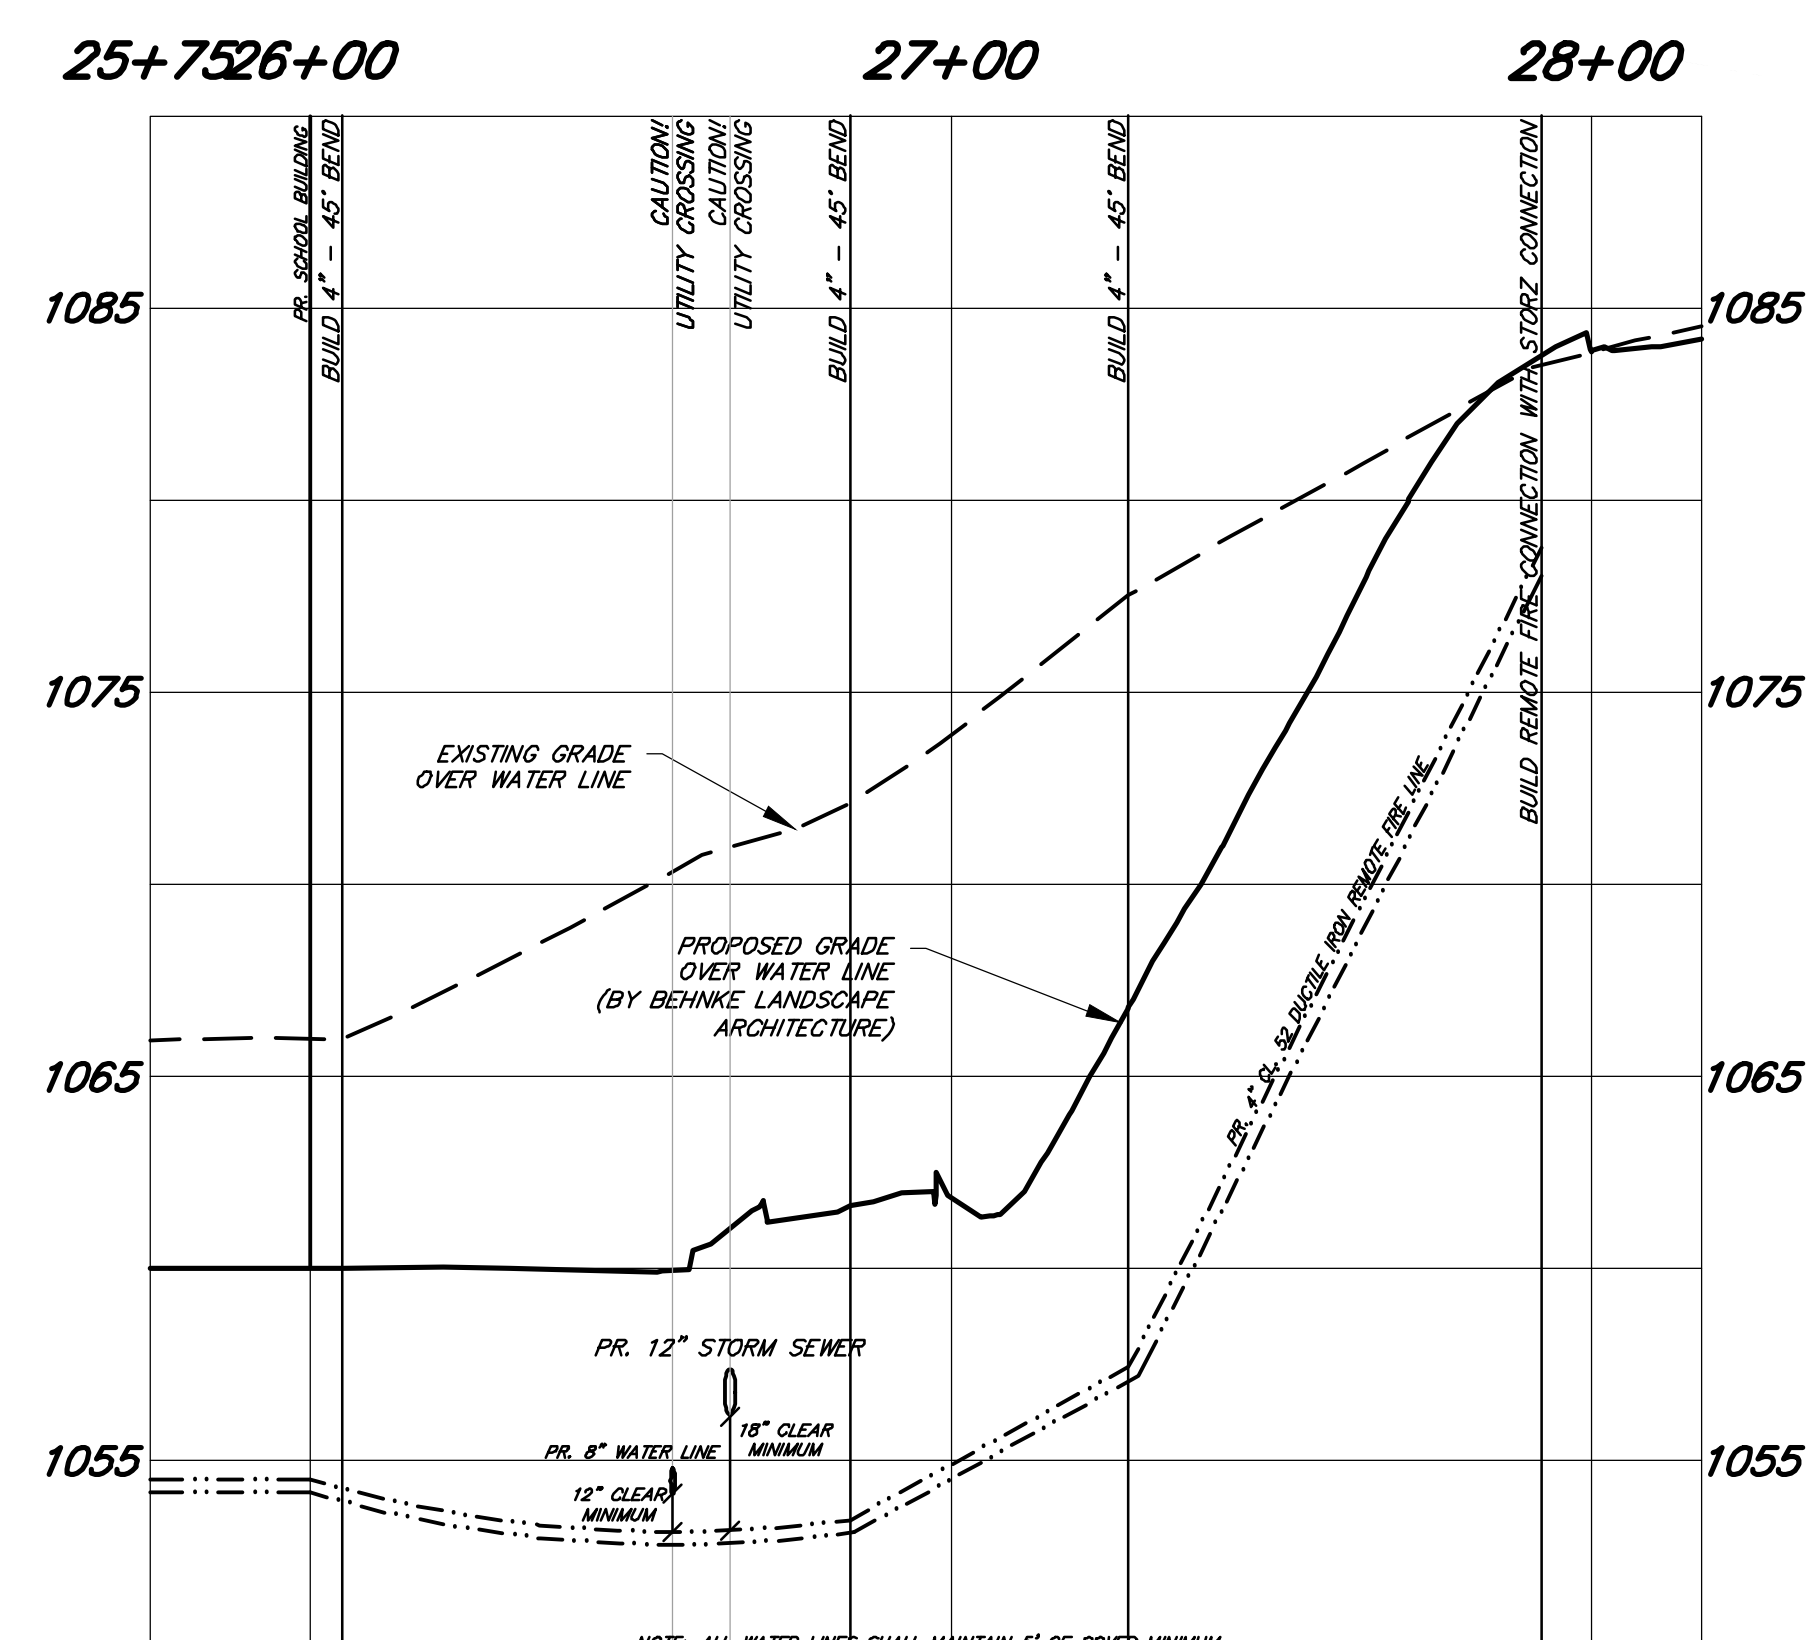


REMOTE FIRE CONNECTION PROFILE
SCALE: HORIZ. 1"=30', VERT. 1"=5'

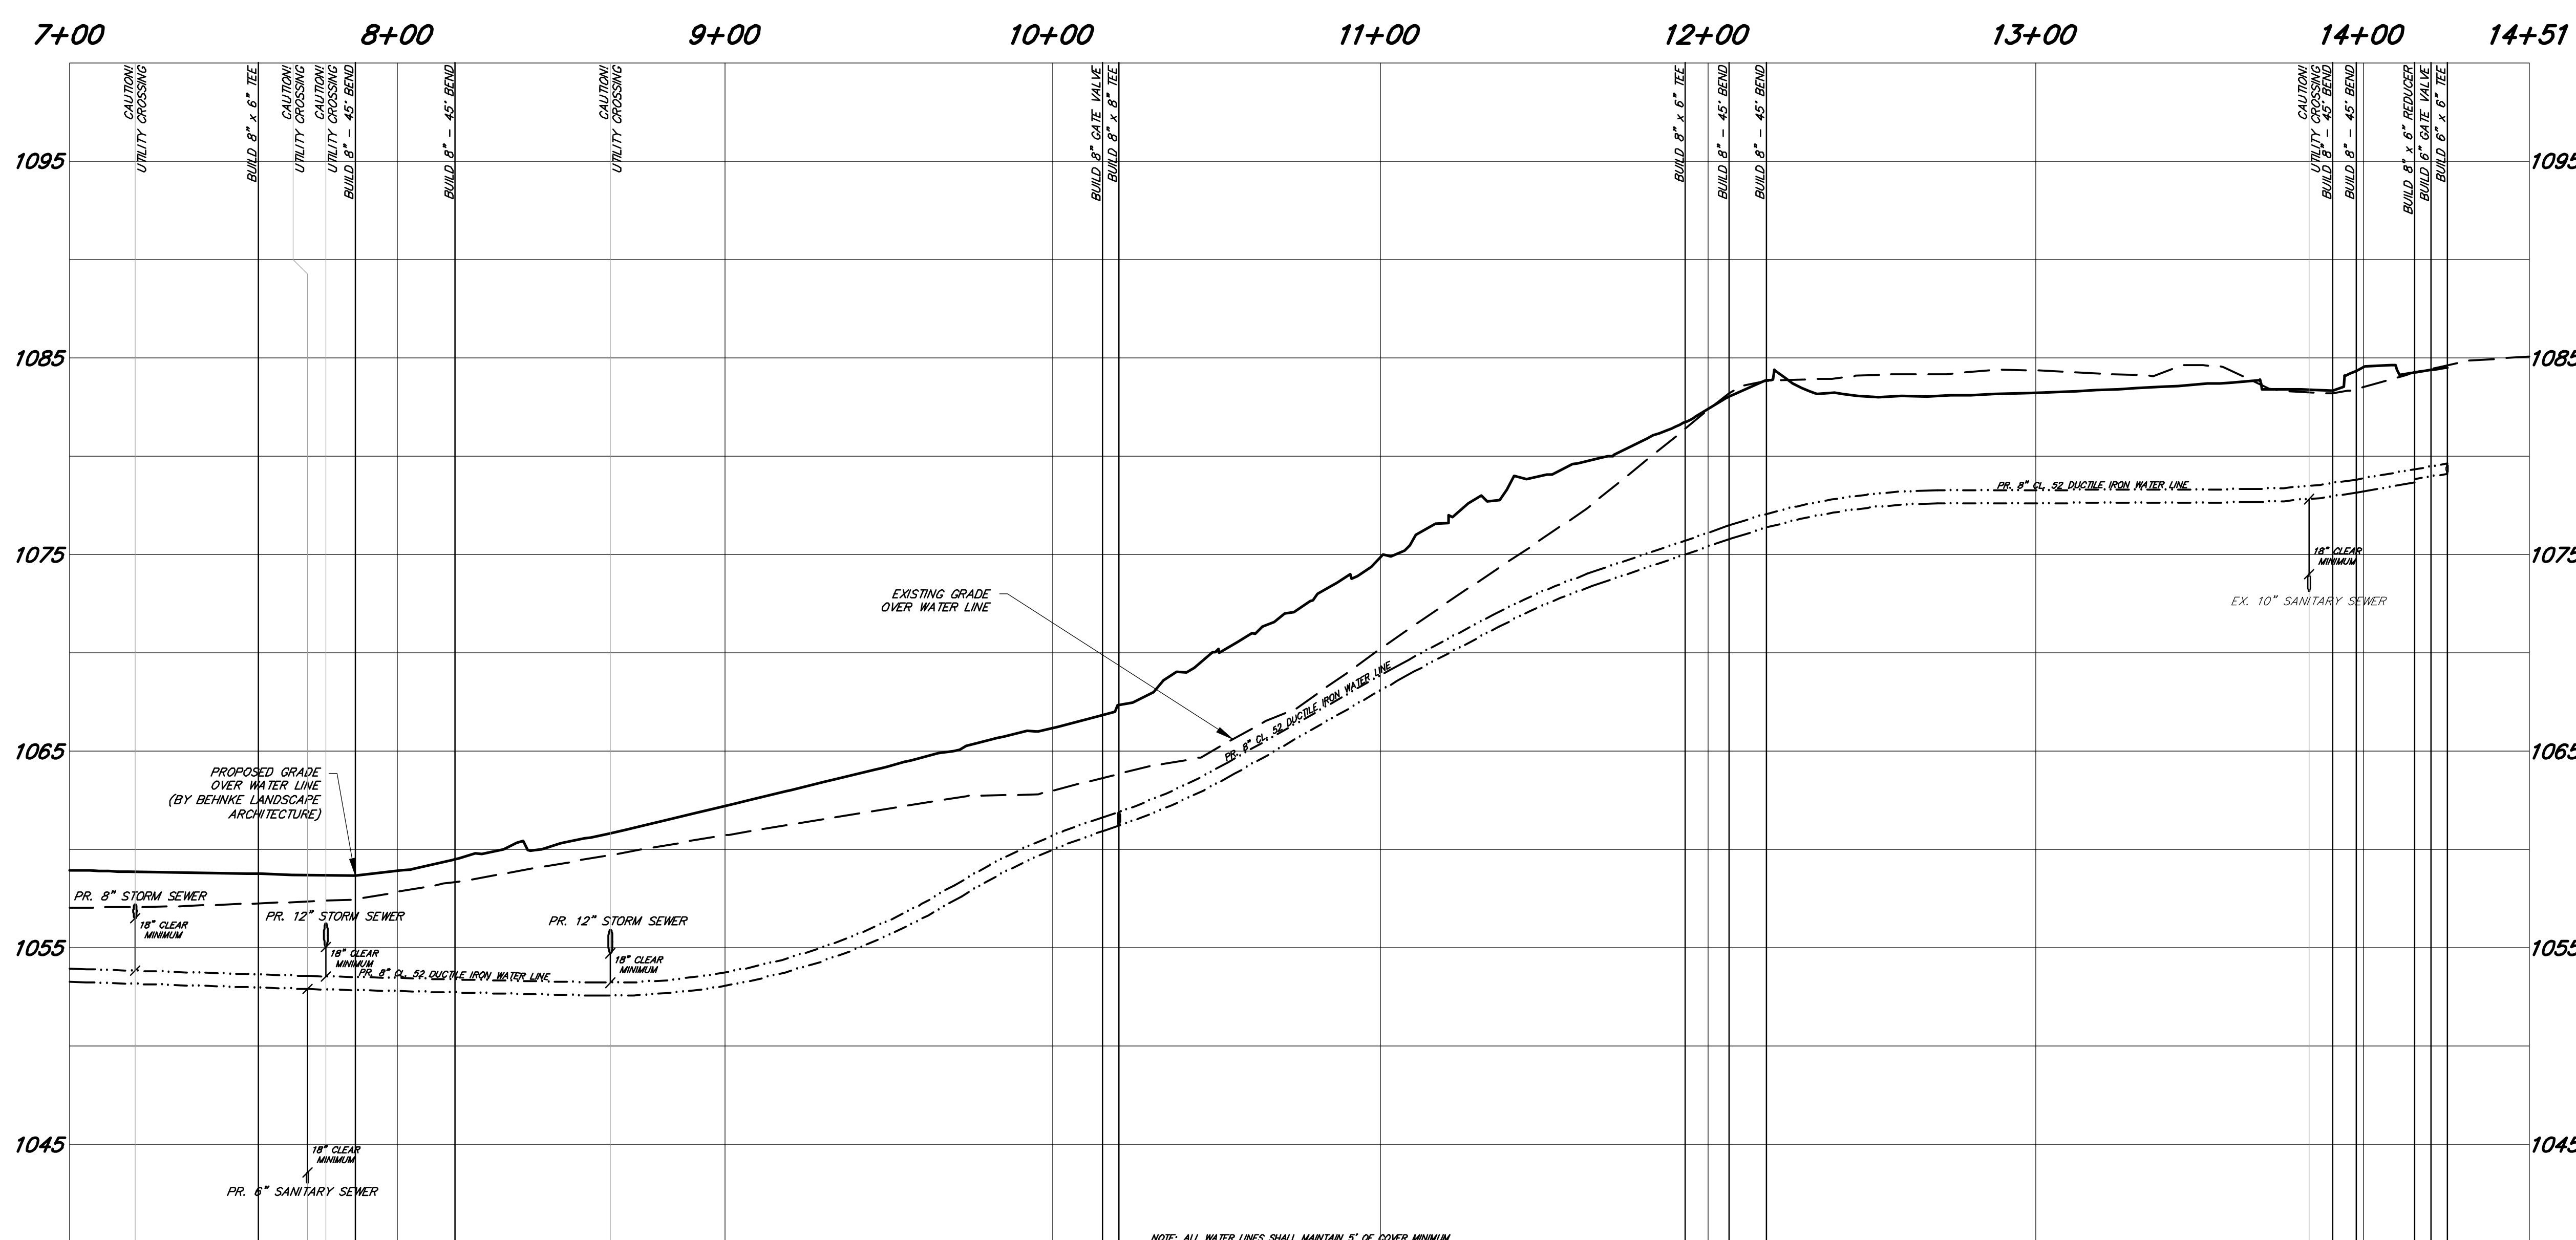

WATERLINE PROFILE STA. 7+00 TO 14+51
SCALE: HORIZ. 1"=30', VERT. 1"=5'

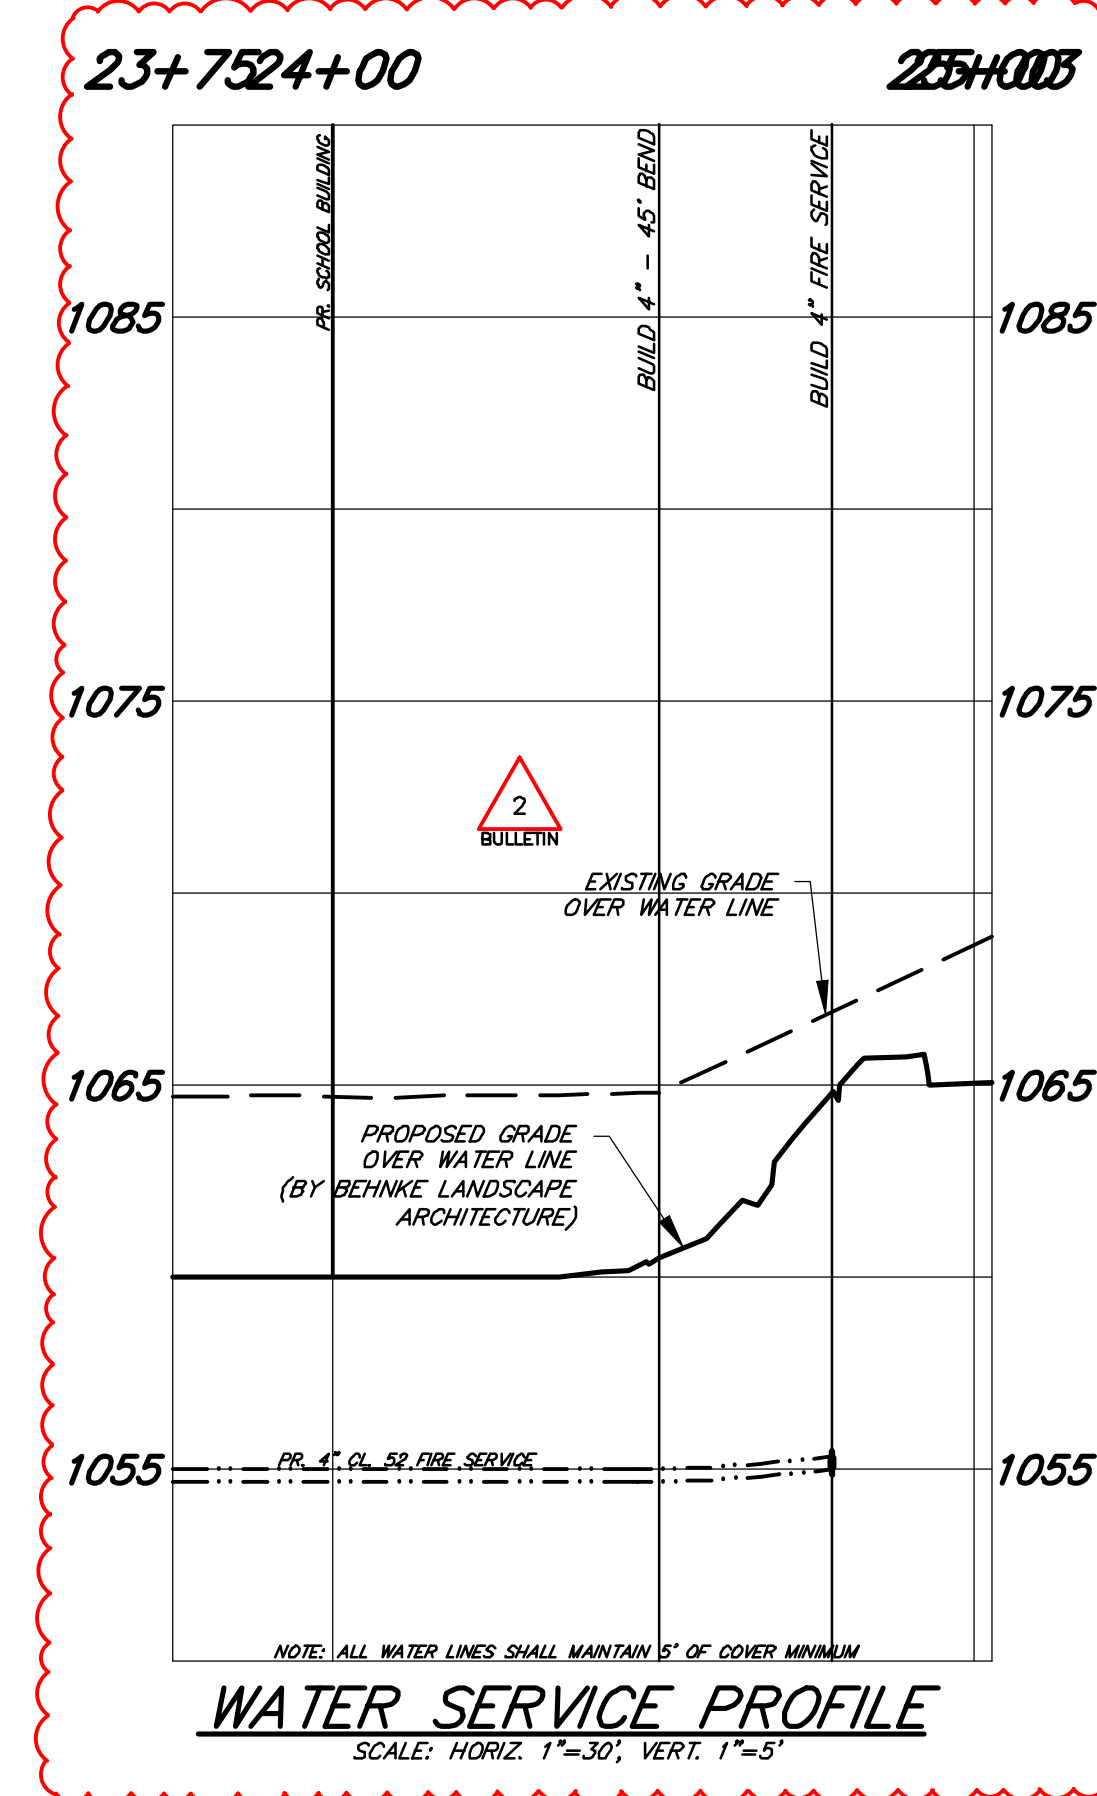

WATER SERVICE PROFILE
SCALE: HORIZ. 1"=30', VERT. 1"=5'

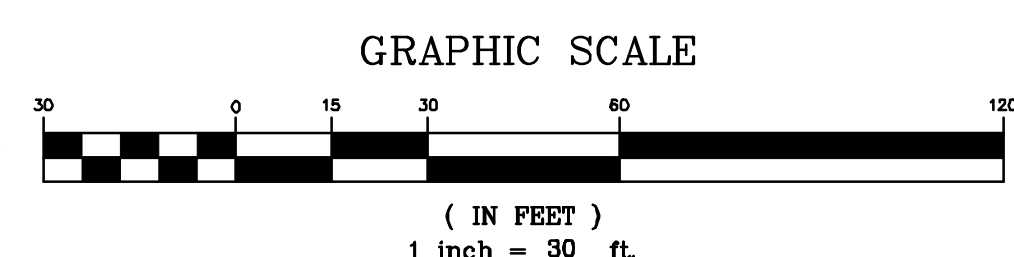

NOTE: CONTRACTOR SHALL TAKE NOTE OF ALL SUBSURFACE CONDITIONS AND MUST ANTICIPATE AND INCLUDE PROPER EQUIPMENT FOR ALL EXCAVATION ACTIVITIES. NO ADDITIONAL PAYMENTS WILL BE MADE FOR ADDITIONAL EQUIPMENT NEEDED OR EXTRA CONSTRUCTION TIME DUE TO IMPROPER PLANNING BY THE CONTRACTOR. LEWIS LAND PROFESSIONALS TAKES NO RESPONSIBILITY FOR ANY SUBSURFACE CONDITIONS PRESENT THAT MAY OR MAY NOT BE SHOWN ON THE PLANS AND/OR PROFILES. SEE GEOTECHNICAL REPORT FOR MORE INFORMATION.


— PLAN PREPARED BY —
LEWIS LAND PROFESSIONALS, INC.

CIVIL ENGINEERING LAND SURVEYING
8691 WADSWORTH ROAD SUITE 100
WADSWORTH, OH 44281 (330) 335-8232



PROJECT NO.
2203-2

ARCHITECTURAL VISION GROUP, LTD
ARCHITECTS • PLANNERS
23850 SPERRY DRIVE CLEVELAND, OHIO 44145

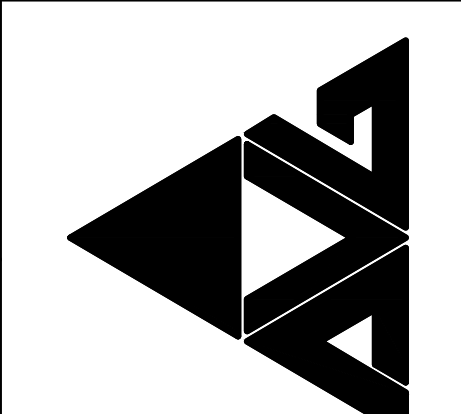

CONSULTANT
LEWIS LAND PROFESSIONALS, INC.
Civil Engineering & Land Surveying
8691 WADSWORTH ROAD
WADSWORTH, OH 44281
PH (330) 335-8232
FX (330) 335-0242
WWW.LEWISLANDPROF.COM

Massillon East Site PK-3
Eastside PK-3 Elementary School
1 Paul E Brown Drive SE
MASSILLON CITY SCHOOL DISTRICT MASSILLON, OHIO

NO.	DATE	DESCRIPTION
1	04.13.23	BULLETIN 2
2	05.02.23	BULLETIN 1
3	04.24.23	ADDENDUM 1
4	03.30.23	PLAN REVIEW & EEP
5	03.30.23	ISSUED TO OWNER SITE PACKAGE

PROJECT NO. 2203-2
DRAWN BY
CHECKED BY
DATE 03/17/2023

WATER LINE PROFILES

SCALE: 1"=30'
SHEET NO.
C-500