


- DEMOLITION NOTES**
- LIMITS OF DEMOLITION IS THE PROPERTY LINE LOCATED ON THE PLANS AS DIRECTED BY THE CONSTRUCTION MANAGER.
  - PRIOR TO STARTING DEMOLITION, THE CONTRACTOR SHALL SECURE ALL REQUIRED PERMITS AND APPROVALS.
  - IT IS THE RESPONSIBILITY OF THE CONTRACTOR TO COORDINATE ALL DEMOLITION ITEMS. SPECIAL ATTENTION NEEDS TO BE PAID TO PROPERTY DEVELOP AND EXECUTE A WASTE MANAGEMENT PLAN FOR BUILDING RELATED ITEMS. THE CONTRACTOR WILL BE EXPECTED TO PROVIDE TICKET QUANTITY INFORMATION IN A FORMAT AGREED UPON BY THE CONSTRUCTION MANAGER, AND PROVIDE THE LOCATION OF RECYCLING OR DISPOSAL.
  - DEMOLITION ACTIVITIES SHALL NOT BEGIN PRIOR TO INSTALLING THE STORM WATER POLLUTION PREVENTION CONTROL MEASURES, AS INDICATED BY THE STORM WATER POLLUTION PREVENTION PLAN.
  - THE CONTRACTOR SHALL CONTACT THE OHIO UTILITIES PROTECTION SERVICE (O.U.P.S.) AT (800)362-2764, AT LEAST 48 HOURS BUT NO MORE THAN 10 WORKING DAYS (EXCLUDING WEEKENDS AND LEGAL HOLIDAYS) BEFORE BEGINNING ANY EXCAVATION ACTIVITIES ON THE PROJECT.
  - THE CONTRACTOR SHALL COORDINATE WITH ALL UTILITY COMPANIES THE REMOVAL AND RELOCATION OF ALL UTILITIES AND SERVICE CONNECTIONS ABOVE AND BELOW GROUND. AT LEAST 72 HOURS NOTICE SHALL BE GIVEN PRIOR TO ANY OUTAGE OR DISRUPTION OF SERVICE.
  - ANY ADDITIONAL UTILITY CONNECTIONS DISCOVERED DURING DEMOLITION AND CONSTRUCTION SHALL BE EVALUATED IN THE FIELD AND MAINTAINED OR ABANDONED AS DIRECTED BY THE PROJECT ENGINEER.
  - THE CONTRACTOR SHALL COORDINATE RELOCATION OF ANY ELECTRIC SERVICE AND POLES WITH THE UTILITY COMPANY.
  - THE CONTRACTOR SHALL NOTIFY CONSTRUCTION MANAGER OF WORK WHICH MAY AFFECT ADJACENT OWNER'S PROPERTY, POTENTIAL NOISE, UTILITY OUTAGE, OR DISRUPTION OF SERVICES. THE CONTRACTOR SHALL COORDINATE WORK ACTIVITIES WITH OWNERS.
  - THE CONTRACTOR SHALL CLEAR AND GRUB ALL EXISTING TREES, SHRUBS, AND UNDERBRUSH TO THE LIMITS DEFINED ON THE DEMOLITION DRAWINGS. ALL MATERIALS INCLUDING, BUT NOT LIMITED TO TRUNKS, BRANCHES, STUMPS, ROOT BALLS, AND CHIPS SHALL BE DISPOSED OFF-SITE AT AN APPROVED WASTE DISPOSAL AREA.
  - THE CONTRACTOR SHALL SAWCUT CONCRETE AND ASPHALT MATERIAL PRIOR TO DEMOLITION.
  - CONCRETE AND ASPHALT MATERIAL DESIGNATED FOR DEMOLITION SHALL BE DISPOSED OFF-SITE AT AN APPROVED WASTE DISPOSAL AREA.
  - ALL EXISTING SLAB ON GRADE STRUCTURES SHOULD BE COMPLETELY REMOVED, INCLUDING CONCRETE SLABS OR FLOOR SLABS AND FOUNDATIONS.
  - ALL EXISTING FOOTINGS AND FOUNDATION WALL AREAS SHOULD BE COMPLETELY REMOVED INCLUDING FOUNDATION DRAIN PIPES AS DIRECTED BY CONSTRUCTION MANAGER.
  - ALL RESULTING DEMOLITION DEBRIS SHALL BE REMOVED FROM THE SITE AND PROPERLY RECYCLED OR DISPOSED OF BY THE CONTRACTOR.
  - COMPLETELY FILL BELOW-GRADE AREAS AND VOIDS RESULTING FROM DEMOLITION OF STRUCTURES. SOIL COMPACTION AND SOIL MOISTURE CONTENT SHALL BE IN ACCORDANCE WITH THE PROJECT SUBSURFACE INVESTIGATION REPORT.
  - USE SATISFACTORY SOIL MATERIALS AS SPECIFIED AND APPROVED BY THE PROJECT GEOTECHNICAL ENGINEER.
  - AFTER PLACEMENT AND COMPACTION, GRADE SURFACE TO MEET ADJACENT CONTOURS AND TO PROVIDE FLOW TO SURFACE DRAINAGE STRUCTURES.
  - ON-SITE STOCKPILING OR SORTING OF DEMOLITION DEBRIS OR MATERIAL IS PERMITTED WITHIN THE DESIGNATED FENCED AREAS ONLY.
  - THE CONTRACTOR SHALL GRADE WORK SITE TO MAINTAIN POSITIVE DRAINAGE THROUGHOUT DEMOLITION OPERATION AND UTILIZE THE CONSTRUCTED EROSION CONTROL MEASURES.
  - THE CONTRACTOR SHALL PROVIDE ERECS AND MAINTAIN TEMPORARY BARRIERS AND SECURITY DEVICES THROUGHOUT THE DURATION OF THE PROJECT AS REQUIRED.
  - THE CONTRACTOR SHALL PREVENT MOVEMENT OR SETTLEMENT OF ADJACENT STRUCTURES AND PROVIDE BRACING AND SHORING AS REQUIRED.
  - THE CONTRACTOR SHALL PROTECT EXISTING SITE FEATURES WHICH ARE DENOTED AS (TO REMAIN).
  - THE CONTRACTOR SHALL DEMOLISH STRUCTURES INDICATED IN AN ORDERLY AND CAREFUL MANNER.
  - THE CONTRACTOR SHALL LEAVE AREAS OF WORK IN A CLEAN CONDITION.
  - THE CONTRACTOR SHALL INSTALL TEMPORARY FENCING AROUND EQUIPMENT AND WORK AREAS TO PROTECT THE PUBLIC FROM CONSTRUCTION ACTIVITIES, MATERIALS AND EQUIPMENT.

**DEMOLITION KEY PLAN**

- COMPLETELY CLEAR EXISTING AND PROPOSED EASEMENT OF ALL UTILITIES, TREES, STRUCTURES AND OTHER PROHIBITED ITEMS IN ACCORDANCE WITH DOMINION ENERGY REQUIREMENTS.
- REMOVE EXISTING STORM STRUCTURE
- REMOVE EXISTING STORM SEWER
- REMOVE EXISTING SANITARY FORCEMAIN
- REMOVE EXISTING WATER SERVICE/WATER MAIN
- REMOVE EXISTING LIGHT POLE AND ASSOCIATED UNDERGROUND ELECTRIC
- REMOVE EXISTING SANITARY SEWER
- REMOVE EXISTING GAS LINE AND/OR SERVICE


29TH ST. NW - (Width Varies)

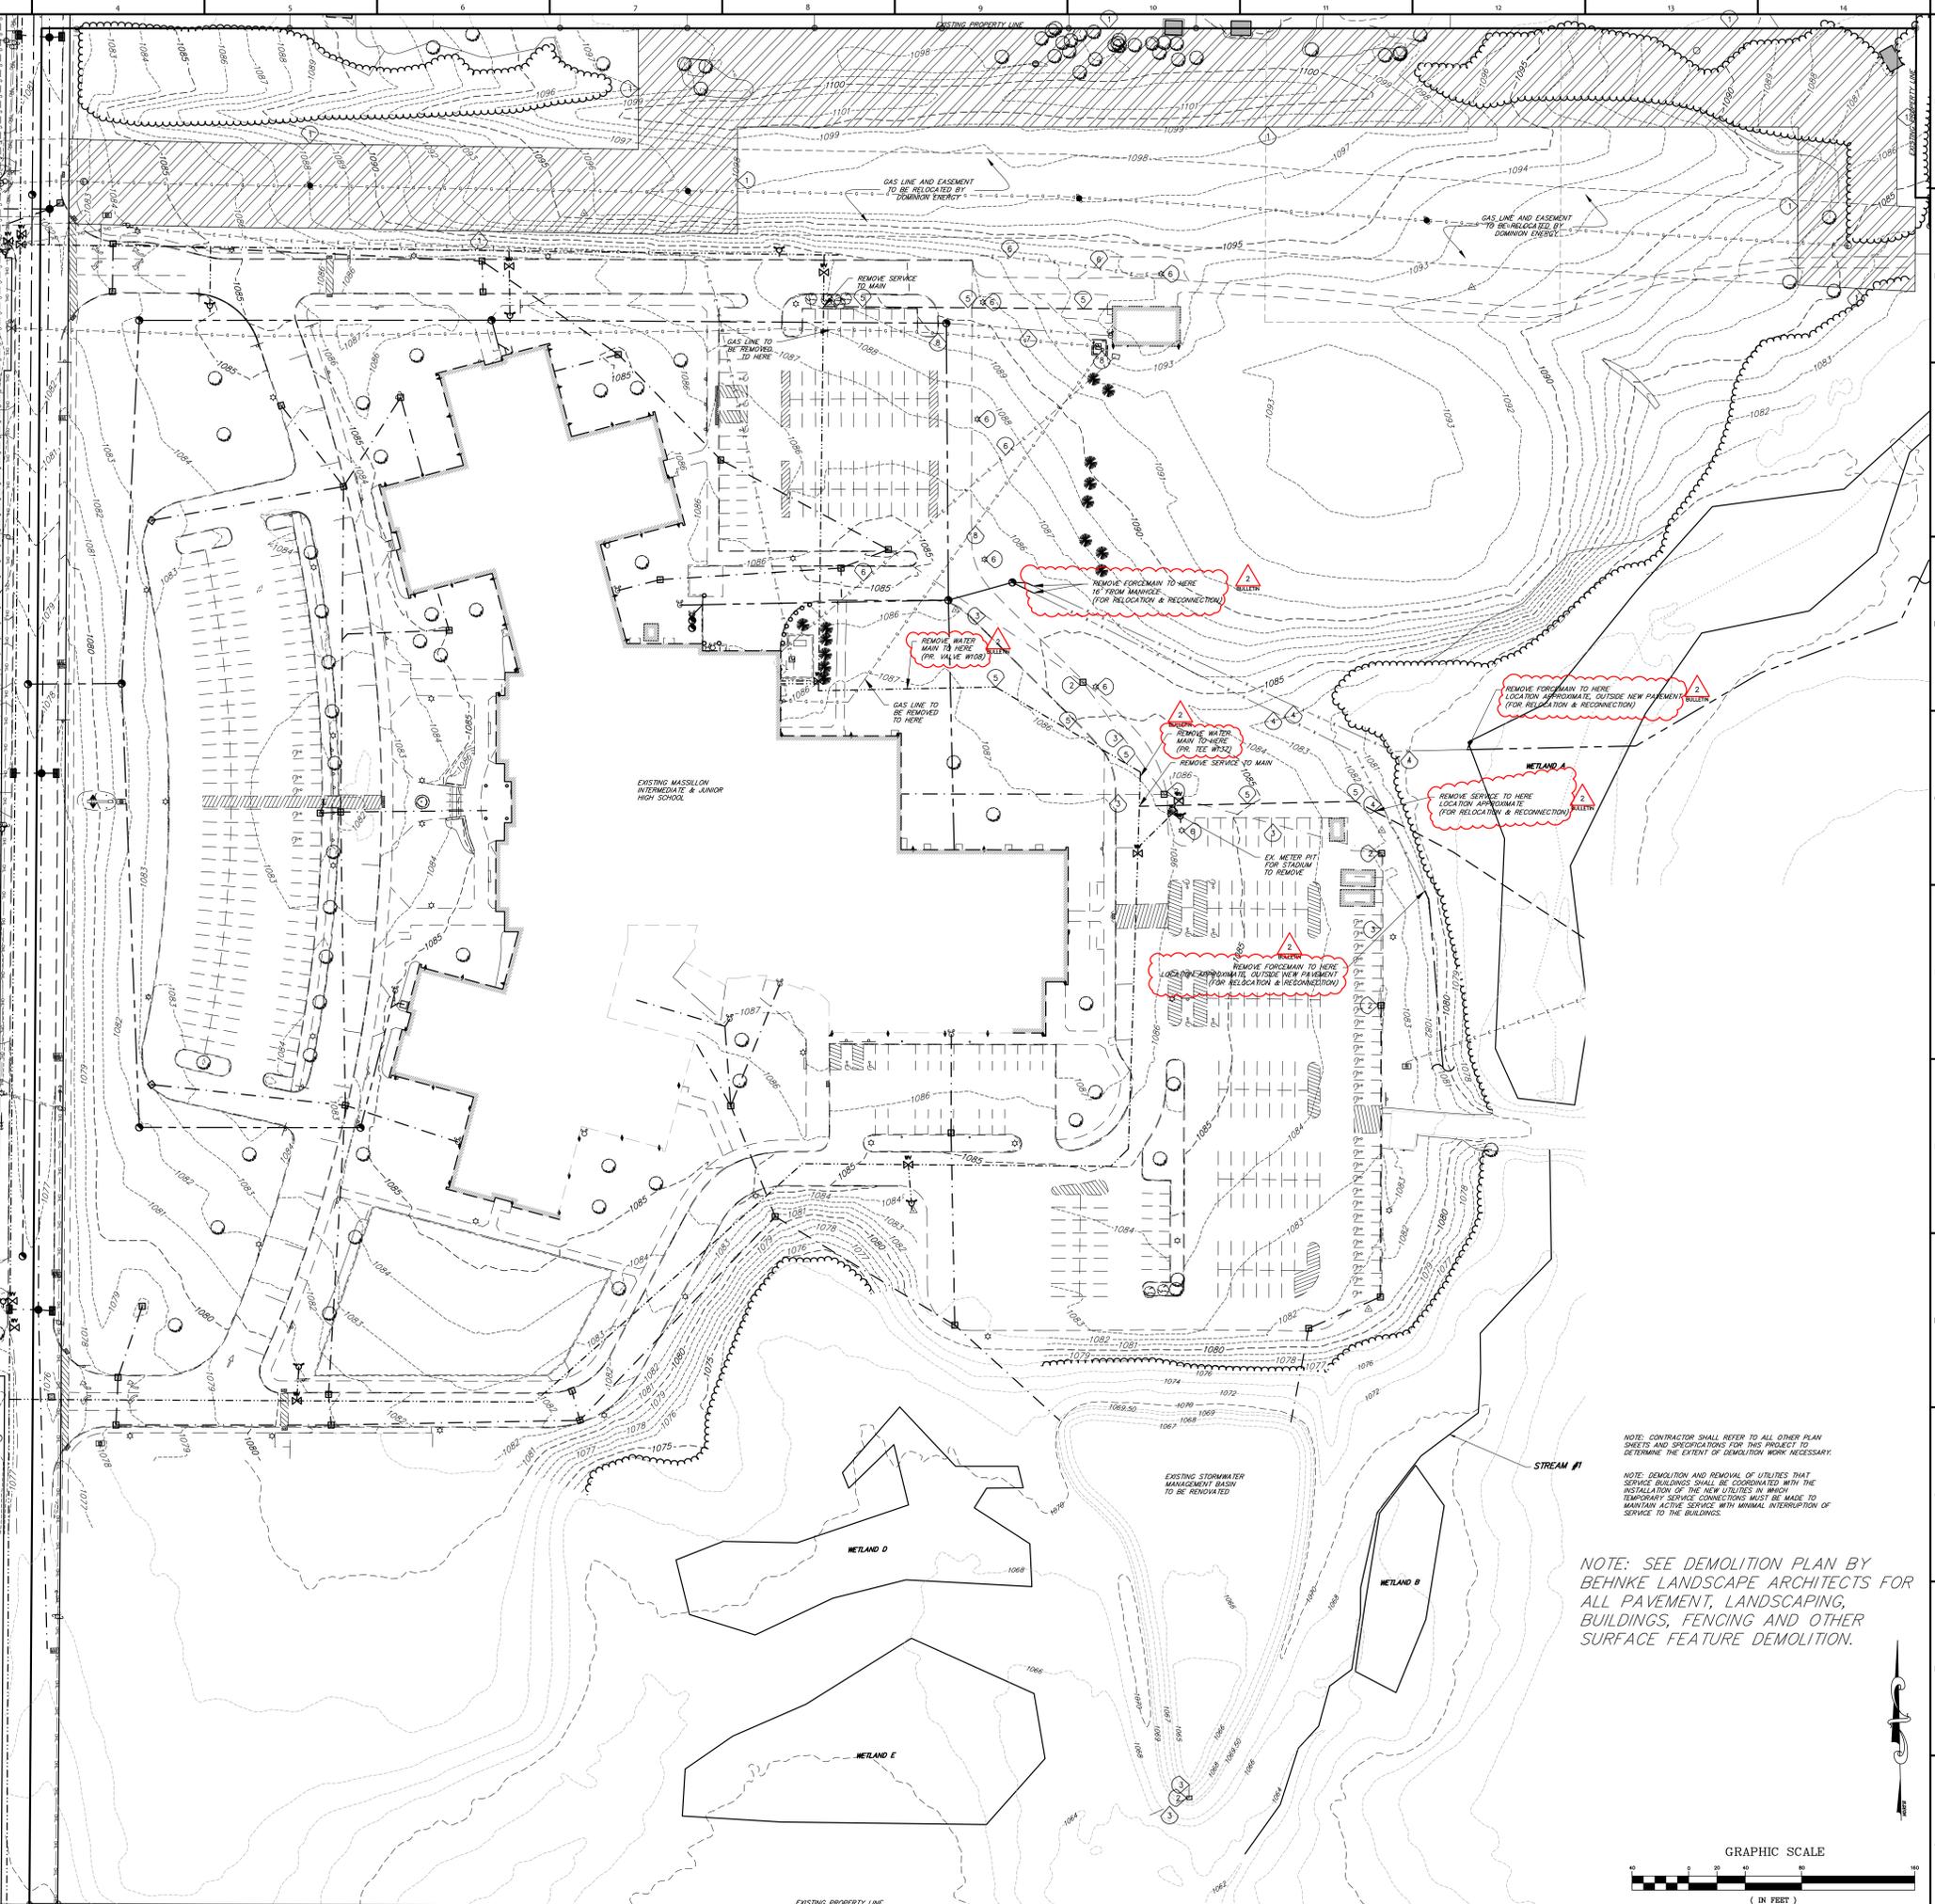

NOTE: CONTRACTOR SHALL REFER TO ALL OTHER PLAN SHEETS AND SPECIFICATIONS FOR THIS PROJECT TO DETERMINE THE EXTENT OF DEMOLITION WORK NECESSARY.

NOTE: DEMOLITION AND REMOVAL OF UTILITIES THAT SERVICE BUILDINGS SHALL BE COORDINATED WITH THE INSTALLATION OF THE NEW UTILITIES IN WHICH TEMPORARY SERVICE CONNECTIONS MUST BE MADE TO MAINTAIN ACTIVE SERVICE WITH MINIMAL INTERRUPTION OF SERVICE TO THE BUILDINGS.

NOTE: SEE DEMOLITION PLAN BY BEHNKE LANDSCAPE ARCHITECTS FOR ALL PAVEMENT, LANDSCAPING, BUILDINGS, FENCING AND OTHER SURFACE FEATURE DEMOLITION.

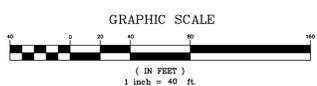

— PLAN PREPARED BY —  
**LEWIS LAND PROFESSIONALS INC.**  
 CIVIL ENGINEERING LAND SURVEYING  
 8691 WADSWORTH ROAD SUITE 100  
 WADSWORTH, OH 44281 (330) 335-8232



PROJECT NO  
 2203-1

**ARCHITECTURAL VISION GROUP, LTD**  
 ARCHITECTS • PLANNERS  
 23850 SPERRY DRIVE  
 CLEVELAND, OHIO 44145



CONSULTANT  
**LEWIS LAND PROFESSIONALS**  
 CIVIL ENGINEERING & LAND SURVEYING  
 8691 WADSWORTH ROAD  
 WADSWORTH, OH 44281  
 PH (330) 335-8232  
 FX (330) 335-0242  
 WWW.LEWISLANDPROF.COM

**MASSILLON CITY SCHOOL**  
**WEST SIDE CAMPUS**  
 250 29th St NW, Massillon, OH 44647

DATE	BY	DESCRIPTION
06/07/21	BULLETT, S	BULLETIN 1
06/07/21	BULLETT, S	BULLETIN 2
09/24/23	ADDENDUM 1	ADDENDUM 1
09/24/23	PLAN REVIEW & ESP	PLAN REVIEW & ESP
09/24/23	ISSUES	ISSUES
09/24/23	ISSUES	ISSUES

PROJECT NO 2203-1  
 DRAWN BY  
 CHECKED BY  
 DATE 09/14/2022

**UTILITY DEMOLITION PLAN**

SCALE: 1"=40'  
 SHEET NO  
**C-100**