


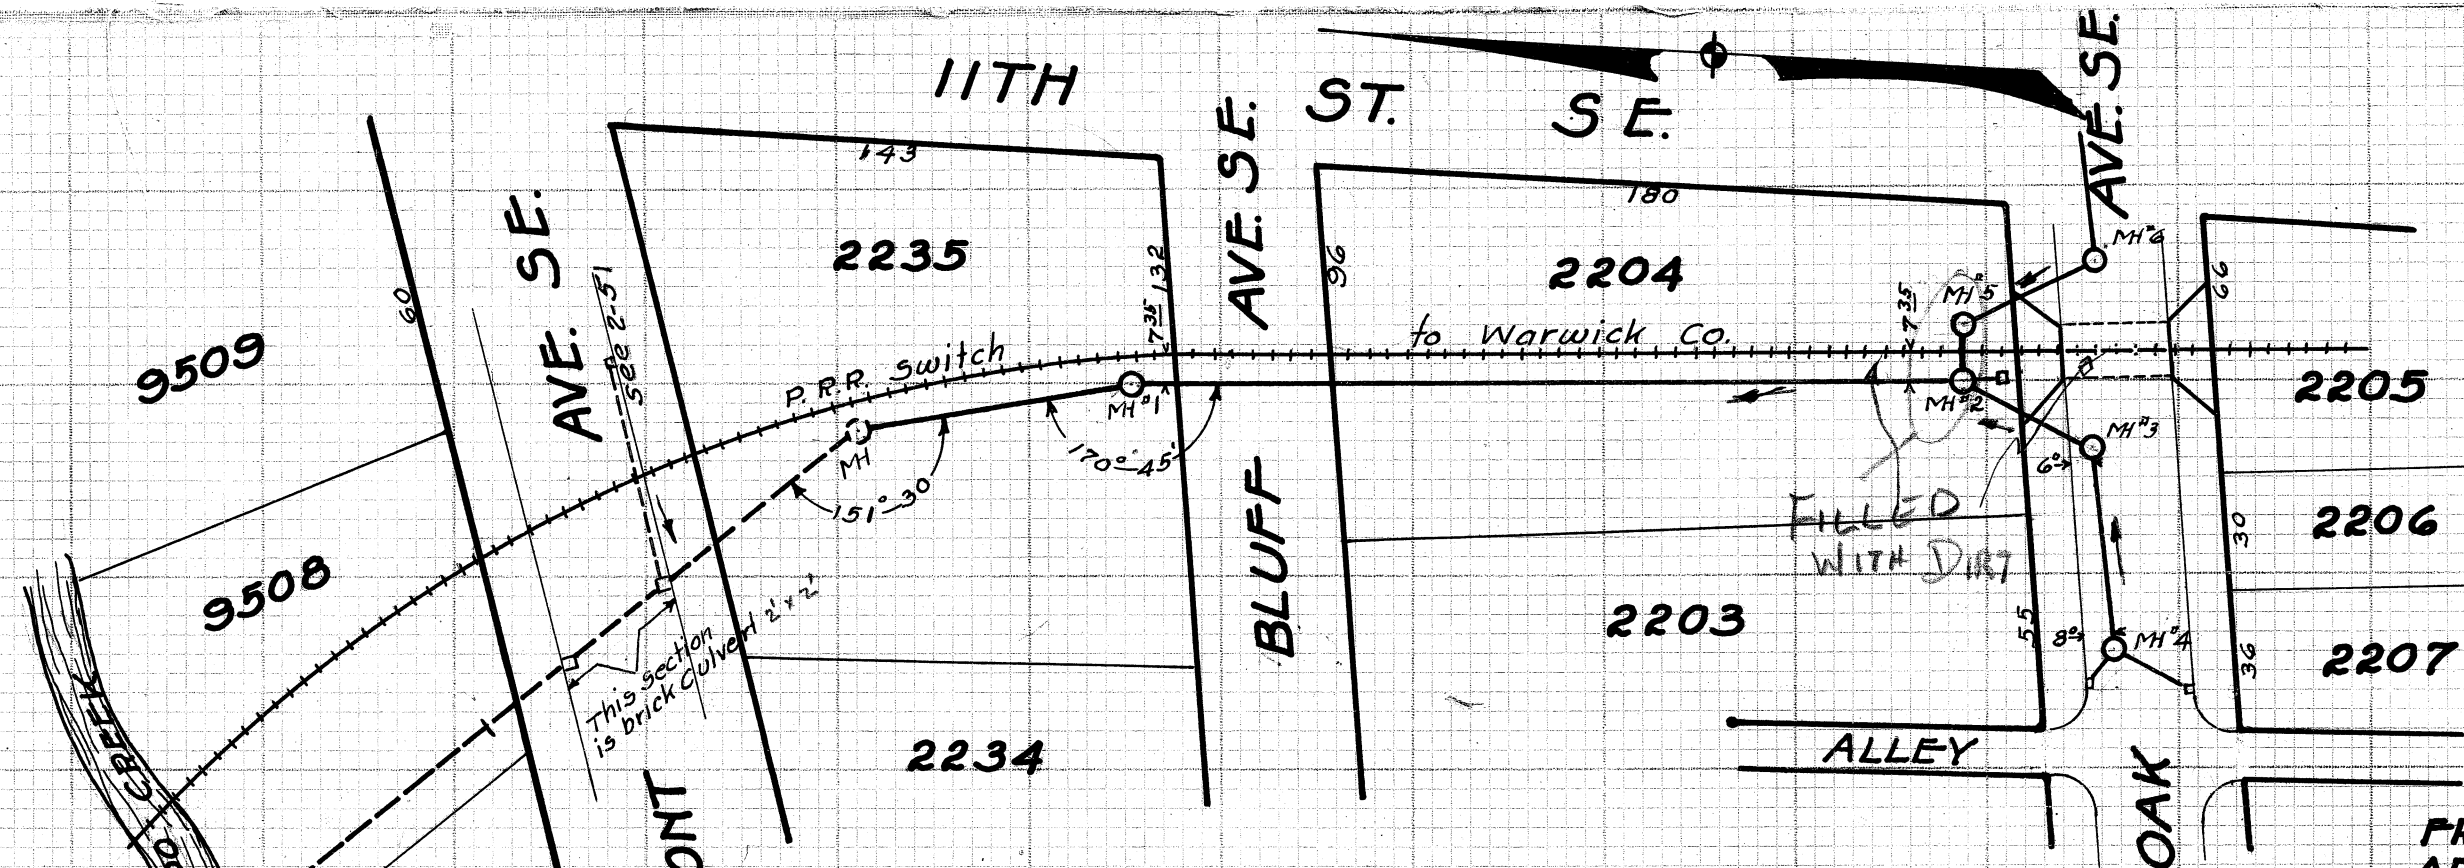

BM - HYD. AT 857 OAK AVE.
 9E - EL = 152.30
 TOP OF NEWEL POST NE.
 COR. OF BRIDGE.
 EL = 158.31

TREMONT & OAK AVES. SE.
 FROM SIPPO CREEK TO OAK AVE. SE. THENCE EAST
 APPROX. 200 FT. & WEST APPROX. 130 FT. OF 11TH ST. SE.
 SECTION OF SEWER SHOWN DOTTED WAS BUILT IN 1925 BY J. WITTMAN.
 BALANCE BUILT IN 1931 BY ELMER VOGT IN CONNECTION WITH PAVING
 OF OAK AVE. SE.

C.E. RICE - CITY ENGR
 SAM JONES - CONST. ENGR
 FRANK JONES - INSPECTOR
 DRG. FILE 5E143 ACC. 556 & P119 ACC. 1049
 PLOTTED NOV. 25, 1931 BY E.G. POCKOCK.
 SCALE 1" = 5' VER. 1" = 50' HOR.

PREL. NB 47 P33-34

CONST. NB 47 P70-71 NB103 P43-60-72

FINAL NB 48 P59 NB 90 P45 NB102 P52-73.00
 INSPECTOR'S RECORD ?

