

N
JF
RING

LOCATION LOT 1943
SUBJECT _____
COMPUTED BY _____ DATE _____ CHECKED BY _____ DATE _____

JOB NO. _____
FILE NO. _____
SHEET NO. 281


1415-

Plat Book 10 Page 102
show City of Mass. Blvd dedicated
65 feet wide LR's distance

as Laid out in the SW 1/4 Sec 4 and SE 1/4 Sec 5, NE 1/4 Sec 8 and NW 1/4 Sec 9
Perry Twp.

6480
5921 New No.

8061392

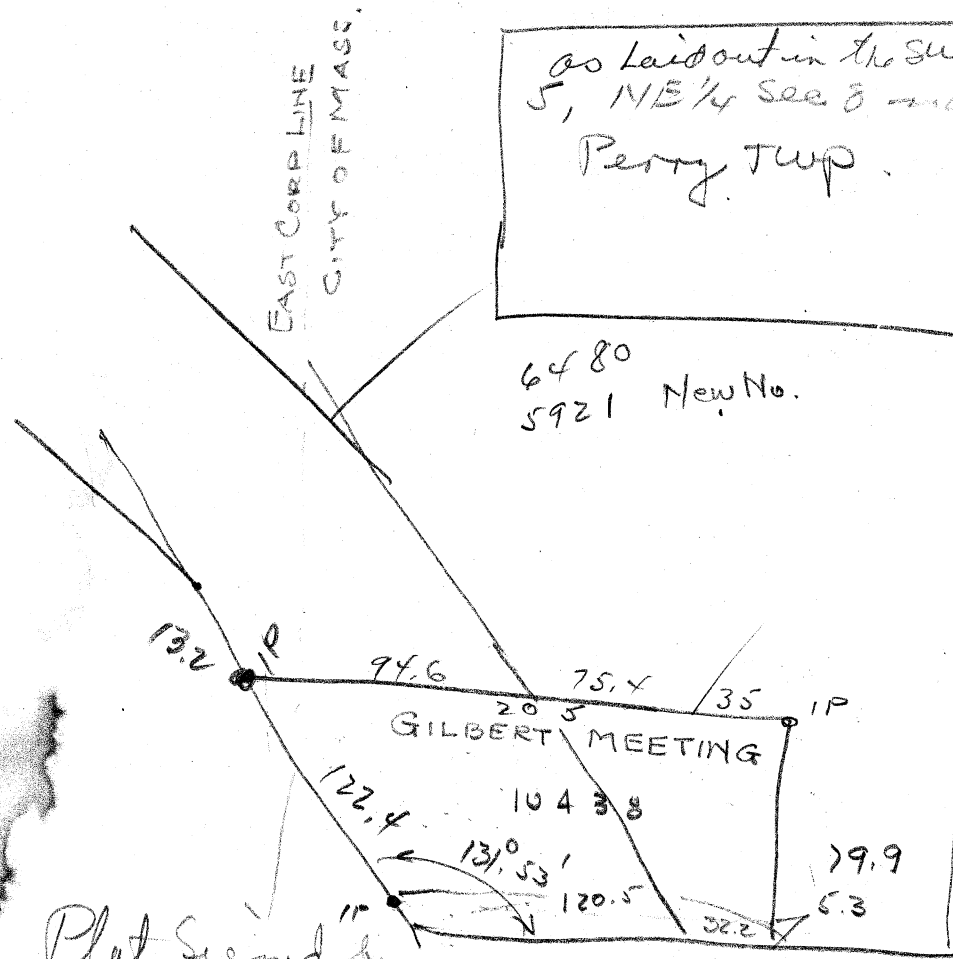

Plat Signed by
Perry Dev. Co
L. J. Campbell Pres.

9th day of Aug 1916

210
N 38° 20' W 355.6

60 - 25.27

Gibbs & Amelia Meeting to
Clarence J. Hostetter.
Consideration \$4,650.00

Sit. in Twp of Perry Cy of St. of Ok. and known
and being a pt of the NE $\frac{1}{4}$ Sec #8 Twp #10 R#9 being
at the pt of + of the W - of lands owned by
John Yengling, which pt is also the E. Bank
of the Res. owned by the Mass Water Co. and running
th N $33^{\circ} 30'$ west 210 feet to the true pl. of
Beg. th S $85^{\circ} 30'$ E 120.5 feet to a stake, th
N $8^{\circ} 30'$ E 79.2 feet to a st.; th N $81^{\circ} 30'$ W 205
feet to a stake on the E Bank of said Res. th
with the E Bank of sd Res. So. 37° E 97 ft to a
stake and thence So $33^{\circ} 31'$ E 25.4 feet to
the pl of Beg containing about 30 ^{of an} ~~acres~~
be the same more or less but subject to
all legal Highways.

Res Aug 28 1923

Gibbs Meeting held till to this property
prior to 1912. Page 231 Perry Twp U.S.D
Tax Map. Year 1912