

~~1439~~ 1439


FOR CITIZENS SAVINGS & LOAN

DATE MARCH 23, 1962

R. F. WAGONER

BY ~~XXXXXXXXXX~~ - REGISTERED ~~XXXXXXXXXXXX~~ SURVEYOR

SCALE: 1" = 30'

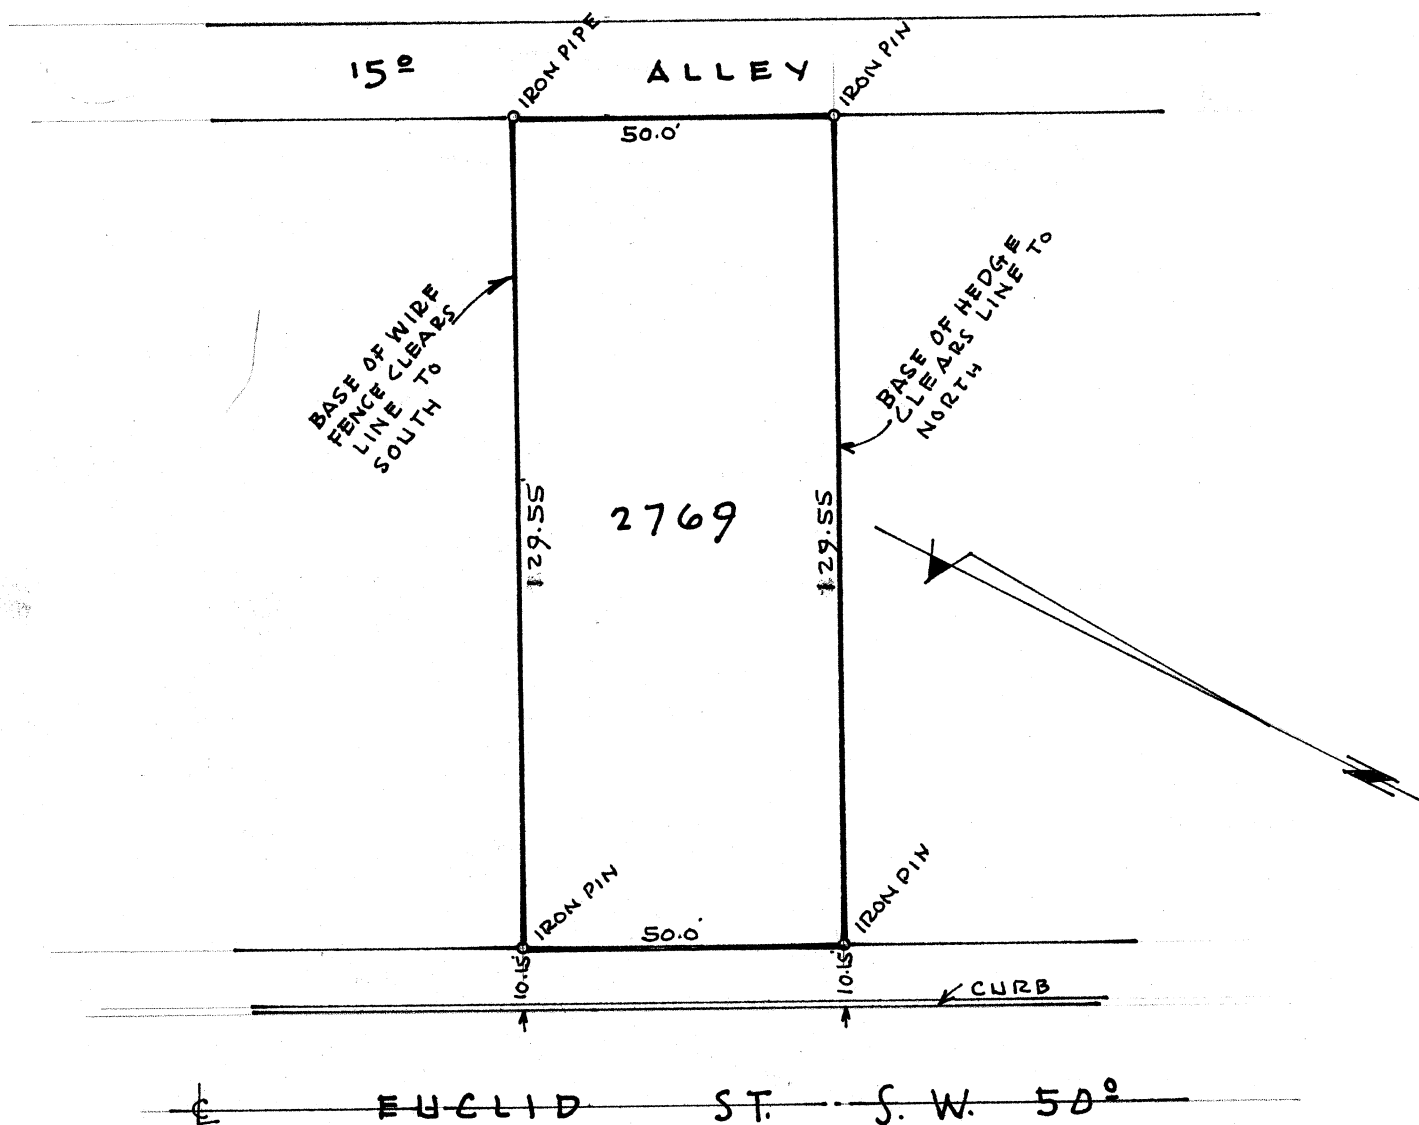

I HEREBY CERTIFY THAT THIS IS A CORRECT PLAT OF THE SURVEY
BY ME, AND THERE ARE NO ENCROACHMENTS FROM ADJACENT PROPERTIES
AND THE BUILDINGS ON LOT NO 2769 DO NOT ENCROACH ON ANY ADJACENT
PROPERTIES.

Robert L. Wagner
REGISTERED SURVEYOR NO. 4787

SURVEY OF LOT # 2769

For O.L. Johnson

Surveyed Apr 20th 1929 by G.C. Wallace
Civil Eng.

A

