

SURVEY OF LOT NO'S. 4771, PT's of 4772 & 4773, 4775 & 4776

Massillon, Ohio.


For Willard Geis, 4771 & PT's 4772, 4773
and

Myron Fricker - 4775 & 4776

4-12-47

FIELD BOOK,
SHOWS 15'

WALNUT RD. S.W. 50°

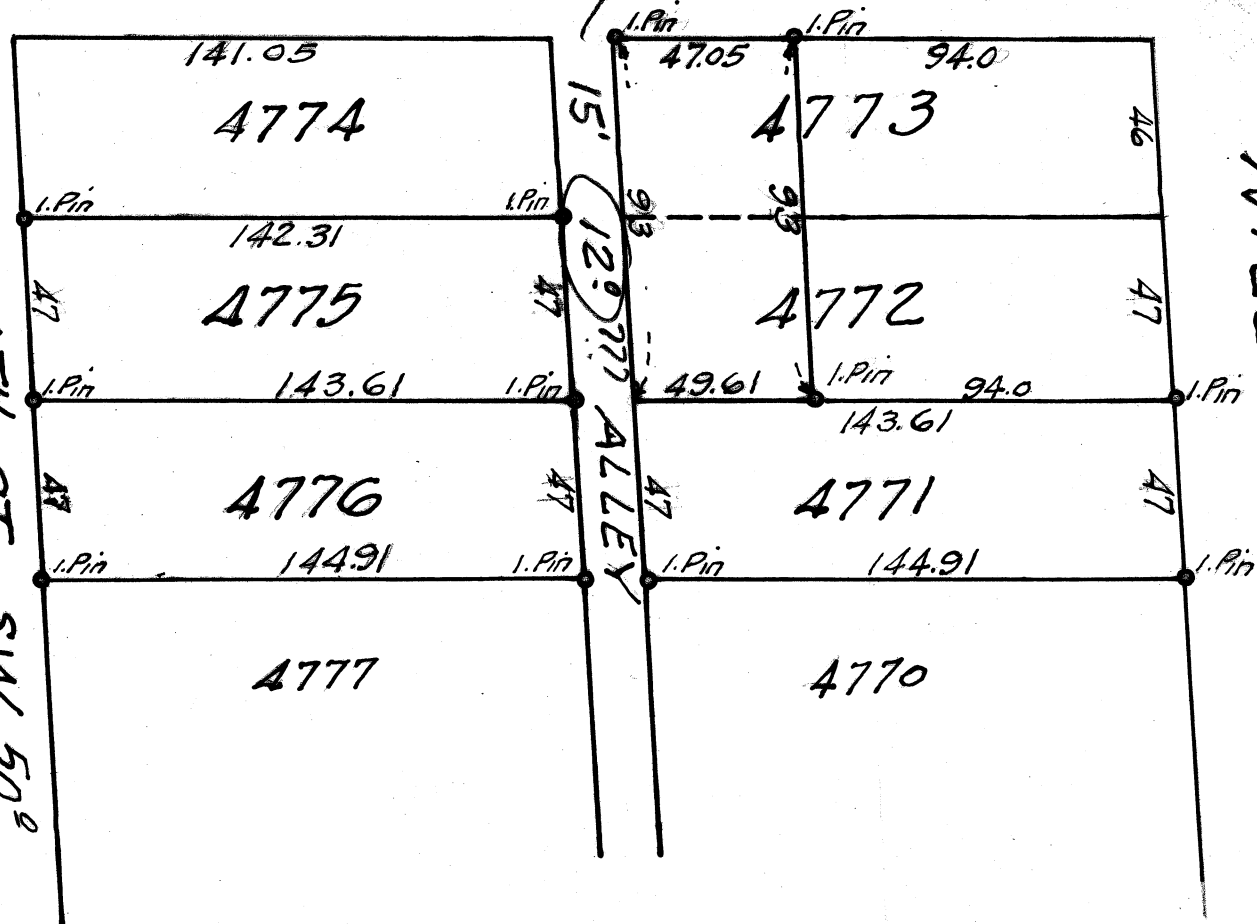

By H.M. Piper - Reg. Engr. & Surveyor

N.B. "M" P 10.

1506

1506

FOR WILLARD GEIS

DATE 3-30-63

R. F. WAGONER

BY ~~XXXXXXXXXX~~ - REGISTERED ~~XXXXXXXXXX~~ SURVEYOR

SCALE: 1"=40'

