

C. E. RICE
758 AMHERST RD. N. E.
PHONE 3450


317
GEO. C. WALLACE
103 WOODLAND AVE. S. E.
PHONE 4654

1731

RICE & WALLACE
REGISTERED CIVIL AND MINING ENGINEERS
SURVEYORS

MASSILLON, OHIO

Sept 6th 1937

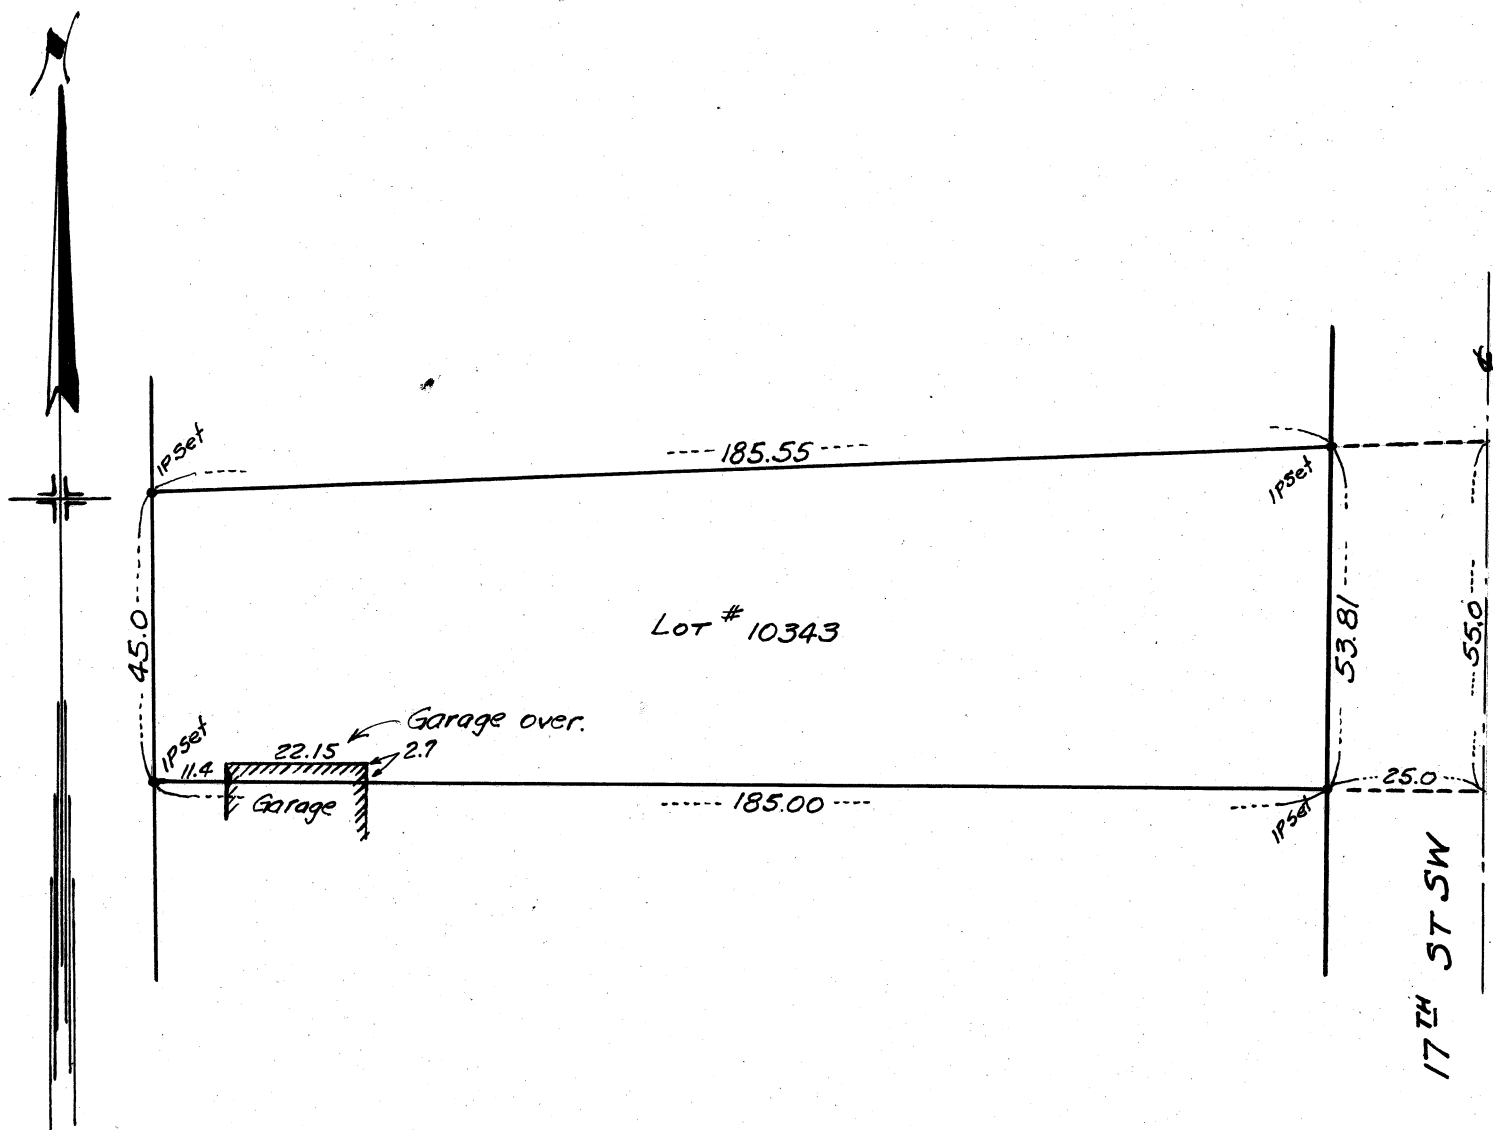

723 - 200 Emil Peterson to Wm J & Mary E Price

com at a pt in the twp - in the c of P R Rd the same being the N E Cor of a tract of land deed to Pauline Lepps to Geo Swier which deed 503 - 367

same as 644 - 85

also a pt of

com at a pt in the twp - in the c of the P R Rd the same being the N E Cor of a tract of land conveyed by D E Akey to one El M Claughlin by deed 595 - 478

th N long the twp - al 2 of sd ind 10 ft to a pt th Wly = with the N - of th El M Claughlin tract 210 feet to a pt th S 11 with twp 10 feet to the N - of sd E M S tract now owned by D R Akey th E al the N - of sd E M S tract 210 ft to Pl of Reg.

Dec 6 1920

674 - 488

D R Akey Clara & Akey to Elmer & Corda M Claughlin

com at a pt on the twp - between twp & Per. twp of Co. sd Pt being the center of P R Rd and sd pt also being the N E Cor of a 10 ft strip of land heretofore sold by the Grantors herein to one Emil Peterson thence Wly al the N - of sd 10 foot strip 210 feet to the N E Cor of sd strip th Wly & 11 with sd twp line 45 ft th N Ely to a pt on sd twp line and in the c of sd P R Rd sd pt being 55 feet north on sd twp line from the Pl of ber of this dec. th S al sd twp - and in the center sd 55 feet to the Pl of Reg.

CITY OF
MASSILLONDEPT. OF
ENGINEERING

LOCATION _____

SUBJECT _____

COMPUTED BY _____

DATE _____

CHECKED BY _____

DATE _____

JOB NO.

FILE NO.

SHEET NO.

387-243

NE 1/4 Sec 13 Beg at a pt in the center of Sugar Creek Road 5 chains 50 links South from a pt in the center of Tremont Rd th al the C of S.C. Rd. S.W. 6.70 ch, th Wly 10.45 ch th Nly 6.70 ch th Ely 10.45 ch to pt of Beg. con 8 ac.

Aug 23 1901

Theresa Brankel to Ed. G. Bowers.

515:1805

Rt E 1/2 NE 1/4 Sec 13 Corn at a pt which is 30 ft South from the NE Cor of Pauline E Bipp's land which cor is in the C of Tre Rth 745.8 ft from the pt where the Q.L. of Tre S crosses the Twp & th S.W. al the sd P.E. Bipp's W- 69 ft to a stone th Ely al line between sd P.E. line & Bowers land 93 ft to a stake th N 97.6 ft to a st th W al a line E with C.L. of T.S. and dist therefrom 30 feet, 80.5 ft to pt of Beg.

Apr 13 1911

Dora J Wehrly to Adam Lux

Pauline Bipp to D R Akey 515 579

th pt of the NE 1/4 Sec 13 Corn at a pt in T.R. where it crosses the Twp line thence al C of T.R. Wly 11.30 chains to a stone th S.W. 1.50 chains to a stone th Ely 10.45 ch to a pt in the center of Sugar Creek Rd. th Nly al the center of sd S.C. Rd. to the pt. of Beg. con 3.06 ac. except that which is sold to Geo Swier & David Fahn.

Sept 23 1911

Mary Swier to Harry L Stoner 503-419

Rt E 1/2 of NE 1/4 Sec 13

Beg at the end of the following courses to wit: at the pt of T. of E. of Twp. Twp with the C- of Tremont Rd th Wly al C of sd Rd 11.30 ch to a stone th S.W. 1.50 ch to a stone at the a post in the N half lands owned by E.G. Bowers th Ely 10.45 ch to a pt in the C- of S.C. Rd. now called Pigeon Run Rd. being or intending to be the S.E. Cor of a tract of land formerly owned by Pauline E Bipp and being the true place

of Reg. The NW 1/4 of Sec 100 feet to a pt.
th wh. an ~~1/4~~ ^{1/2} ~~1/4~~ ^{1/2} the N - of properties now
owned by E. S. Bowers. & C. E. Swier and same being
the S. 1/2 of land formally owned by Pauline E. Lipp
270 feet to a pt; th Swier = with C. of sd P. R. Rd.
100 feet to a pt. in the N - of sd land now owned
by E. S. Bowers thence E. by along N - of sd land
of E. S. Bowers and C. E. Swier 270 feet to
pt of Reg -
Sept 2 1910


⁴⁰⁰⁰⁰
644 - 85 Elmer Laughlin to Emil Peterson
Comm at a pt in the trap line in C of P. R. Rd. the
same being the N.E. cor of a tract of land deeded
by Pauline E. Lipp to Geo. Swier in vol 503-367
th N on the trap line S. E. of sd Rd. 50 feet to
a pt th wh. 1/2 with the N - of The Swier tract
ref. to above 270 ft to a pt th S = with the
sd Trap - 50 ft. to the NW cor of Swier tract
th wh. S. E. of sd Swier tract now
owned by H. L. Stoner 270 ft to pt of Reg.
Nov 30 1918

CITY OF
MASSILLON

DEPT. OF
ENGINEERING

LOCATION _____
SUBJECT _____
COMPUTED BY _____ DATE _____ CHECKED BY _____ DATE _____

JOB NO.
FILE NO.
SHEET NO.

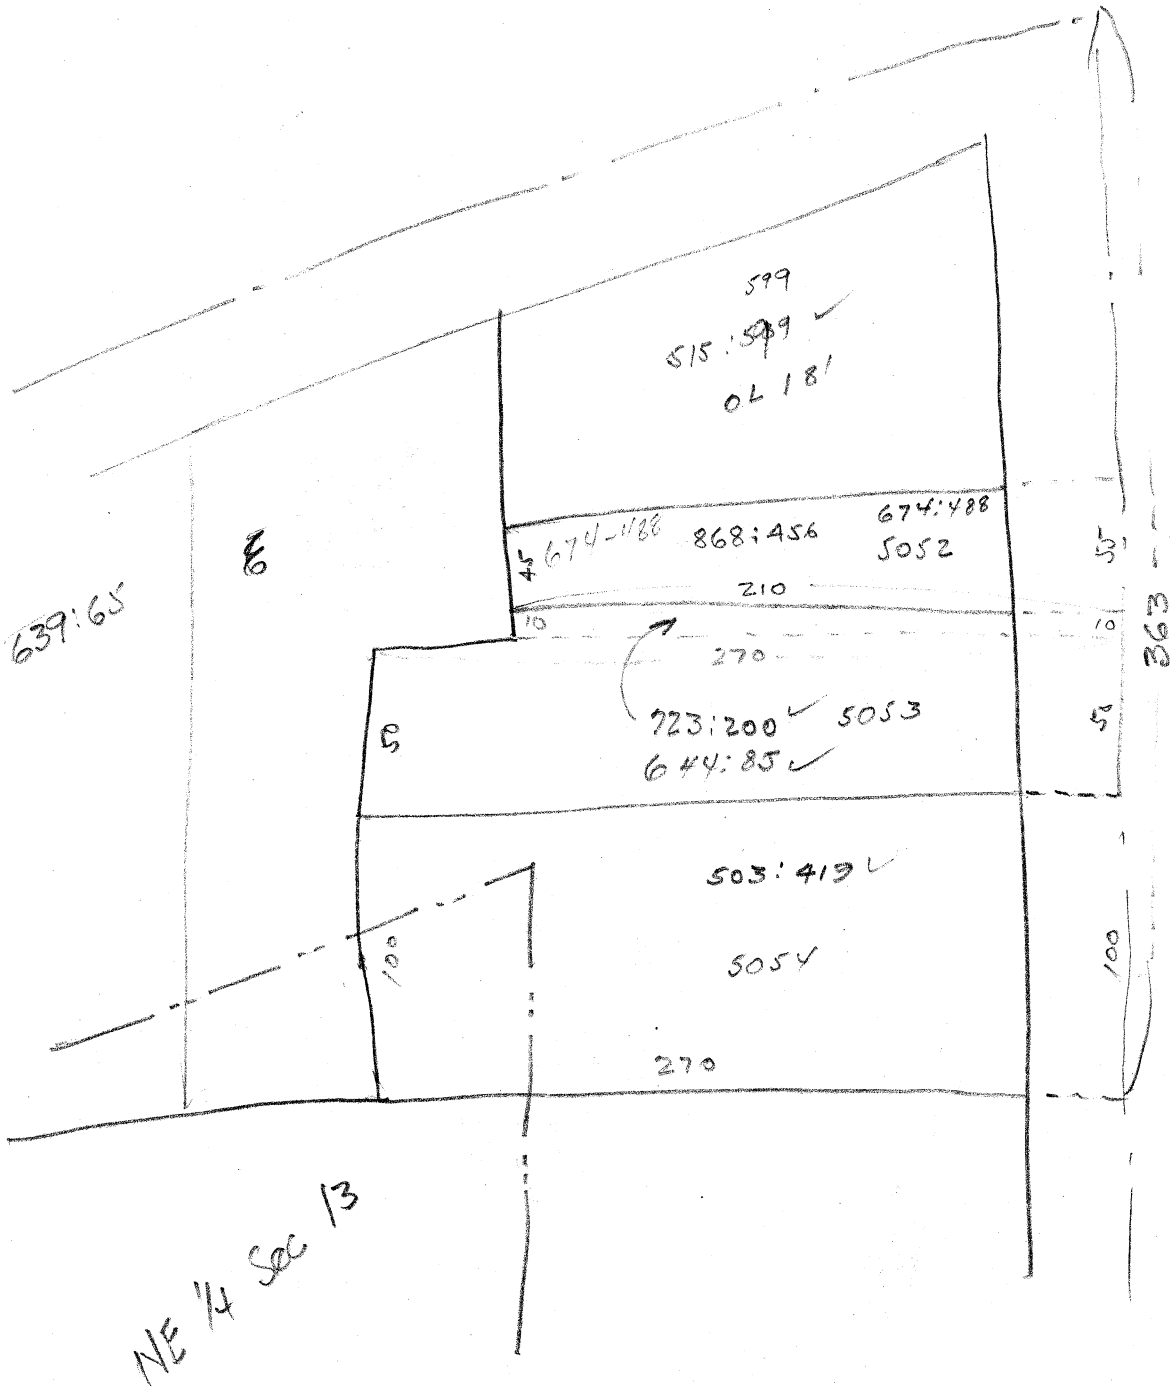

NE 1/4 Sec 13

F 515 185

E.G. Bowers 387:243