

SURVEY OF LOT NO. 4729


MASSILLON, STARK, OHIO

FOR BOB HECK

DATE 4-8-61

ROBERT F. WAGNER
BY ~~W. M. FIBER~~ - REGISTERED ~~ENGINEER~~ AND SURVEYOR

SCALE: 1"=30'

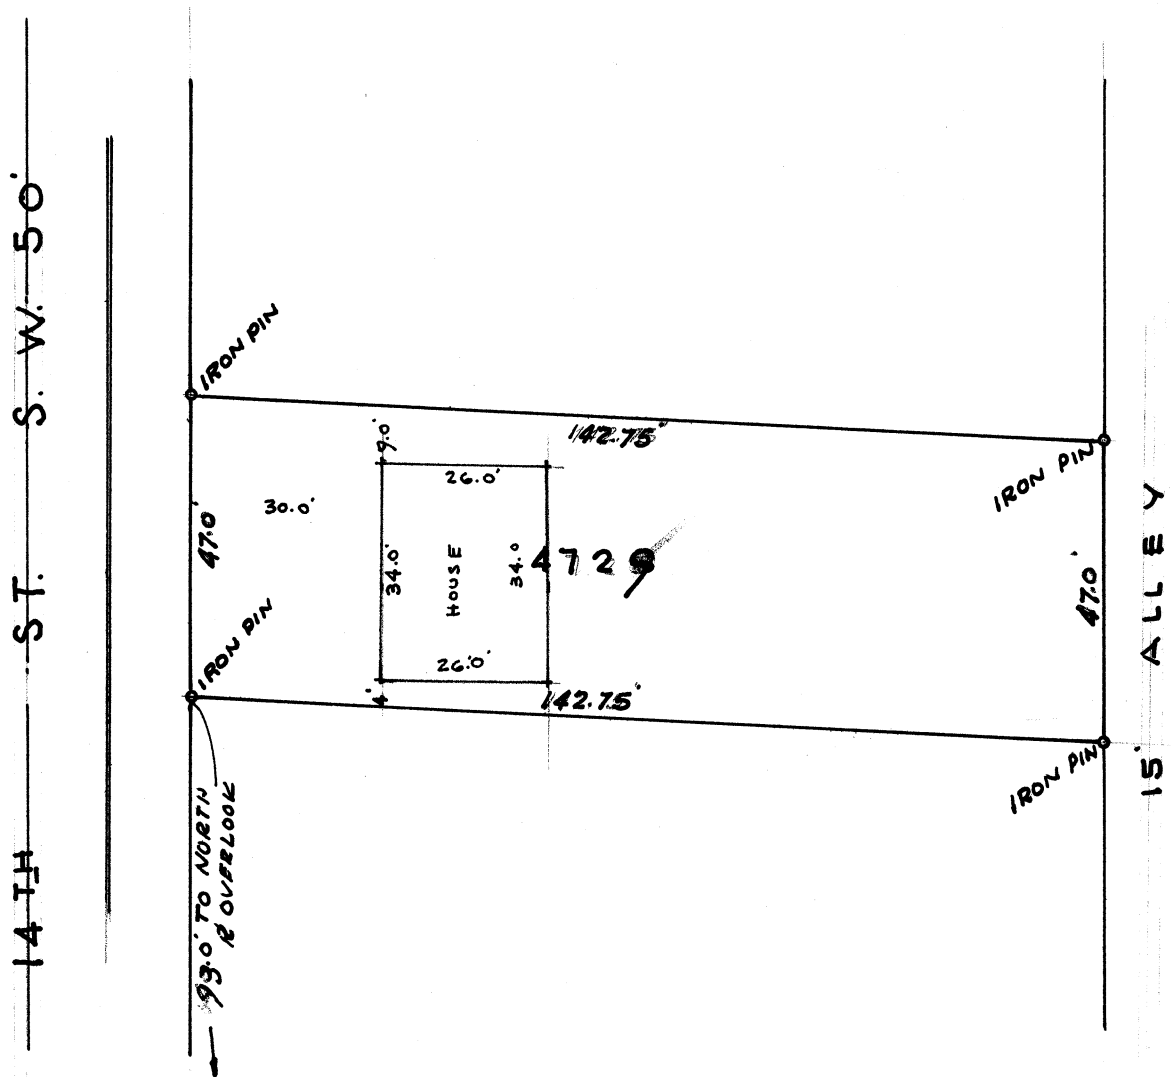

THE ABOVE PROPERTY IS LOCATED AT 820 14TH ST.
S.W. MASSILLON, OHIO.
I HEREBY CERTIFY THAT THIS SURVEY SHOWS THE
HOUSE IS LOCATED ON THE PREMISES DESCRIBED; THAT ALL
DIMENSIONS SHOWN HEREON ARE CORRECT; THAT THE HOUSE
IS ENTIRELY WITHIN THE LOT LINES, AND THAT THERE ARE
NO ENCROACHMENTS UPON THE PREMISES DESCRIBED BY
THE IMPROVEMENTS OF THE ADJOINING PREMISES.

Robert F. Wagner

REGISTERED SURVEYOR NO. 4787