

180,3	180,3
-------	-------


FOR JEROME MULNICK

DATE JAN. 8, 1962

R. F. WAGONER

BY ~~XXXXXXXXXX~~ REGISTERED ~~XXXXXXXXXX~~ SURVEYOR

SCALE: 1" = 30'

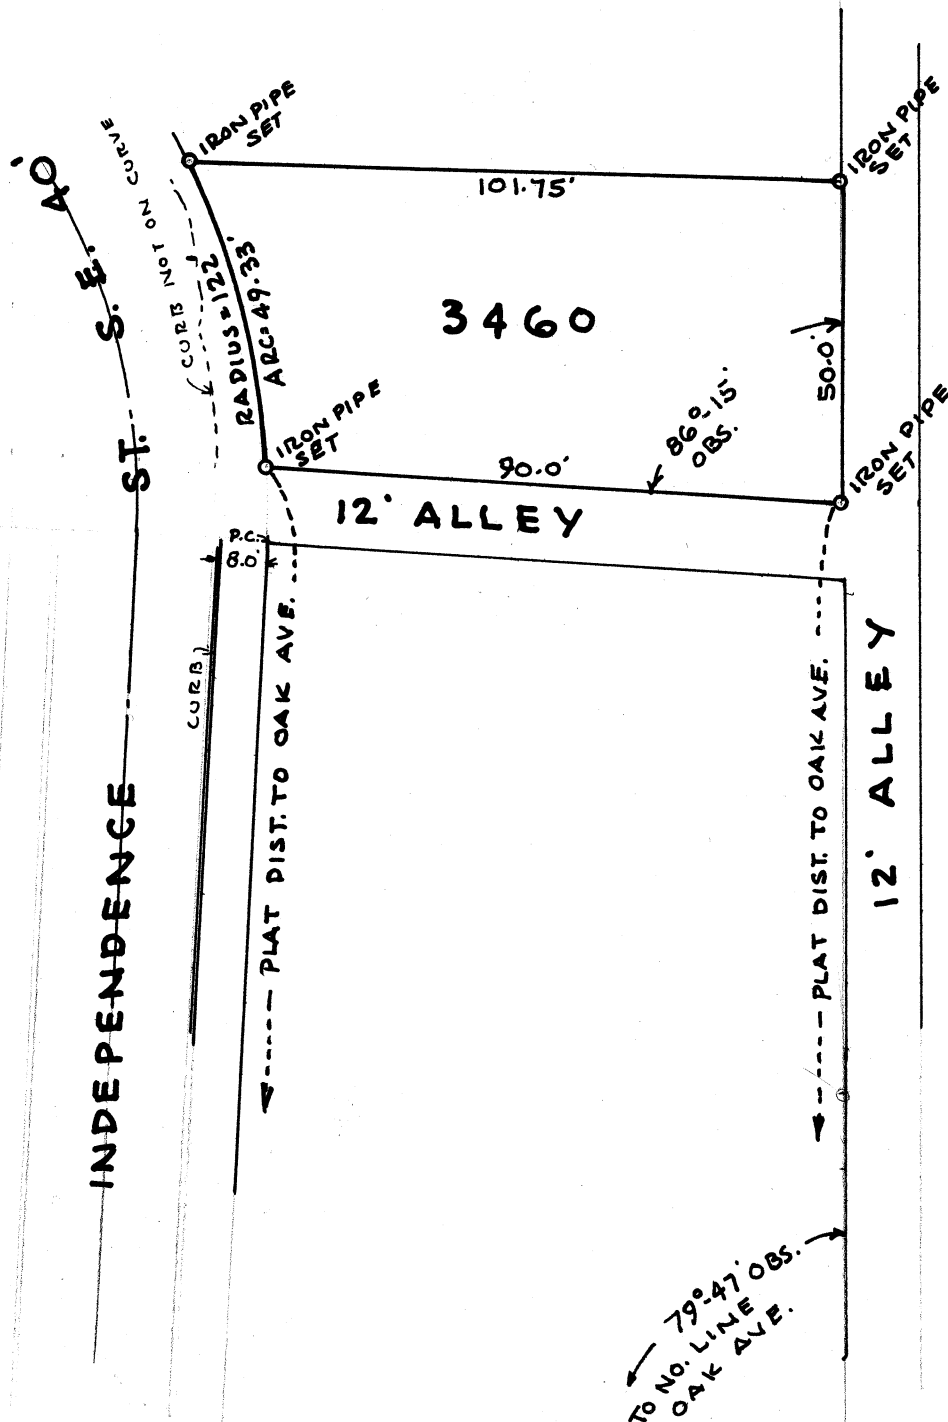

2-59

285