

1804

MASSILLON, STARK, OHIO

FOR BILL HECK

DATE 12-14-61

R. F. WAGONER
BY ~~THOMAS WAGONER~~ - REGISTERED ~~ENGINEER AND~~ SURVEYOR

SCALE: 1" = 30'

STONER RD. N.E. 50⁰



K-571

SURVEY OF MASS. CITY LOT NOS. 8039 & 8040


MASSILLON, STARK, OHIO

FOR J. GLICK

DATE 4-4-67

BY R.F. WAGONER-REGISTERED SURVEYOR

SCALE: 1" = 50 FT

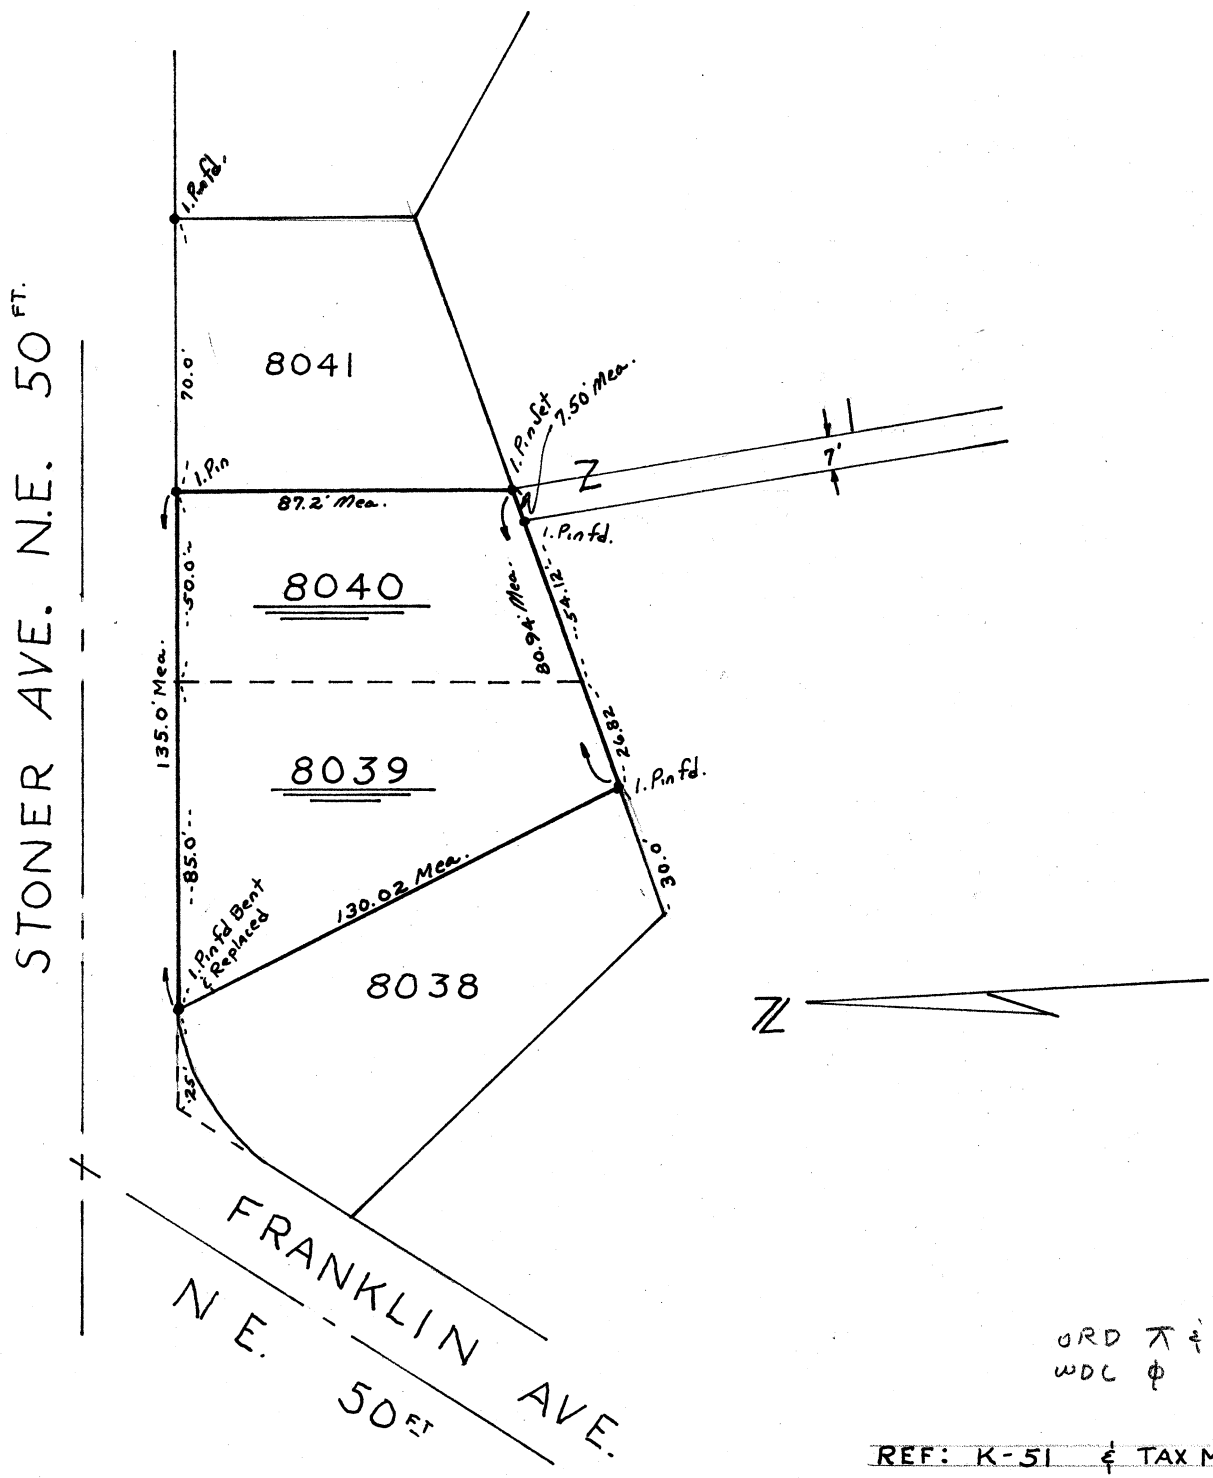

ORD π & ϕ
WDL ϕ