


180

SCALE: $1'' = 20'$

~~THORNE~~ . ~~AVE.~~ . ~~N. E.~~ . ~~332~~

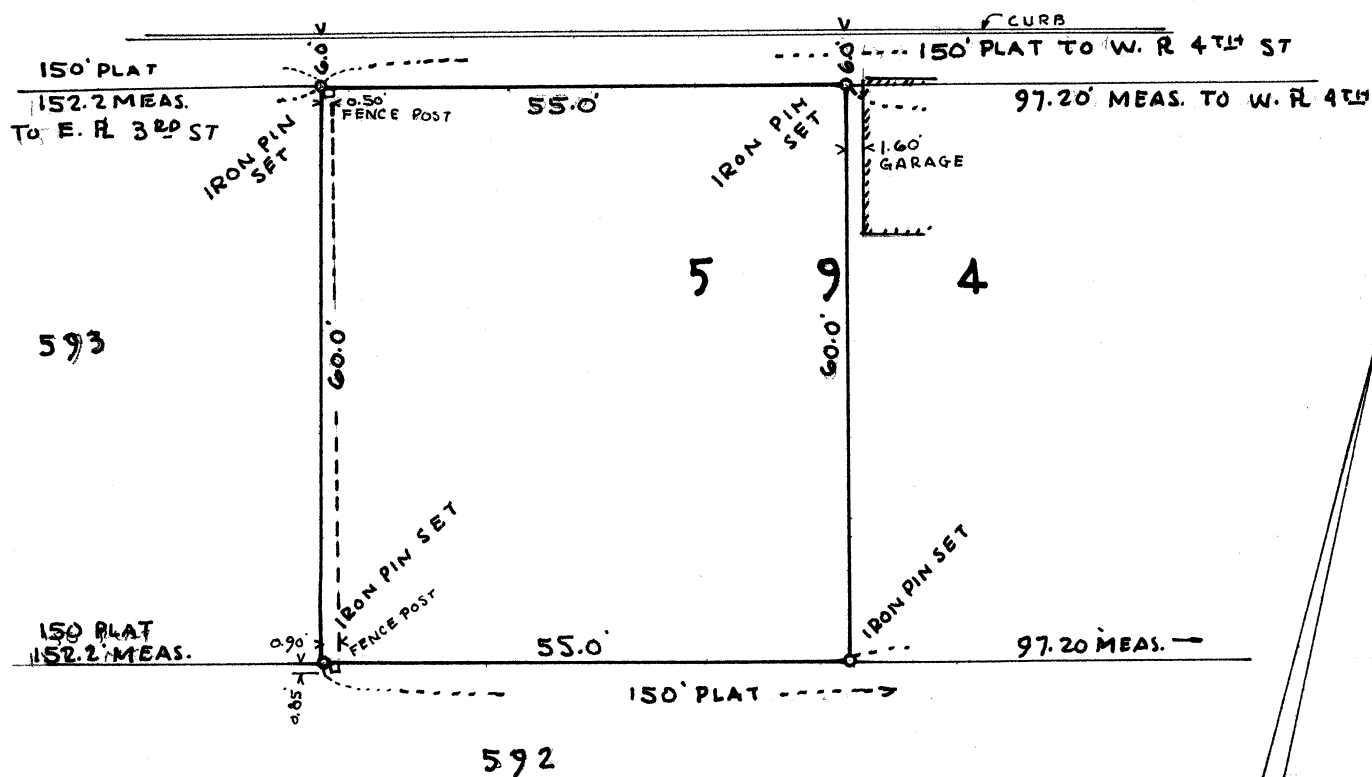

100