

SURVEY OF PART LOT NO. 8006 & PT. 8005

MASSILLON, STARK, OHIO


FOR RAY DAVID - 828-17TH ST. N.E.

DATE JUNE 1962

R. F. WAGONER

BY ~~REGISTERED~~ - REGISTERED ~~SURVEYOR~~ SURVEYOR

SCALE: 1"=30'

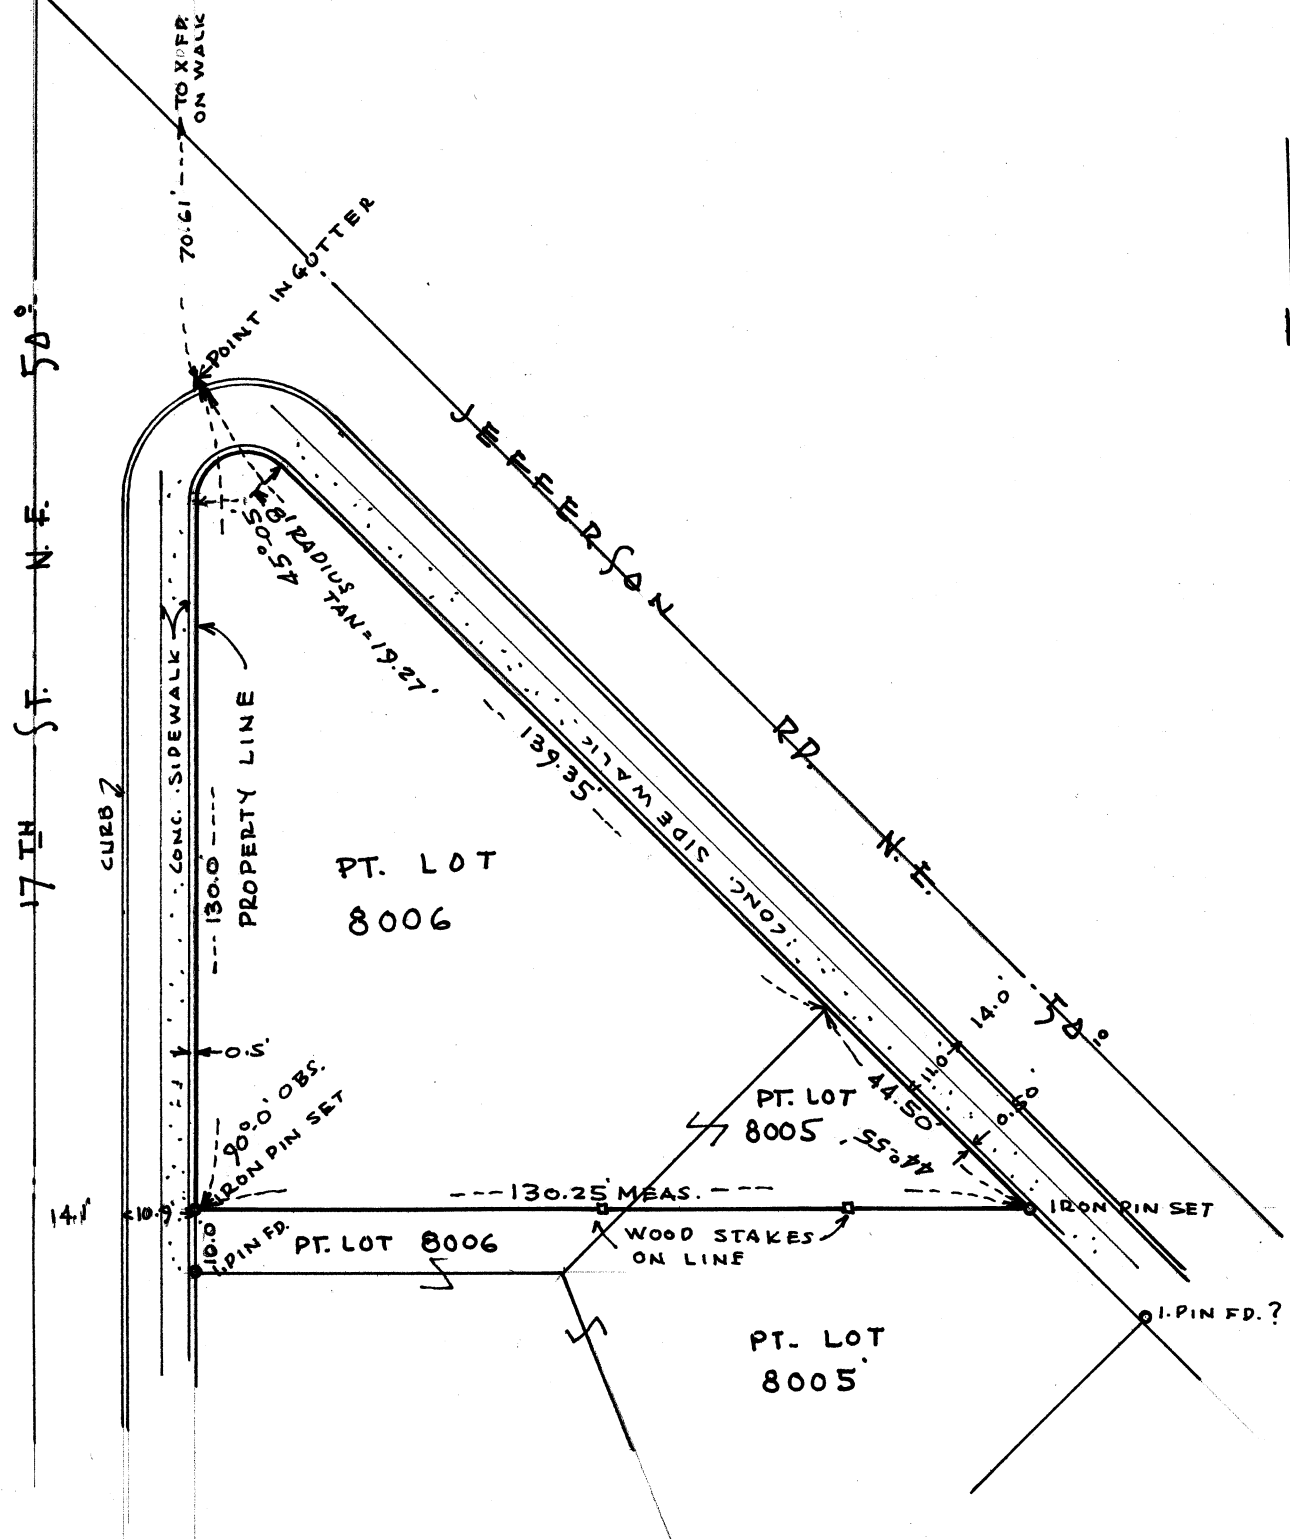

1927